


Exhibit B

Approved Concrete Overhang Geometry


Approved April 2021

Ground Floor:
Relief from the required 10'
Setback/Waiver Request: 6'-6"

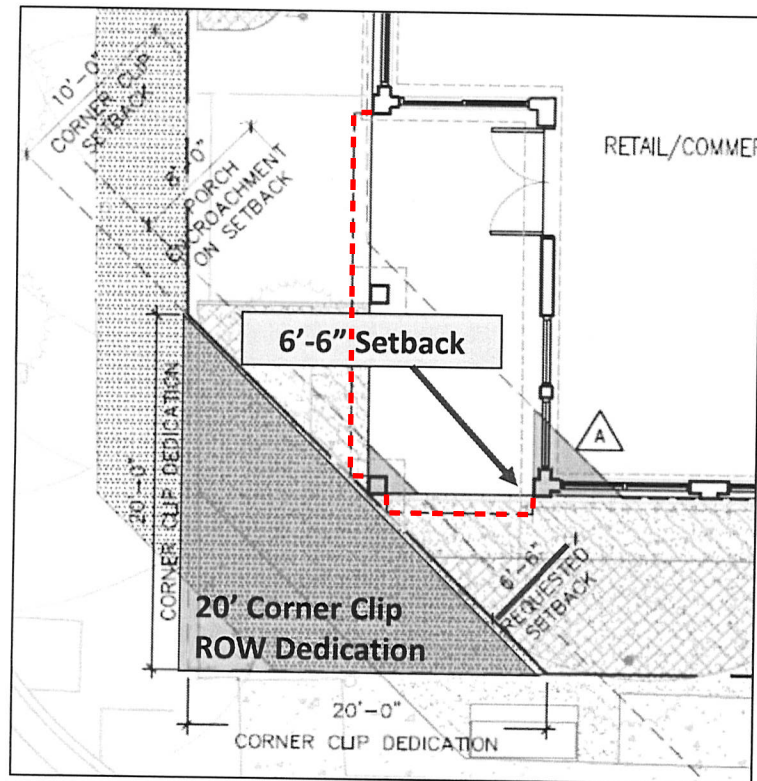

Approved April 2021

Second Floor:
Relief from the required 10'
Setback/Waiver Request: 0'-0"

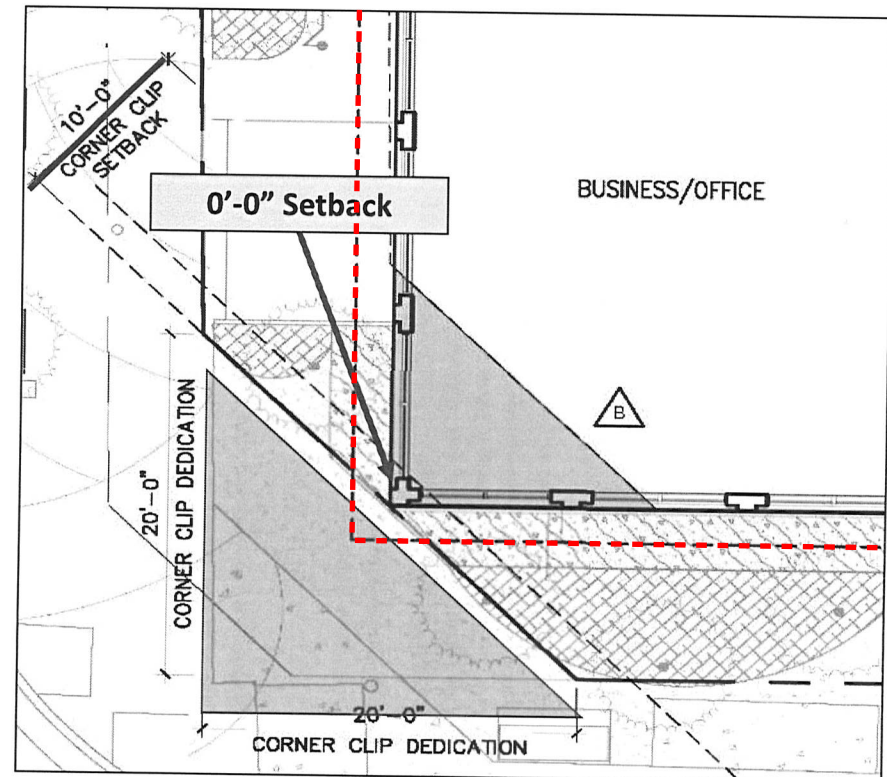


Note: Dotted red line shows approximate location of decorative awnings.

As-Built Concrete Overhang Geometry

Approved April 2021


Ground Floor:
Relief from the required 10'
Setback/Waiver Request: 6'-6"

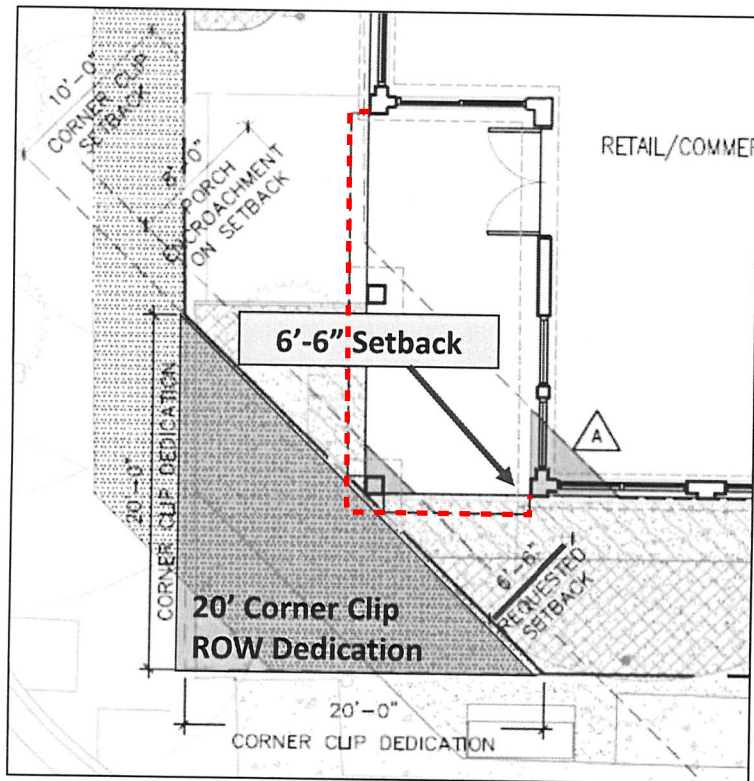

First Floor concrete overhang was built slightly different from what was approved, as the corner wraps around the corner and intrudes in the Corner Clip ROW Dedication.

Approved April 2021

Second Floor:
Relief from the required 10'
Setback/Waiver Request: 0'-0"

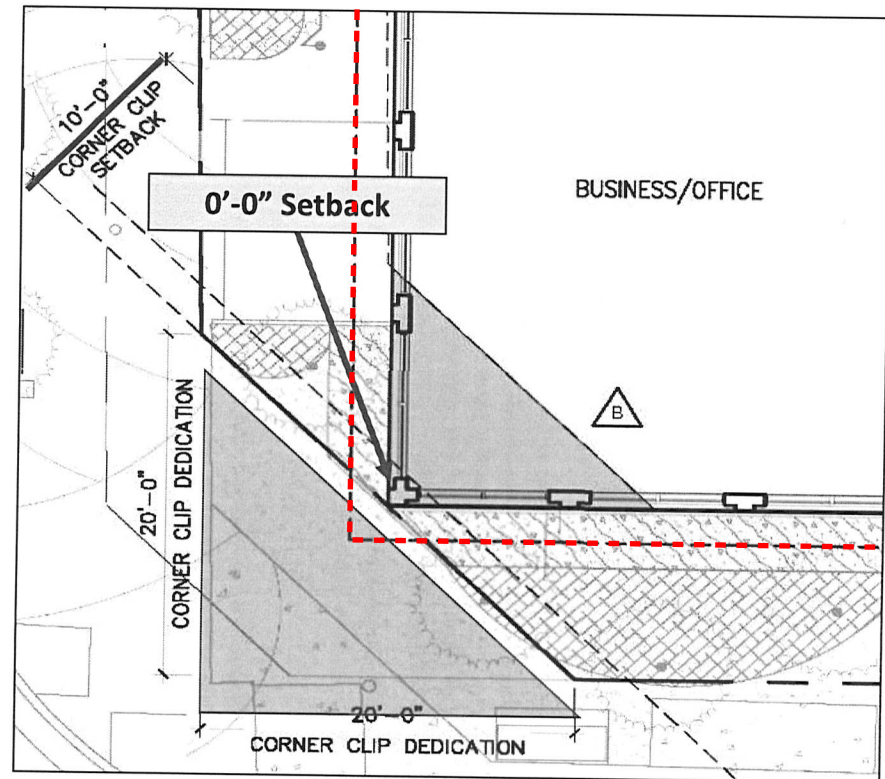

Second Floor concrete overhang was built as approved.