


As-Built Concrete Overhang Geometry

Approved April 2021

Ground Floor:

Relief from the required 10'
Setback/Waiver Request: 6'-6"

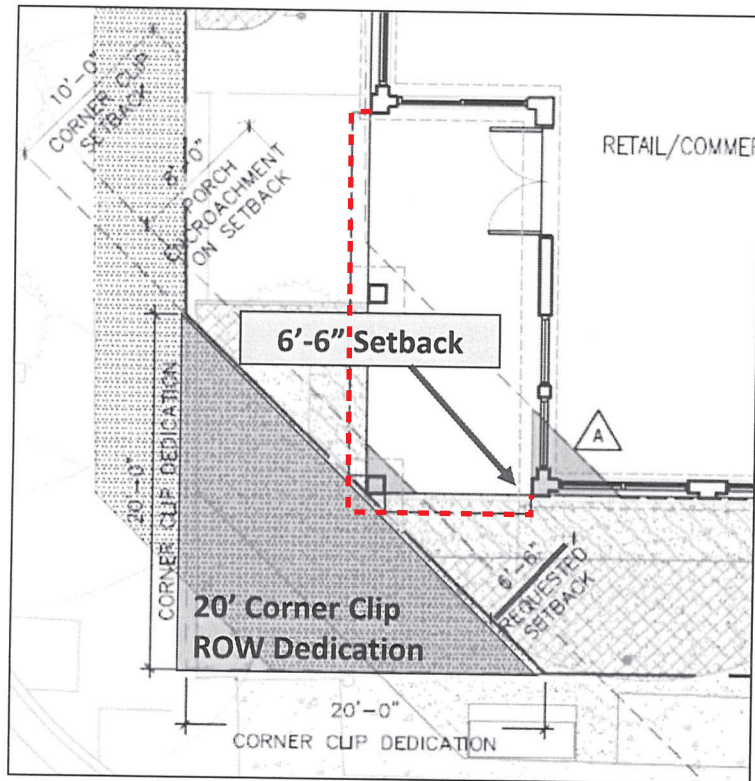


Encroachment occurs between 11'-0" and 12'-0" above ground level.

Approved April 2021

Second Floor:

Relief from the required 10'
Setback/Waiver Request: 0'-0"

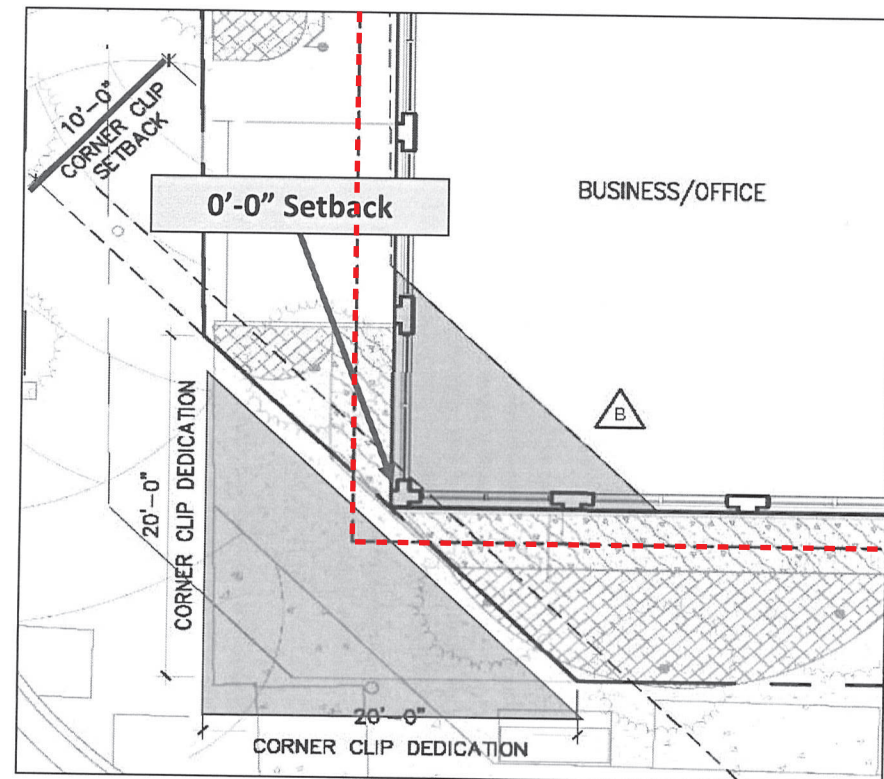

Encroachment occurs between 22'-0" and 22'-7" above ground level.