



CITY OF DELRAY BEACH

DEPARTMENT OF DEVELOPMENT SERVICES

100 N.W. 1ST AVENUE • DELRAY BEACH • FLORIDA 33444 • (561) 243-7040



HISTORIC PRESERVATION BOARD STAFF REPORT

170 Marine Way

Meeting	File No.	Application Type
June 5, 2024	2024-134	Certificate of Appropriateness

REQUEST

The item before the Board is consideration of a Certificate of Appropriateness (2024-134) request associated with the reconstruction of an existing chimney and exterior modifications on a contributing single-family structure located at 170 Marine Way, within the Marina Historic District.

GENERAL DATA

Owner: Angela L Porter Trust

Agent: Mark Hunley

Location: 170 Marine Way

PCN: 12-43-46-16-01-126-0150

Property Size: 0.197 acres

Zoning: Multiple Family Residential-Medium Density (RM)

Historic District: Marina Historic District

OSSHAD (North)

Land Use: Medium Density Residential

Adjacent Zoning:

- East: CF (Community Facilities)
- North: RM (Multiple Family Residential - Medium Density)
- West: RM
- South: R-1-AA (Single-Family Residential)

Existing Use: Residential

Proposed Use: Residential



BACKGROUND AND PROJECT DESCRIPTION

The subject property is located within the RM zoning district. A circa 1939 two-story, A-frame, vernacular style structure was relocated to the subject property in 2012 and subsequently Individually Designated to the Local Register of Historic Places via Ordinance No. 03-13.

At its meeting of August 15, 2012, the Historic Preservation Board (HPB) approved Certificate of Appropriateness (COA) and Variance (2012-189) requests associated with the Relocation of the single-family residence from 806 NE 2nd Street to 170 Marine Way. The variance associated with the relocation proposal was to reduce the south side street setback from 15' to 5' (adjacent to SE 2nd Street).

At its meeting of February 6, 2013, HPB approved COA (2013-082) associated with additions and alterations to the single-family residence that included an open front porch addition (East elevation),

Project Planner:	Review Dates:	Attachments:
Katherina Paliwoda, Planner, Paliwodak@mydelraybeach.com Michelle Hoyland, Principal Planner, HoylandM@mydelraybeach.com	HPB: June 5, 2024	<ul style="list-style-type: none">1. Plans2. Materials and Color Samples3. Renderings

installation of concrete landing and steps (North and West elevation), installation of concrete porch (South elevation), brick paver walkway from Marine Way, and replacement of upper story rail with decorative capped aluminum rail. HPB also recommended approval of a request to individually designate the subject structure to the Local Register of Historic Places to be known as "The Marina House". The designation (2013-044) was approved by the City Commission at its March 5, 2013, meeting via Ordinance No. 03-13.

At its meeting of February 7, 2018, HPB approved a Certificate of Appropriateness (2017-267) request associated with a 172 square foot exterior addition, construction of a 432 square foot, two-story, two-car garage, pool, landscaping and perimeter fence. To date, construction has commenced but is not yet completed.

At its meeting of July 6, 2022, HPB approved Certificate of Appropriateness (2022-064) request associated with a 259 square foot addition to the existing 1,601 square foot, 2-story main residence, replacement of the existing trusses and white cement tile roof on the single-family residence, construction of a new covered porch and aluminum trellis to the rear (west side) of the property.

At its meeting of January 4, 2023, HPB approved Certificate of Appropriateness (2023-040) request for the demolition of 236 square feet of non-contributing additions to the existing residence to allow for the structure to be raised from its existing 6' finished floor elevation height to 8.5' finished floor elevation in order to comply with FEMA flood zone requirements. The elements of the structure to be removed included the front steps, the non-contributing addition on the north rear side of the main residence, and the terrace on the south of the existing structure. These elements were to be reconstructed once the structure is raised.

Work has been ongoing on the structure and property and during construction, the existing chimney fell. As the structure is contributing to the Marina Historic District, the certified set from the previous approval noted that the chimney was to remain. Therefore, as the request has exceeded the approved scope of work, the reconstruction of the chimney requires the review and approval from HPB. It is noted that chimney frame was already constructed before the applicant was given direction from staff that board approval was required, and work has been stopped on permit (18-180765) for the roof and chimney. The exterior brick for the chimney has not yet been applied to the structure. A Certificate of Appropriateness for the request was submitted on April 17, 2024. In addition to the reconstruction of the chimney other exterior modifications to the property are being requested, and are listed below:

- New white aluminum railings and handrail added to the front porch of the main structure.
- New stair configuration on the rear (west) side of the main structure.
- Tiled wall for outdoor kitchen in the rear of main structure.
- Change of paver material from marble to shellock.
- Addition of artificial turf to the backyard.
- Change of exterior colors for façade, awnings, and shutters.
- New aluminum fences and gates with columns on the front (east) and side street (south) side of the property.
- Sliding gate for driveway on the northeast side of the property.

The request is now before the board.

REVIEW AND ANALYSIS

Pursuant to Land Development Regulation (LDR) Section 2.4.12(A)(5), prior to approval, a finding must be made that any Certificate of Appropriateness is consistent with Historic Preservation purposes pursuant to Objective HPE 1.4 of the Historic Preservation Element of the Comprehensive Plan; the provisions of Section 4.5.1; the Delray Beach Historic Preservation Design Guidelines; and, the Secretary of the Interior's Standards for Rehabilitation.

ZONING AND USE REVIEW

Pursuant to LDR Section 4.4.6(F)(1) - Medium Density Residential (RM) - Development standards: The provisions for the R-1-A District shall apply for single family detached dwellings.

The existing use is a single-family residence will remain, which is a permitted use within the RM zoning district.

LDR SECTION 4.5.1

HISTORIC PRESERVATION: DESIGNATED DISTRICTS, SITES, AND BUILDINGS

Pursuant to LDR Section 4.5.1(E), Development Standards, all new development or exterior improvements on individually designated historic properties and/or properties located within historic districts shall, comply with the goals, objectives, and policies of the Comprehensive Plan, the Delray Beach Historic Preservation Design Guidelines, the Secretary of the Interior's Standards for Rehabilitation, and the Development Standards of this Section.

Pursuant to LDR Section 4.5.1(E)(2) – Minor Development.

The subject application is considered "Minor Development" as it involves "The construction, reconstruction, or alteration of less than 25 percent of the existing floor area of the building and all appurtenances."

Pursuant to LDR Section 4.5.1(E)(3)(a)(1.)(d) – Buildings, Structures, Appurtenances and Parking: Buildings, structures, appurtenances and parking shall only be moved, reconstructed, altered, or maintained, in accordance with this chapter, in a manner that will preserve the historical and architectural character of the building, structure, site, or district:

Appurtenances: Appurtenances include, but are not limited to, stone walls, fences, light fixtures, steps, paving, sidewalks, signs, and accessory structures.

Fences and Walls: The provisions of Section 4.6.5 shall apply, except as modified below:

- a. Chain-link fences are discouraged. When permitted, chain-link fences shall be clad in a green or black vinyl and only used in rear yards where they are not visible from a public right of way, even when screened by a hedge or other landscaping.
- b. Swimming pool fences shall be designed in a manner that integrates the layout with the lot and structures without exhibiting a utilitarian or stand-alone appearance.
- c. Fences and walls over four feet (4') shall not be allowed in front or side street setbacks.
- d. Non-historic and/or synthetic materials are discouraged, particularly when visible from a public right of way.
- e. Decorative landscape features, including but not limited to, arbors, pergolas, and trellises shall not exceed a height of eight feet (8') within the front or side street setbacks.

The subject request includes new 5' aluminum fencing, driveway gate, and 5' concrete columns on the front (east) side of the property (adjacent to Marine Way) and on the side street (south) of the property (adjacent to SE 2nd Street). The LDRs allow fencing to be a maximum of 4' within the front and side street setbacks within an historic district, the applicants have agreed to lower the height to the appropriate 4' height, so it has been added as a site plan technical item.

Pursuant to LDR Section 4.5.1(E)(4) – Alterations: in considering proposals for alterations to the exterior of historic buildings and structures and in applying development and preservation standards, the documented, original design of the building may be considered, among other factors.

The subject request is a result of work being done at the building permit stage that exceeds the approval from HPB. Modifications to the structure went to the Historic Preservation Board on January 4, 2023, where the project was approved and included the existing chimney to remain. Due to unforeseen events in the field, the existing chimney was removed and now requires reconstruction. The deviation from HPB's approval is being brought to the board for review. In addition, other exterior modifications to the structure and the site are proposed.

Pursuant to LDR Section 4.6.9(D), Design Standards, All parking spaces which are created in order to fulfill requirements of this Section (i.e. required parking spaces) shall conform to the design standards of this subsection.

Single-Family dwelling units, duplexes and townhomes with direct, individual unit access to a public right-of-way shall provide:

- **Along all road classifications, except local, a minimum stacking distance of 20 feet from the ultimate right-of-way.**
- **Along local roads, gates, wall, fences, or similar structures, that are 25 percent or less opaque and do not create visual obstructions, are permitted on the ultimate right-of-way line or on the property line without a stacking distance, whichever distance is greater, and are not subject to the regulations in Section 4.6.14.**

The proposal includes a sliding gate for the previously approved driveway on the northeast side of the property that will enter from Marine Way. As the proposed gate is not 25% percent opaque or less and does not meet the site visibility requirements of LDR Section 4.6.14 it will be need to meet the minimum 20' stacking distance requirement. This item is an added site plan technical item.

Pursuant to LDR Section 4.6.14 – Sight Visibility – Driveway intersecting street or alley. The area on both sides of a driveway formed by the intersection of a driveway and a street or alley with a length of ten feet along the driveway, a length of ten feet along the street or alley right-of-way and the third side being a line connecting the ends of the other two lines.

The subject request includes a sliding gate for the previously approved driveway. A site plan technical item has been added that site triangles be depicted on the plan to ensure the driveway meets the minimum 10' site visibility requirements.

Landscape Regulations– Section 4.6.16(E)(12) *Artificial Turf*. Artificial turf is allowed on both residential and non-residential properties, subject to the following requirements:

a) General.

- i. The installation of artificial turf requires a landscape permit.**

- ii. Artificial turf areas may not be included in open space calculations.
 - iii. Artificial turf is considered pervious but cannot be used within permanent drainage features, including ponds and swales.
 - iv. Artificial turf shall not be installed closer than five feet to the property line.
 - v. Artificial turf shall not be installed in or be visible from a public or private right-of-way.
 - vi. Artificial turf may be used in combination with living plants as part of a landscape design, but artificial turf shall not by itself constitute landscaping.
- b) Locational criteria.
- i. Residential and commercial uses. Residential and commercial properties are subject to the following additional criteria:
 1. After building coverage, hardscaping areas, and minimum open space requirement areas are subtracted from the total lot area, no more than 15 percent of the remaining lot area may be comprised of artificial turf.
 2. Artificial turf is allowed in rear and interior side yards, and in side street yards when shielded from view. Artificial turf may also be used in conjunction with driveway pavers.
 - ii. Recreational uses. Artificial turf is allowed in recreational use areas, and is not required to be shielded from view.
 - iii. Historic. On properties located within a Historic District or on Individually Designated Sites, as listed on the Local Register of Historic Places, artificial turf is only allowed in rear and side yards and must be shielded from view.

The subject request includes artificial turf with a checkerboard style design proposed in the rear of the main structure surrounding the pool area in the backyard. As the structure is located within an historic district, the location of the proposed turf in the rear yard is considered appropriate and can be considered to meet the requirements. However, open space calculations on the plans and site data table need to be updated to ensure the minimum 25% open space requirements match the revisions being made to the property. This item has been added as a site plan technical item.

SECRETARY OF THE INTERIORS STANDARDS

Pursuant to LDR Section 4.5.1(E)(5) - Standards and Guidelines: a historic site, building, structure, improvement, or appurtenance within a historic district shall only be altered, restored, preserved, repaired, relocated, demolished, or otherwise changed in accordance with the Secretary of the Interior's Standards for Rehabilitation, and the Delray Beach Historic Preservation Design Guidelines, as amended from time to time.

Standard 1

A property shall be used for its historic purpose or be placed in a new use that requires minimal change to the defining characteristics of the building and its site and environment.

Standard 2

The historic character of a property shall be retained and preserved. The removal of historic materials or alteration of features and spaces that characterize a property shall be avoided.

Standard 3

Each property shall be recognized as a physical record of its time, place, and use. Changes that create a false sense of historical development, such as adding conjectural features or architectural elements from other buildings, shall not be undertaken.

Standard 4

Most properties change over time; those changes that have acquired historic significance in their own right shall be retained and preserved.

Standard 5

Distinctive features, finishes, and construction techniques or examples of craftsmanship that characterize a historic property shall be preserved.

Standard 6

Deteriorated historic features shall be repaired rather than replaced. Where the severity of deterioration requires replacement of a distinctive feature, the new feature shall match the old in design, color, texture, and other visual qualities and, where possible, materials. Replacement of missing features shall be substantiated by documentary, physical, or pictorial evidence.

Standard 7

Chemical or physical treatments, such as sandblasting, that cause damage to historic materials shall not be used. The surface cleaning of structures, if appropriate, shall be undertaken using the gentlest means possible.

Standard 8

Significant archeological resources affected by a project shall be protected and preserved. If such resources must be disturbed, mitigation measures shall be undertaken.

Standard 9

New additions, exterior alterations, or related new construction shall not destroy historic materials that characterize the property. The new work shall be differentiated from the old and shall be compatible with the massing, size, scale, and architectural features to protect the historic integrity of the property and its environment.

Standard 10

New additions and adjacent or related new construction shall be undertaken in such a manner that if removed in the future, the essential form and integrity of the historic property and its environment would be unimpaired.

The subject request is for the reconstruction of the existing brick chimney on the existing historic structure and other exterior and site modifications. As previously noted, the chimney frame has already been reconstructed prior to the submittal of the subject COA request. Regarding Standard 1, 2, and 3, the historic character of the property is that of a 2-story Frame Vernacular style structure constructed in 1939. The use of the property will remain as a single-family residence as it was traditionally used, so the property will be used as its original historic purpose. With respect to the reconstruction of the chimney, the use of the original brick material on the exterior of the chimney will ensure the integrity of the historic structure is not diminished.

With regard to Standard 5, the proposed material to be used on the exterior of the chimney will be the existing brick from the original chimney. In addition, the proposed railings on the front porch and rear stairs of the main structure will match the design of the railings existing on the residence. The proposed tile wall for the summer kitchen to the rear of the main structure will be concrete block with a ceramic tile added to the exterior. Also the new fences and gate will be white aluminum to match what is existing

and approved for the site, with gate columns to be concrete. Previously approved marble pavers to the rear of the main structure surrounding the pool will be replaced with shellock pavers and artificial turf. Other exterior modifications include a change of the color to the façade, trim, and existing fabric awnings. There are no concerns with any of the proposed materials as they can be considered appropriate to the property and the historic streetscape.

Pursuant to LDR Section 4.5.1I(7) – Visual Compatibility Standards: new construction and all improvements to both contributing and noncontributing buildings, structures, and appurtenances thereto within a designated historic district or on an individually designated property shall be visually compatible. In addition to the Zoning District Regulations, the Historic Preservation Board shall apply the visual compatibility standards provided for in this Section with regard to height, width, mass, scale, façade, openings, rhythm, material, color, texture, roof shape, direction, and other criteria set forth elsewhere in Section 4.5.1. Visual compatibility for minor and major development as referenced in Section 4.5.1I(2) shall be determined by utilizing criteria contained in (a)-(m) below.

- a. **Height:** The height of proposed buildings or modifications shall be visually compatible in comparison or relation to the height of existing structures and buildings in a historic district for all major and minor development. For major development, visual compatibility with respect to the height of residential structures, as defined by 4.5.1I(2)(a), shall also be determined through application of the Building Height Plane.
- b. **Front Facade Proportion:** The front facade of each building or structure shall be visually compatible with and be in direct relationship to the width of the building and to the height of the front elevation of other existing structures and buildings within the subject historic district.
- c. **Proportion of Openings (Windows and Doors):** The openings of any building within a historic district shall be visually compatible with the openings exemplified by prevailing historic architectural styles of similar buildings within the district. The relationship of the width of windows and doors to the height of windows and doors among buildings shall be visually compatible within the subject historic district.
- d. **Rhythm of Solids to Voids:** The relationship of solids to voids of a building or structure shall be visually compatible with existing historic buildings or structures within the subject historic district for all development, with particular attention paid to the front facades.
- e. **Rhythm of Buildings on Streets:** The relationship of buildings to open space between them and adjoining buildings shall be visually compatible with the relationship between existing historic buildings or structures within the subject historic district.
- f. **Rhythm of Entrance and/or Porch Projections:** The relationship of entrances and porch projections to the sidewalks of a building shall be visually compatible with existing architectural styles of entrances and porch projections on existing historic buildings and structures within the subject historic district for all development.
- g. **Relationship of Materials, Texture, and Color:** The relationship of materials, texture, and color of the facade of a building and/or hardscaping shall be visually compatible with the predominant materials used in the historic buildings and structures within the subject historic district.
- h. **Roof Shapes:** The roof shape, including type and slope, of a building or structure shall be visually compatible with the roof shape of existing historic buildings or structures

within the subject historic district. The roof shape shall be consistent with the architectural style of the building.

- i. **Walls of Continuity:** Walls, fences, evergreen landscape masses, or building facades, shall form cohesive walls of enclosure along a street to ensure visual compatibility with historic buildings or structures within the subject historic district and the structure to which it is visually related.
- j. **Scale of a Building:** The size of a building and the building mass in relation to open spaces, windows, door openings, balconies, porches, and lot size shall be visually compatible with the building size and mass of historic buildings and structures within a historic district for all development. To determine whether the scale of a building is appropriate, the following shall apply for major development only:
 - a. For buildings wider than sixty percent (60%) of the lot width, a portion of the front façade must be setback a minimum of seven (7) additional feet from the front setback line:
 - b. For buildings deeper than fifty percent (50%) of the lot depth, a portion of each side façade, which is greater than one story high, must be setback a minimum of five (5) additional feet from the side setback line:
- k. **Directional Expression of Front Elevation:** A building shall be visually compatible with the buildings, structures, and sites within a historic district for all development with regard to its directional character, whether vertical or horizontal.
- l. **Architectural Style:** All major and minor development shall consist of only one (1) architectural style per structure or property and not introduce elements definitive of another style.
- m. **Additions to individually designated properties and contributing structures in all historic districts:** Visual compatibility shall be accomplished as follows:
 - 1. Additions shall be located to the rear or least public side of a building and be as inconspicuous as possible.
 - 2. Additions or accessory structures shall not be located in front of the established front wall plane of a historic building.
 - 3. Characteristic features of the original building shall not be destroyed or obscured.
 - 4. Additions shall be designed and constructed so that the basic form and character of the historic building will remain intact if the addition is ever removed.
 - 5. Additions shall not introduce a new architectural style, mimic too closely the style of the existing building nor replicate the original design but shall be coherent in design with the existing building.
 - 6. Additions shall be secondary and subordinate to the main mass of the historic building and shall not overwhelm the original building.

With regard to **Relationship of Materials, Texture, and Color**, the proposed reconstruction of the chimney will utilize the existing chimney brick. The proposed new white aluminum railings for the front porch and rear stairs will match exactly what is existing/Previously approved on the structure. The proposed wall for the outdoor summer kitchen will be concrete block with 8x8 ceramic tile in Capri. The proposed house color will be Iceberg 2122-50, trim to be Chantilly Lace OC-65, shutters to be Denim Wash CC-770, and front door to be Kensington Blue 840. The existing fabric awnings will be replaced with colors to be white and blue to match the structure.

Additionally, a new walkway is proposed to the front of the property and the paver materials throughout the site are proposed to be changed from marble to shellock. Artificial turf is also proposed to the rear of the property. There are no concerns with these hardscape alterations as the paver material and

location of the artificial turf is appropriate to the site and can be considered visually compatible with other materials within the historic district. Regarding **Walls of Continuity**, white aluminum fencing and driveway gate are proposed on the front (east) and side street (south) sides of the property. The gates and columns are proposed at 5' when the requirements are 4'. A site plan technical item has been included for the gates and columns not to exceed 4' in height within the front setback.

COMPREHENSIVE PLAN

Pursuant to the Historic Preservation Element (HPE), Objective 1.4, Historic Preservation Planning: Implement appropriate and compatible design and planning strategies for historic sites and properties within historic districts.

The objective shall be met through continued adherence to the City's Historic Preservation Ordinance and, where applicable, to architectural design guidelines through the following policies:

HPE Objective 1.4 - Property shall be developed or redeveloped, in a manner so that the future use, intensity and density are appropriate in terms of soil, topographic, and other applicable physical considerations; encourage affordable goods and services; are complementary to and compatible with adjacent land uses; and fulfill remaining land use needs.

The development proposal involves the request for the reconstruction of a chimney and other exterior modifications. There are no concerns with respect to soil, topographic or other physical considerations. With respect to the adjacent land uses, the property is in an historic district that is comprised of single-family and multi-family uses. The board will need to make a determination that the proposal can be found to be consistent with the requirements of this Comprehensive Plan Policy.

Historic Preservation Element 1.4.1 Prior to approval or recommending approval of any land use or development application for property located within a historic district or designated as a historic site, the Historic Preservation Board must make a finding that the requested action is consistent with the provisions of Section 4.5.1 of the Land Development Regulations relating to historic sites and districts and the "Delray Beach Design Guidelines".

The development proposal involves a request for reconstruction of the existing chimney and other exterior modifications to a contributing single-family residence. The board will need to make a determination that the alterations are consistent with the requirements of the Comprehensive Plan, and the provisions of LDR Section 4.5.1 relating to historic sites and districts as well as the "Delray Beach Historic Preservation Design Guidelines".

SITE PLAN TECHNICAL ITEMS

1. That the site plan utilizes an architect scale that matches the survey.
2. That dimensions for the proposed tile wall be included on the detail drawings and elevations.
3. That the proposed tile wall for approved summer kitchen be illustrated on all elevations.
4. That the proposed driveway be dimensioned 5' from the property line to meet drainage requirements.
5. That the open space calculations be updated on the plans to ensure the site meets minimum LDR requirements.
6. That the sliding driveway gate meets minimum stacking distance requirements.
7. That the sliding driveway gate meets minimum site visibility requirements.
8. That all fences, gates, and columns within the front setback be at the required 4'.

9. That the site data table be updated on the plans and supplemental data form to include open space update due to the use of artificial turf.
10. That the proposed material for the reconstruction of the chimney be consistent throughout the application.


ALTERNATIVE ACTIONS

- A. Move to continue with direction.
- B. Approve Certificate of Appropriateness (2024-134), for the property located at **170 Marine Way, Marina Historic District**, by finding that the request and approval thereof is consistent with the Comprehensive Plan and meets the criteria set forth in the Land Development Regulations.
- C. Approve Certificate of Appropriateness (2024-134), for the property located at **170 Marine Way, Marina Historic District** by finding that the request and approval thereof is consistent with the Comprehensive Plan and meets the criteria set forth in the Land Development Regulations, subject to the following conditions:
- D. Deny Certificate of Appropriateness (2024-134), for the property located at **170 Marine Way, Marina Historic District**, by finding that the request is inconsistent with the Comprehensive Plan and does not meet the criteria set forth in the Land Development Regulations.


PUBLIC AND COURTESY NOTICES

Courtesy Notices were provided to the following, at least 5 working days prior to the meeting:
 Marina Historic District Homeowners Association


Public Notices are not required for this request.
 Agenda was posted on 5/29/24, 5 working days prior to meeting.

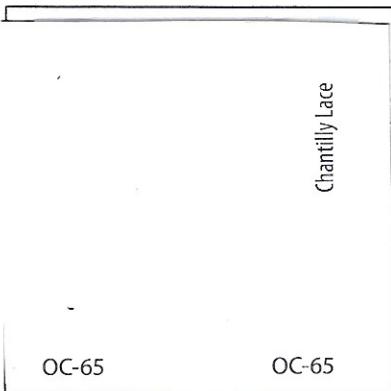

TRIM COLOR
BENJAMIN MOORE
CHANTILLY LACE - OC-65

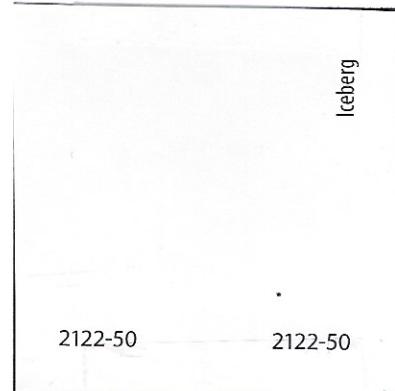

MAIN BODY COLOR
BENJAMIN MOORE,
ICEBERG - 2122-50

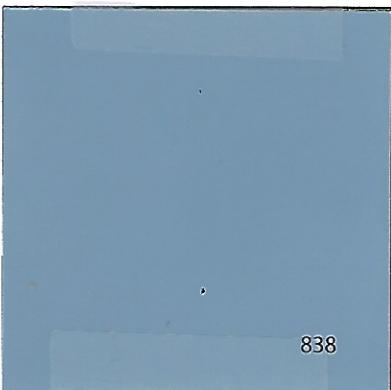

SHUTTER COLOR
BENJAMIN MOORE
DENIM WASH - OC-770



FRONT DOOR COLOR
BENJAMIN MOORE
KENSINGTON - 840



Steplock | Shellock

[« Products](#)[Steplock](#) [Roadlock](#) [Coping](#) [Granitelock](#) [Shellock](#) [Desertlock](#) [Corallock](#) [Limestonelock](#) [Stonelock](#) [Planklock](#) [Pedestals](#) [Limited Editions](#) [Antique](#)

Shellock

Seashells mixed in each paver and then polished to expose the beauty of the shells.

Application: 

Steplock® Shellock pavers are designed for pedestrian applications including patios, swimming pool decks, lanais, walkways and more. Steplock® pavers and coping are also excellent for architectural and decorative uses, including raised walls, pool coping, steps, spillways, fountains, planters and benches. Artistic Paver's coordinating deck pavers, coping and specialty pieces not only give your project a great look, but they also make an easy sand-set installation, saving you time and money.

Finishes: Polished, Polished & Antiqued



Ivory

16 x 16 "



Polished Polished & Antiqued

[Gallery](#)[Brochure](#)

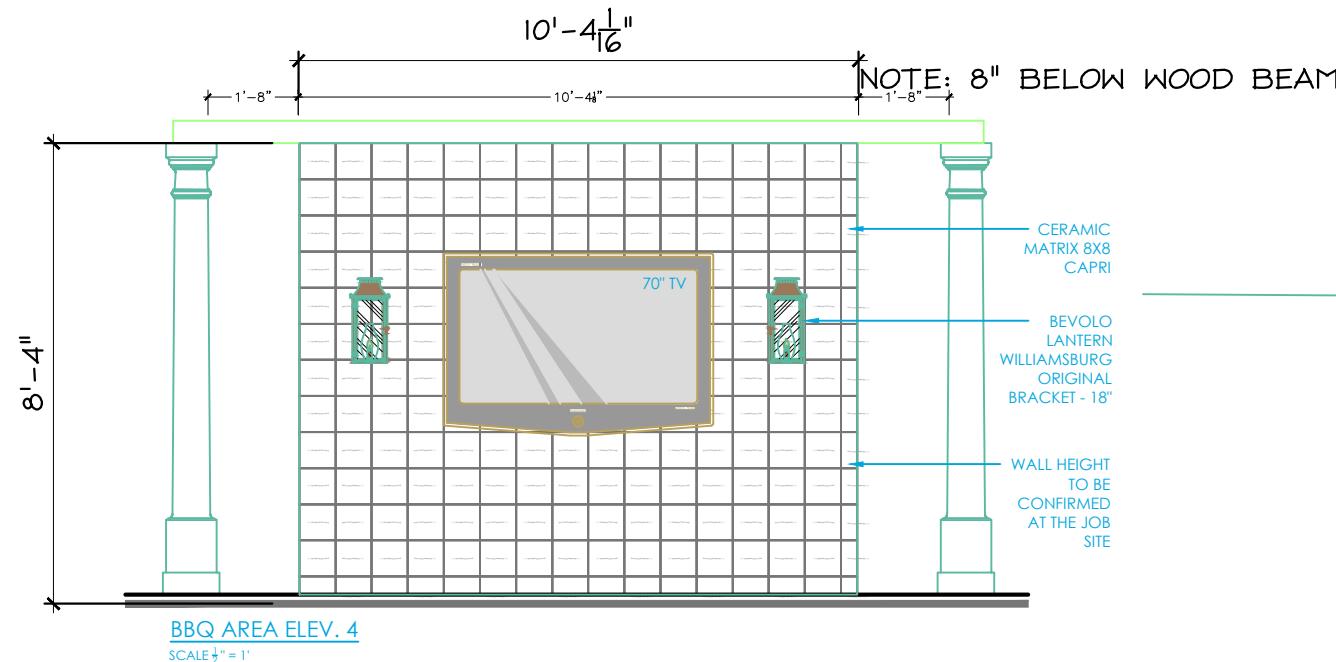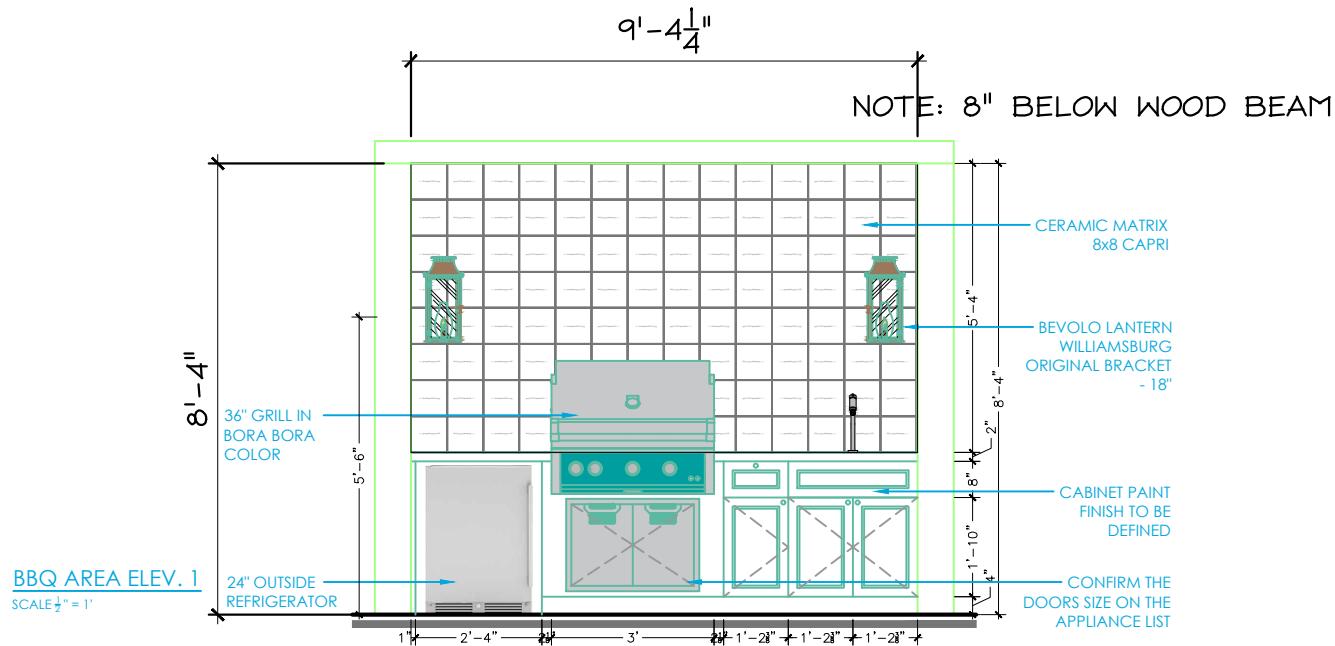

WALL ELEVATION UNDER BBQ



EAST / FRONT ELEVATION
2024-04-11



NORTH / LEFT ELEVATION
2024-04-11



NORTH / LEFT ELEVATION
2024-04-11



WEST / REAR ELEVATION
2024-04-11



WEST / REAR ELEVATION
2024-04-11



SOUTH / RIGHT ELEVATION
2024-04-11



SOUTH / RIGHT ELEVATION
2024-04-11

PAUL CHARETTE A.I.A.
LICENSE AR0016279

MARK HUNLEY A.I.A.
LICENSE AR0099784

THIS ITEM HAS BEEN
ELECTRONICALLY SIGNED
AND SEALED BY MARK
CHARETTE ON THE DATE
ADJACENT TO THE SEAL
USING A SHA AUTHENTICATION
CODE. PRINTED COPIES OF THIS
DOCUMENT ARE NOT
CONSIDERED SIGNED AND THE SHA
AUTHENTICATION CODE
MUST BE VERIFIED ON ANY
ELECTRONIC COPIES.

paul@charettearch.com
mark@charettearch.com
954-756-6094
954-809-9802
www.charettearch.com

**CHARETTE
INTERNATIONAL
ARCHITECTURE**
551 NW 77TH ST SUITE 107
BOCA RATON, FL 33487

ANGIE PORTER
170 MARINE WAY
DELRAY BEACH, FL
2023-114

STARTED:
PRELIM:
PRELIM 2: 8-8-23
PRELIM 3:
PRELIM FINAL:
CONST DOCS: 8-30-23
BLDG DEPT: 9-18-23
BLDG DEPT: 10-10-23
BLDG DEPT: 10-17-23
HISTORICAL REV: 2-17-24

ISSUED:
SHEET

A9

PORTER RESIDENCE

HPB REVISION SUBMITTAL

PAUL CHARETTE A.I.A.
LICENSE AR0016279

MARK HUNLEY A.I.A.
LICENSE AR0099784

THIS ITEM HAS BEEN
ELECTRONICALLY SIGNED
AND SEALED BY MARK
HUNLEY OR PAUL
CHARETTE ON THE DATE
ADJACENT TO THE SEAL
USING SHA256
AUTHENTICATION CODE.
PRINTED COPIES OF THIS
DOCUMENT ARE NOT
CONSIDERED SIGNED AND
SEALED AND THE SHA
AUTHENTICATION CODE
MUST BE VERIFIED ON ANY
ELECTRONIC COPIES.

GENERAL NOTES	
1. ALL WORK SHALL CONFORM TO THE REQUIREMENTS OF THE FLORIDA BUILDING CODE 2020 7TH EDITION	
2. ALL DIMENSIONS & CONDITIONS SHALL BE VERIFIED IN THE FIELD BY THE CONTRACTOR BEFORE PROCEEDING WITH WORK. FIGURED DIMENSIONS TAKE PRECEDENCE OVER SCALE DIMENSIONS AT ALL TIMES.	
3. THE DESIGNER SHALL BE NOTIFIED IMMEDIATELY OF ANY DISCREPANCIES, ERRORS AND/OR OMISSIONS ON THE PLANS.	
4. CONTRACTOR SHALL ADHERE TO THE REQUIREMENTS OF F.B.C. CHAPTER 33 FOR SAFETY STANDARDS PERTAINING TO CONSTRUCTION PROCEDURES, I.E. EXCAVATION, STORAGE OF MATERIALS, SCAFFOLDS, SAFEGUARDS, TEMP. STAIRS.	
5. ALL CEILING HEIGHTS ON FIRST FLOOR ARE TAKEN FROM 0'-0"	
6. ALL CEILING HEIGHTS ON SECOND FLOOR ARE TAKEN FROM TOP OF SUB FLOOR OR BYP-CRETE.	
NON-BEARING INTERIOR PARTITIONS	
1. ALL INT NON BEARING PARTITIONS SHALL BE METAL OR WOOD STUDS & RUNNERS OF EACH SIDE OR SHAPE OF P.T. WOOD. HOT DIPPED GALV. WITH 1/2" MIN. GYP BRD BACK SIDE. SPAN 16' OVER DRYWALL SUPPORTS SHALL NOT EXCEED 24" C/C. FIRESTOP SHALL BE PROVIDED AT CEILINGS AND FLOOR LEVELS AND AT MID HGT. NOT TO EXCEED 8' HEIGHT.	
2. NON-BEARING INTERIOR PARTITION BASE TRACK ATTACHED WITH POWER ACTUATED TO FASTENERS 16" o.c. & 1.5" LONG. (TYPICAL UNLESS NOTED OTHERWISE)	
ANCHORAGE	
1. METAL & WIRE LATH- FASTENING SHALL BE PER F.B.C. 2020 CHAPTER 25 SECTION 2503.3. LATH & WIRE MUST BE SUPPORTED IN ACCORDANCE WITH 24" C/C HEIGHT & 5.7" FT. IN AREA. THE GROUND FLOOR OPENINGS HAVE A MIN. 5.0 SQ. FT. IN AREA. THE BOTTOM OF THE OPENING SHALL NOT BE MORE THAN 44" OFF THE FLOOR & NO PART OF THE OPERATING MECHANISM SHALL BE PLACED HIGHER THAN 54" ABOVE FINISHED FLOOR.	
2. WINDOWS INDICATED AS EGRESS MUST BE MANUFACTURED TO CONFORM TO THE BUILDING CODE WITH RESPECT TO MINIMUM EMERGENCY EGRESS REQUIREMENTS PER N.F.P.A. 101 CHAPTER 24-2.	
3. ALL WINDOWS SHALL MEET EGRESS, LIGHT & VENTILATION REQUIREMENTS.	
4. OPERATING MECHANISMS ON SINGLE HUNG WINDOWS SHALL BE AT OR NEAR THE SILL.	
5. PROVIDE TEMPERED GLASS @ ALL OPENINGS WITHIN 24" OF ALL DOORS.	
6. PROVIDE THRESHOLD & WEATHERSTRIPPING @ ALL EXTERIOR DOORS.	
7. ALL FIXED GLASS SHALL MEET THE REQUIREMENTS OF THE F.B.C. 2020 CHAPTER 24.	
8. ALL DOOR & WINDOW BUCKS SHALL BE ANCHORED WITH 1-3/8" X .099" (BOSTITCH, HITACHI, Hilti, ATWOOD, etc.) CONCRETE SHOT PEWEE NAILS @ 6" C/C STAGGERED. U.N.O. ALUMINUM SASH SHALL BE ANCHORED W/ 3/16" CORROSION RESISTANCE APPROVED CONCRETE SCREW ANCHORS W/MIN. 1-1/4" EMBEDMENT INTO BLOCK/CONC. ANCHORAGE IS DESIGNED TO ACCEPT MAX. 3/16" FIXED GLASS & 3/16" BUTT SWEEP GLASS (MAX 49 SQ. FT. GLASS) 5/8" DOOR INBS SHALL BE FASTENED TO BUCKS W/ (2) #10 FINISH NAILS (SIDE BY SIDE) SPACED @ 18" C/C.	
9. ALL SLIDING GLASS DOORS & FRENCH DOORS SHALL BE TEMP. PER F.B.C. 2020 CHAPTER 24.	
10. FRAME TO BUCK TOLERANCE SHALL BE PER WINDOW MFGR. BUCK TO OPENING TOLERANCE SHALL BE MAX. 1/4" TOTAL OPENING.	
11. ALL GARAGE DOOR BUCKS (HEADER & JAMB) SHALL BE MIN. 2 X 6 P.T. WOOD ATTACHED W/ 1/4" O TAP-CON @ 18" C/C STAGGERED (MIN. 1-3/4" EMBEDMENT) PROVIDE WASHER @ EACH ANCHOR. IF ANCHOR HAS WASHER INTEGRAL W/ HEAD PROVIDE ADDITIONAL WASHER.	
12. MANUFACTURERS METHODS OF ATTACHMENT SHALL PREVAIL WHEN SUBMITTED WITH COMPLETE INSTRUCTIONS.	
FINISHES	
1. MIRRORS IN EXCESS OF 9 S.F. SHALL BE DIRECTLY SECURED TO SUPPORTS & SHALL NOT BE HUNG. NOTE: MIRROR INSTALLATION PER MFGR. SPECIFICATIONS	
2. SHOWER COMPARTMENT WALLS TO 72" A.F.F. & BATHROOM FLOORS & BASE SHALL BE IMPERVIOUS MATERIALS PER F.B.C. 2020 RESIDENTIAL CHAPTER 3 SECTION 307.2. TILE SELECTION BY OWNER.	
3. ALL WATER CLOSETS & LAVATORIES SHALL HAVE 18" MIN. CLEARANCE IN FRONT OF FIXTURE FROM THE CENTER LINE OF FIXTURE & 15" TO ANY SIDE FIXTURE OR FINISHED SURFACE PER F.B.C. 2020 RESIDENTIAL CHAPTER 3 SECTION 307.2.	
4. ALL SHOWERS SHALL HAVE MIN. 900 SQ. IN. CLEAR FINISH W/ 30" MIN. DIM.	
5. PROVIDE TEMPERED GLASS @ ALL TUB & SHOWER ENCLOSURES.	

LEGAL DESCRIPTION

LOT 15, A SUBDIVISION OF BLOCK 126, DELRAY, FLORIDA,
ACCORDING TO THE PLAT THEREOF, AS RECORDED IN PLAT
BOOK II, PAGE 4 OF THE PUBLIC RECORDS OF PALM BEACH
COUNTY, FLORIDA.

FLOOD ZONE

FLOOD ZONE: AE
ELEVATION: 6'
CITY OF DELRAY BEACH
I20196
PANEL NUMBER: I2099C
0979F
EFFECTIVE DATE: 10-05-17

ZONING

RM (R-1 -1A FOR SINGLE
FAMILY) -
"HISTORIC MARINA DISTRICT"
LOCAL REGISTER "THE MARINA HOUSE"

SETBACKS:

REQUIRED MAIN HOUSE:	
FRONT	25'-0"
SIDE STREET	15'-0"
SIDE INTERIOR	7'-6"
REAR	10'-0"
ROOF HT.	35'-0" (TO MEAN ROOF HEIGHT)

REQUIRED ACCESSORY STRUCTURE:	
FRONT	25'-0"
SIDE STREET	15'-0"
SIDE INTERIOR	7'-6"
REAR	10'-0"
ROOF HT.	35'-0" (TO MEAN ROOF HEIGHT)

FLOOR AREA/ BUILDING SQ FT CALC.

MAIN HOUSE:

EXISTING GROUND FLOOR AC	1066 SQ FT
EXISTING 2ND FLOOR AC	535 SQ FT
EXISTING COV FRONT PORCH	150 SQ FT

EXISTING

TOTAL 1751 SQ FT

APPROVED

PROPOSED GROUND FLOOR AC	82 SQ FT
PROPOSED 2ND FLOOR AC	177 SQ FT
PROPOSED COVERED PATIO	119 SQ FT

APPROVED PROPOSED

TOTAL 2121 SQ FT
NO CHANGE

LOT AREA:

LOT SIZE 61.01' X 143.0'
LOT AREA 8,709 SQ FT

OPEN SPACE:

REQUIRED: 25% = 2177 SQ FT
PROVIDED: 53% = 4585 SQ FT

BUILDING COVERAGE

EXISTING: 2081 SQ FT = 24.4
PROPOSED APPROVED: 1853 SQ FT = 29.3

TYPE OF CONSTRUCTION

R3- SINGLE FAMILY
TYPE VBUNPROTECTED
ALTERATION - LEVEL 2

APPLICABLE CODES

2020 FLORIDA BUILDING CODE
2020 FLORIDA PLUMBING CODE
2020 FLORIDA ELECTRICAL CODE
2020 FLORIDA MECHANICAL CODE

ALLOWABLE AREA

RESIDENTIAL, GROUP R2 / 7,000 S.F.

PARKING:

2 SPACES REQUIRED
5 SPACES PROVIDED NO CHANGE

SITE CHANGES

PROPOSED DRIVEWAY GATE/POSTS
MAN GATE/POSTS FENCE ON RETAINING WALL
NEW 50 SQ FT WALK WAY
WALL UNDER BBQ AS BACKPLASH
WALL UNDER COVERED PATIO


THIS DRAWING IS NOT FOR CONSTRUCTION,
IT HAS BEEN ISSUED FOR GOVERNMENTAL
REVIEW AND/OR PRELIMINARY PRICING

CIVIL ENGINEER

LDI
1860 OLD OKEECHOBEE RD
#504
WEST PALM BEACH FL
PH. (561) 615-6567

ARCHITECTS

CHARETTE
INTERNATIONAL
ARCHITECTURE
PH. (561)756-6094
paul@charettearch.com

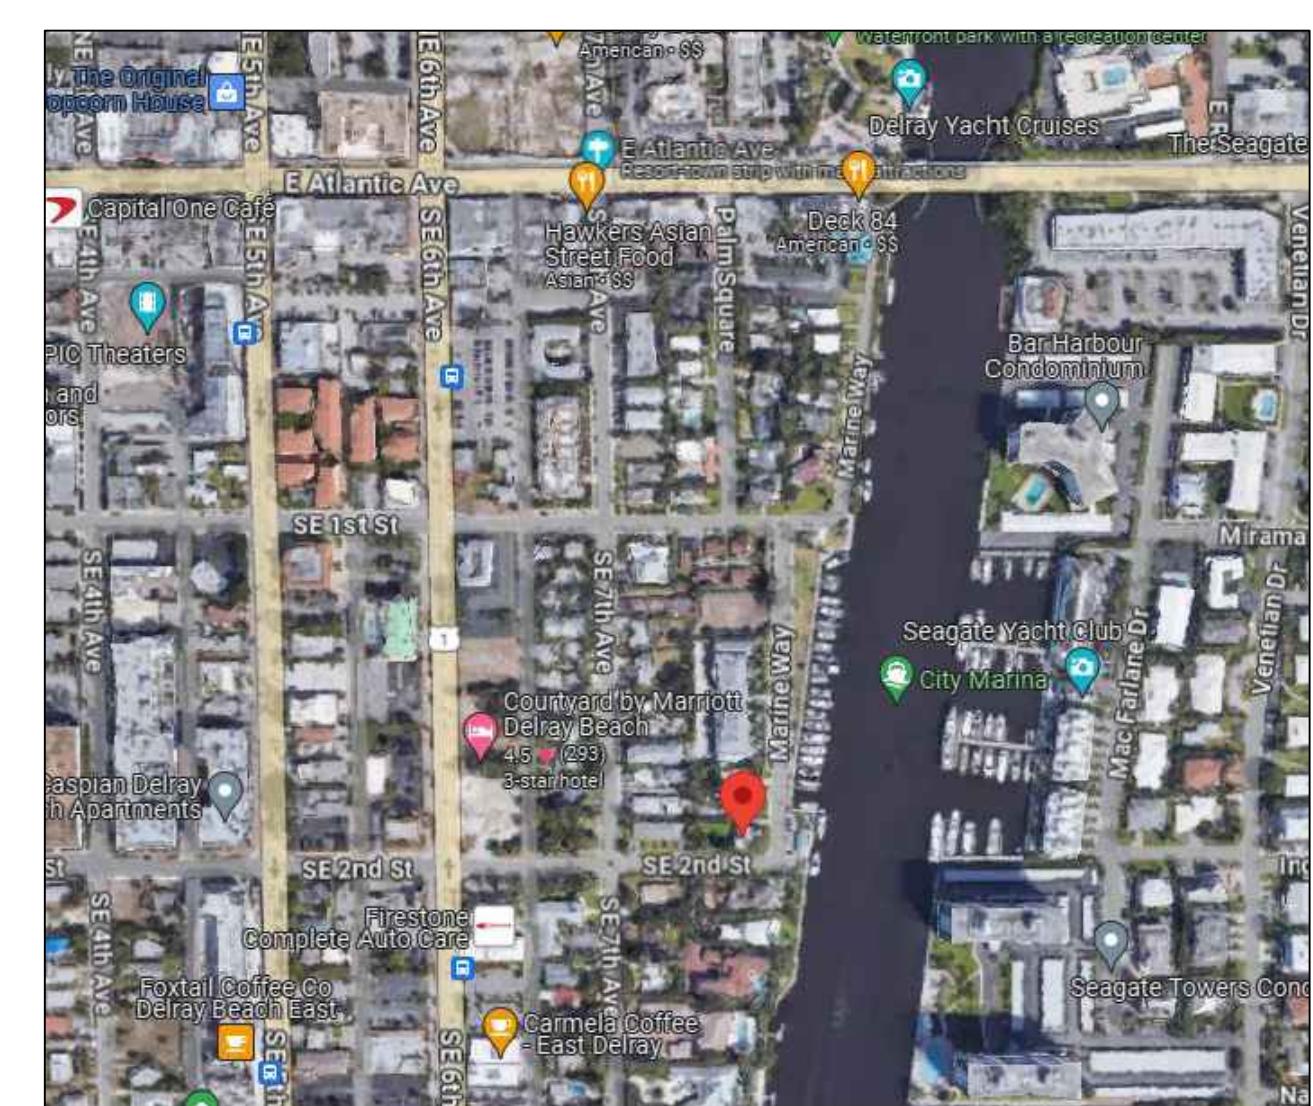


LOCATION MAP
SCALE NTS

ANGIE PORTER
170 MARINE WAY
DELRAY BEACH, FL
2023-114

STARTED:
PRELIM:
PRELIM 2:
8-8-23
PRELIM 3:
8-10-23
PRELIM FINAL:
8-12-23
CONST DOCS:
8-30-23
BLDG DEPT:
9-18-23
BLDG DEPT:
10-10-23
BLDG DEPT:
10-17-23
HISTORICAL REV:
2-17-24
3-25-24
SHEET

CVR

CHARETTE
INTERNATIONAL
ARCHITECTURE
551 NW 77TH ST SUITE 107
BOCA RATON, FL 33487
paul@charettearch.com
561-756-6094
mark@charettearch.com
954-809-9802
www.charettearch.com

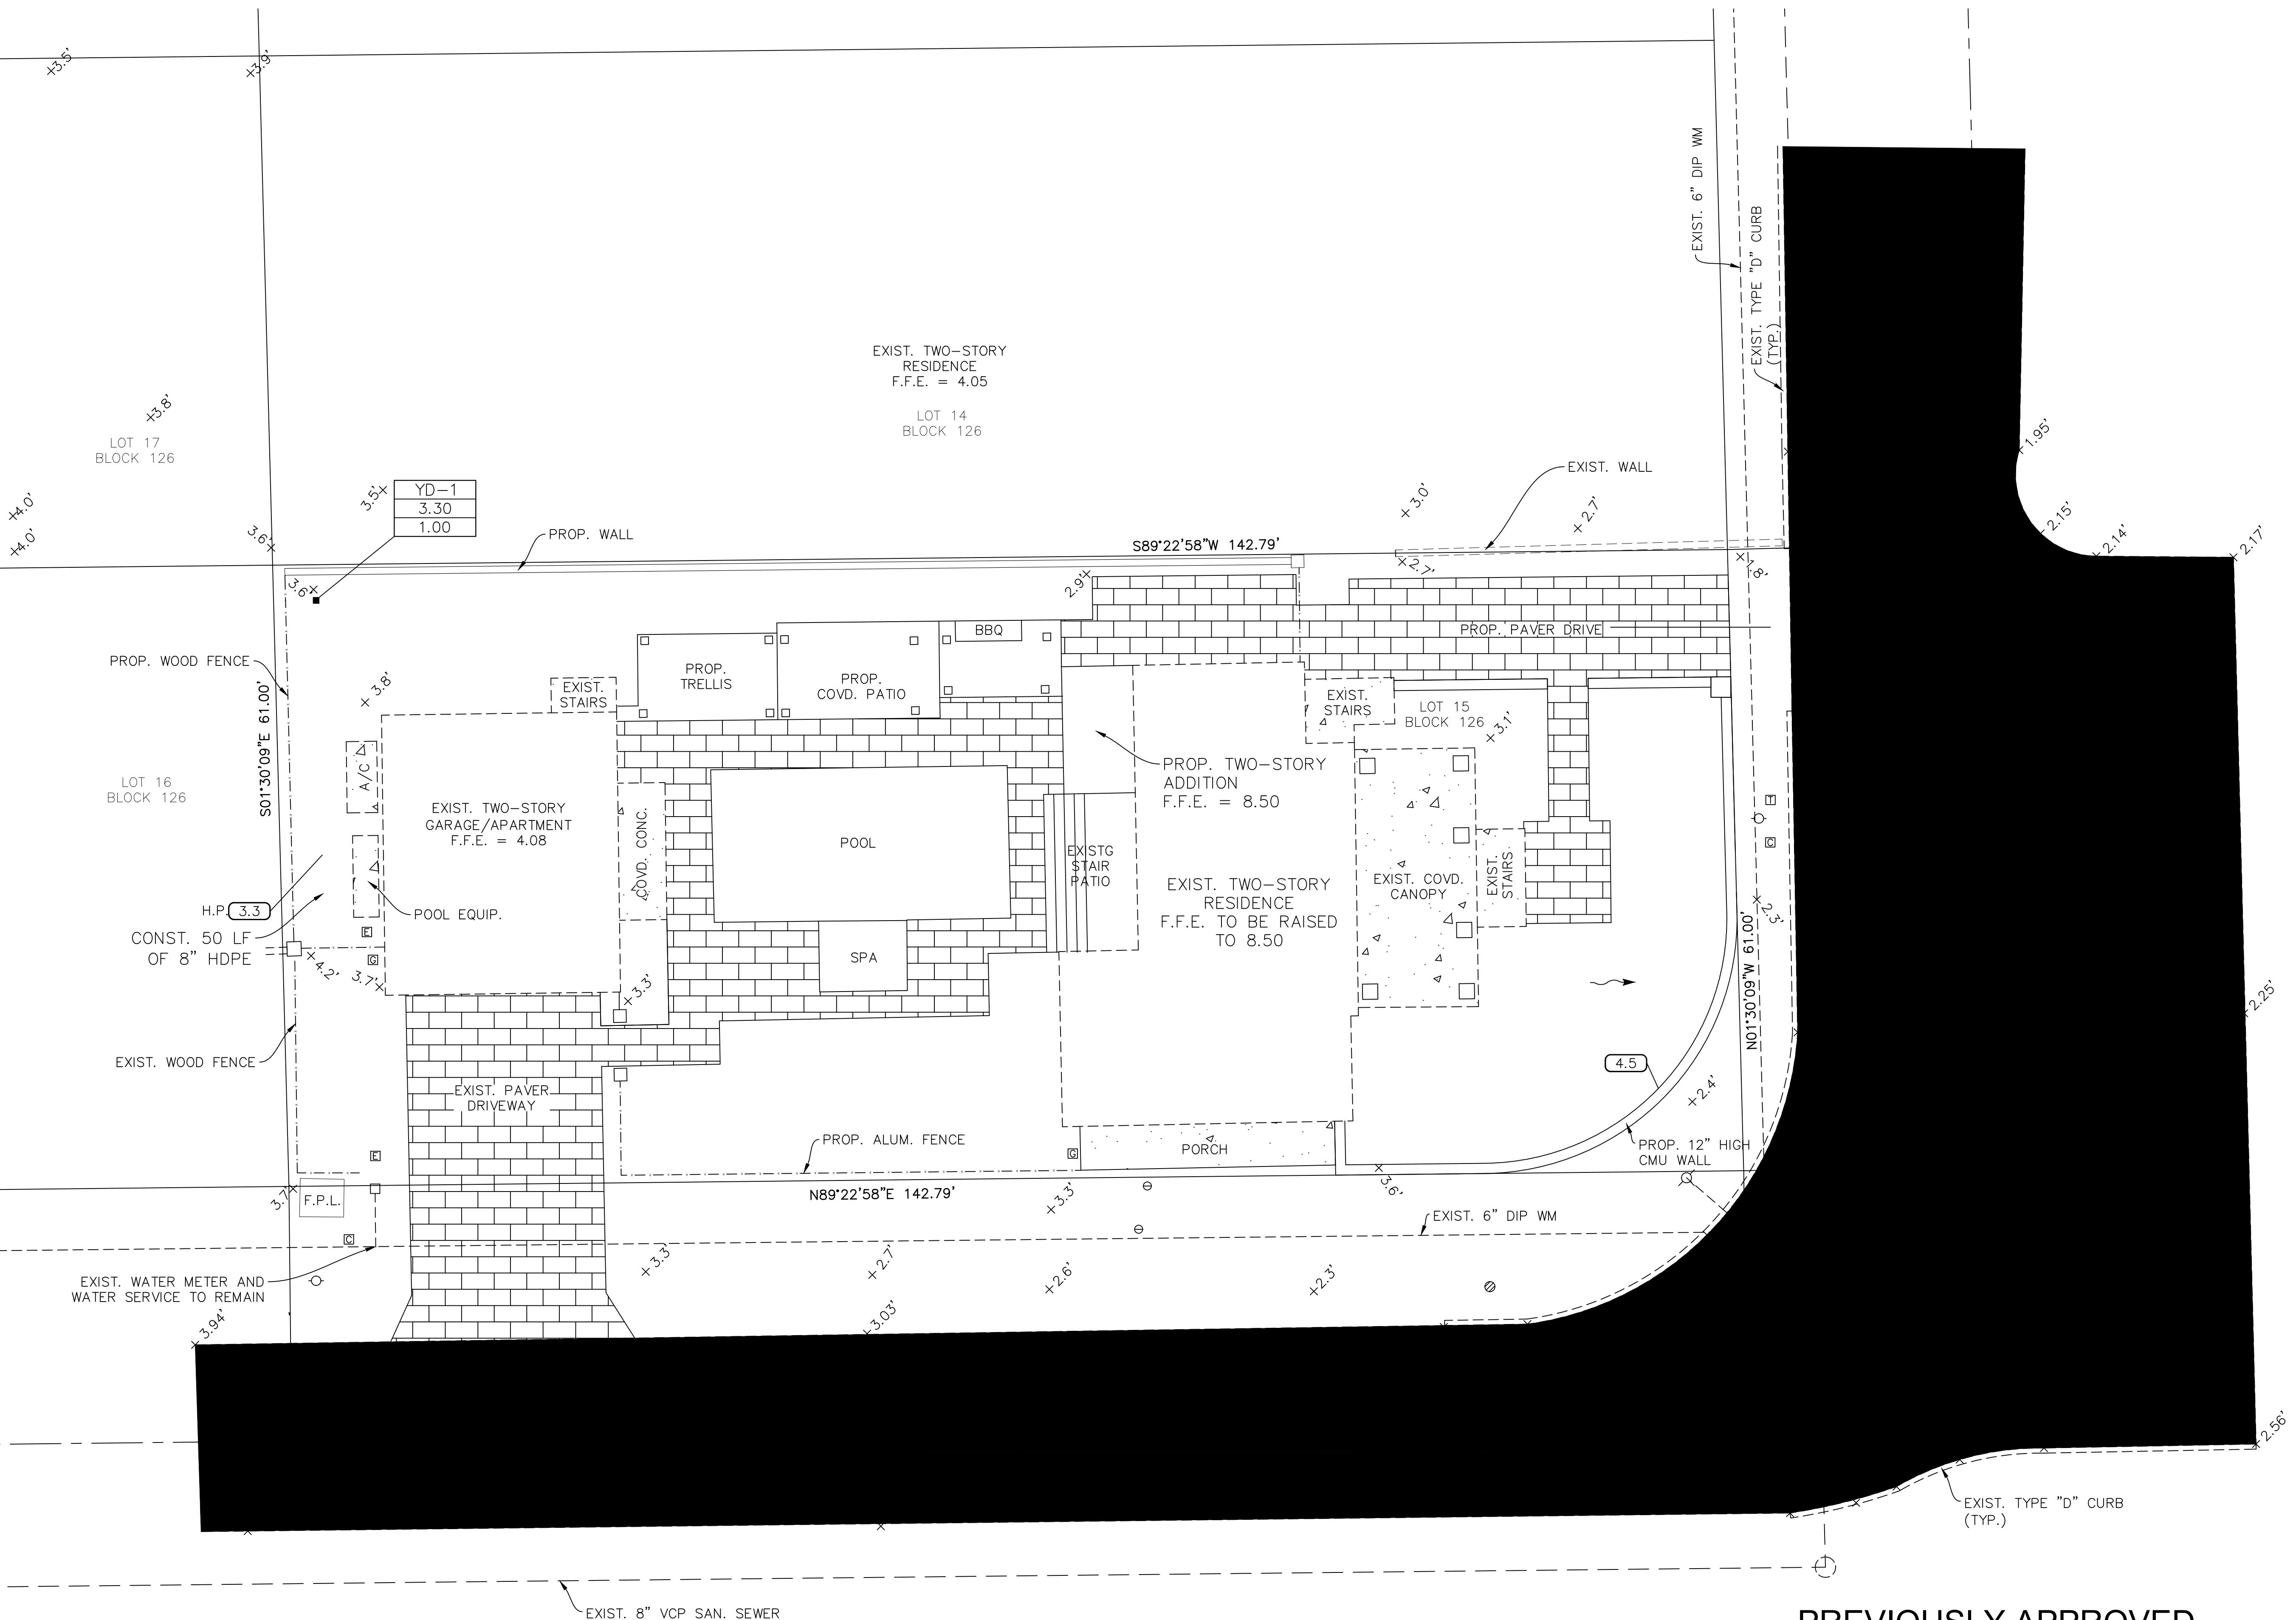

PREVIOUSLY APPROVED

SITE PLAN

CALE 1/8 " = 1'

170 MARINE WAY
DELRAY BEACH, FL

ED:
:
2: 8-8-23
3:
FINAL:
DOCS: 8-30-23
DEPT: 9-18-23
DEPT: 10-10-23
DEPT: 10-17-23

DEPT: 10-17-23
ICAL REV: 2-17-24
:
SHEET
S P I


CHARETTE A.I.A.
ENSE AR0016279

W.R. HUNLEY A.I.A.
ENSE AR0099784

TEM HAS BEEN
RONICALLY SIGNED
SEALED BY MARK
Y OR PAUL
ETTE ON THE DATE
CENT TO THE SEAL
A SHA
ENTIFICATION CODE.
ED COPIES OF THIS
MENT ARE NOT
DERED SIGNED AND
D AND THE SHA
ENTIFICATION CODE
BE VERIFIED ON ANY
TRONIC COPIES.

381-738-8094
mark@charrettearch.com
954-809-9802

**INTERNATIONAL
ARCHITECT**
551 NW 77TH ST SUITE 1
BOCA RATON, FL 33487

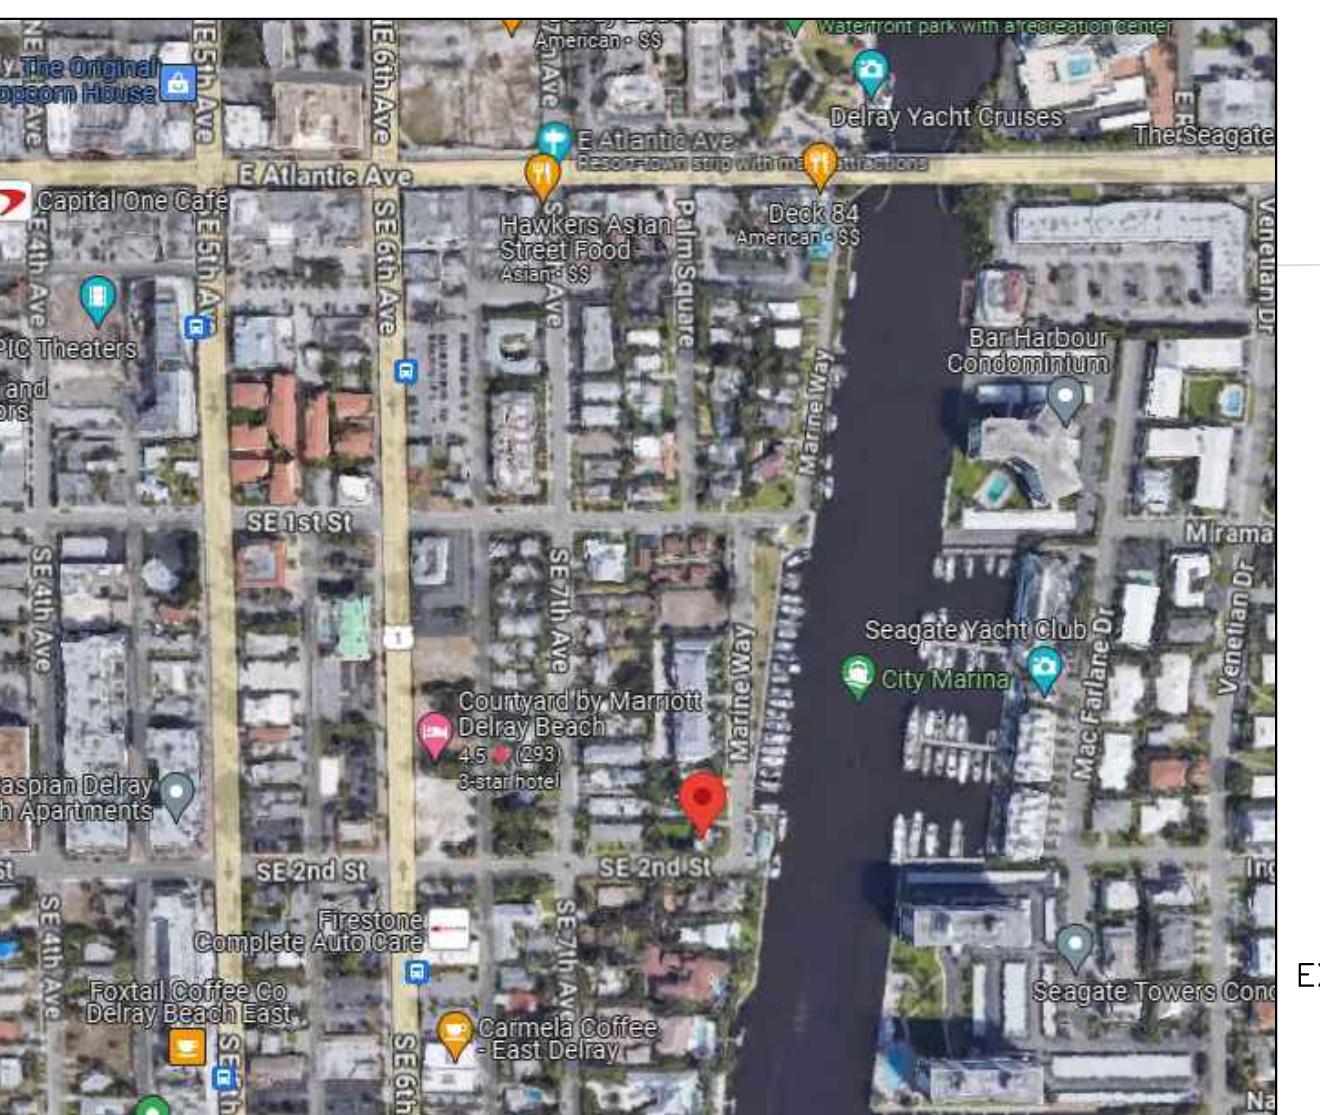

LOCATION MAP

SCALE NTS

EXIST. TWO-STORY
RESIDENCE
F.F.E. = 4.05

PROP. WO

CONST

XIST. WATER METER AND
TER SERVICE TO REMAIN

— — — — —

This architectural site plan illustrates a proposed outdoor space layout. The plan includes the following key features and dimensions:

- EXIST. TWO-STORY GARAGE/APARTMENT** (F.F.E. = 4.08) is located on the left, enclosed in a dashed red boundary.
- POOL EQUIP.** is located near the bottom left, indicated by a dashed red boundary.
- PROPS. WALL** is a proposed wall along the top edge.
- NEW BACK WALL' PATIO** is a proposed patio area.
- NEW BACK WALL' FOR BBQ** is a proposed wall for a barbecue area.
- PROPS. TRELLIS** is a proposed trellis structure.
- PROPS. COVD. PATIO** is a proposed covered patio area.
- BBQ** is a proposed barbecue area.
- EXISTING POOL** is an existing swimming pool.
- EXISTING SPA** is an existing hot tub.
- PROPS. PATIO** is a proposed patio area.
- 24" SQ W/ ART. GRASS CHECKERBOARD** indicates a pattern for paving stones.
- COV tile** indicates a pattern for paving stones.
- Dimensions:** The overall width is 29'-0" (2.9' X). The distance from the garage to the pool is 35'-0" (X 35'). The distance from the garage to the spa is 35'-3" (X 35'). The distance from the garage to the proposed patio is 35'-8" (X 35.8'). The distance from the garage to the proposed wall is 35'-8" (X 35.8').
- Handrails:** The proposed patio area features 30" handrails and 42" high rails. The spa area has 30" handrails and 45 1/2" high rails.
- Brickwork:** A brick wall is shown on the right side of the plan.

This architectural site plan illustrates the layout of a property. The property line is marked by a red line. A two-story addition is shown on the left, with dimensions of 58" W and 142.79' L. The property is identified as LOT 15, BLOCK 126. A proposed paver drive is shown on the right, with dimensions of 11' SLIDING DRIVE GATE and 2' X 2' X 5' CONC GATE POSTS. An existing canopy is located on the right side. Existing stairs are indicated on the left and right sides. A new paver walk is proposed on the right side, with dimensions of 50 SQ. FT and 1.00'. The plan also shows proposed CMU walls and a proposed two-story addition with a footprint of 30' ON C.

58" W 142.79'

FOR POOL SAFETY NEW MAIN GATE

EXIST. STAIRS

LOT 15
BLOCK 126

X 3.1'

PROP. TWO-STORY
ADDITION
F.E. = 8.50

EXIST. COVD. CANOPY

EXIST. STAIRS

2' X 2' X 5'
CONC GATE POSTS

11' SLIDING DRIVE GATE

PROP. PAVER DRIVE

2' X 2' X 5'
CONC GATE POSTS

NEW PAVER WALK
50 SQ. FT
1.00'

PRO
CMU
30"
ON C

A site plan diagram showing property boundaries (dashed red lines), a wavy line representing water, and a dashed line for a marine way. Labels include 'P. 12" HIGH WALL', 'HIGH FENCE CMU WALL', 'EXIST. PARKING AREA', 'MARINE WAY', and 'PUBLIC R/W WIDTH VARIES'. A dimension line indicates a width of 105' between two points marked with an 'X' and a '2.14' label.

P. 12" HIGH
WALL

HIGH FENCE
CMU WALL

EXIST. PARKING
AREA

MARINE WAY

PUBLIC R/W
WIDTH VARIES

105' 2.14, 2.13

EXIST.

WAVES

PROPOSE

SITE PLAN SCALE 1/8 "

ANGIE PORTER
70 MARINE WAY
DELRAY BEACH, FL

STARTED:
PRELIM:
PRELIM 2: 8-8-2
PRELIM 3:

PRELIM FINAL:
CONST DOCS: 8-30-
BLDG DEPT: 9-18-
BLDG DEPT: 10-10-
BLDG DEPT: 10-17-

ISSUED: SHEET

5 | Page

PAUL CHARETTE A.I.A
LICENSE AR0016279

MARK HUNLEY A
LICENSE AR0099

THIS ITEM HAS BEEN
ELECTRONICALLY SIGNED
AND SEALED BY MARK
HUNLEY OR PAUL
CHARETTE ON THE DATE
ADJACENT TO THE SEAL
USING A SHA
AUTHENTICATION CODE.
PRINTED COPIES OF THIS
DOCUMENT ARE NOT
CONSIDERED SIGNED AND
SEALED AND THE SHA
AUTHENTICATION CODE
MUST BE VERIFIED ON AN
ELECTRONIC COPIES.

paul@charettearch.com
561-756-6094
mark@charettearch.com
954-809-9802


CHARRETTE INTERNATIONA ARCHITECTURE

NGIE PORTER
70 MARINE WAY
ELRAY BEACH, FL

STARTED:	
PRELIM:	
PRELIM 2:	8-8-2
PRELIM 3:	
PRELIM FINAL:	
CONST DOCS:	8-30-
BLDG DEPT:	9-18-2
BLDG DEPT:	10-10-
BLDG DEPT:	10-17-

ISSUED: SHEET

5 | Page

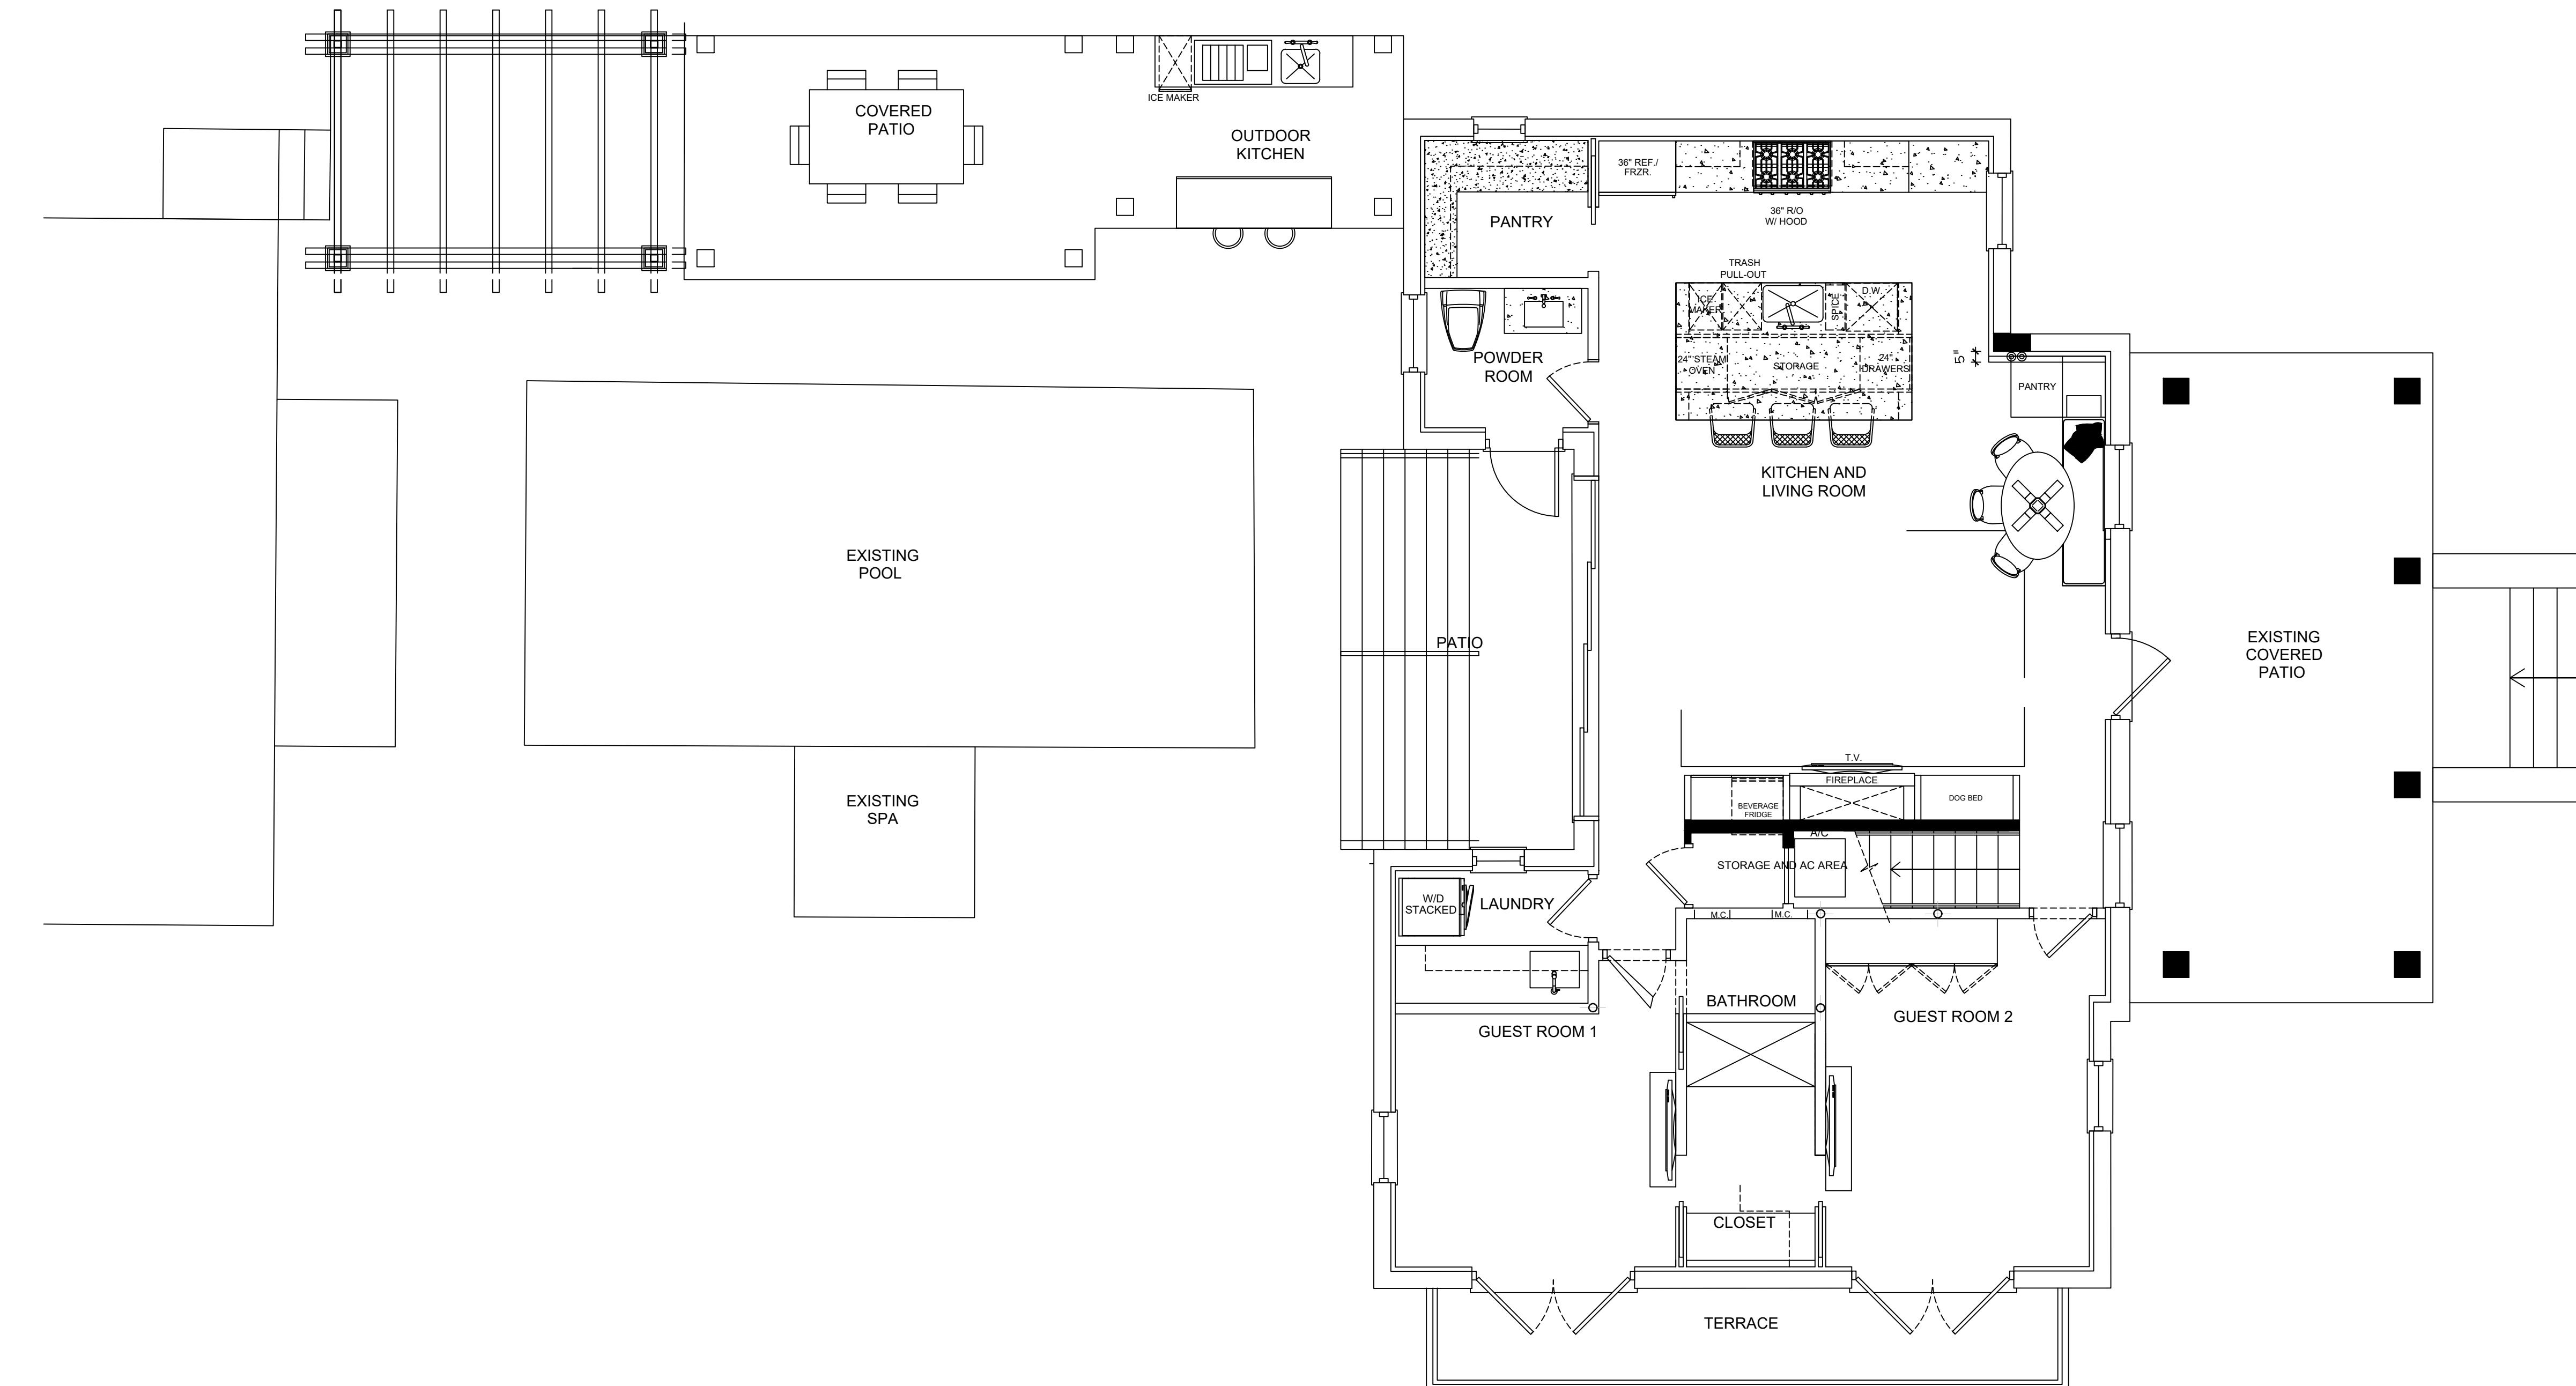

PREVIOUSLY APPROVED

1ST FLOOR PLAN
SCALE 1/4" = 1'

561-756-6094
mark@charettearch.com
www.charettearch.com

594-809-9802
paul@charettearch.com


551 NW 77TH ST SUITE 107
BOCA RATON, FL 33487

ANGIE PORTER
170 MARINE WAY
DELRAY BEACH, FL
2023-114

STARTED: 8-30-23
PRELIM: 8-8-23
PRELIM 2: 8-8-23
PRELIM 3: 8-8-23
PRELIM FINAL: 8-30-23
CONST. DOCS: 8-30-23
BLDG. DEPT: 9-18-23
BLDG. DEPT: 10-10-23
BLDG. DEPT: 10-17-23
HISTORICAL REV: 2-17-24

ISSUED: SHEET


A1

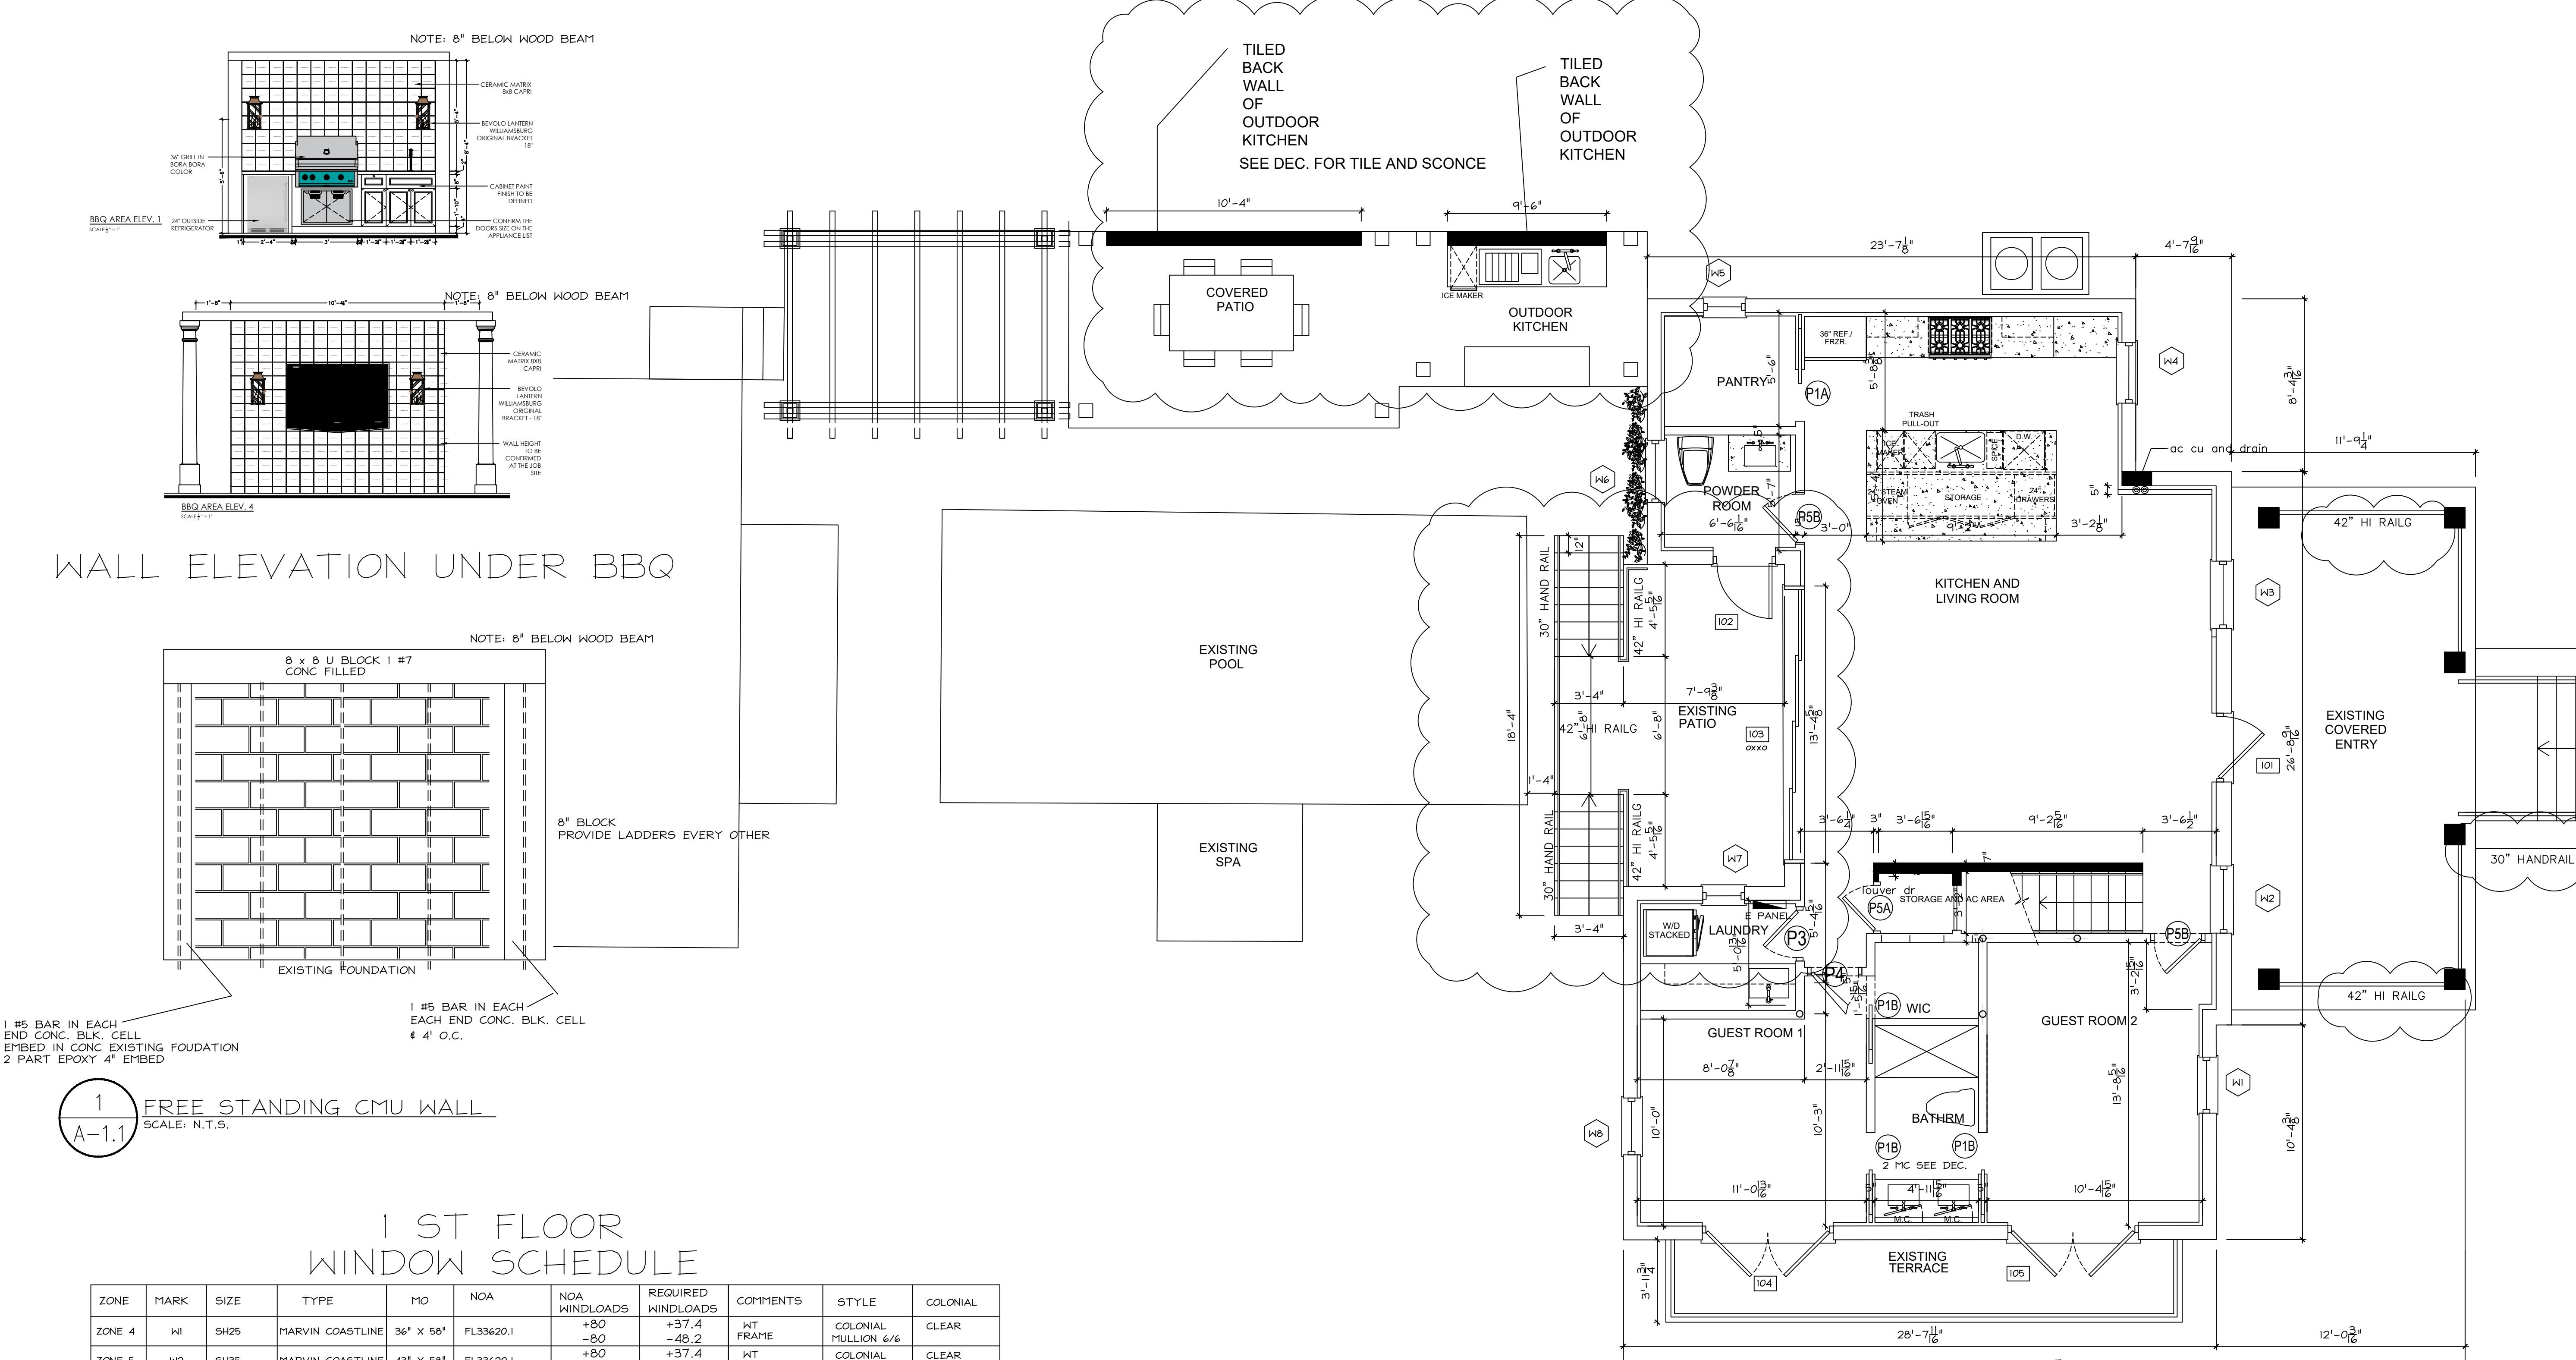


1 ST FLOOR WINDOW SCHEDULE

ZONE	MARK	SIZE	TYPE	MO	NOA	NOA WINDLOADS	REQUIRED WINDLOADS	COMMENTS	STYLE	COLONIAL
ZONE 4	W1	SH25	MARVIN COASTLINE	36" X 58"	FL33620.1	+80 -80	+37.4 -48.2	WT FRAME	COLONIAL MULLION 6/6	CLEAR
ZONE 5	W2	SH35	MARVIN COASTLINE	43" X 58"	FL33620.1	+80 -80	+37.4 -40.8	WT FRAME	COLONIAL MULLION 6/6	CLEAR
ZONE 4	W3	SH35	MARVIN COASTLINE	43" X 58"	FL33620.1	+80 -80	+37.4 -48.2	WT FRAME	COLONIAL MULLION 6/6	CLEAR
ZONE 5	W4	PW 2030	MARVIN COASTLINE	24" X38	FL34706.2	+70 -70	+37.4 -48.2	WT FRAME	COLONIAL MULLION 6/6	CLEAR
ZONE 5	W5	SH24	MARVIN COASTLINE	33" X51	FL34706.2	+80 -80	+37.4 -48.2	WT FRAME	COLONIAL MULLION 2/3	CLEAR
ZONE 5	W6	SH1/2 34	MARVIN COASTLINE	28" X43	FL34706.2	+80 -80	+37.4 -48.2	WT FRAME	COLONIAL MULLION 6/6	CLEAR
ZONE 5	W7	SH24	MARVIN COASTLINE	37" X 58"	FL34706.2	+80 -80	+37.4 -48.2	WT FRAME	COLONIAL MULLION 4/4	CLEAR
ZONE 5	W8	SH24	MARVIN COASTLINE	36" X 58"	FL34706.2	+80 -80	+37.4 -48.2	WT FRAME	COLONIAL MULLION 6/6	CLEAR


NOTE: CONTRACTOR TO VERIFY WITH WINDOW NOA BUCK SIZE TO BE IN FULL CONTACT, JAMB AND HEAD.
PER FBC 2020 ENERGY CONSERVATION CODE WINDOW MUST MATCH ENERGY CALCULATIONS AND MIN U-VALUE
ALL GLAZING TO BE IMPACT RATED AS PER THE FBC 2020 - NO STORM PANELS REQUIRED

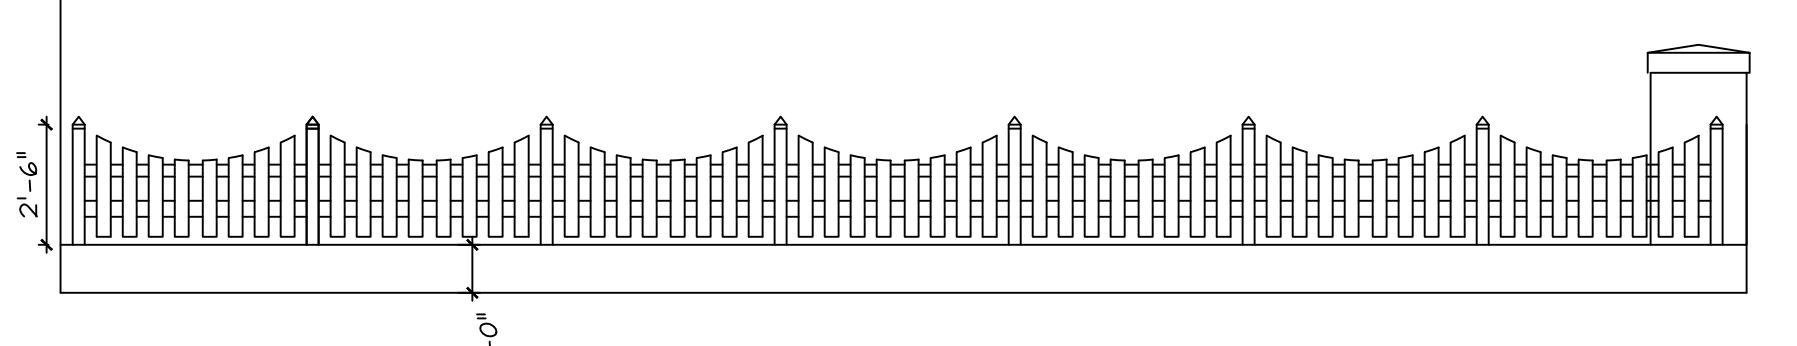

FENCE ELEVATION
SE 2ND ST

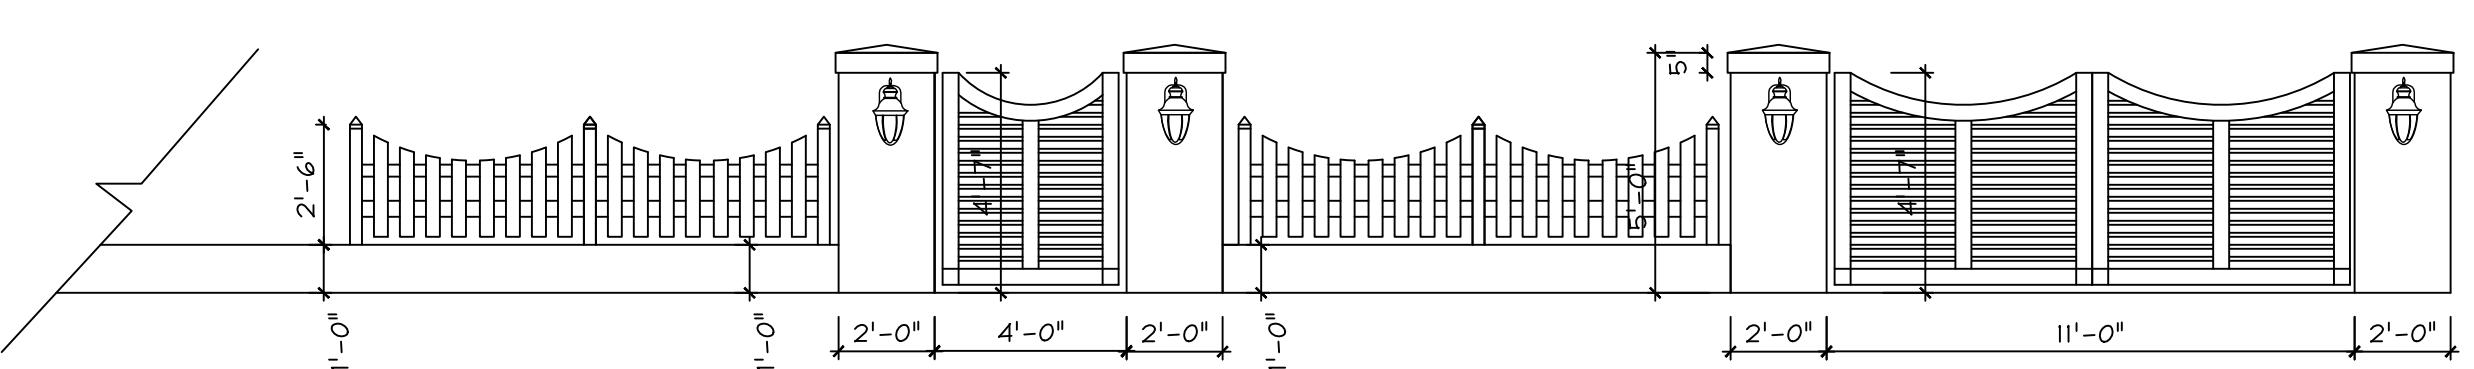


FRONT FENCE AND GATE ELEVATION MARINE WAY

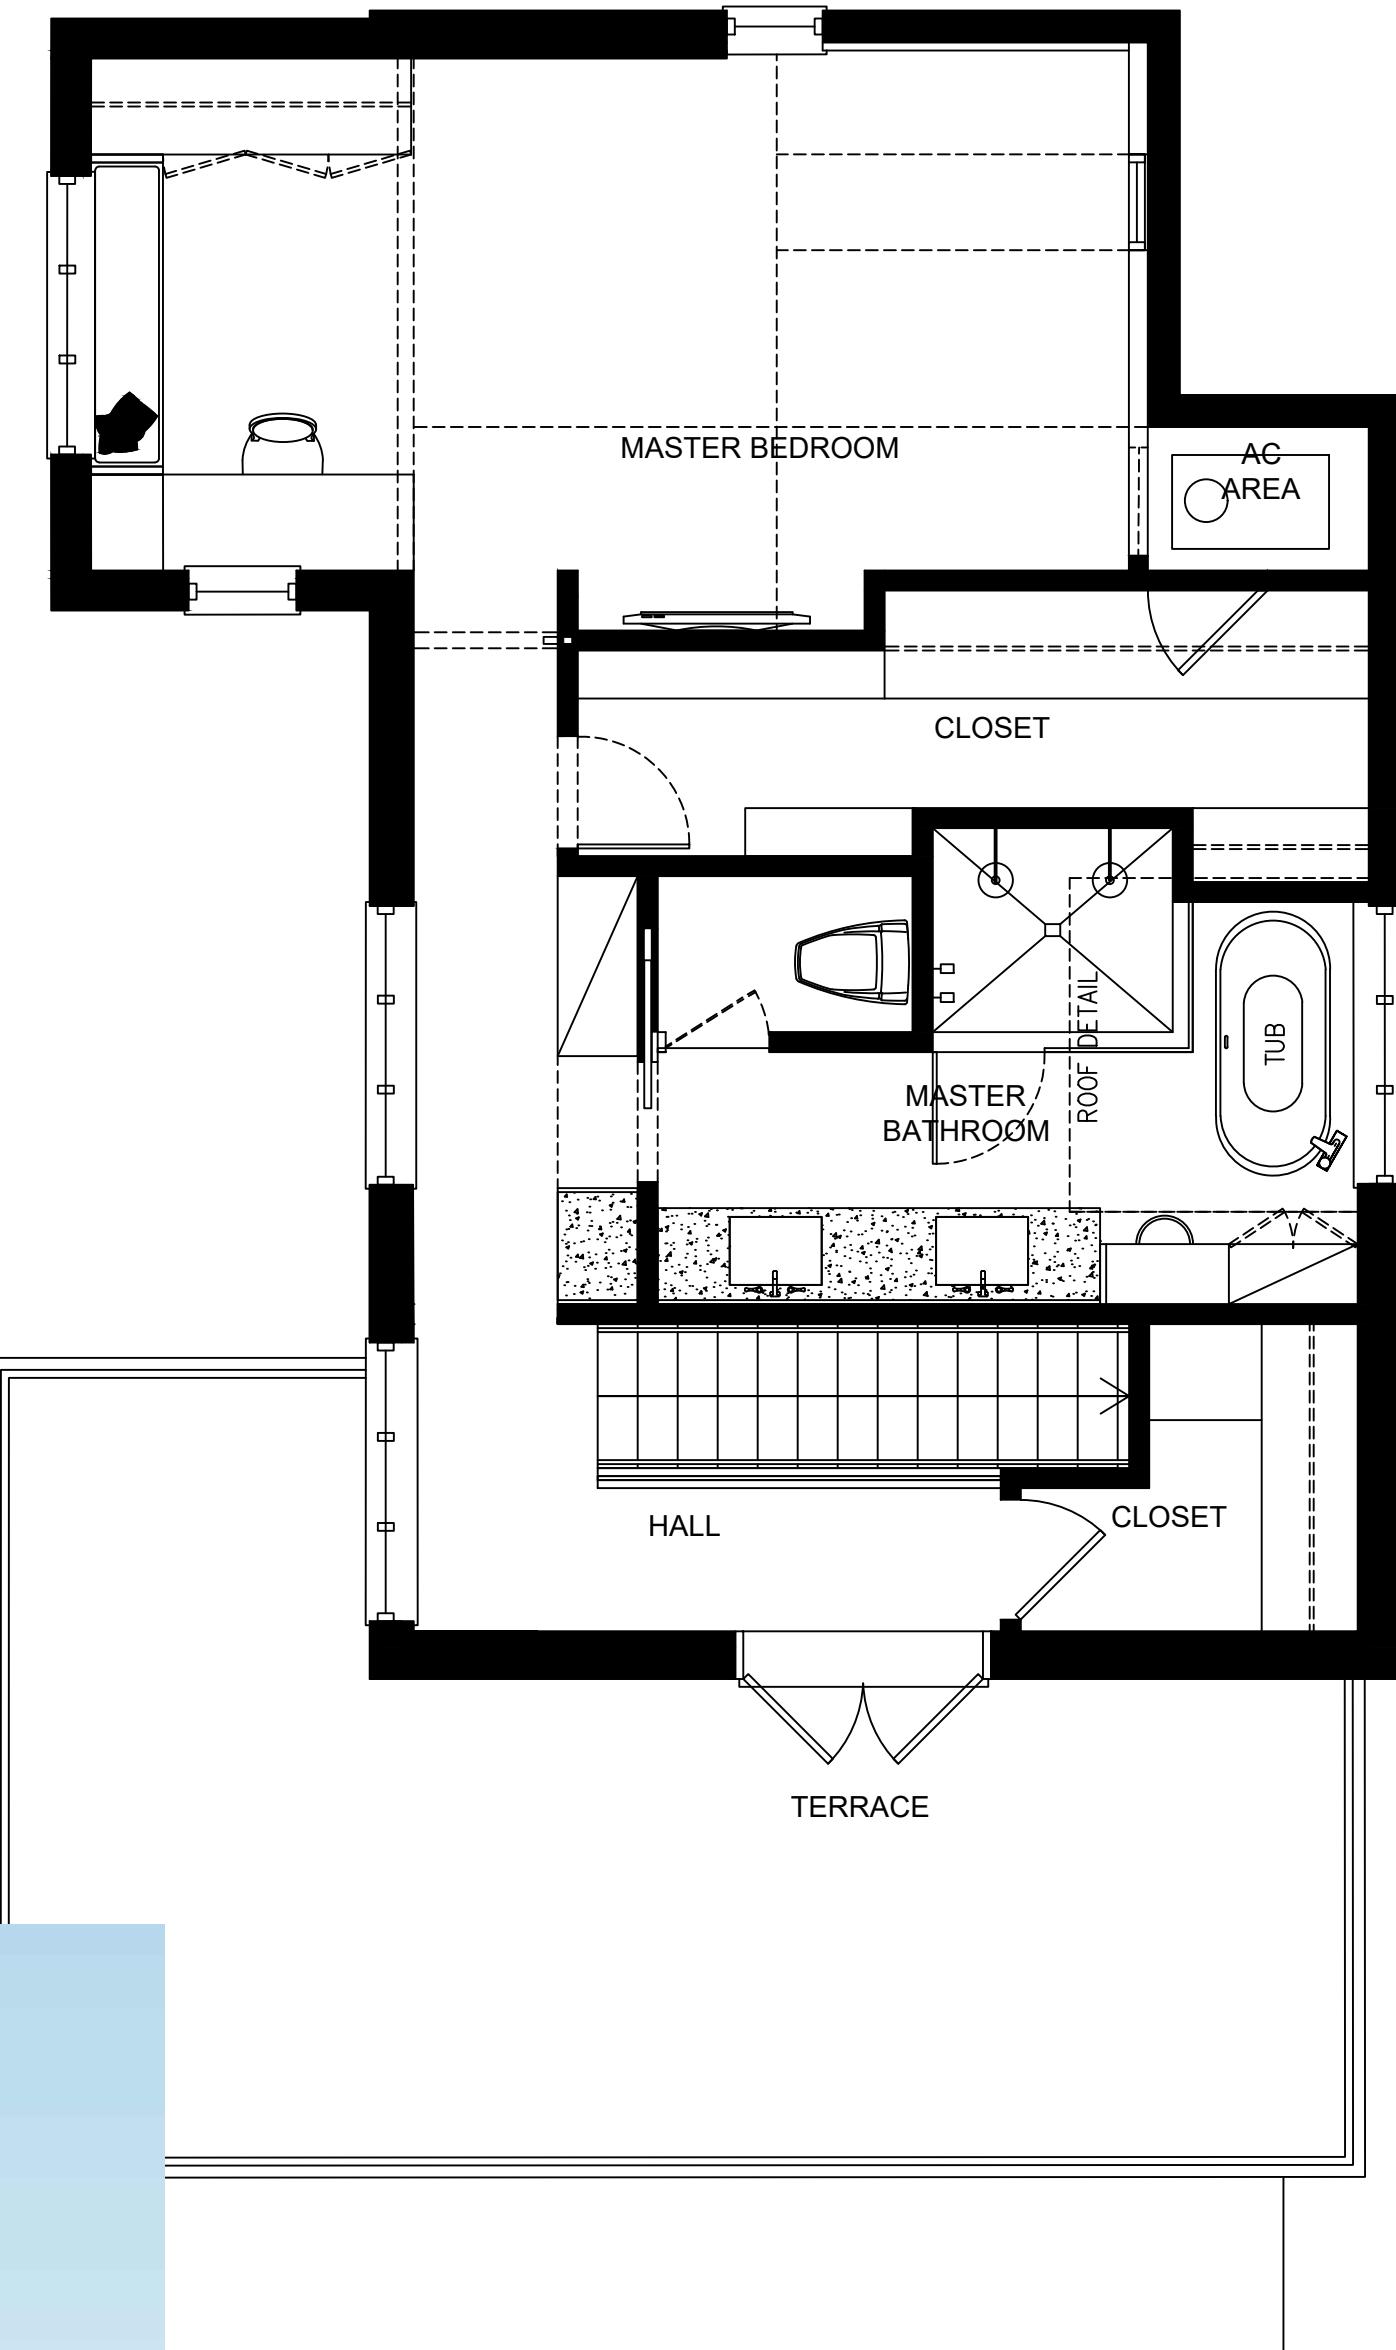

PREVIOUSLY APPROVED

2ND FLOOR PLAN
SCALE 1/4 " = 1'

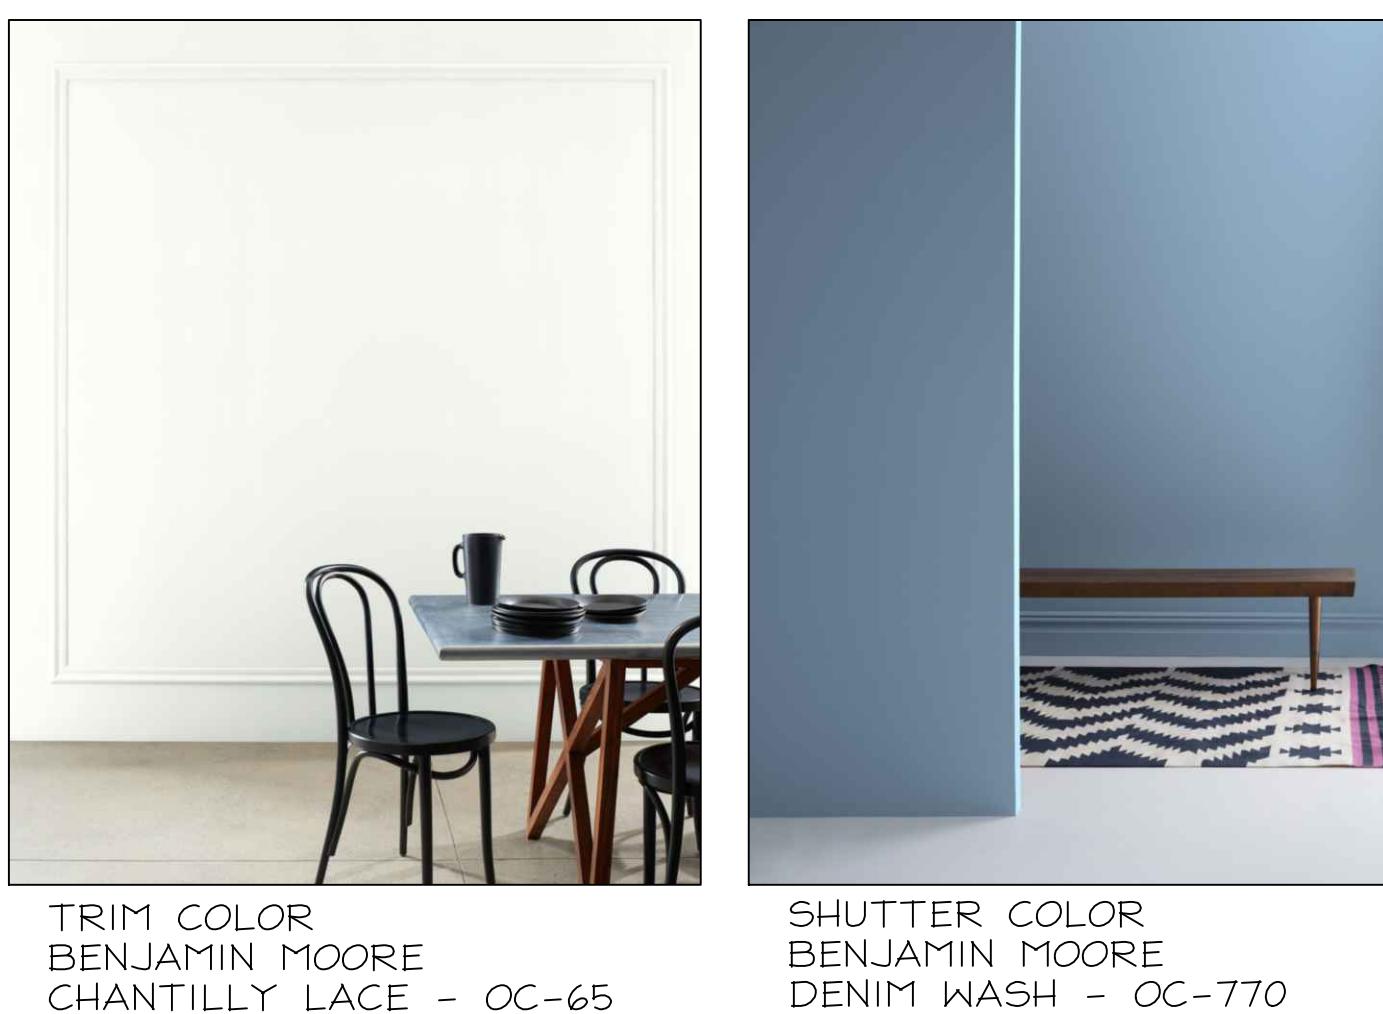

TRIM COLOR
BENJAMIN MOORE
CHANTILLY LACE - OC-65

SHUTTER COLOR
BENJAMIN MOORE
DENIM WASH - OC-770

MAIN BODY COLOR
BENJAMIN MOORE
ICEBERG - 2122-50


FRONT DOOR COLOR
BENJAMIN MOORE
KENSINGTON - 840



EXISTING
EAST ELEVATION

SCALE: 1/4"=1'-0"

FRONT ELEVATION

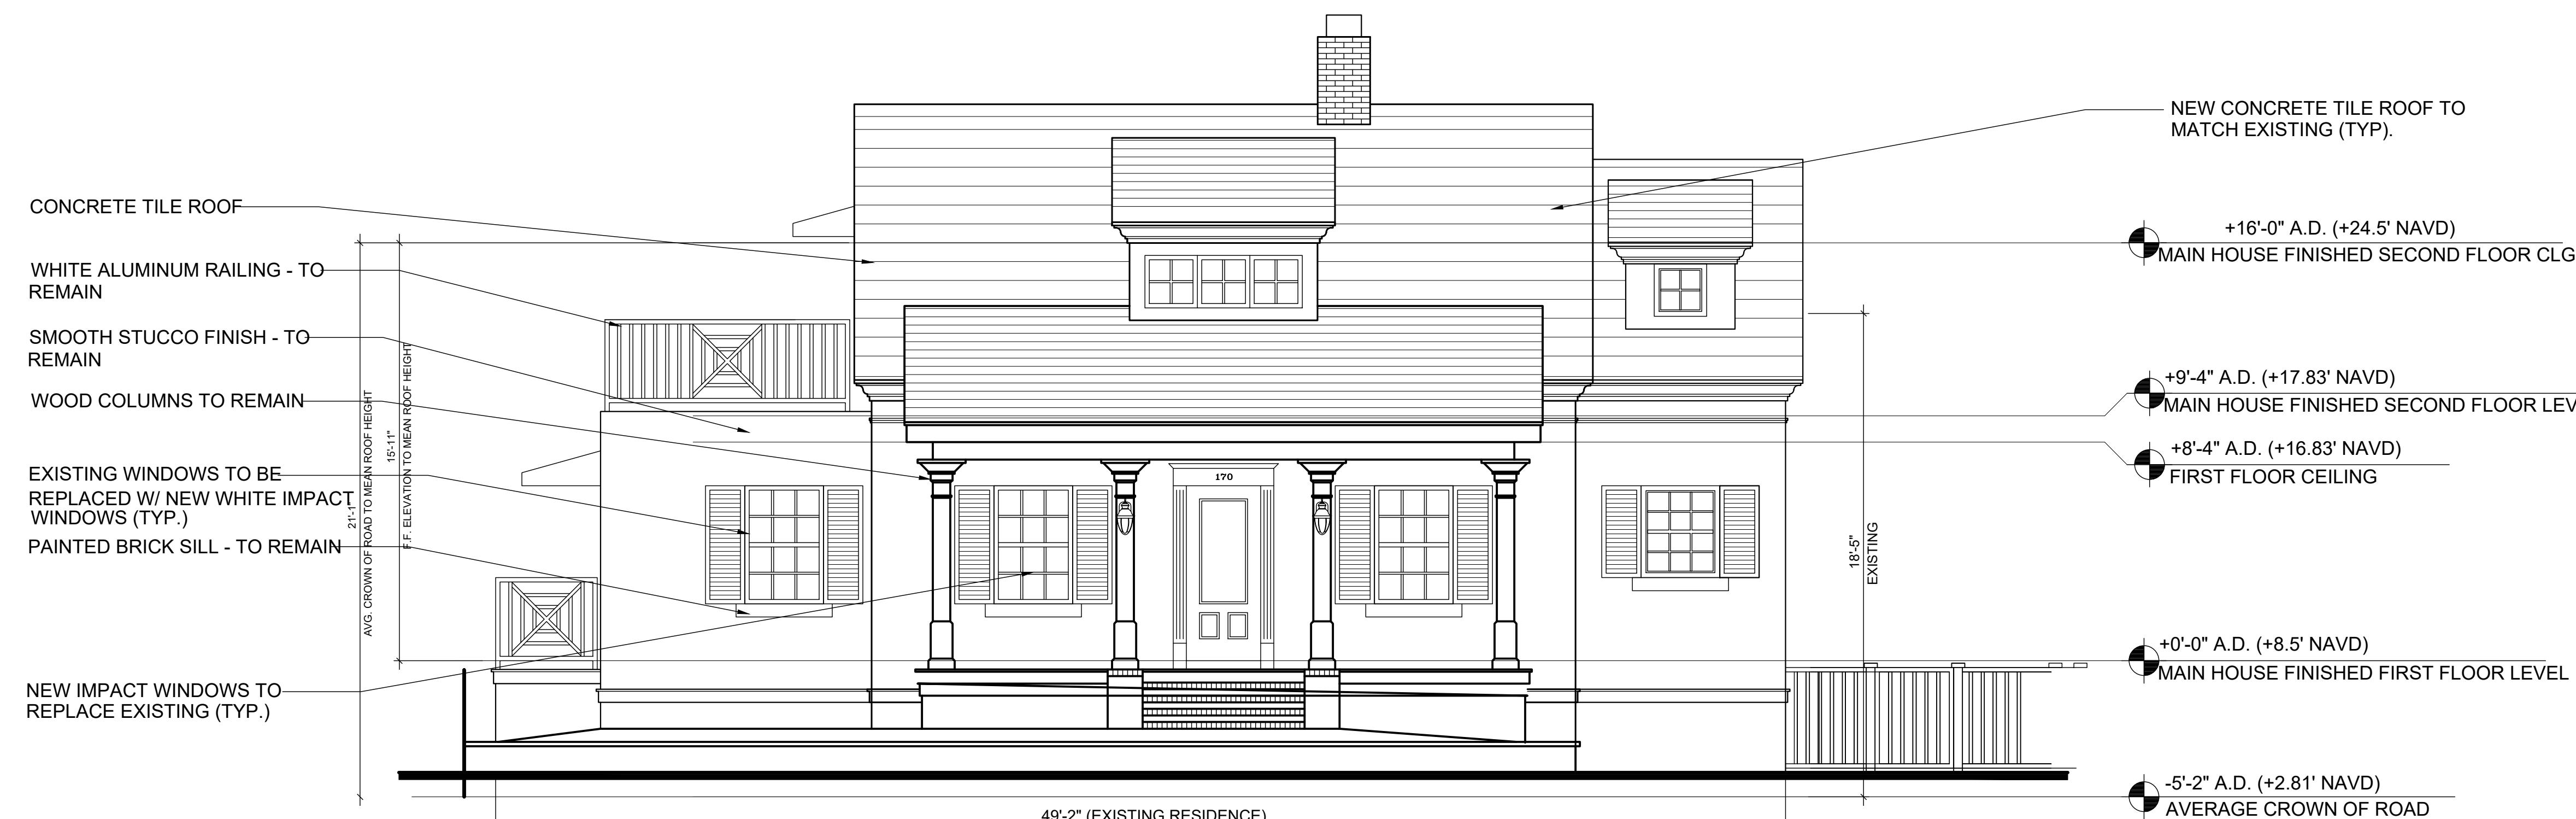

PREVIOUSLY APPROVED
EAST ELEVATION

SCALE: 1/4"=1'-0"

FRONT ELEVATION

PAUL CHARETTE A.I.A.
LICENSE AR0016279

MARK HUNLEY A.I.A.
LICENSE AR0099784

THIS ITEM HAS BEEN
ELECTRONICALLY SIGNED
AND SEALED BY MARK
HUNLEY OR PAUL
CHARETTE ON THE DATE
ADJACENT TO THE SEAL
USING A SHA
AUTHENTICATION CODE.
PRINTED COPIES OF THIS
DOCUMENT ARE NOT
CONSIDERED SIGNED AND
THE SHA
AUTHENTICATION CODE
MUST BE VERIFIED ON ANY
ELECTRONIC COPIES.

paul@charettearch.com
561-756-6094
mark@charettearch.com
954-809-9802
www.charettearch.com

CHARETTE
INTERNATIONAL
ARCHITECTURE
551 NW 77TH ST SUITE 107
BOCA RATON, FL 33487


ANGIE PORTER
170 MARINE WAY
DELRAY BEACH, FL
2023-114

STARTED:
PRELIM:
PRELIM 2: 8-8-23
PRELIM 3:
PRELIM FINAL:
CONST DOCS: 8-30-23
BLDG DEPT: 9-18-23
BLDG DEPT: 10-10-23
BLDG DEPT: 10-17-23
HISTORICAL REV: 2-17-24

ISSUED:
SHEET
A3



TRIM COLOR
BENJAMIN MOORE
CHANTILLY LACE - OC-65

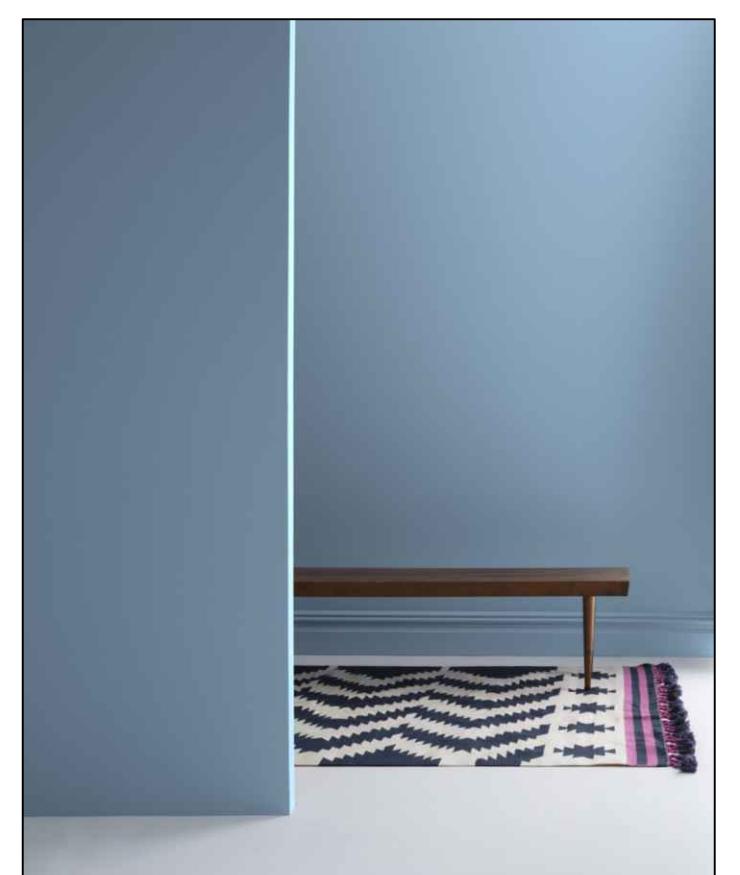



SHUTTER COLOR
BENJAMIN MOORE
DENIM WASH - OC-770



MAIN BODY COLOR
BENJAMIN MOORE
ICEBERG - 2122-50



FRONT DOOR COLOR
BENJAMIN MOORE
KENSINGTON - 840

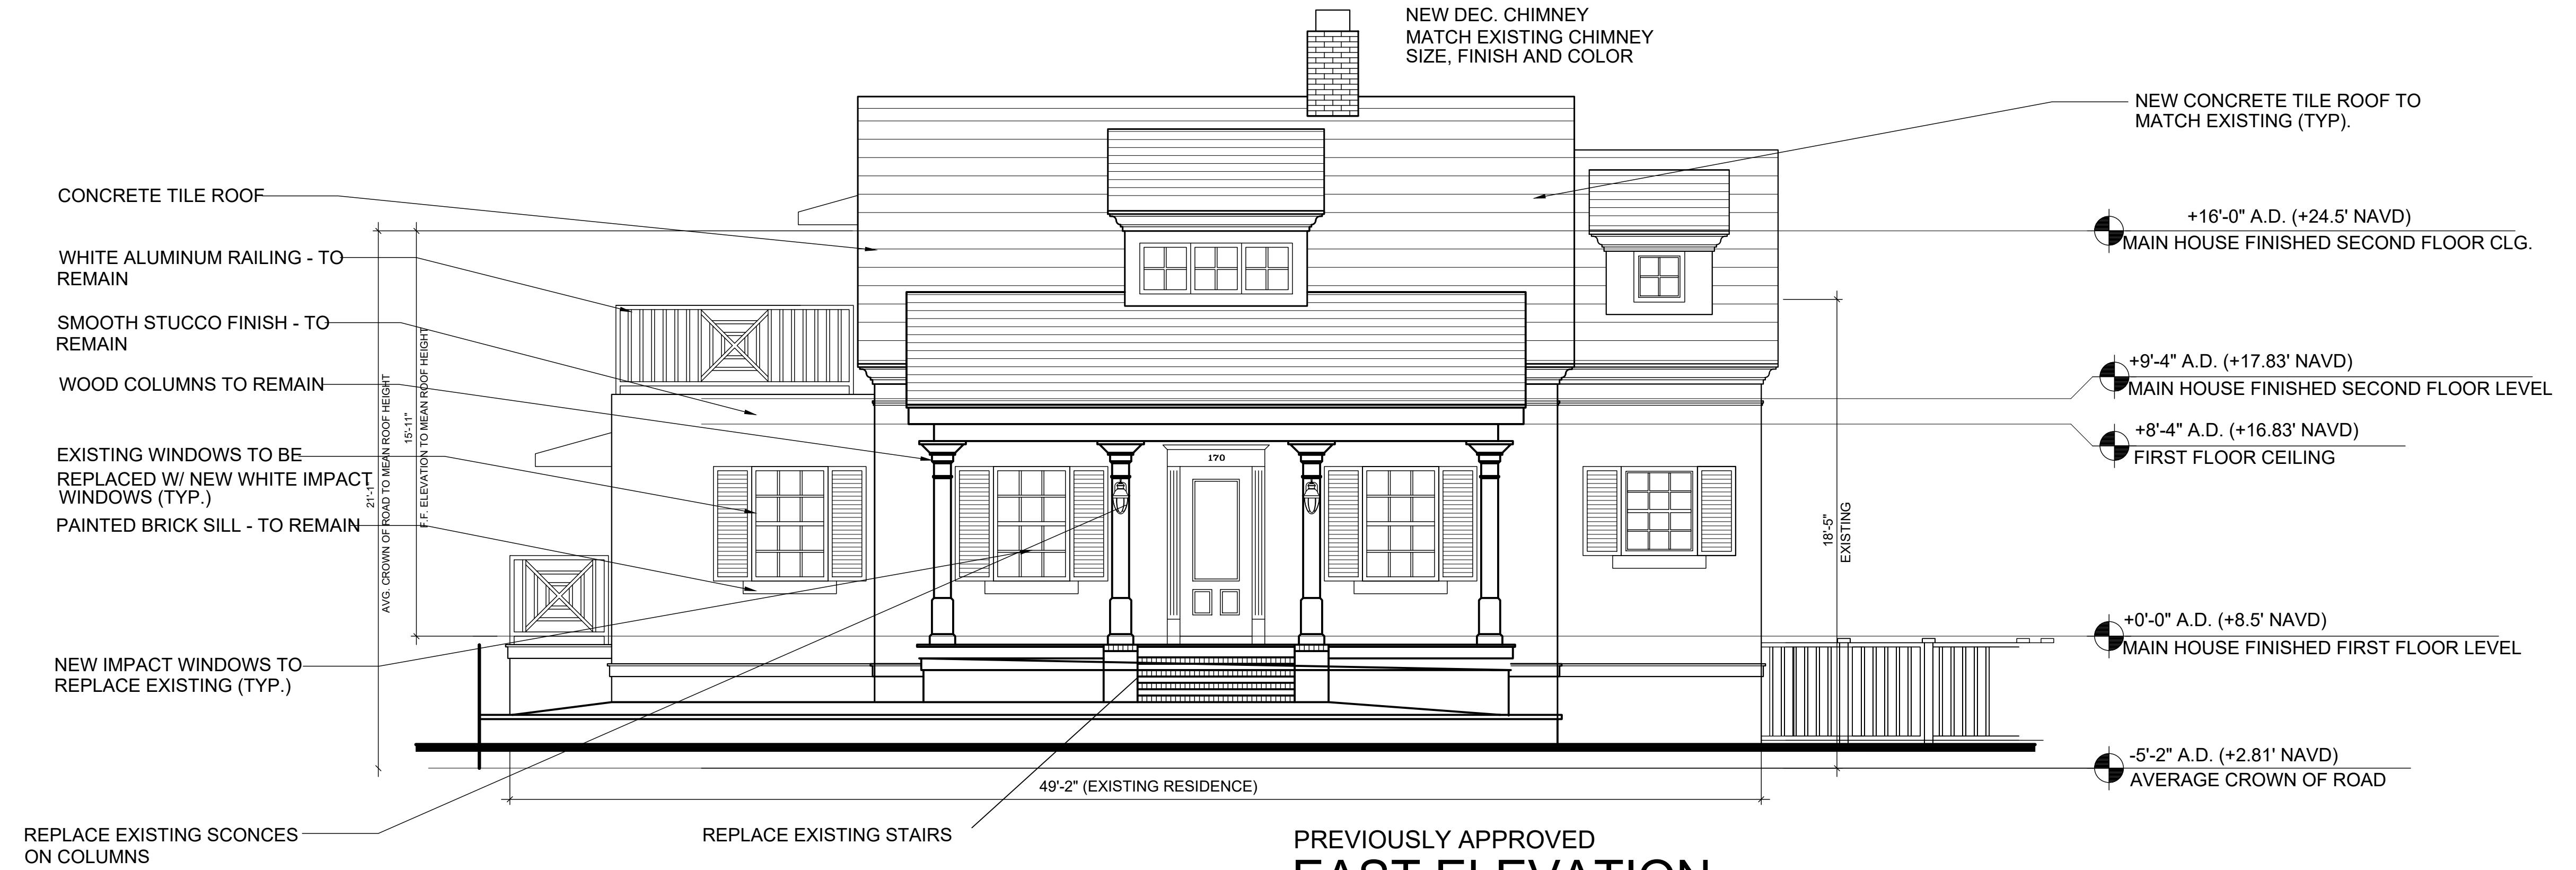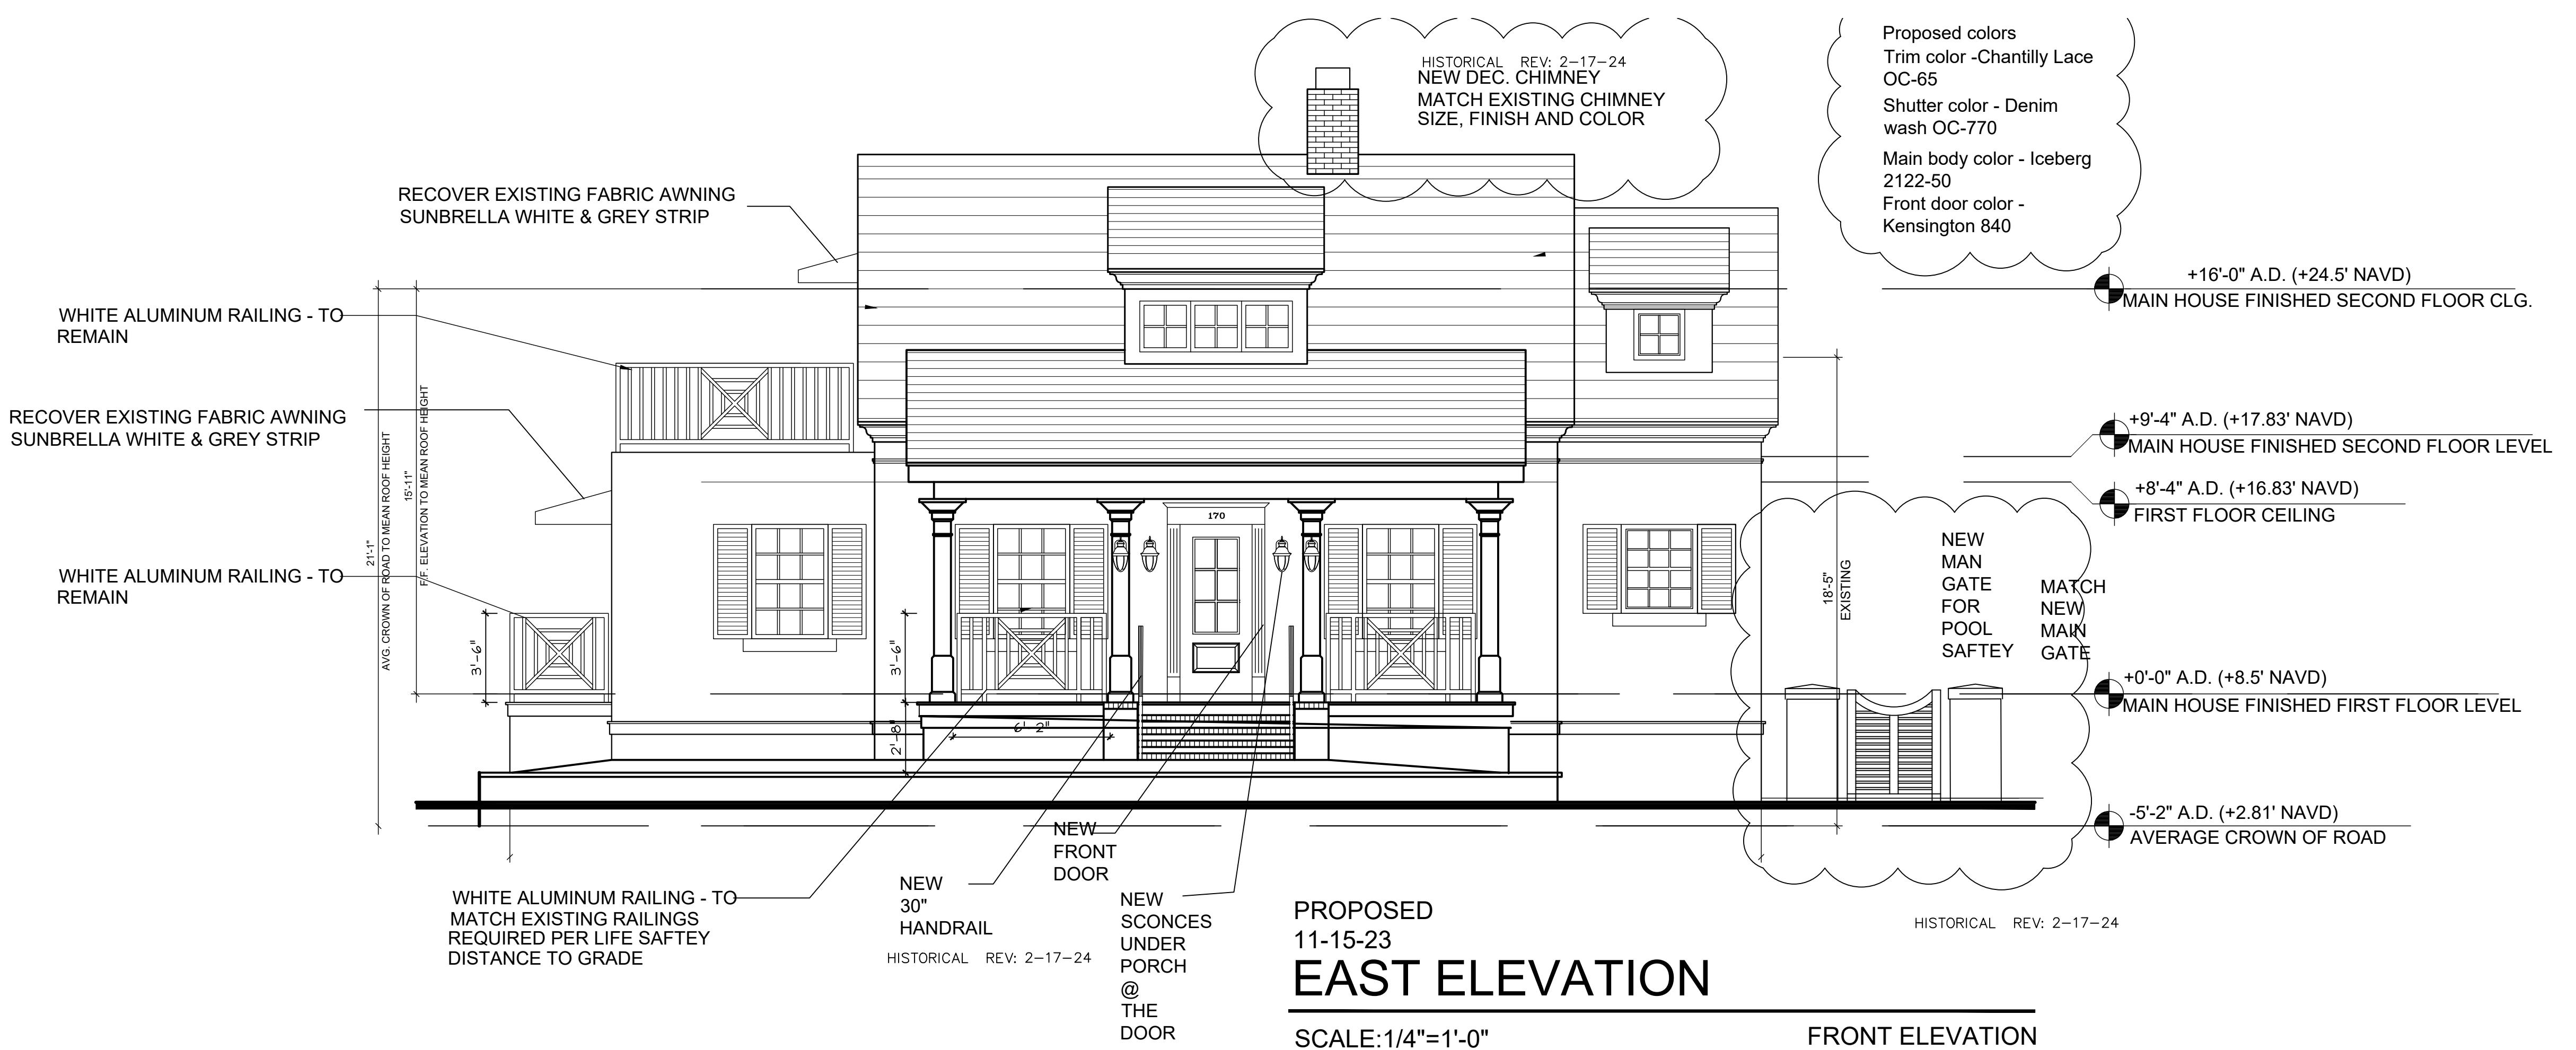

PREVIOUSLY APPROVED
EAST ELEVATION

SCALE: 1/4"=1'-0"

PAUL CHARETTE A.I.A.
LICENSE AR0016279

MARK HUNLEY A.I.A.
LICENSE AR0099784

THIS ITEM HAS BEEN
ELECTRONICALLY SIGNED
AND SEALED BY MARK
HUNLEY OR PAUL
CHARETTE ON THE DATE
ADJACENT TO THE SEAL
USING A SHA
AUTHENTICATION CODE.
PRINTED COPIES OF THIS
DOCUMENT ARE NOT
CONSIDERED SIGNED
AND SEALED AND THE SHA
AUTHENTICATION CODE
MUST BE VERIFIED ON ANY
ELECTRONIC COPIES.

paul@charettearch.com
561-756-6094
mark@charettearch.com
954-809-9802
www.charettearch.com

**CHARETTE
INTERNATIONAL
ARCHITECTURE**
551 NW 77TH ST SUITE 107
BOCA RATON, FL 33487

ANGIE PORTER
170 MARINE WAY
DELRAY BEACH, FL
2023-114



STARTED:
PRELIM:
PRELIM 2: 8-8-23
PRELIM 3:
PRELIM FINAL:
CONST DOCS: 8-30-23
BLDG DEPT: 9-18-23
BLDG DEPT: 10-10-23
BLDG DEPT: 10-17-23
HISTORICAL REV: 2-17-24
ISSUED:
SHEET

A3.1



EXISTING
SOUTH ELEVATION

SCALE: 1/4"=1'-0" SIDE ELEVATION

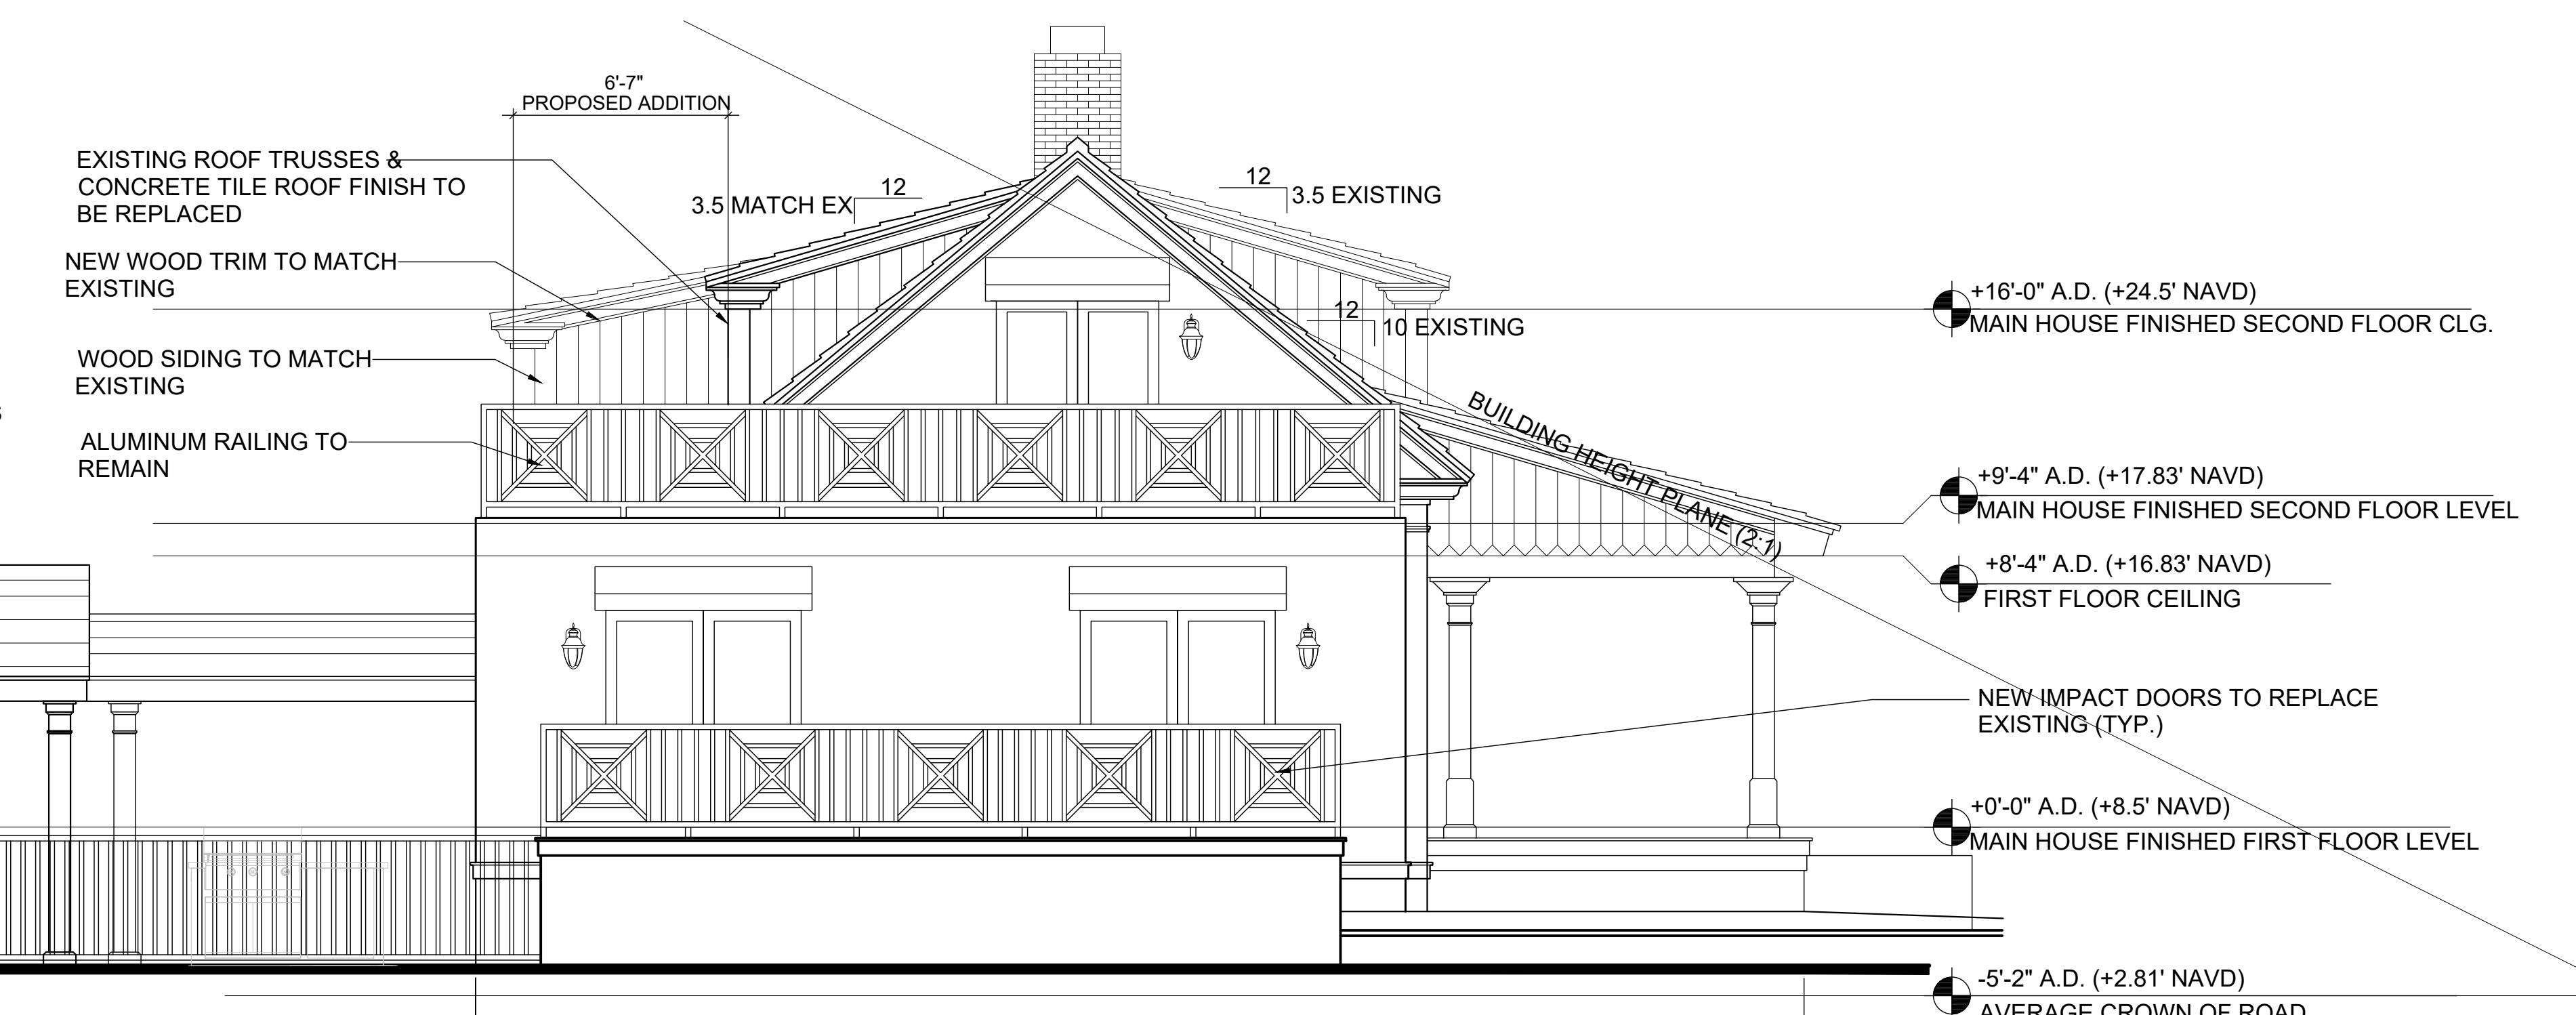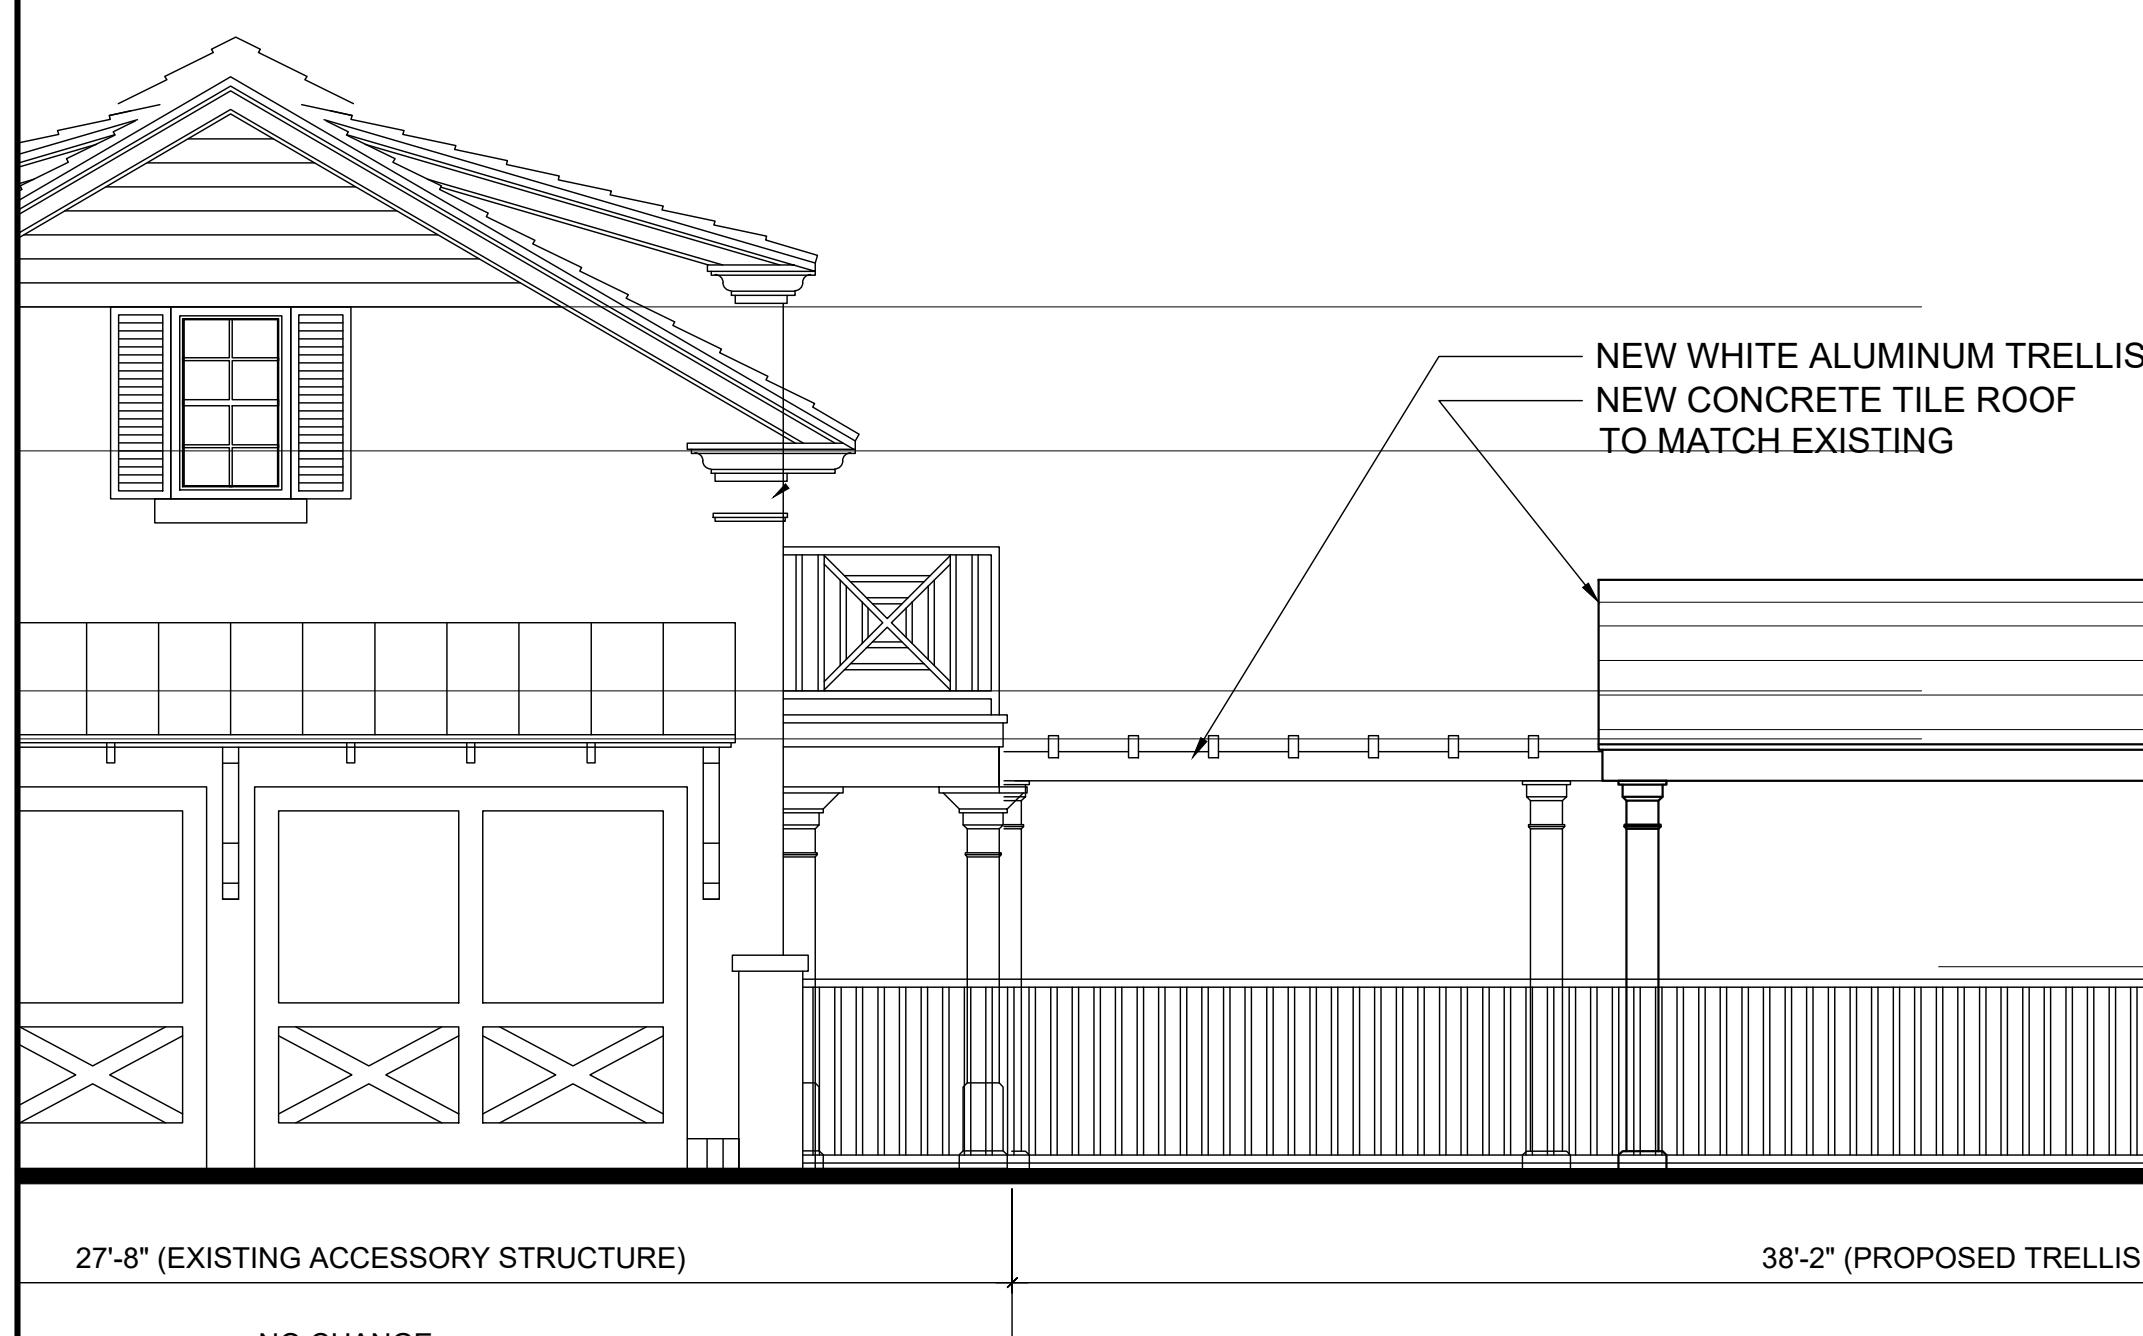

PREVIOUSLY APPROVED
SOUTH ELEVATION

SCALE: 1/4"=1'-0" SIDE ELEVATION

PAUL CHARETTE A.I.A.
LICENSE AR0016279

MARK HUNLEY A.I.A.
LICENSE AR0099784

THIS ITEM HAS BEEN
ELECTRONICALLY SIGNED
AND SEALED BY MARK
HUNLEY OR PAUL
CHARETTE ON THE DATE
ADJACENT TO THE SEAL
USING A SHA
AUTHENTICATION CODE.
PRINTED COPIES OF THIS
DOCUMENT ARE NOT
CONSIDERED SIGNED AND
THE SHA
AUTHENTICATION CODE
MUST BE VERIFIED ON ANY
ELECTRONIC COPIES.



paul@charettearch.com
561-756-6094
mark@charettearch.com
954-809-9802
www.charettearch.com

CHARETTE
INTERNATIONAL
ARCHITECTURE
551 NW 77TH ST SUITE 107
BOCA RATON, FL 33487

ANGIE PORTER
170 MARINE WAY
DELRAY BEACH, FL
2023-114

STARTED:
PRELIM:
PRELIM 2: 8-8-23
PRELIM 3:
PRELIM FINAL:
CONST DOCS: 8-30-23
BLDG DEPT: 9-18-23
BLDG DEPT: 10-10-23
BLDG DEPT: 10-17-23
HISTORICAL REV: 2-17-24
ISSUED:
SHEET

A4

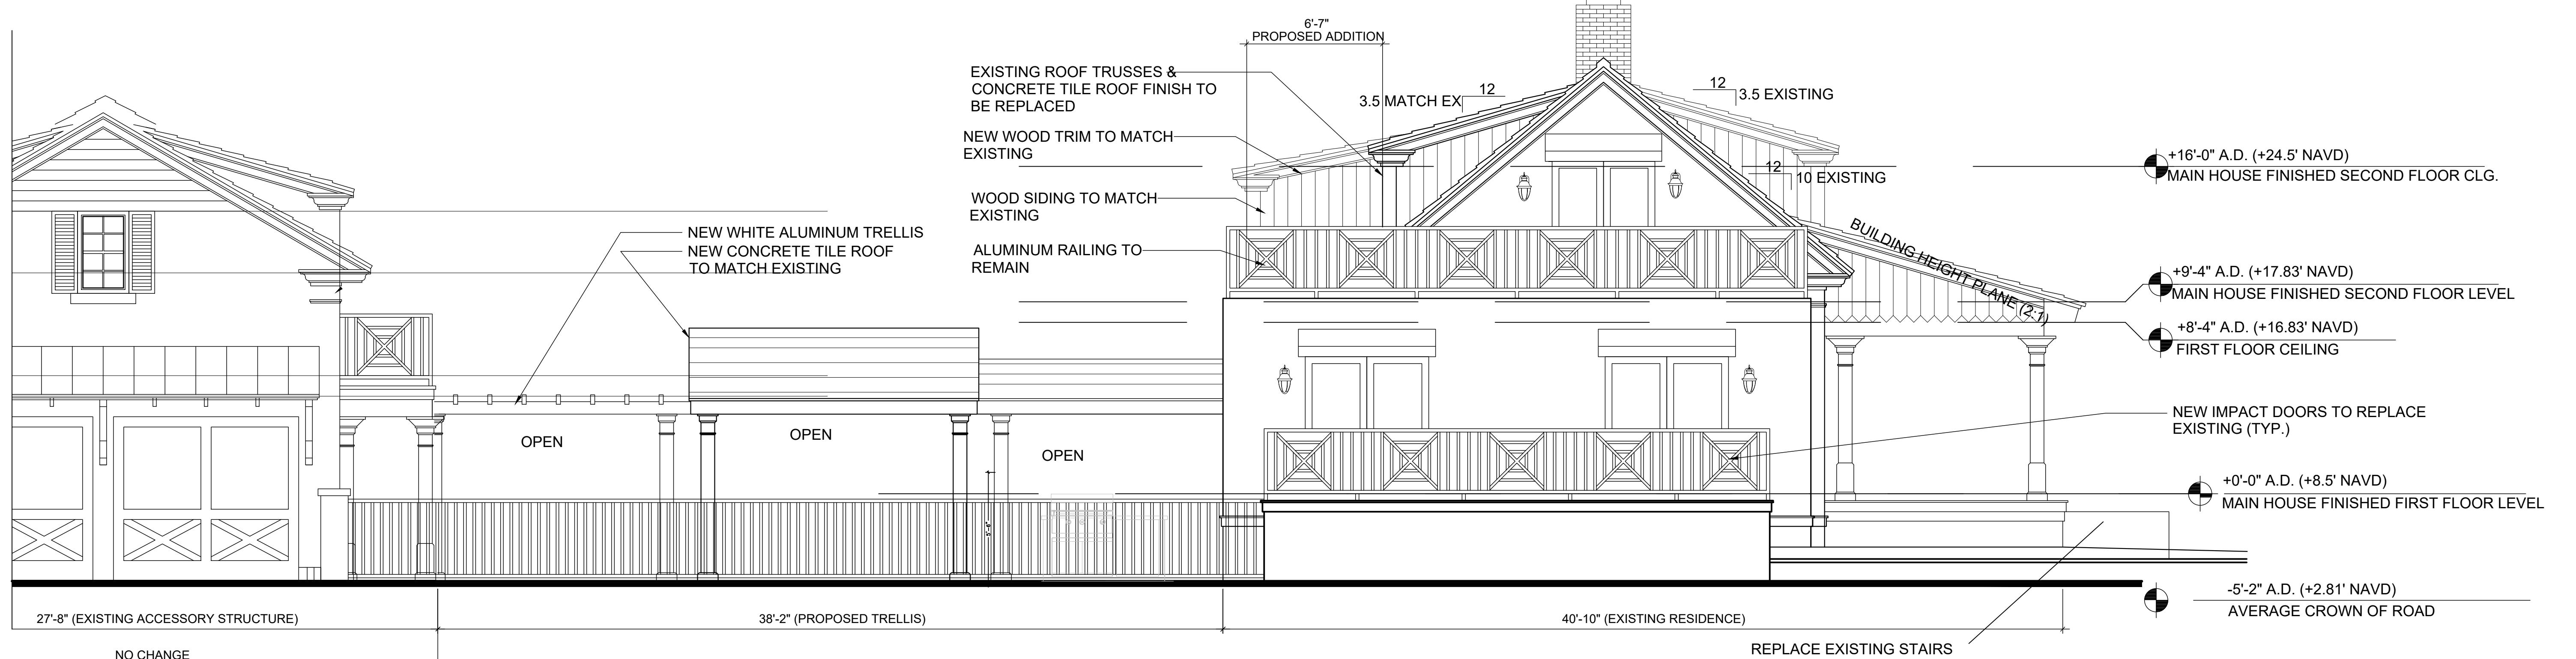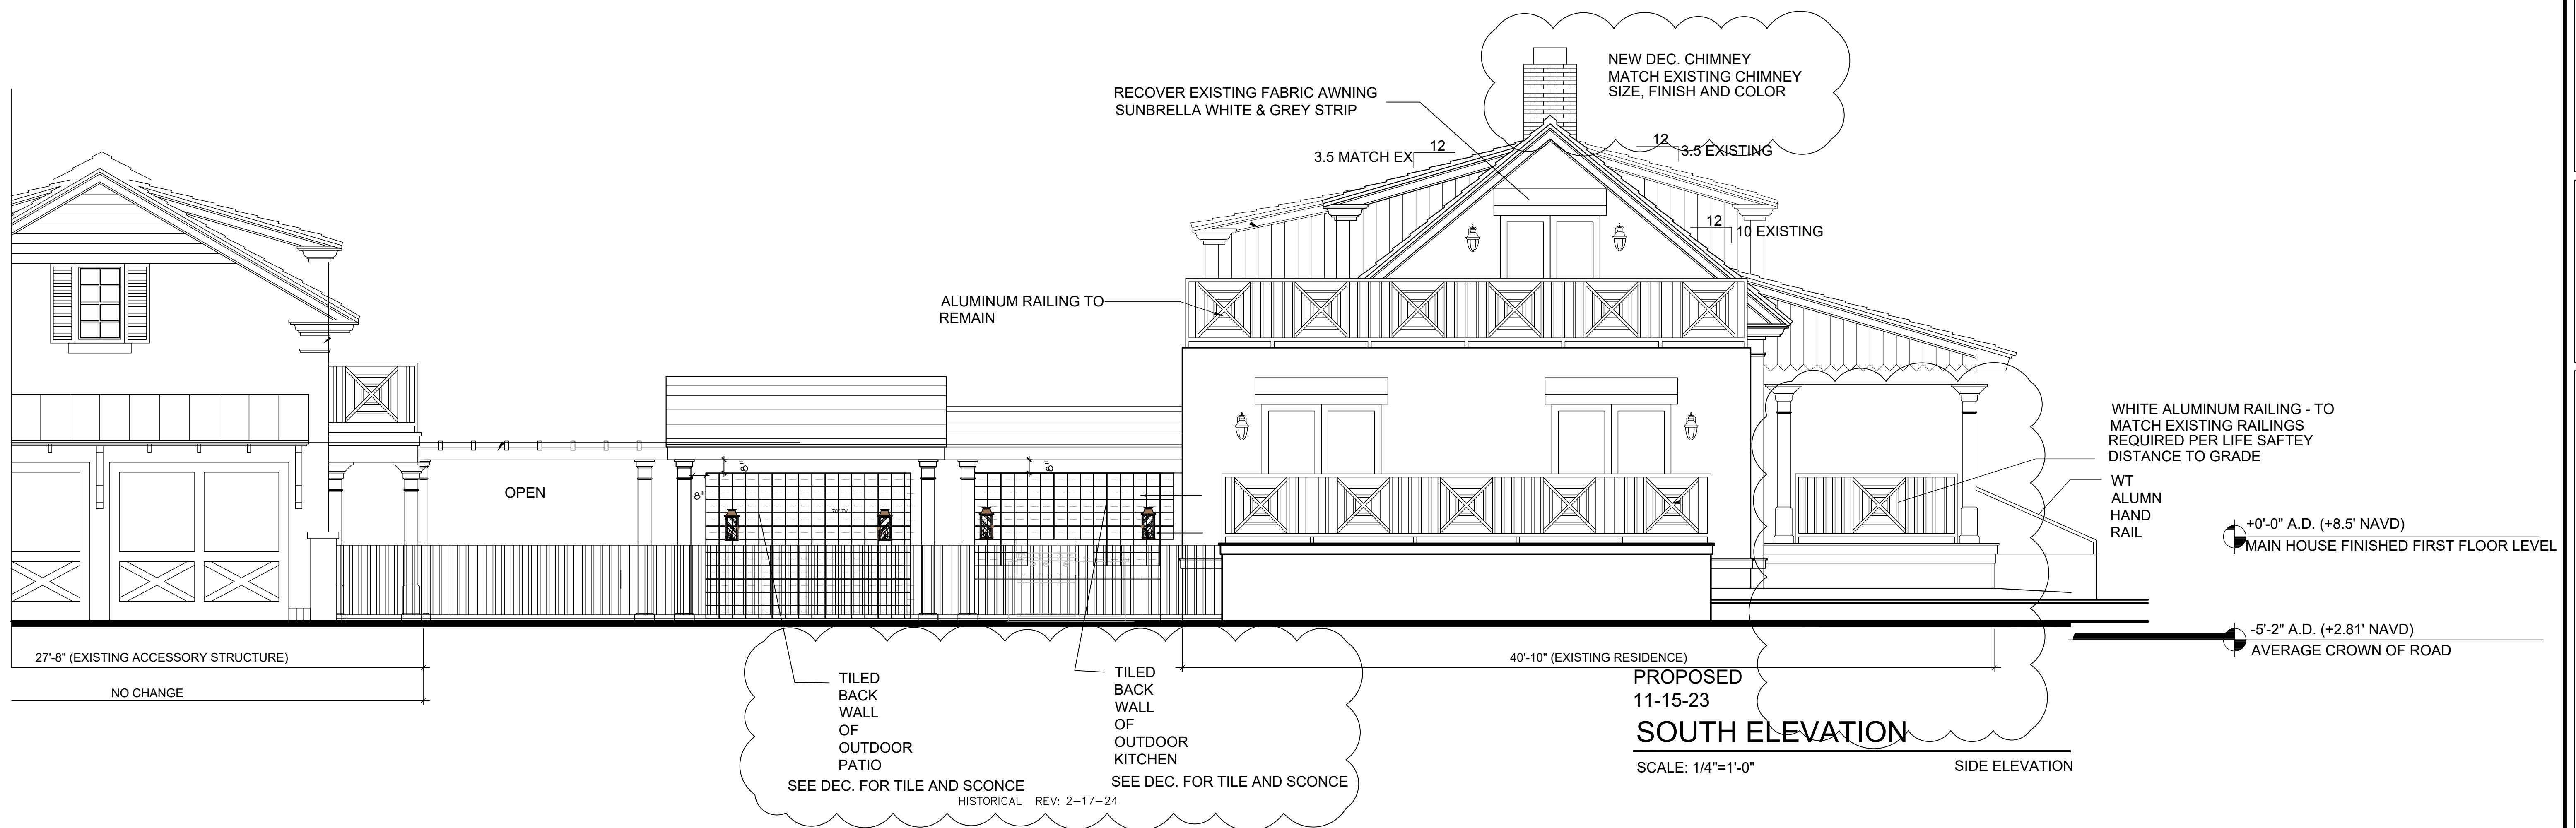

PREVIOUSLY APPROVED
SOUTH ELEVATION

SCALE: 1/4"=1'-0" SIDE ELEVATION

PAUL CHARETTE A.I.A.
LICENSE AR0016279

MARK HUNLEY A.I.A.
LICENSE AR0099784

THIS ITEM HAS BEEN
ELECTRONICALLY SIGNED
AND SEALED BY MARK
HUNLEY OR PAUL
CHARETTE ON THE DATE
ADJACENT TO THE SEAL
USING A SHA
AUTHENTICATION CODE.
PRINTED COPIES OF THIS
DOCUMENT ARE NOT
CONSIDERED SIGNED AND
SEALED AND THE SHA
AUTHENTICATION CODE
MUST BE VERIFIED ON ANY
ELECTRONIC COPIES.

paul@charrettearch.com
561-756-6094
mark@charrettearch.com
954-809-9802

CHARRETTE INTERNATIONAL ARCHITECTURE

551 NW 77TH ST SUITE 107
BOCA RATON, FL 33487

ANGIE PORTER
170 MARINE WA'
DELRAY BEACH,
2023-114

STARTED:	
PRELIM:	
PRELIM 2:	8-8-23
PRELIM 3:	
PRELIM FINAL:	
CONST DOCS:	8-30-23
BLDG DEPT:	9-18-23
BLDG DEPT:	10-10-23
BLDG DEPT:	10-17-23
HISTORICAL	REV: 2-17-24
SEARCHED	

SHEET



PAUL CHARETTE A.I.A.
LICENSE AR0016279

MARK HUNLEY A.I.A.
LICENSE AR0099784

THIS ITEM HAS BEEN
ELECTRONICALLY SIGNED
AND SEALED BY MARK
HUNLEY OR PAUL
CHARETTE ON THE DATE
ADJACENT TO THE SEAL
USING SHA AUTHENTICATION
CODE. PRINTED COPIES OF THIS
DOCUMENT ARE NOT
CONSIDERED SIGNED AND THE
SHA AUTHENTICATION CODE
MUST BE VERIFIED ON ANY
ELECTRONIC COPIES.

paul@charettearch.com
561-756-6094
mark@charettearch.com
954-809-9802
www.charettearch.com

CHARETTE
INTERNATIONAL
ARCHITECTURE
551 NW 77TH ST SUITE 107
BOCA RATON, FL 33487



ANGIE PORTER
170 MARINE WAY
DELRAY BEACH, FL
2023-114


STARTED:
PRELIM: 8-8-23
PRELIM 2: 9-18-23
PRELIM 3: 10-10-23
PRELIM FINAL: 10-17-23
CONST DOCS: 8-30-23
BLDG DEPT: 9-18-23
BLDG DEPT: 10-10-23
BLDG DEPT: 10-17-23
HISTORICAL REV: 2-17-24

ISSUED:
SHEET


A5



TRIM COLOR
BENJAMIN MOORE
CHANTILLY LACE - OC-65

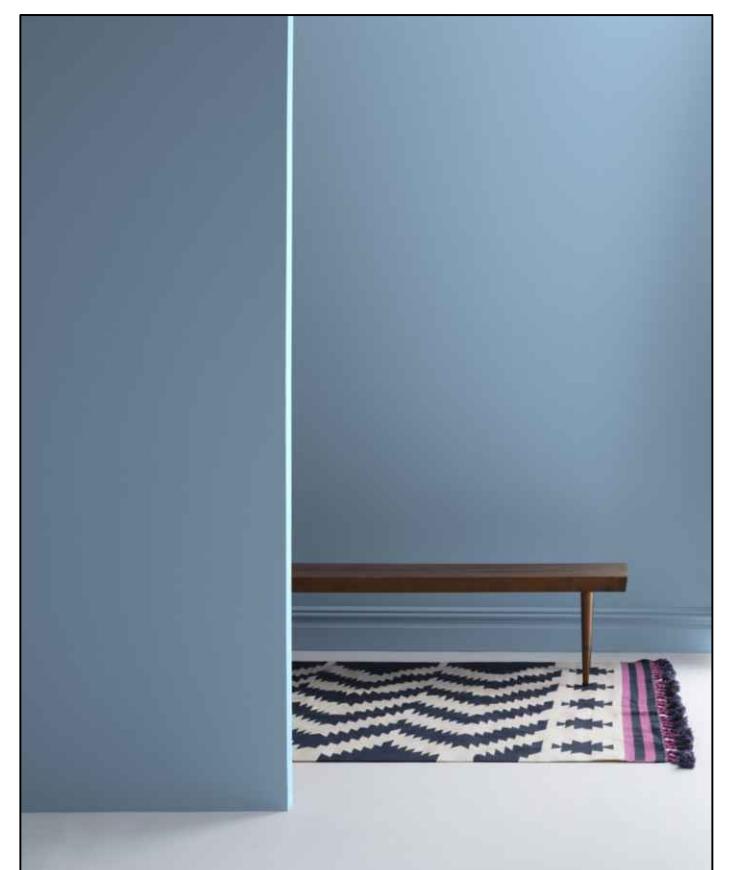


SHUTTER COLOR
BENJAMIN MOORE
DENIM WASH - OC-770

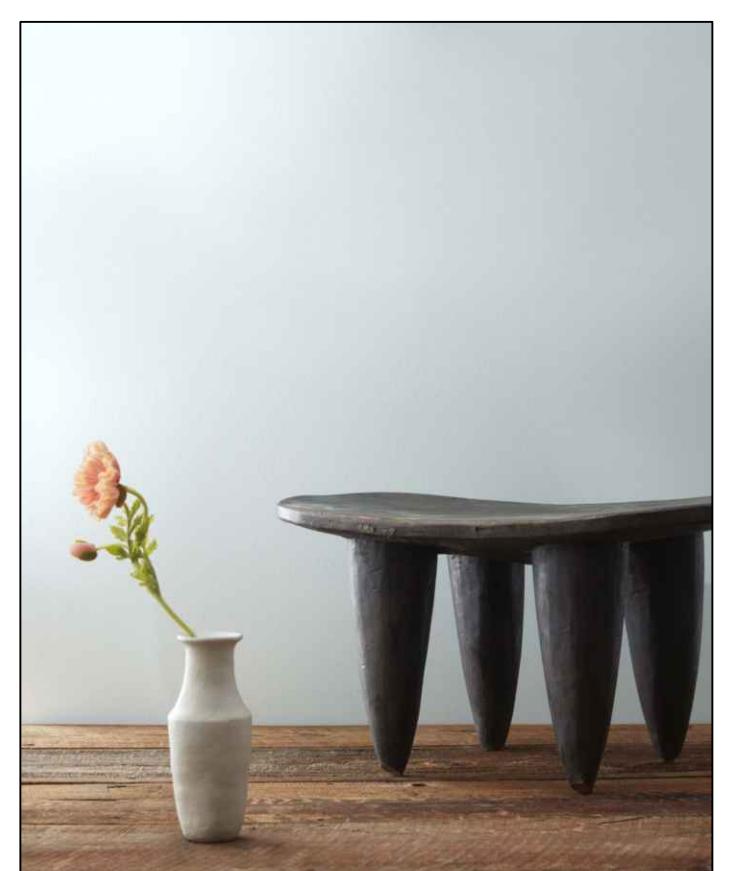

MAIN BODY COLOR
BENJAMIN MOORE
ICEBERG - 2122-50



FRONT DOOR COLOR
BENJAMIN MOORE
KENSINGTON - 840

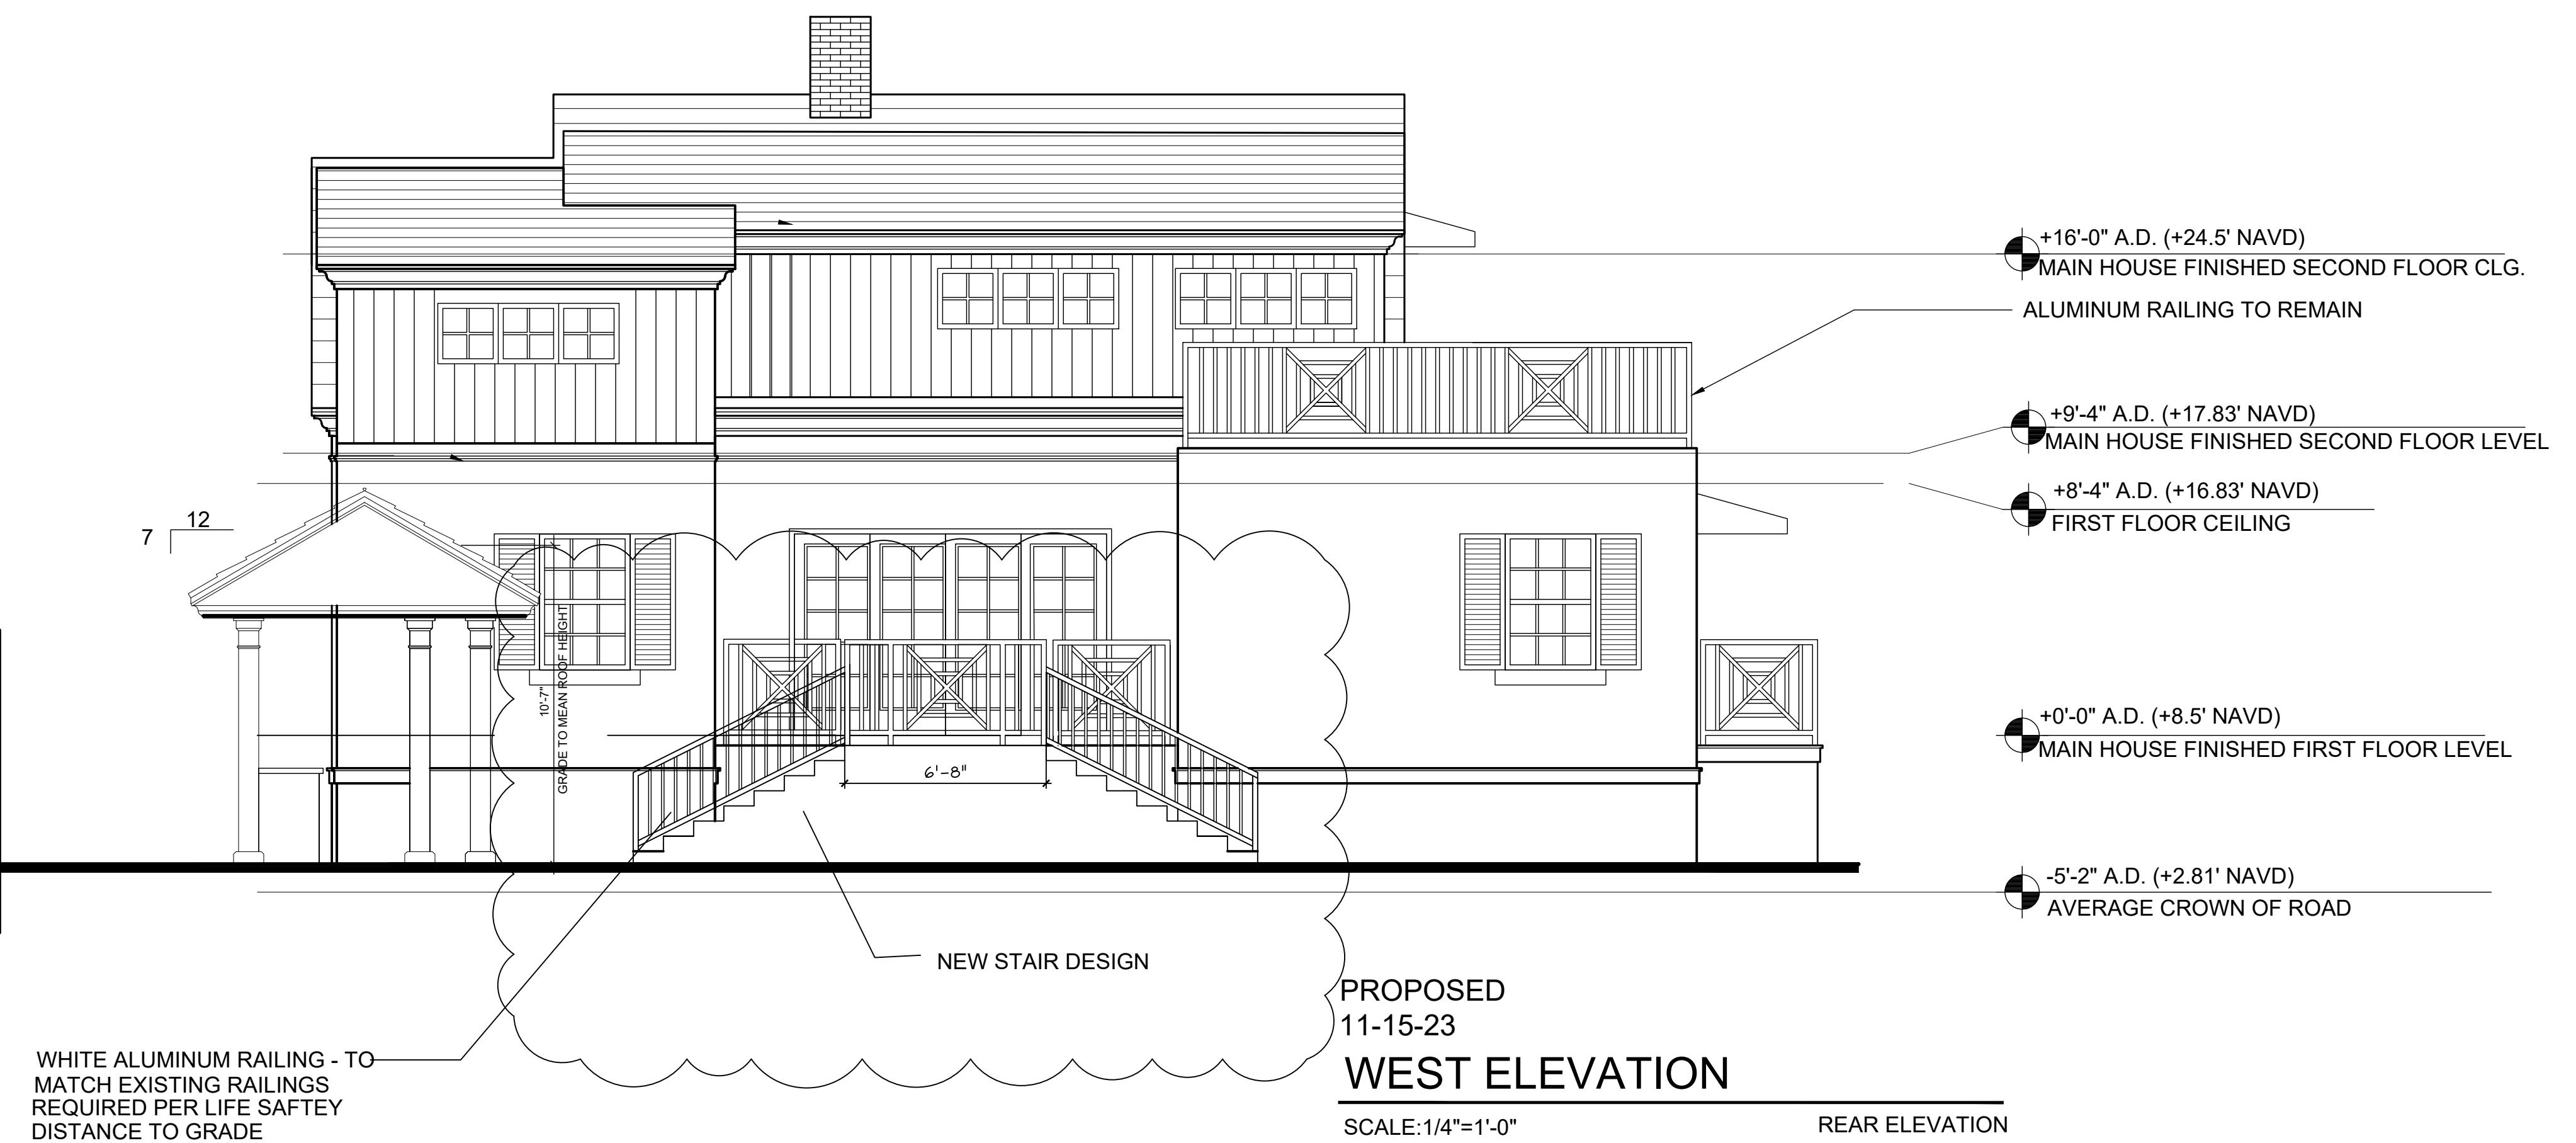

PAUL CHARETTE A.I.A.
LICENSE AR0016279

MARK HUNLEY A.I.A.
LICENSE AR0099784

THIS ITEM HAS BEEN
ELECTRONICALLY SIGNED
AND SEALED BY MARK
HUNLEY OR PAUL
CHARETTE ON THE DATE
ADJACENT TO THE SEAL
USING A SHA
AUTENTICATION CODE.
PRINTED COPIES OF THIS
DOCUMENT ARE NOT
CONSIDERED SIGNED
AND SEALED AND THE SHA
AUTENTICATION CODE
MUST BE VERIFIED ON ANY
ELECTRONIC COPIES.


paul@charettearch.com
561-756-6094
mark@charettearch.com
954-809-9802
www.charettearch.com

CHARETTE
INTERNATIONAL
ARCHITECTURE
551 NW 77TH ST SUITE 107
BOCA RATON, FL 33487

ANGIE PORTER
170 MARINE WAY
DELRAY BEACH, FL
2023-114


STARTED:
PRELIM:
PRELIM 2: 8-8-23
PRELIM 3:
PRELIM FINAL:
CONST. DEPT: 8-30-23
BLDG DEPT: 9-18-23
BLDG DEPT: 10-10-23
BLDG DEPT: 10-17-23
HISTORICAL REV: 2-17-24
ISSUED:
SHEET

A5.1

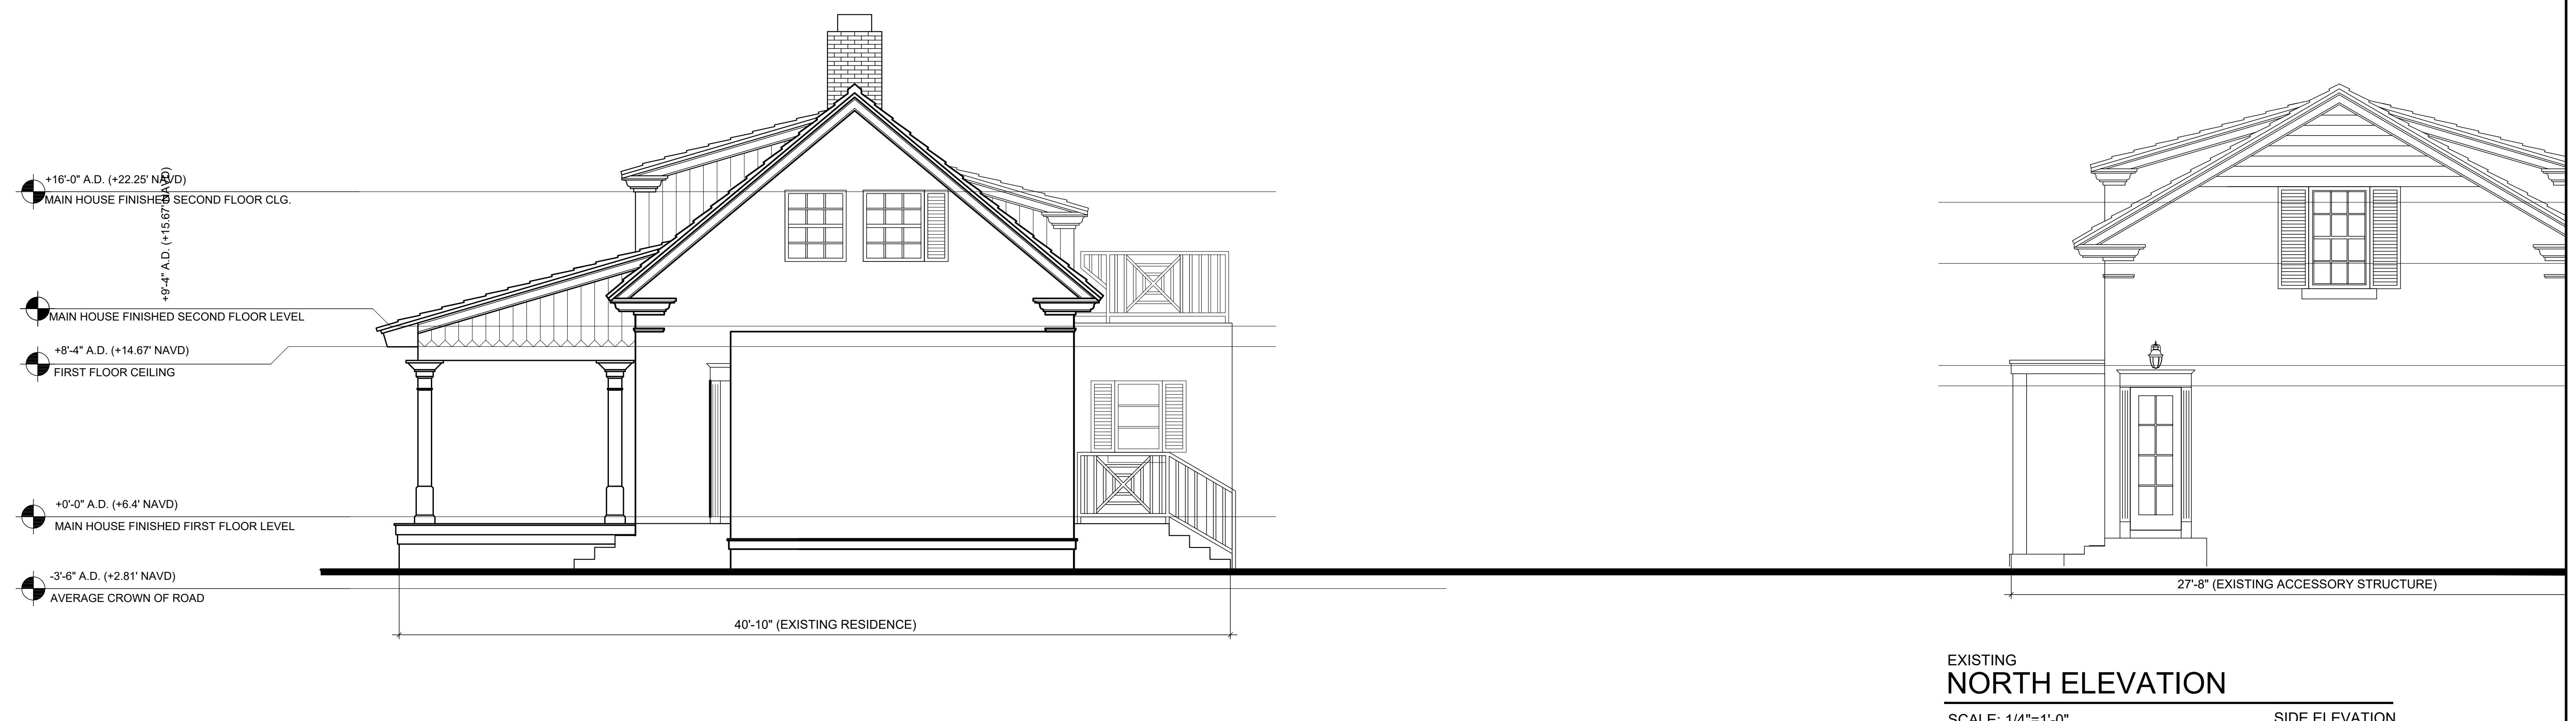

EXISTING
NORTH ELEVATION

SCALE: 1/4"=1'-0" SIDE ELEVATION

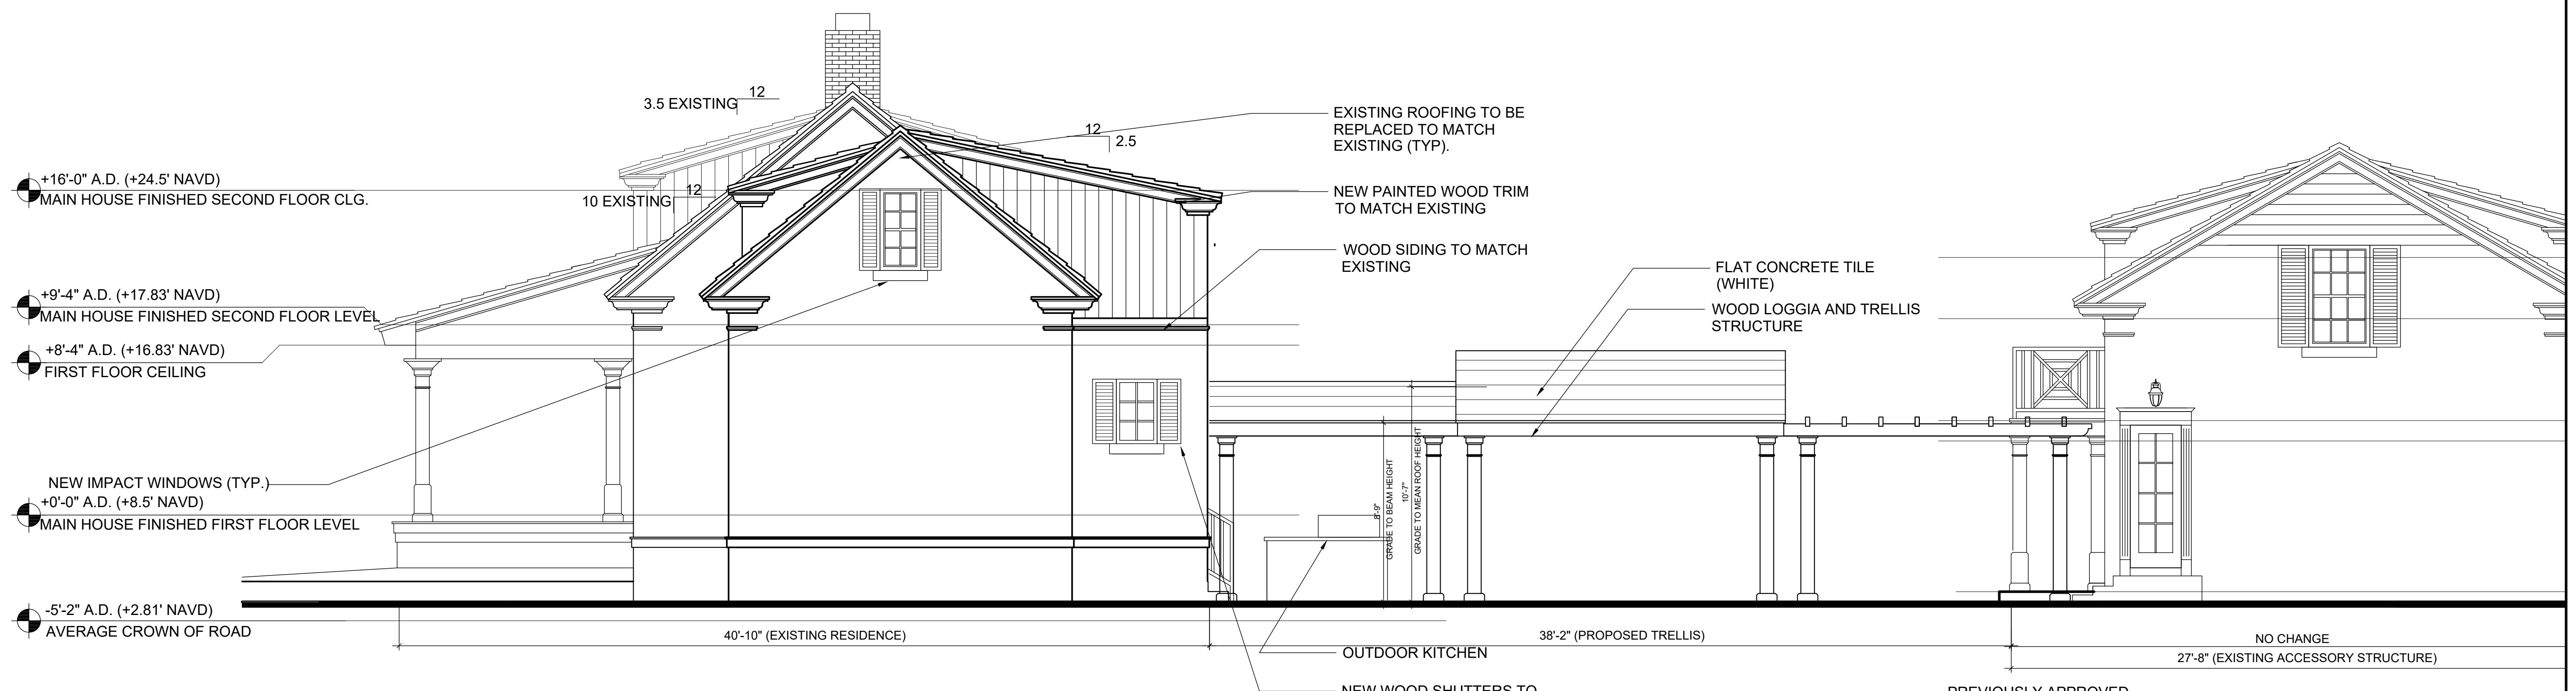

PREVIOUSLY APPROVED
NORTH ELEVATION

SCALE: 1/4"=1'-0" SIDE ELEVATION

PAUL CHARETTE A.I.A.
LICENSE AR0016279

MARK HUNLEY A.I.A.
LICENSE AR0099784

THIS ITEM HAS BEEN
ELECTRONICALLY SIGNED
AND SEALED BY MARK
HUNLEY OR PAUL
CHARETTE ON THE DATE
ADJACENT TO THE SEAL
USING A SHA
AUTHENTICATION CODE.
PRINTED COPIES OF THIS
DOCUMENT ARE NOT
CONSIDERED SIGNED
AND SEALED AND THE SHA
AUTHENTICATION CODE
MUST BE VERIFIED ON ANY
ELECTRONIC COPIES.



paul@charettearch.com
561-756-6094
mark@charettearch.com
954-809-9802
www.charettearch.com

CHARETTE
INTERNATIONAL
ARCHITECTURE
551 NW 77TH ST SUITE 107
BOCA RATON, FL 33487

ANGIE PORTER
170 MARINE WAY
DELRAY BEACH, FL
2023-114

STARTED:
PRELIM:
PRELIM 2: 8-8-23
PRELIM 3:
PRELIM FINAL:
CONST. DOCS: 8-23
BLDG. DEPT: 9-18-23
BLDG. DEPT: 10-10-23
BLDG. DEPT: 10-17-23
HISTORICAL REV: 2-17-24
ISSUED:
SHEET

A6

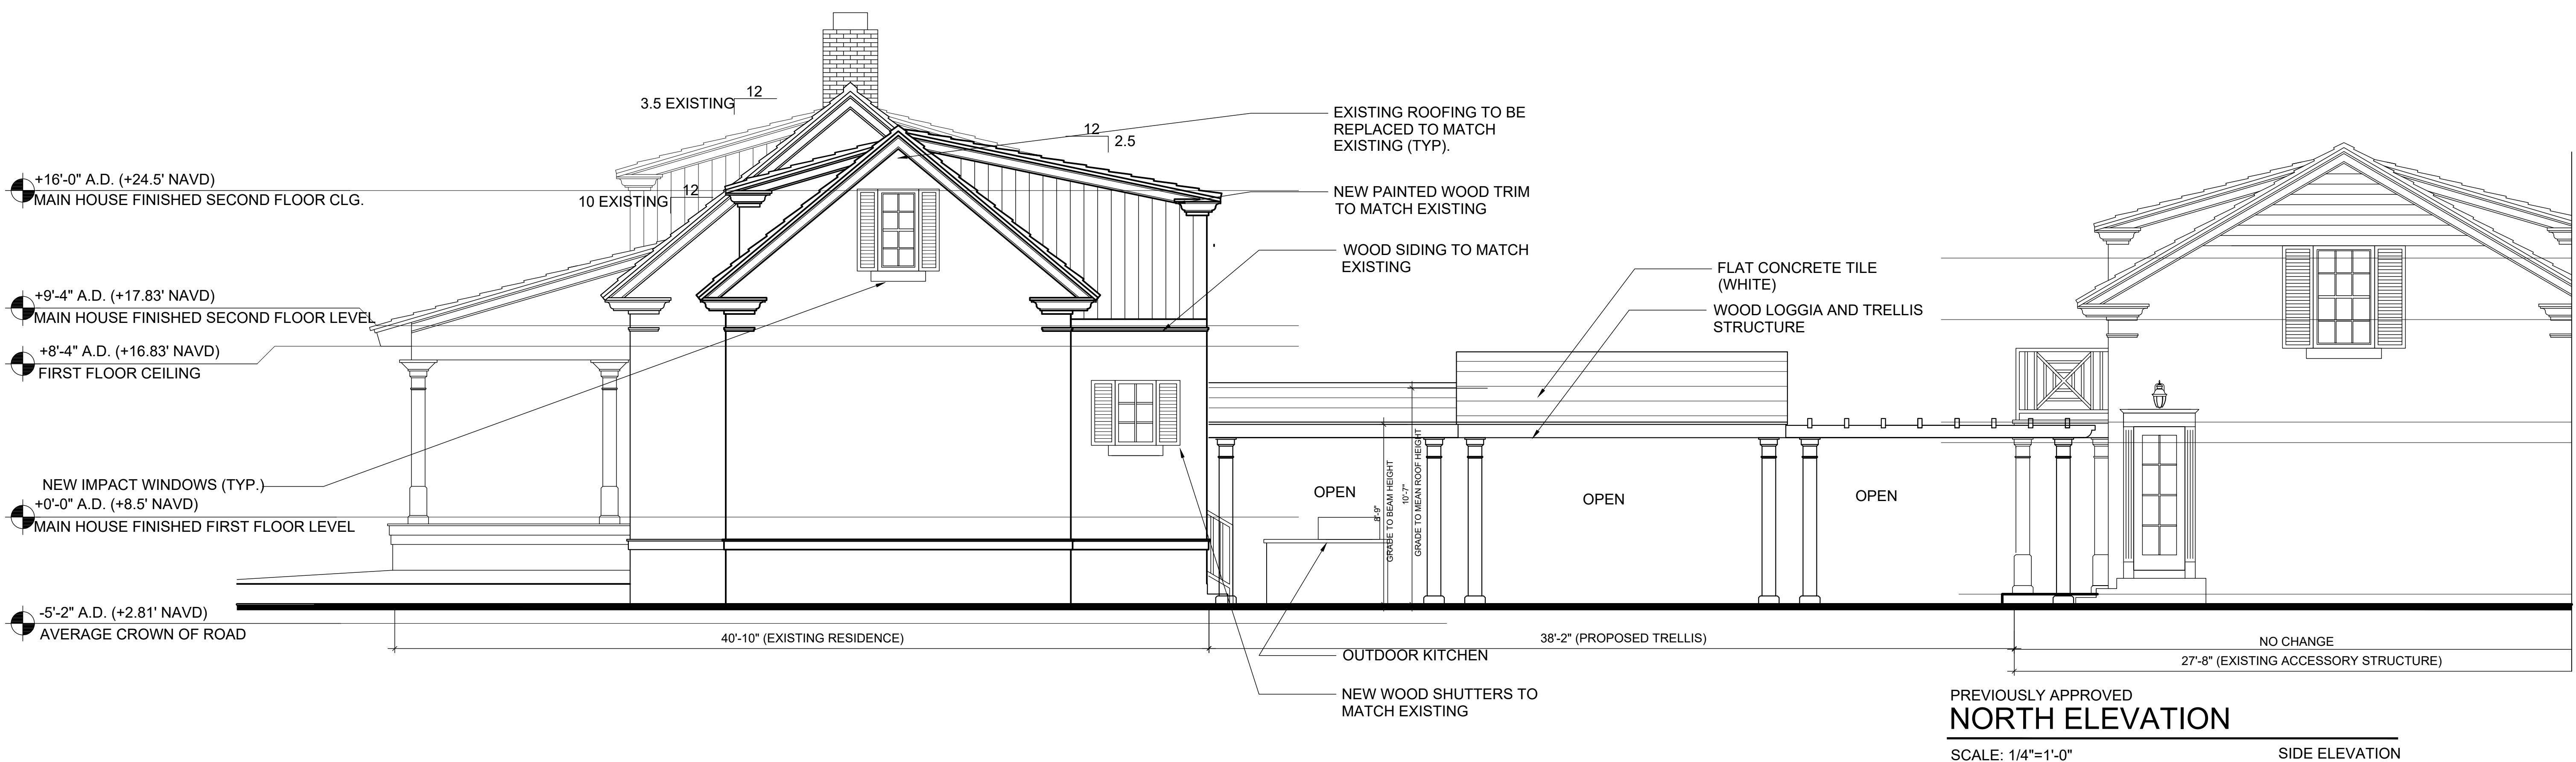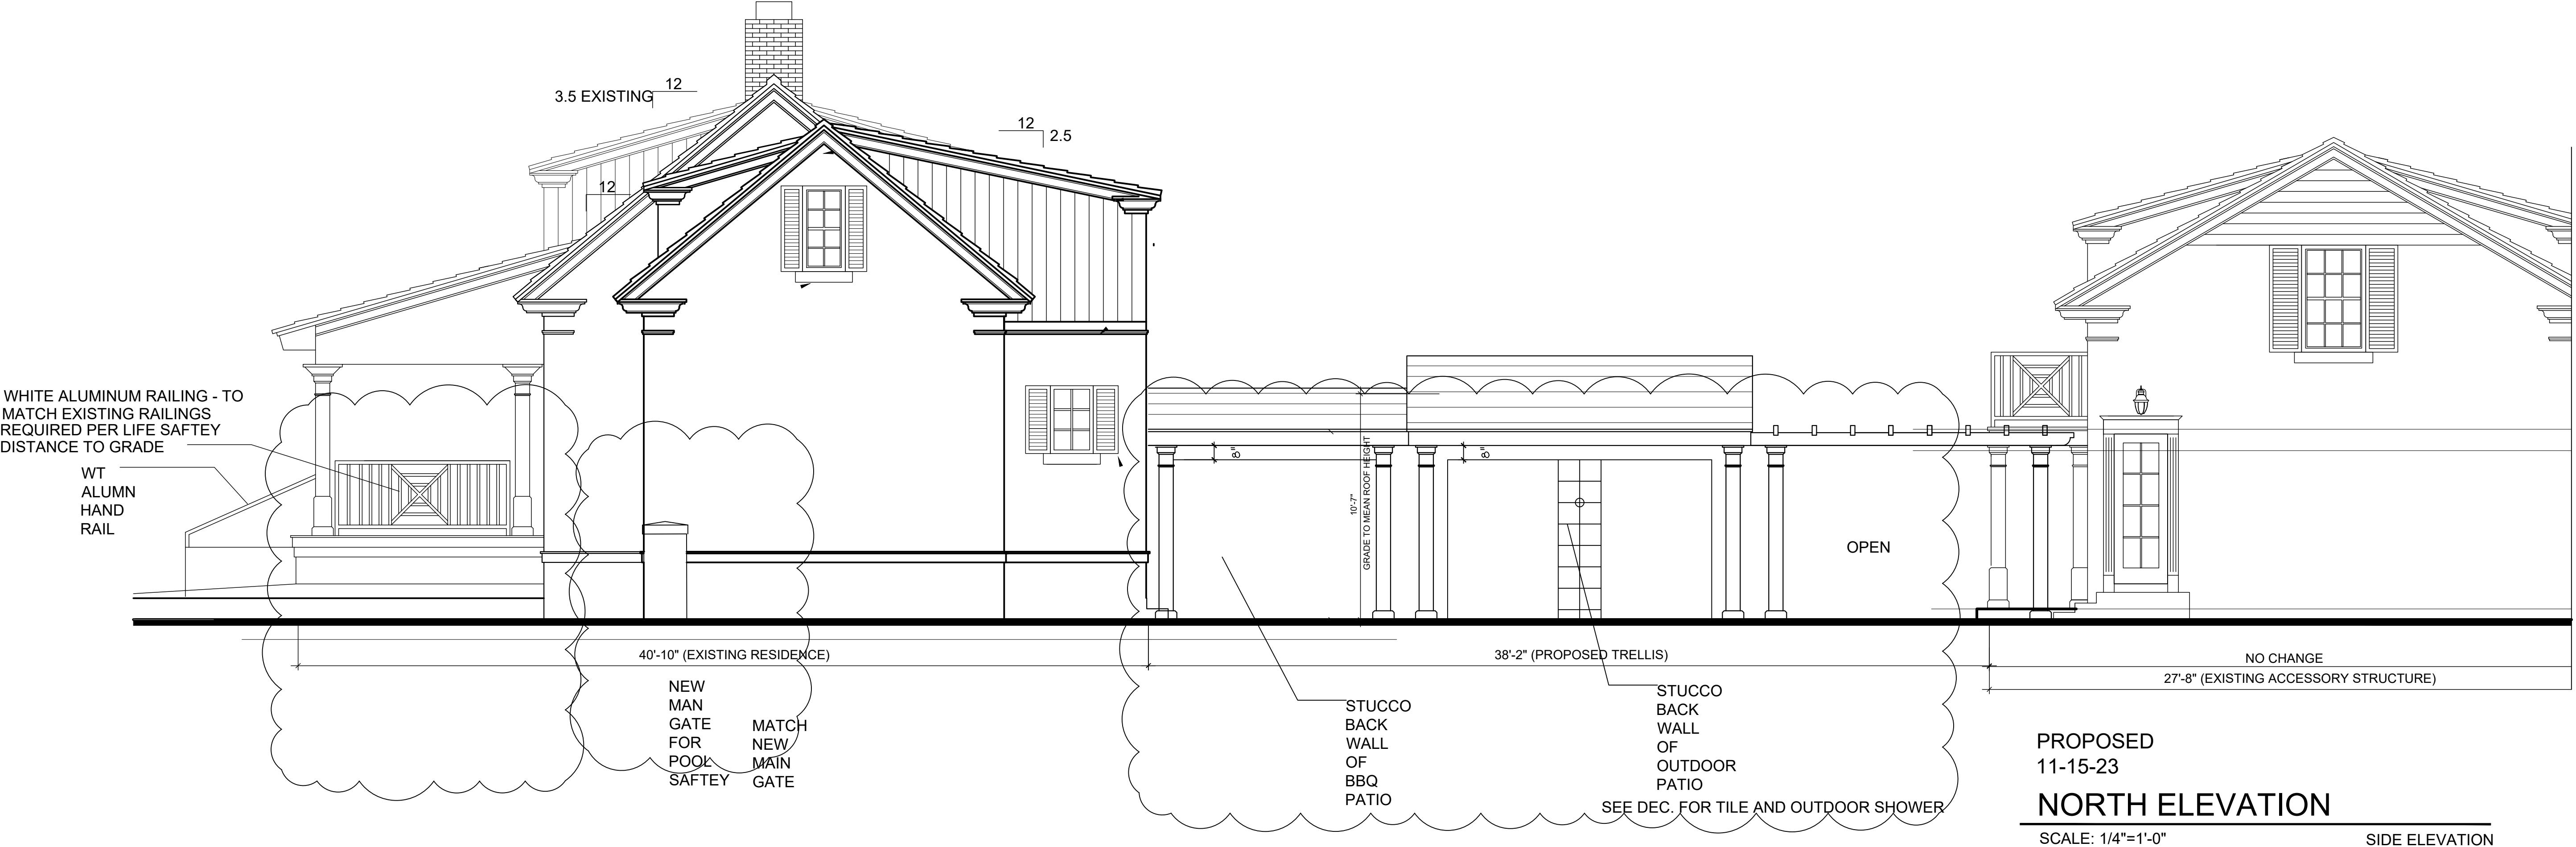

PAUL CHARETTE A.I.A.
LICENSE AR0016279

MARK HUNLEY A.I.A.
LICENSE AR0099784

THIS ITEM HAS BEEN
ELECTRONICALLY SIGNED
AND SEALED BY MARK
HUNLEY OR PAUL
CHARETTE ON THE DATE
ADJACENT TO THE SEAL
USING THE SHA
AUTHENTICATION CODE.
PRINTED COPIES OF THIS
DOCUMENT ARE NOT
CONSIDERED SIGNED AND
SEALED AND THE SHA
AUTHENTICATION CODE
MUST BE VERIFIED ON ANY
ELECTRONIC COPIES.

paul@charettearch.com
561-756-6094
mark@charettearch.com
954-809-9802
www.charettearch.com



**CHARETTE
INTERNATIONAL
ARCHITECTURE**
551 NW 77TH ST SUITE 107
BOCA RATON, FL 33487

ANGIE PORTER
170 MARINE WAY
DELRAY BEACH, FL
2023-114

STARTED:
PRELIM: 8-8-23
PRELIM 2: 9-18-23
PRELIM 3: 10-10-23
PRELIM FINAL:
CONST DOCS: 8-30-23
BLDG DEPT: 9-18-23
BLDG DEPT: 10-10-23
BLDG DEPT: 10-17-23
HISTORICAL REV: 2-17-24


ISSUED:
SHEET

A7

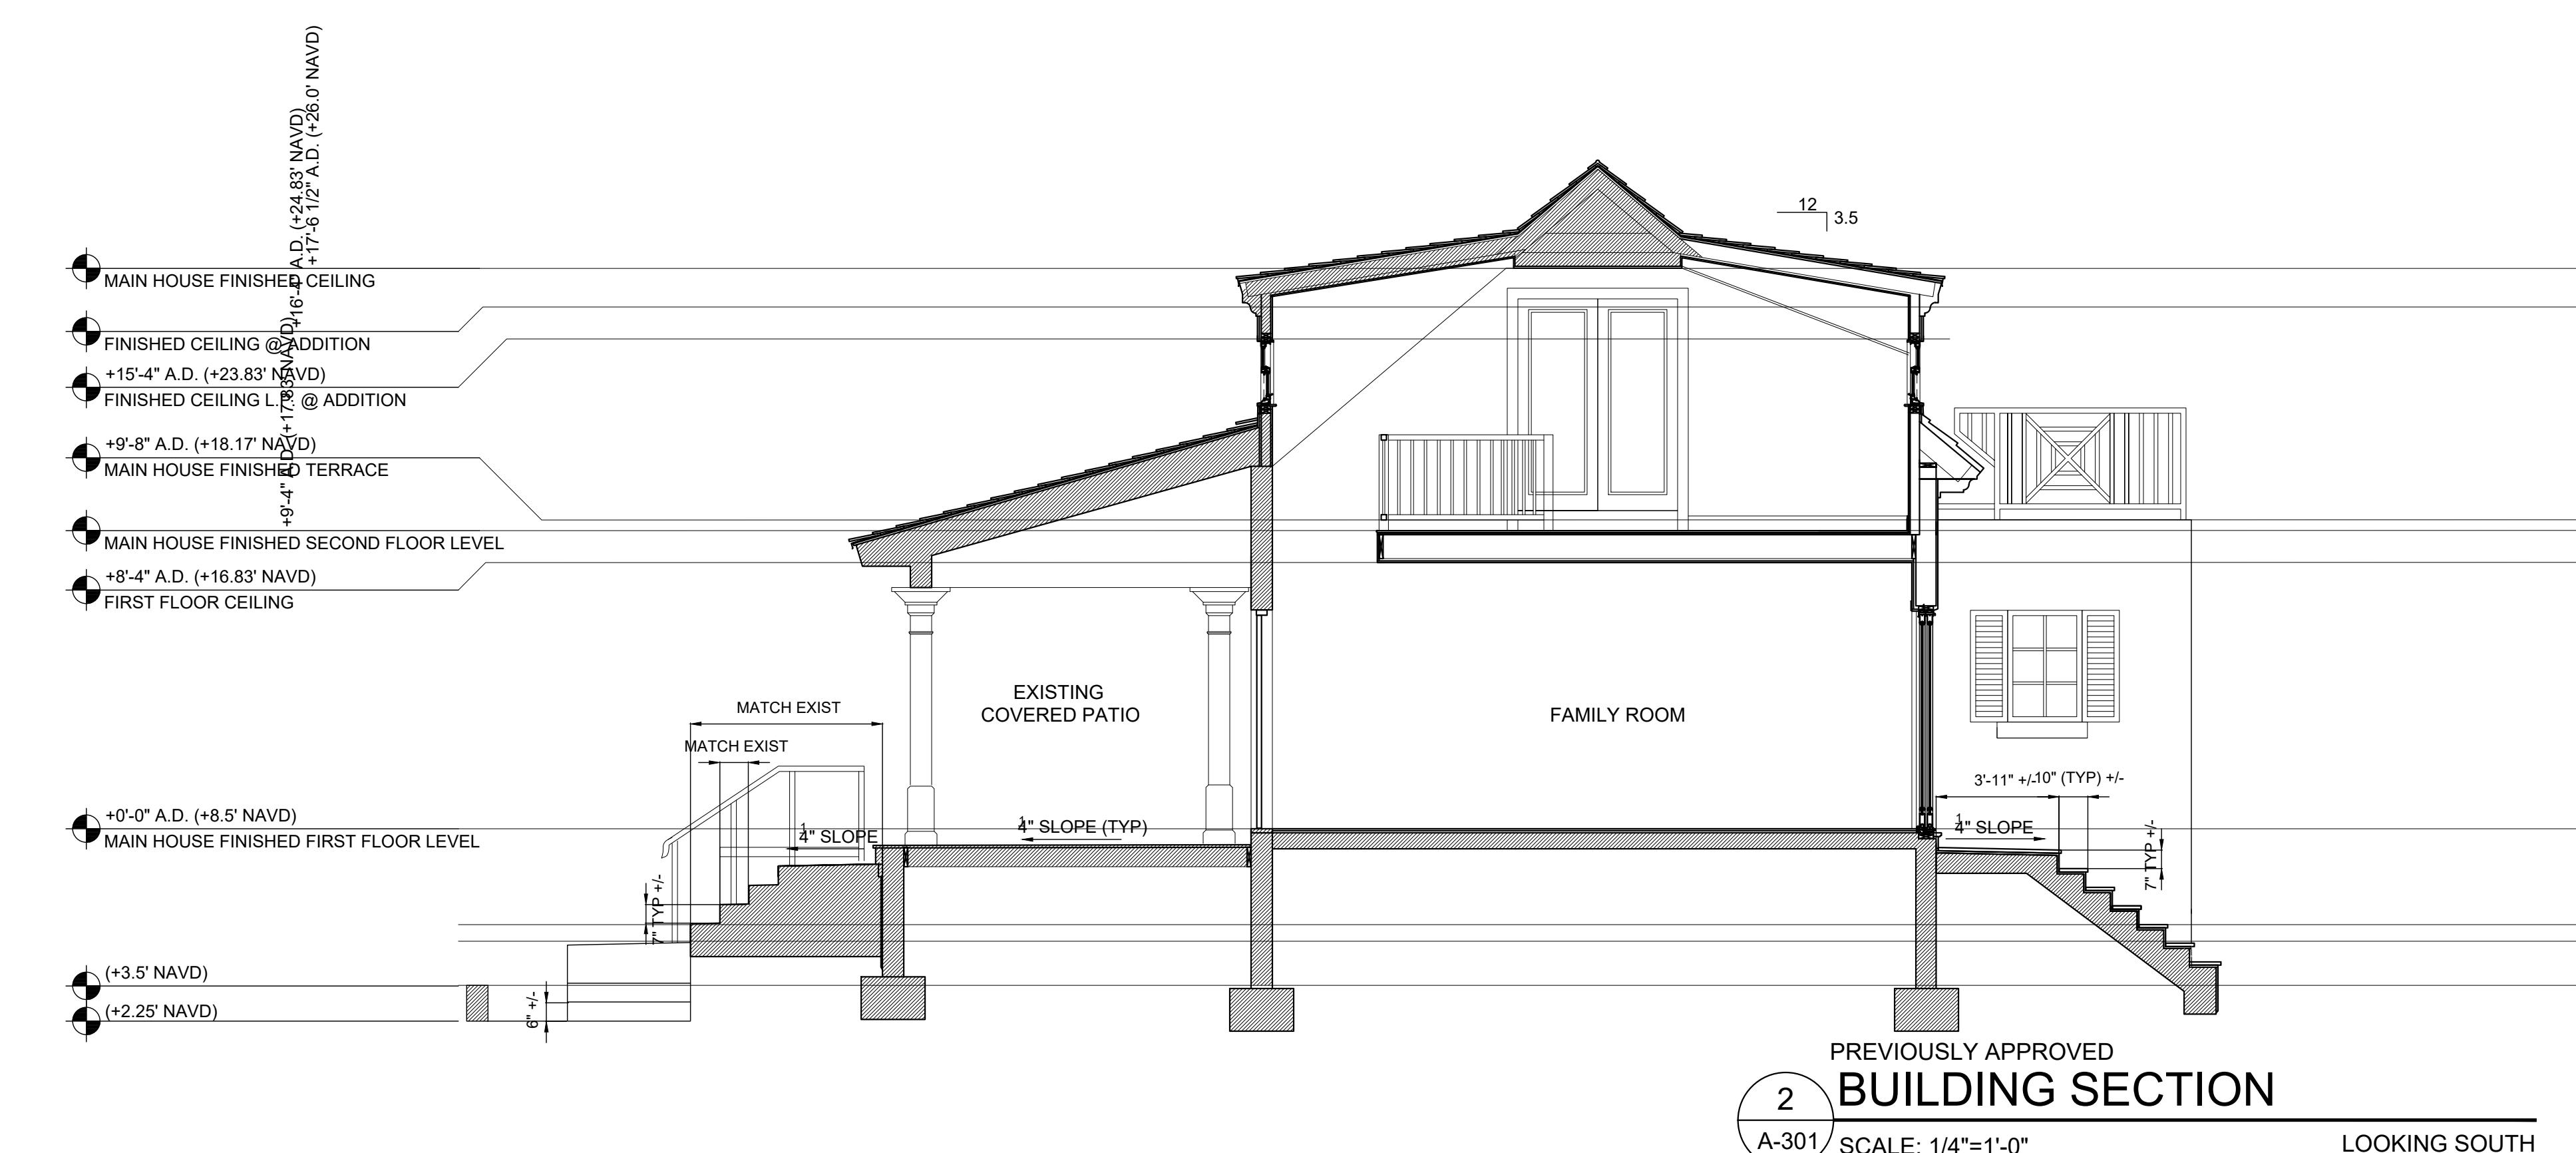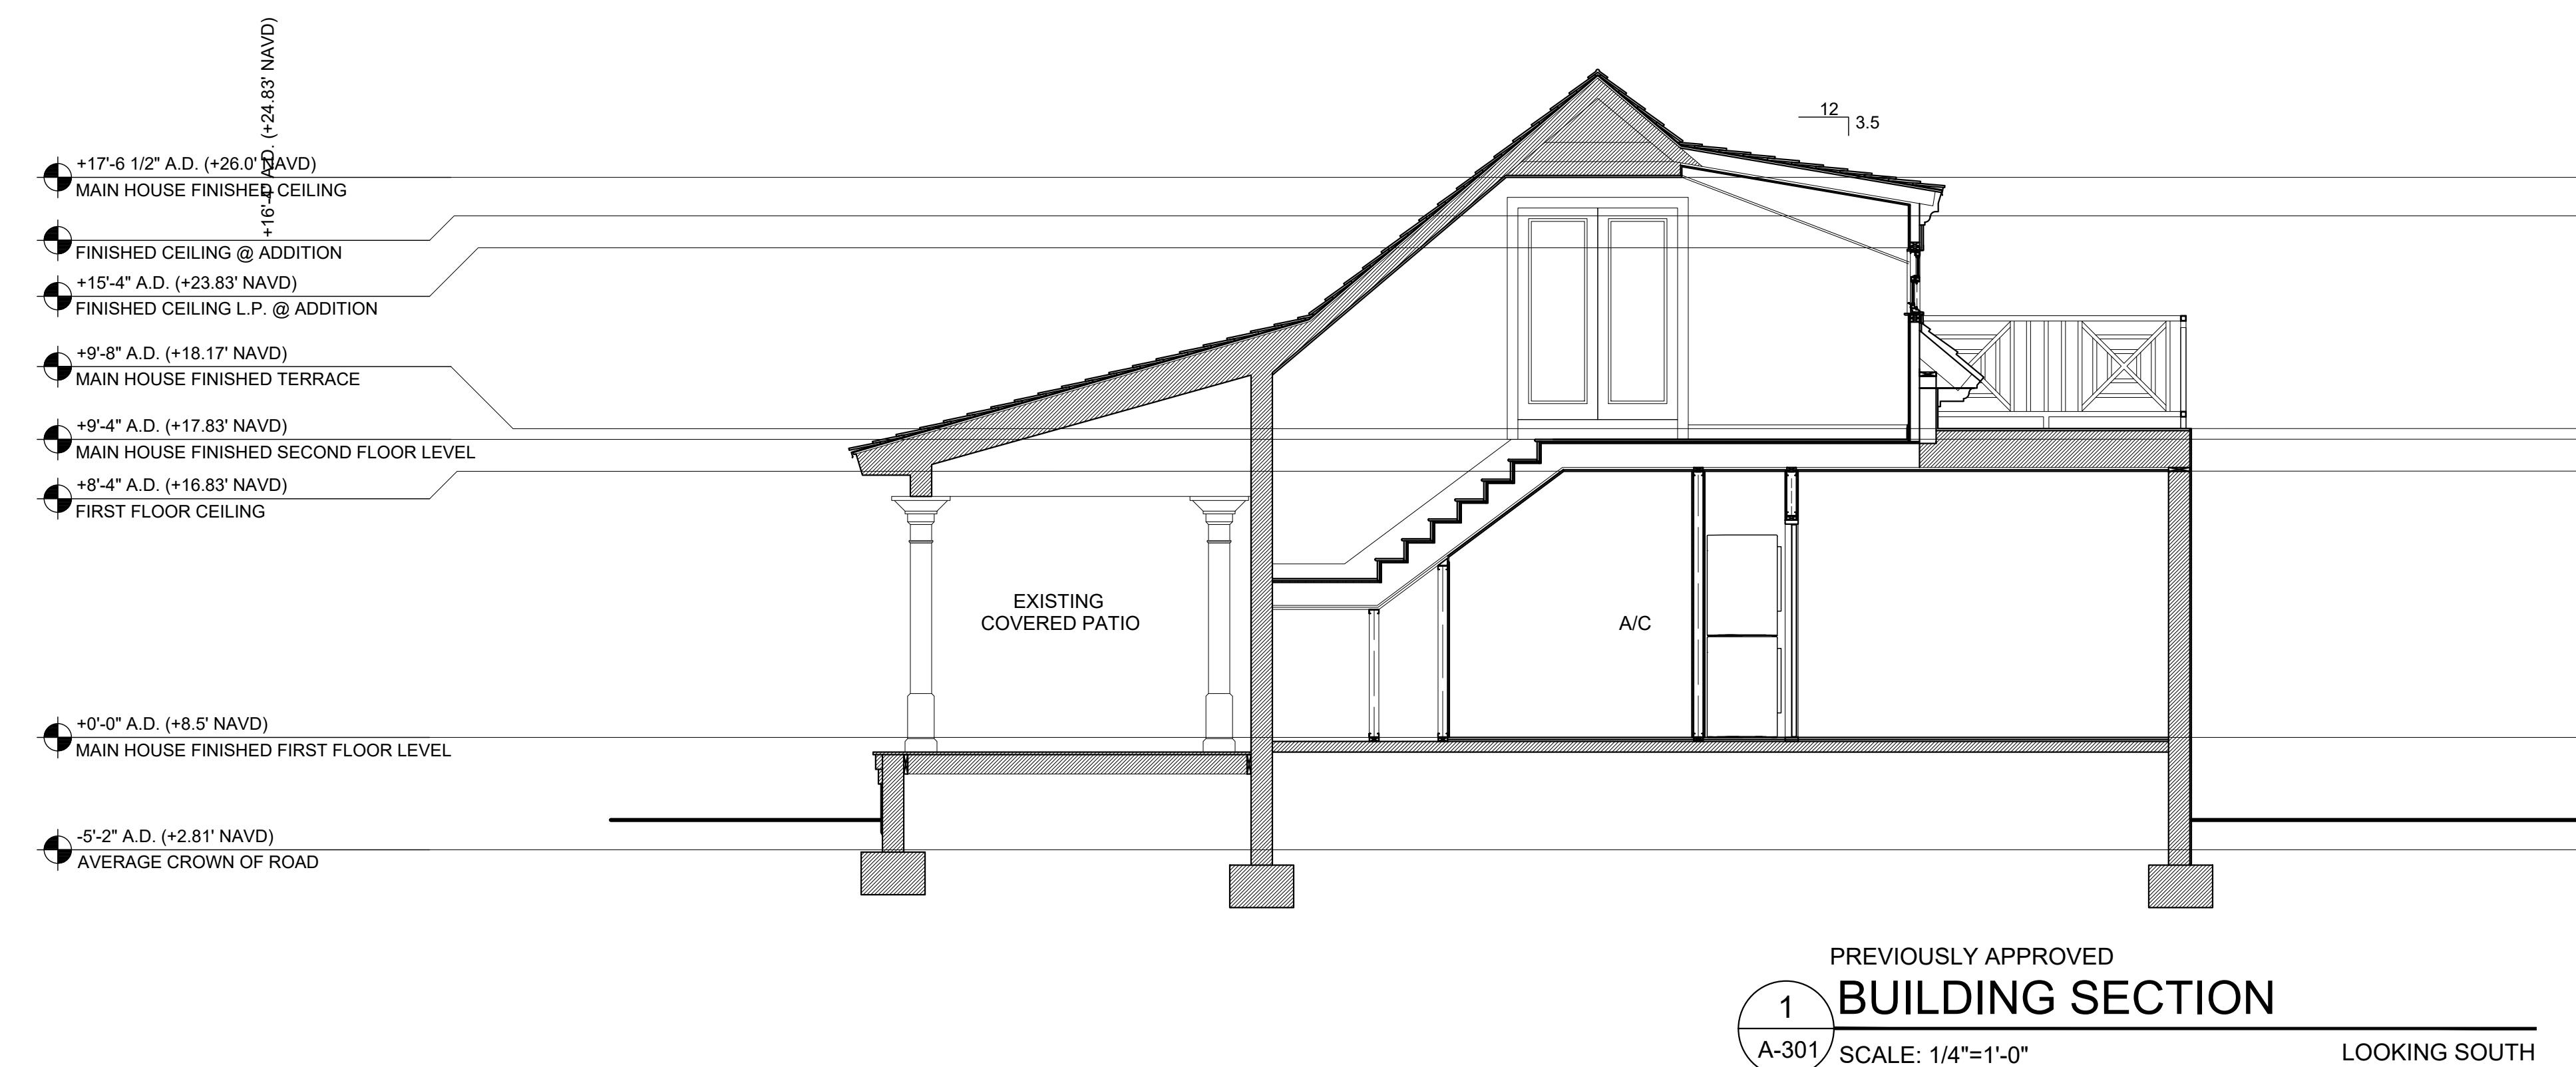




TRIM COLOR
BENJAMIN MOORE
CHANTILLY LACE - OC-65

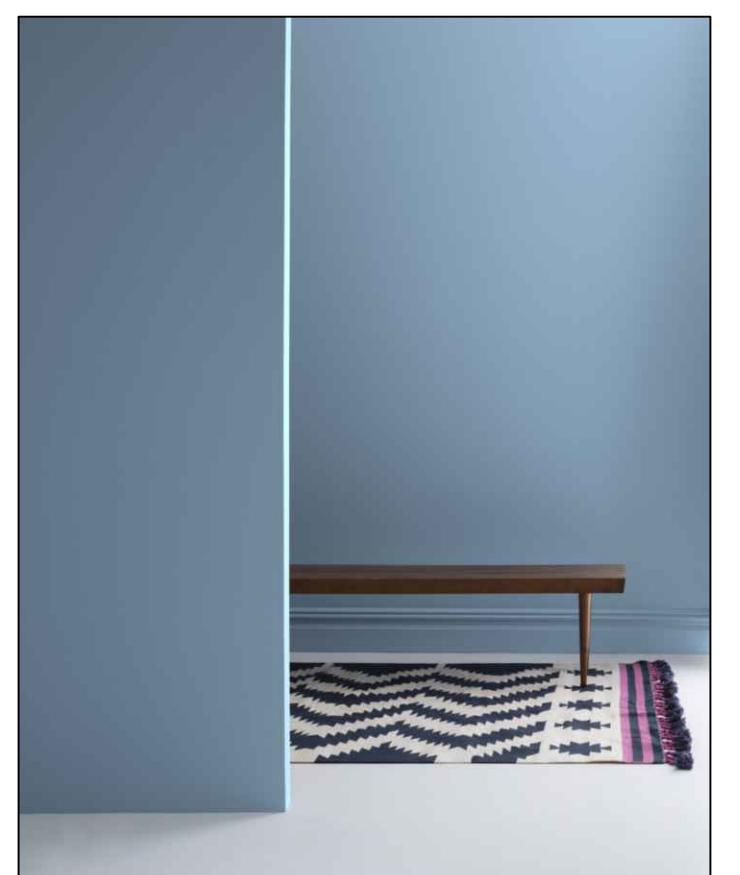



SHUTTER COLOR
BENJAMIN MOORE
DENIM WASH - OC-770

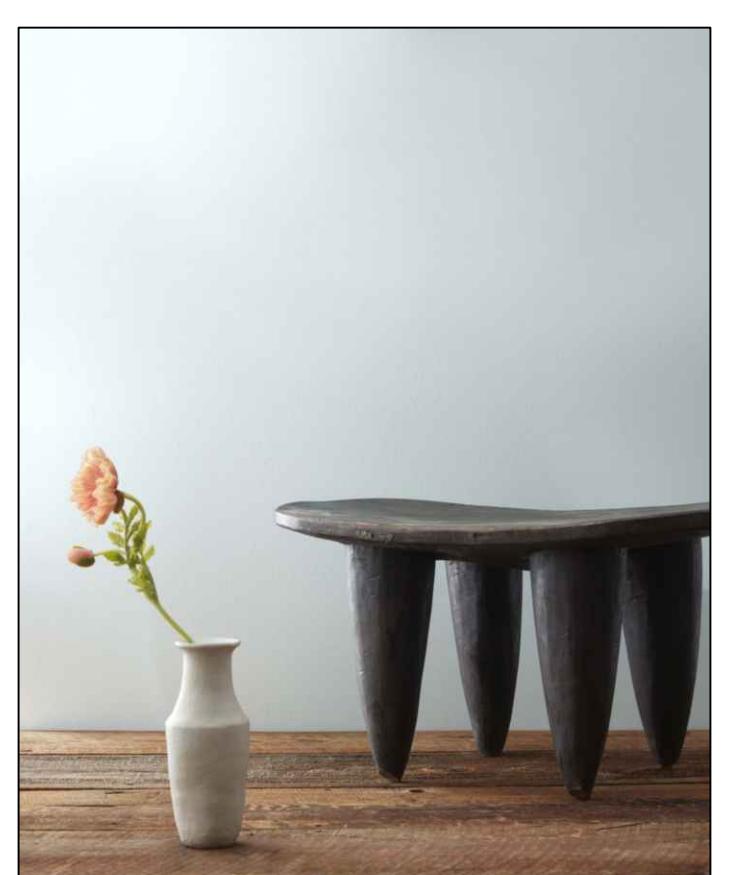

MAIN BODY COLOR
BENJAMIN MOORE
ICEBERG - 2122-50



FRONT DOOR COLOR
BENJAMIN MOORE
KENSINGTON - 840

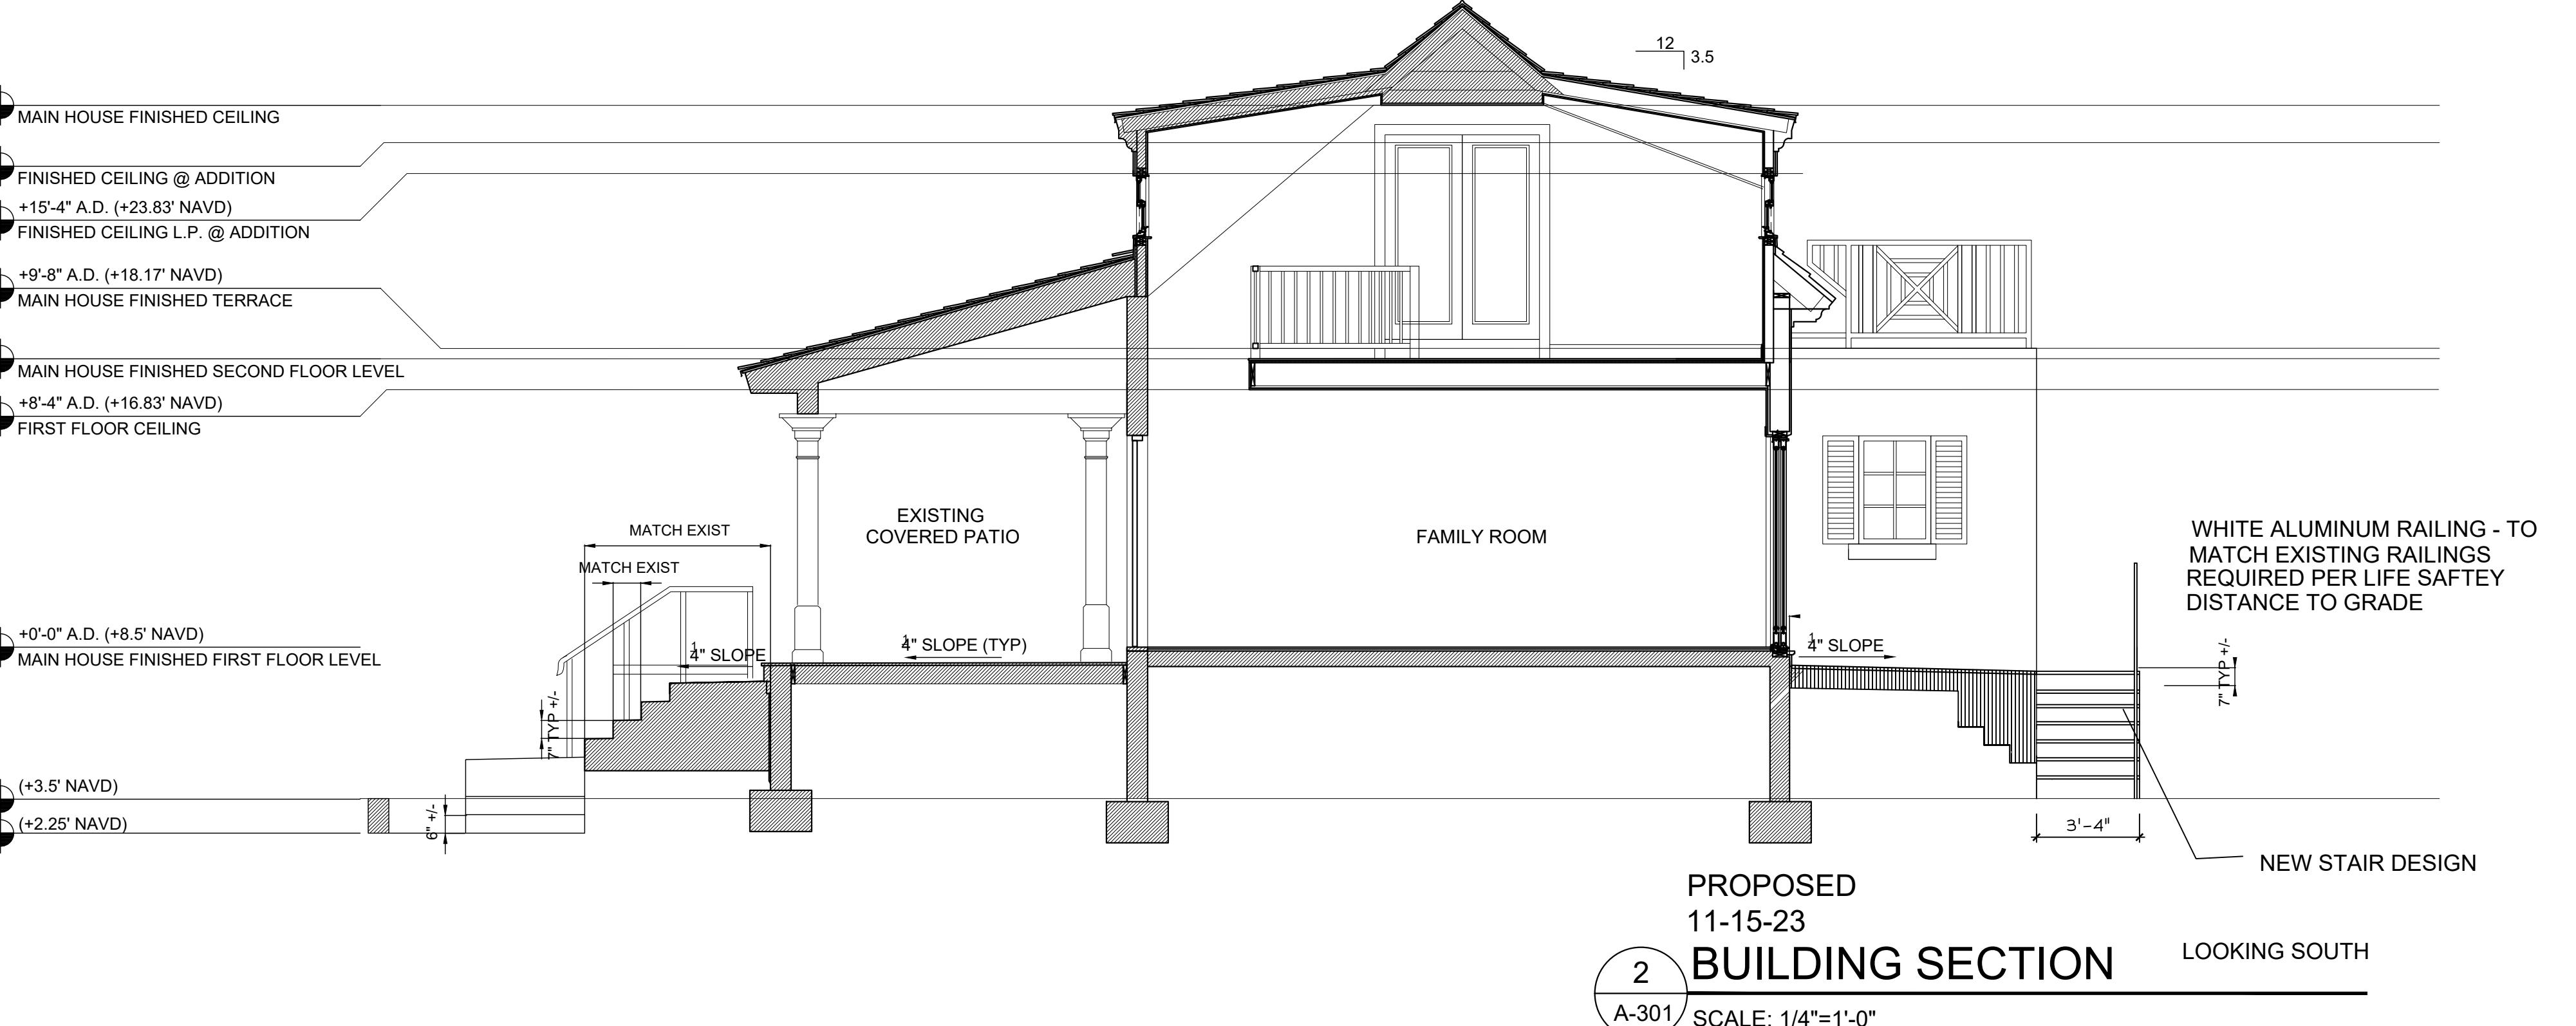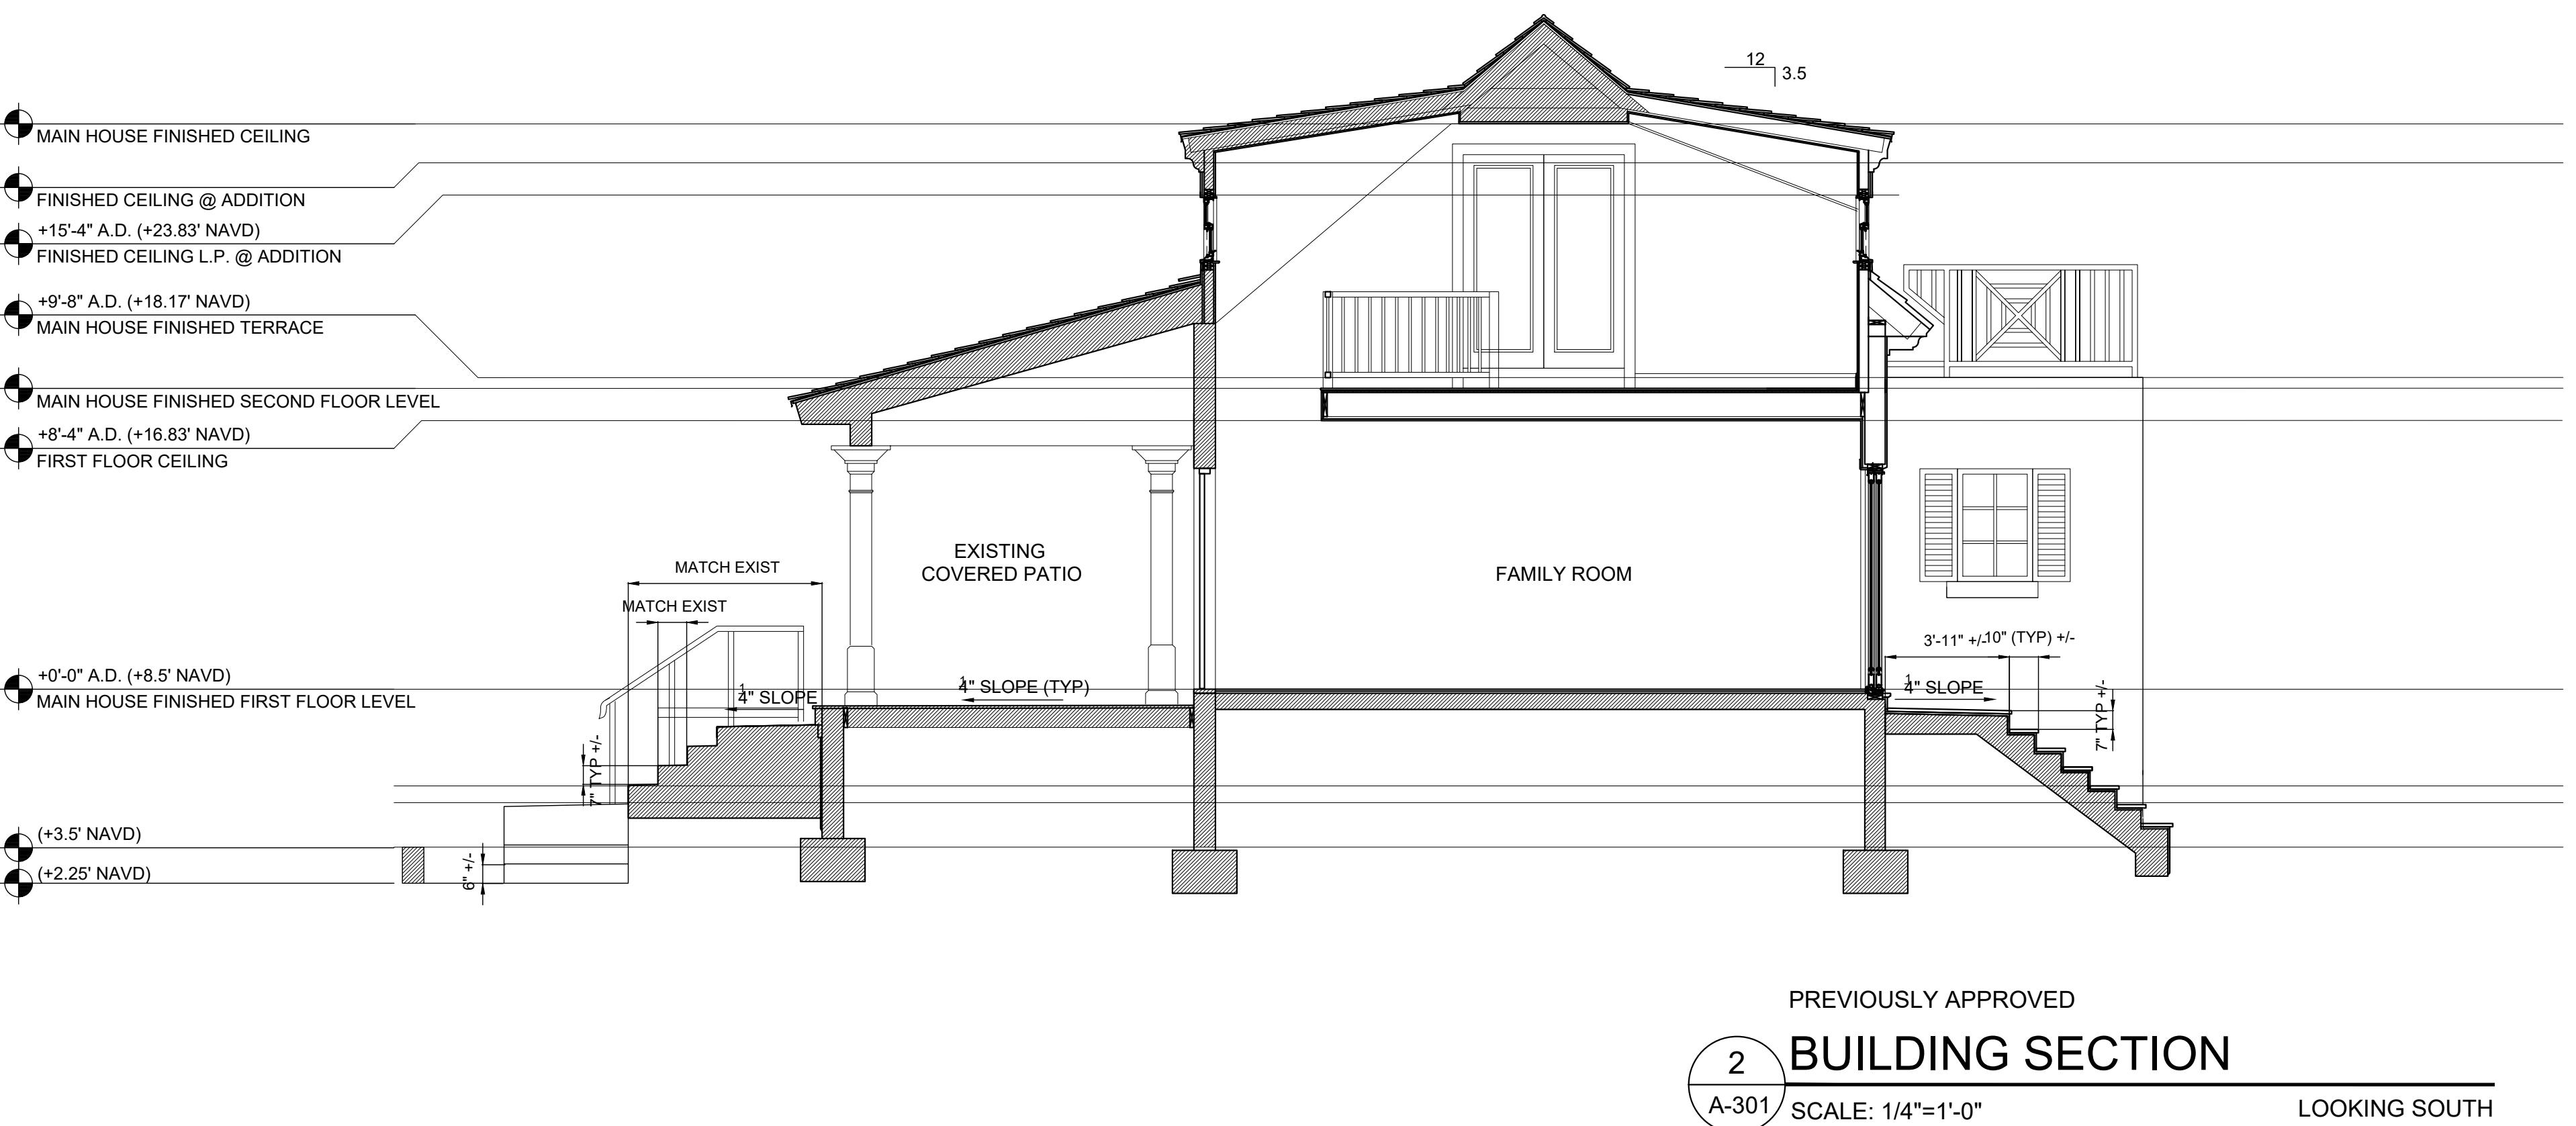

PAUL CHARETTE A.I.A.
LICENSE AR0016279

MARK HUNLEY A.I.A.
LICENSE AR0099784

THIS ITEM HAS BEEN
ELECTRONICALLY SIGNED
AND SEALED BY MARK
HUNLEY OR PAUL
CHARETTE ON THE DATE
INDICATED. PRINTED COPIES
OF THIS DOCUMENT ARE NOT
CONSIDERED SIGNED AND
SEALED AND THE SHA
AUTHENTICATION CODE
MUST BE VERIFIED ON ANY
ELECTRONIC COPIES.

paul@charettearch.com
561-756-6094
mark@charettearch.com
954-809-9802
www.charettearch.com

CHARETTE
INTERNATIONAL
ARCHITECTURE
551 NW 77TH ST SUITE 107
BOCA RATON, FL 33487

ANGIE PORTER
170 MARINE WAY
DELRAY BEACH, FL
2023-114

STARTED:
PRELIM: 8-8-23
PRELIM 2: 8-8-23
PRELIM 3:
PRELIM FINAL:
CONST DOCS: 8-30-23
BLDG DEPT: 9-18-23
BLDG DEPT: 10-10-23
BLDG DEPT: 10-17-23
HISTORICAL REV. 2-17-24
ISSUED:
SHEET


A7.1




TRIM COLOR
BENJAMIN MOORE
CHANTILLY LACE - OC-65



SHUTTER COLOR
BENJAMIN MOORE
DENIM WASH - OC-770

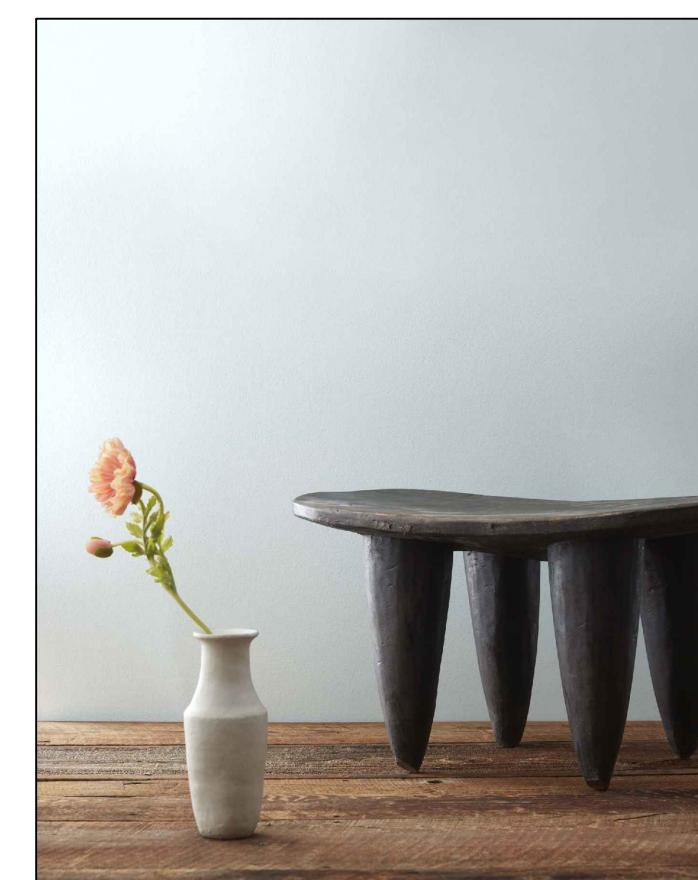

MAIN BODY COLOR
BENJAMIN MOORE
ICEBERG - 2122-50

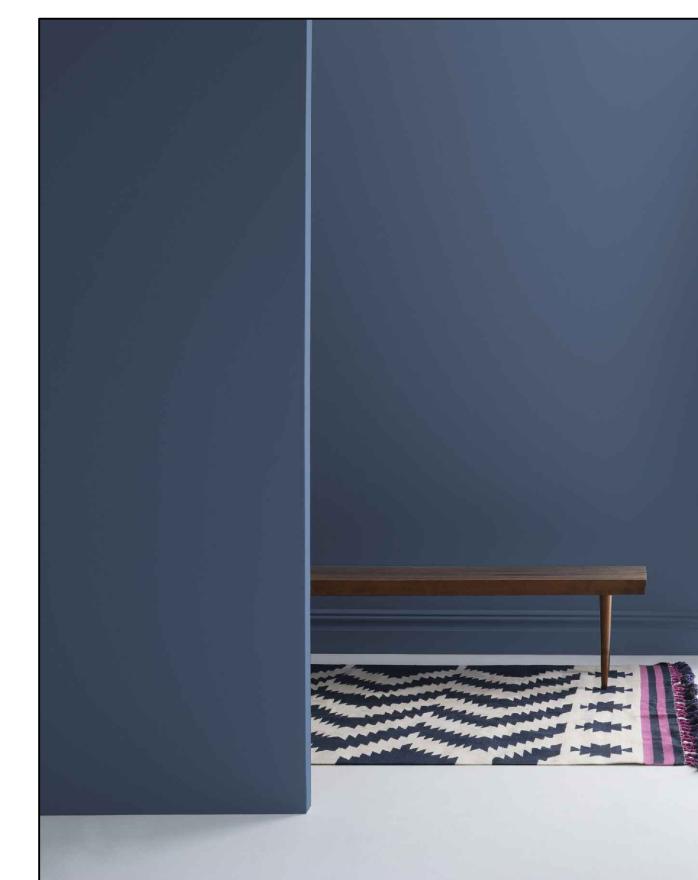

FRONT DOOR COLOR
BENJAMIN MOORE
KENSINGTON - 840



SIDE GATE AND PORCH RAILING



ANGIE PORTER
170 MARINE WAY
DELRAY BEACH, FL
2023-114

STARTED:
PRELIM:
PRELIM 2: 8-8-23
PRELIM 3:
PRELIM FINAL:
CONST DOCS: 8-30-23
BLDG DEPT: 9-18-23
BLDG DEPT: 10-10-23
BLDG DEPT: 10-17-23
HISTORICAL REV: 2-17-24
ISSUED:
SHEET

A8

PAUL CHARETTE A.I.A.
LICENSE AR0016279

MARK HUNLEY A.I.A.
LICENSE AR0099784

THIS ITEM HAS BEEN
ELECTRONICALLY SIGNED
AND SEALED BY MARK
HUNLEY OR PAUL
CHARETTE ON THE DATE
USING A SHA
AUTHENTICATION CODE.
PRINTED COPIES OF THIS
DOCUMENT ARE NOT
CONSIDERED SIGNED AND
SEALED AND THE SHA
AUTHENTICATION CODE
MUST BE VERIFIED ON ANY
ELECTRONIC COPIES.

paul@charettearch.com
561-756-6094
mark@charettearch.com
954-809-9802
www.charettearch.com

CHARETTE
INTERNATIONAL
ARCHITECTURE
551 NW 77TH ST SUITE 107
BOCA RATON, FL 33487



947 Clint Moore Road
Boca Raton, Florida 33487

SURVEYING & MAPPING
Certificate of Authorization No. LB7264

Tel: (561) 241-9988
Fax: (561) 241-5182

BOUNDARY, TOPOGRAPHIC AND TREE SURVEY LOT 15, A SUBDIVISION OF BLOCK 126

LEGAL DESCRIPTION


LOT 15, A SUBDIVISION OF BLOCK 126, DELRAY BEACH, ACCORDING TO THE PLAT THEREOF, AS RECORDED IN PLAT BOOK 11, PAGE(S) 4, OF THE PUBLIC RECORDS OF PALM BEACH COUNTY, FLORIDA.

SAID LANDS SITUATE IN THE CITY OF DELRAY BEACH, PALM BEACH COUNTY, FLORIDA, AND CONTAIN 0.200 ACRES, MORE OR LESS.

NOTES

1. THIS DRAWING IS NOT VALID WITHOUT THE SIGNATURE AND THE ORIGINAL RAISED SEAL OF A FLORIDA LICENSED SURVEYOR AND MAPPER.
2. NO SEARCH OF THE PUBLIC RECORDS WAS PERFORMED OR REFERENCED IN THE PREPARATION OF THIS SURVEY.
3. ALL EASEMENTS SHOWN HEREON ARE PER THE RECORD PLAT(S) UNLESS OTHERWISE INDICATED.
4. THERE HAVE BEEN NO UNDERGROUND IMPROVEMENTS LOCATED IN CONNECTION WITH THIS SURVEY, EXCEPT AS SHOWN. (UNDERGROUND UTILITY PAINT MARK BY OTHERS)
5. BEARINGS SHOWN HEREON ARE BASED ON THE N. R/W LINE OF SE 2ND STREET, HAVING A BEARING OF N89°22'58"W, AS REFERENCED FROM THE STATE PLANE COORDINATE SYSTEM, NORTH AMERICAN DATUM (NAD) 83/90 ADJ.
6. ELEVATIONS SHOWN HEREON ARE RELATIVE TO THE NORTH AMERICAN VERTICAL DATUM, OF 1988 AND WERE DETERMINED FROM PALM BEACH COUNTY BENCHMARK "14.33SRD", ELEVATION: 12.782.
7. PROPOSED DIMENSIONS OBTAINED FROM ARCHITECTURAL DRAWING FROM SMITH KELLOGG ARCHITECTURE, INC. JOB#210512, SHEET SP-101
8. PROPERTY ADDRESS: 170 MARINE WAY, DELRAY BEACH, FL. 33483

COMMUNITY NUMBER : 125102
PANEL NUMBER : 12099C0979
DATE OF FIRM INDEX : 10-05-2017
ZONE : AE
BASE FLOOD ELEVATION : 6.0' for AE

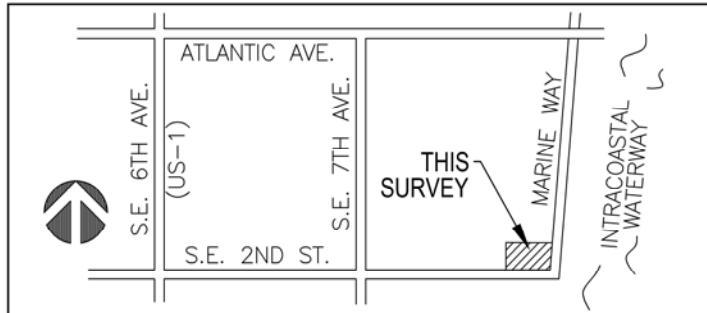

LOCATION MAP

NOT TO SCALE

LEGEND

W	WATER METER	G	GAS SERVICE
E	ELECTRIC SERVICE	-○-	FIRE HYDRANT
T	TELEPHONE BOX	■■■	CATCH BASIN
C	CABLE TV BOX	○	LIGHT POLE
D	DRAINAGE MANHOLE	●	WOOD UTILITY POLE
S	SANITARY MANHOLE	■■■■	CONCRETE UTILITY POLE
W	WATER VALVE	⊖	CLEAN OUT
○	SIGN	¢	CENTERLINE
⊗	TREE	×0.0'	EXISTING ELEVATION

ABBREVIATIONS

A/C	= AIR CONDITIONER
CBS	= CONCRETE BLOCK & STUCCO
CLF	= CHAIN LINK FENCE
CONC.	= CONCRETE
D.E.	= DRAINAGE EASEMENT
EL	= ELEVATION
FF	= FINISHED FLOOR
I.E.	= INVERT ELEVATION
IP	= IRON PIPE
IR	= IRON ROD
IRC	= IRON ROD & CAP
(M)	= MEASURED
MON	= MONUMENT
N/D	= NAIL AND DISC
P.B.	= PLAT BOOK
P.B.C.R.	= PALM BEACH COUNTY RECORDS
PG	= PAGE
PROP	= PROPOSED
(R)	= RECORDED
R/W	= RIGHT-OF-WAY
TYP.	= TYPICAL
U.E.	= UTILITY EASEMENT
WF	= WOOD FENCE
YD	= YARD DRAIN

SURVEYOR'S CERTIFICATION

I HEREBY CERTIFY THAT THE SURVEY SHOWN HEREON COMPLIES WITH STANDARDS OF PRACTICE AS CONTAINED IN CHAPTER 5J-17.051, FLORIDA ADMINISTRATIVE CODE, PURSUANT TO SECTION 472.027, FLORIDA STATUTES, AND THAT SAID SURVEY IS TRUE AND CORRECT TO THE BEST OF MY KNOWLEDGE AND BELIEF AS PREPARED UNDER MY DIRECTION.

JEFF S. HODAPP
SURVEYOR AND MAPPER
FLORIDA LICENSE NO. LS5111

DATE OF LAST FIELD WORK: APRIL 09, 2024

04/09/2024 - UPDATE SURVEY
05/11/2023 - FORM BOARD SURVEY
(SITE WALL)
11/01/2022 - PLOT PLAN
05/18/2022 - BOUNDARY SURVEY


PROJECT NAME: 170 MARINE WAY	DATE: 04/09/2024
JOB NO. 22136	DWG BY: GY
CK'D BY: JSH	SHEET 1 OF 2

PERIMETER

SURVEYING & MAPPING
Certificate of Authorization No. LB7264

947 Clint Moore Road
Boca Raton, Florida 33487

Tel: (561) 241-9988
Fax: (561) 241-5182

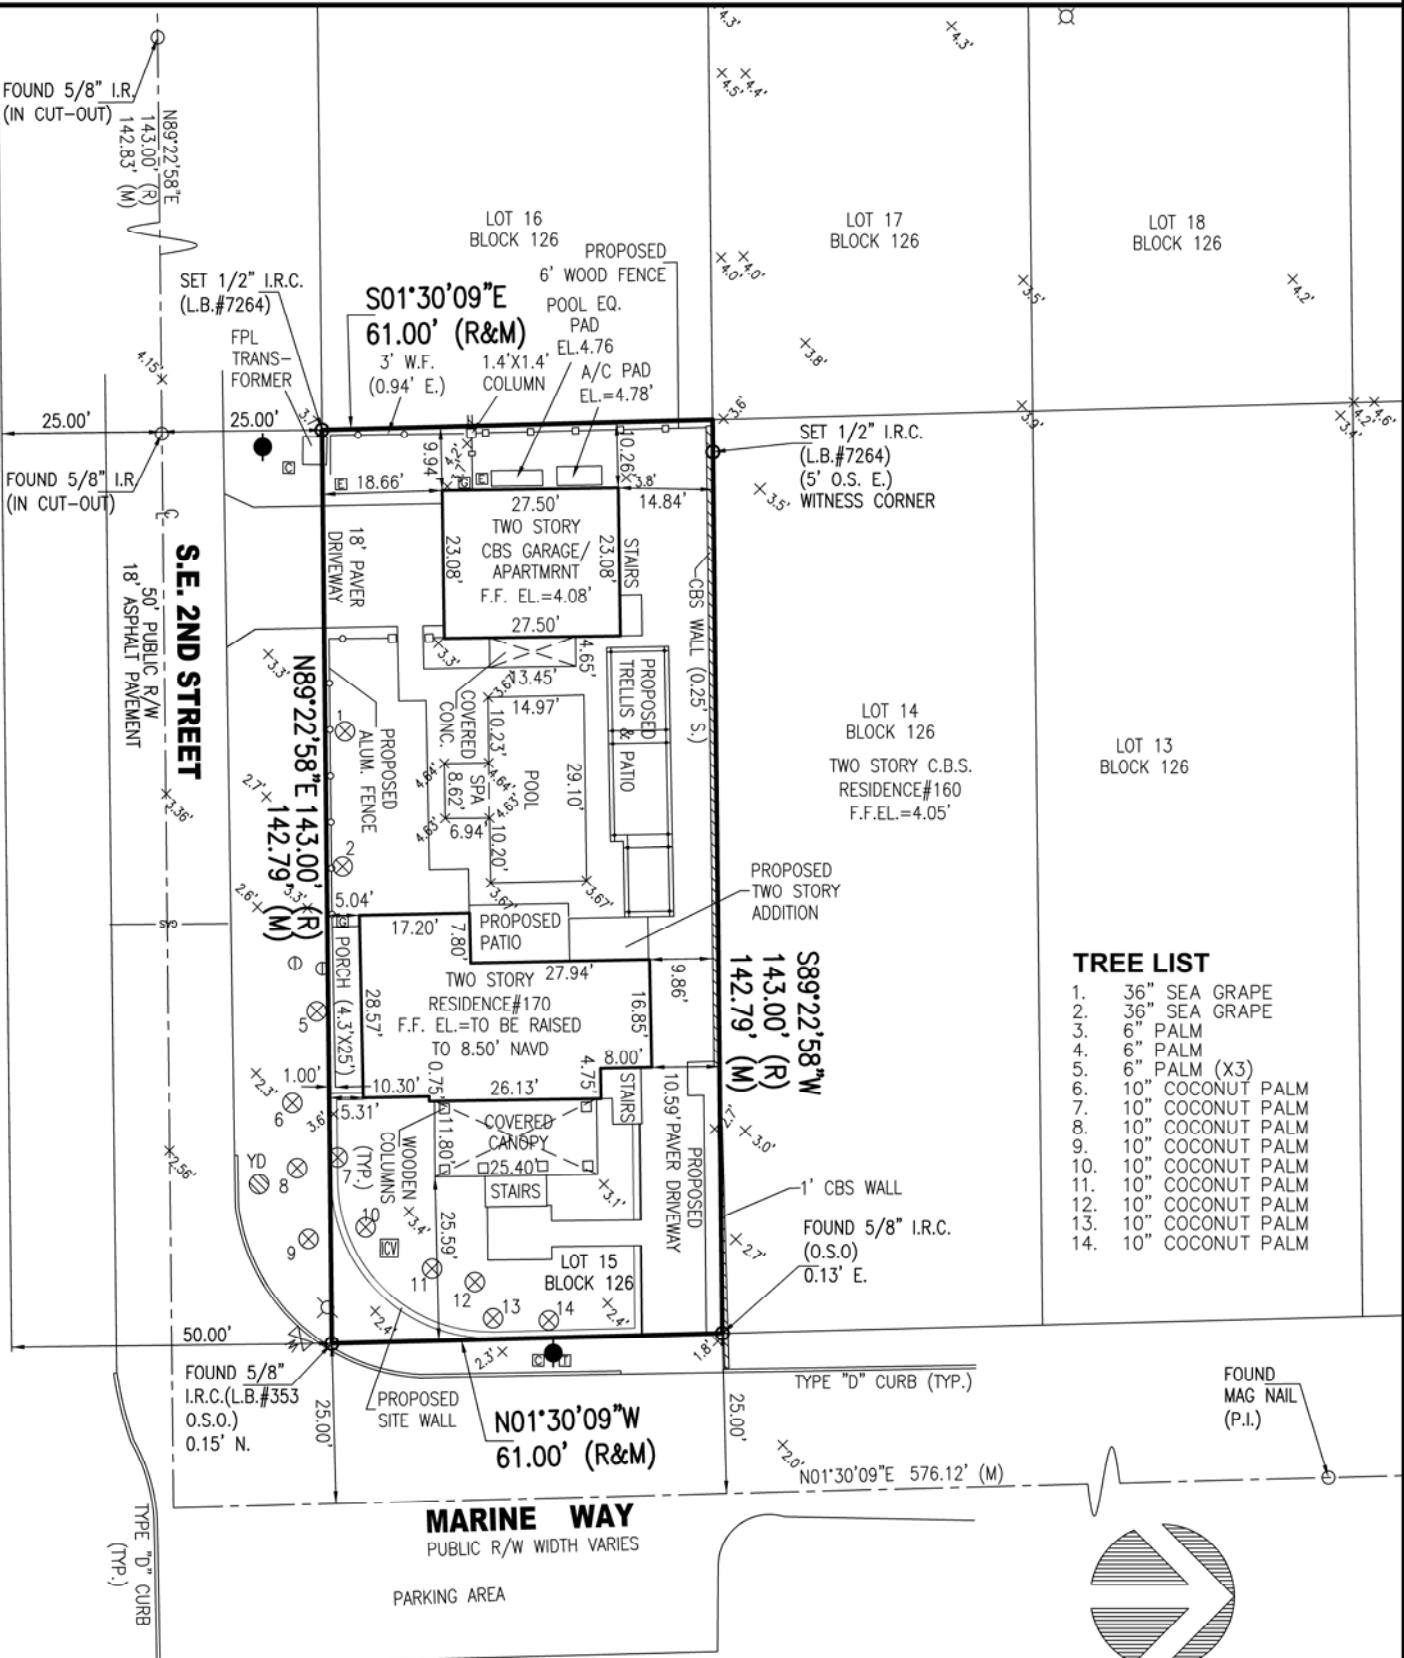

JOB NO. 22136	PROJECT NAME: 170 MARINE WAY	DWG BY: GY	SCALE: 1"=30'
		CK'D BY: JSH	DATE: 04/09/24