


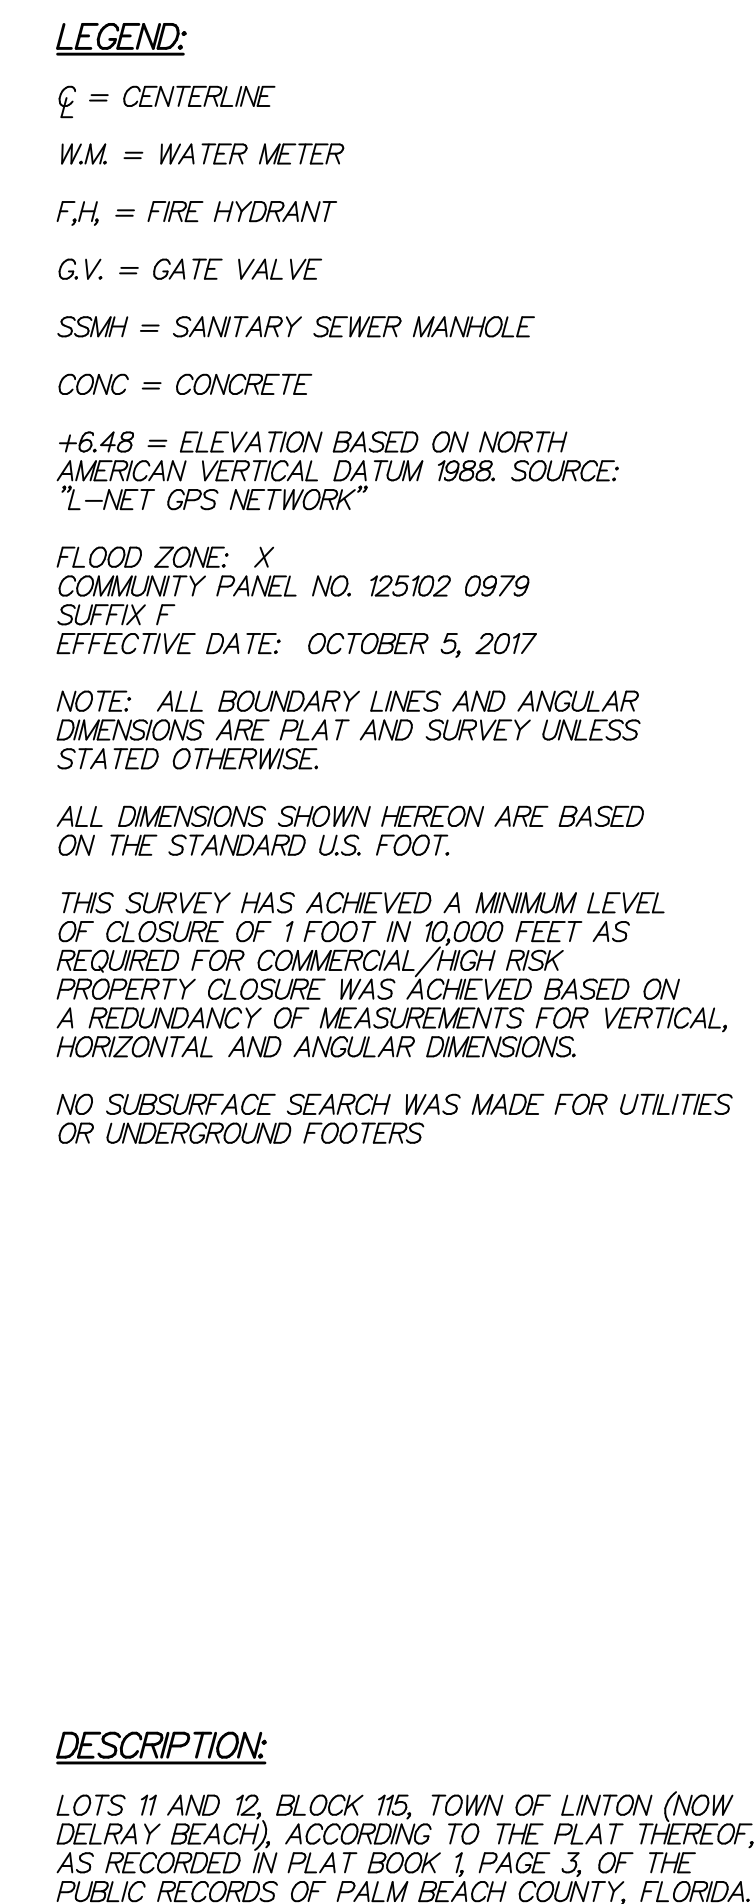

MAP OF AS-BUILT SURVEY
SITE ADDRESS: 142 N.E. 7TH AVENUE
DELRAY BEACH, FLORIDA 33483
PARCEL ID. NO.: 12-43-46-16-01-115-0110
I HEREBY CERTIFY THAT THIS SURVEY WAS MADE UNDER MY RESPONSIBLE CHARGE
AND MEETS THE STANDARDS OF PRACTICE AS SET FORTH BY THE FLORIDA
BOARD OF PROFESSIONAL SURVEYORS AND MAPPERS, CHAPTER 54, FLORIDA
ADMINISTRATIVE CODE, PURSUANT TO SECTION 472.027, FLORIDA STATUTES.

NOT VALID WITHOUT THE SIGNATURE AND
THE ORIGINAL RAISED SEAL OF A FLORIDA
LICENSED SURVEYOR AND MAPPER.

ENGLE LAND SURVEYING LLC
LAND SURVEYORS
CERTIFICATE OF AUTHORIZATION #LB8447
SURVEYOR AND MAPPER IN RESPONSIBLE CHARGE: PAUL D. ENGLE
955 N.W. 17TH AVENUE, SUITE K-1, DELRAY BEACH, FLORIDA 33445
(561) 276-4501 732-3279 FAX 276-2390

DATE OF SURVEY JULY 18, 2023	SCALE: 1" = 10'
FIELD BOOK PAGE NO. D.317 27	ORDER NO.: 18-10ab