

Development Services Department

BOARD ACTION REPORT – APPEALABLE ITEM

Project Name: Opal Grand Hotel Project Location: 10 N. Ocean Blvd Request: Class II Site Plan Modification

PCN: 12-43-46-16-E63-003-0010

Board: Site Plan Review and Appearance Board

Meeting Date: July 27, 2022

Board Action: 6 – 0 (Dana Post Adler absent)

Brief Description: Class II Site Plan Modification, Landscape Plan, and Architectural Elevations for the Opal Grand (fka Marriott) associated with the construction of a raised pool deck above an enclosed vehicular accessway from the north parking lot to the main entrance.

Board Action:

Approved (6-0 Dana Post Adler absent)

Project Description:

The Opal Grand Hotel, formerly known as the Marriott Hotel, is located on the northwest corner of East Atlantic Avenue and North Ocean Boulevard.

The Class II Site Plan Modification includes the following improvements: demolish existing pool deck fence (low wall and four piers) and replace with a raised deck, with 42-inch decorative aluminum guardrails and decorative stepped smooth stucco structural pier in Acadia white, lap siding Berkshire Beige, Bronze aluminum railings and Brilliant White wood tri, columns, and banding; modify existing road from the north parking lot to the main entrance by excavating it to slope down below a new raised pool deck expansion; relocate the pool equipment enclosure and pool shower; Install new planter boxes at the stairs and ramp of the pool deck and at the ends of the deck; install fire pit on the deck; install additional landscaping and lighting associated with the areas being improved.

Board Comments:

N/A

Public Comments:

Associated Actions:

N/A

Next Action: The SPRAB action is final unless appealed by the City Commission.

SITE PLAN REVIEW AND APPEARANCE BOARD STAFF REPORT

Opal Grand Hotel

Meeting	File No.	File No. Application Type		
July 27, 2022	2020-106-SPF-SPR-CL2	Class II Site Plan Modification		
Property Owner	Applicant	Agent		
Ocean Properties LTD	Ocean Properties LTD	GE Architecture Inc./Gary P. Eliopoulos		

Request

Consideration of a Class II Site Plan Modification, Landscape Plan, and Architectural Elevations for the Opal Grand (fka Marriott) associated with the construction of a raised pool deck above an enclosed vehicular accessway from the north parking lot to the main entrance.

General Data

Location: 10 North Ocean Boulevard, northwest corner of

East Atlantic Avenue and North Ocean Boulevard

PCN: 12-43-46-16-E3-003-0010

Property Size: 4.6 acres

LUM: CC (Commercial Core)

Zoning: Central Business District (CBD), Beach Sub-district

Adjacent Zoning:

North: Open Space (OS) & Community Facilities

o South: CBD, Beach Sub-district

o East: Atlantic Ocean

 West: Multiple Family Residential – Medium Density (RM) & CBD, Beach Sub-district

Existing Land Use: Hotel


CBD Beach Sub-district:

o East Atlantic Avenue: Primary Street, Required

Retail Frontage

o North Ocean Boulevard: Primary Street, Required

Retail Frontage

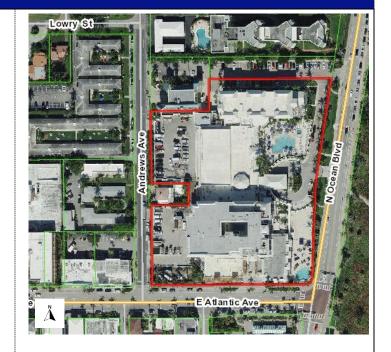

Background

The Opal Grand Hotel, formerly known as the Marriott Hotel, is located on the northwest corner of East Atlantic Avenue and North Ocean Boulevard. The existing 328,486 square foot development includes a 277-room hotel, associated indoor and outdoor hotel amenities, a valet parking queue, and structured parking garage. The hotel was first constructed in 1983 and has gone through several

Project Planner:

Attachments:

- Application Justification Statement
- Site Plan
- Landscape Plan
- Architectural Elevations

modifications and expansions. The most recent approvals and modifications relative to the current hotel and the anticipated improvements are highlighted below:

October 14, 2008: SPRAB approved a Class IV Site Plan Modification for the construction of a two-story hotel addition containing nine cabana suites, expanding the existing restaurant, adding a retail and commercial component, constructing a four-story hotel addition with 27 suites along the entire south property line fronting on East Atlantic Avenue, adding a kitchen to better accommodate existing banquet rooms, and expansion of the existing pool deck.

September 22, 2010: SPRAB approved a two-year extension request for the Class IV Modification, which established a new expiration date of October 14, 2012.

August 8, 2012: SPRAB approved an additional extension request and a Class I Site Plan Modification, allowing the Class IV Site Plan Modification to be completed in three phases.

June 12, 2019: SPRAB approved a Class II Site Plan Modification primarily related to architectural modifications associated with the rebranding of the hotel from the Marriott to the Opal Grand.

October 28, 2020: SPRAB approved a Class II Site Plan Modification associated with the addition of a new event deck, additional parking, and architectural modifications.

May 25, 2022: SPRAB approved a Class I Site Plan Modification to create a loading space for laundry drop off

and a trash compactor and install roll up doors and windows on the west elevation.



Description of Proposal

The Class II Site Plan Modification includes the following improvements (located within area circled in red):

- Demolish existing pool deck fence (low wall and four piers) and replace with a raised deck, with 42-inch decorative aluminum guardrails and decorative stepped smooth stucco structural pier in Acadia white, lap siding Berkshire Beige, Bronze aluminum railings and Brilliant White wood tri, columns, and banding;
- Modify existing road from the north parking lot to the main entrance by excavating it to slope down below a new raised pool deck expansion;
- Relocate the pool equipment enclosure and pool shower;
- VB US Circusta Hilbert
- Install new planter boxes at the stairs and ramp of the pool deck and at the ends of the deck;
- Install fire pit on the deck;
- Install additional landscaping and lighting associated with the areas being improved.

The elevation below illustrates the street view of the raised deck area from North Ocean Boulevard.



Review and Analysis: Site Plan and Zoning

LDR Section 2.4.5(G)(1)(c), Modifications to site plans and Master Development Plans: Class II

The approval of items (other than Class I applications) which requires no review of Performance Standards found in Section 3.1.1, but which requires action by a Board.

The proposed modifications to the landscaping and the construction of the pool deck area and covered vehicular access way prompts the review of a Class II Site Plan Modification, which requires Board Action.

Section 4.4.13, Central Business District

Standard/Regulation	Review
Primary and Secondary Streets and Alleys 4.4.13(B)(1)	Primary Streets are intended to develop over time as superior pedestrian environments and, as such, are held to higher standards in the regulations regarding building placement, building frontage, and the location of parking and service uses. While the improvements do not include the streetscape area, as is required found on new construction projects, the addition of the deck over the roadway improves the pedestrian environment by bringing more activity closer to the street.
Required Retail Frontage 4.4.13(B)(2)	Certain Primary Streets within the CBD are intended to be lively, highly active pedestrian environments that support businesses and reinforce local character. Hotels are allowed on streets designated with required retail frontage. The addition of the raised deck brings the active outdoor spaces closer to the street, where a roadway currently exists that separates the outdoor hotel areas from the public realm.
Architectural Elevations 4.4.13(F)	A review of the CBD architectural requirements is provided under the Architectural Elevations section of the report, as applicable to the improvements.

Other Requirements

Standard/Regulation	Review
Lighting LDR Section 4.6.8	Requirement(s): all developments/redevelopments are encouraged to utilize energy efficiency lighting; Artificial lighting used to illuminate premises shall be directed in such a way to minimize light spillover on adjacent properties and reduce urban glowWhen lighting is proposed within the vicinity of the beach it shall comply with all other City of Delray Beach Code Sections, including, but not limited to, Section 91.51 (Sea Turtles) which requires that all lighting shall be screened or shielded so that the light is not visible from the beach.

Lighting, Cutoff luminaire required LDR Section 4.6.8(2)	Provided: The LED Amber Lighting proposed around the pool deck meets the standards and complies with the requirements of the "Sea Turtle Protection and Sand Preservation" of the Palm Beach County Code of Ordinances. Requirement: all perimeter exterior lighting shall be full cutoff luminaries to minimize spillover on adjacent propertiesto decrease urban glow, no luminaries shall be directed upwards. Provided: The lighting proposed in the access driveway tunnel is full cut off luminaries and meets the illumination standard for a tunnel which is 1.0-to-10-foot candles. Therefore, the tunnel lighting is not anticipated to negatively affect sea life.
Off Street Parking, Hotels and motels LDR Section 4.6.9(C)(7)(e)	As the changes to the pool deck and addition of the tunnel do not increase the number of guest rooms or interior floor area, parking is not being modified as part of this application.

Review & Analysis: Landscape Plan

LDR Section 2.4.5(H)(5), Findings

At the time of action on a landscape plan, the approving body shall make finding with respect to the proposed plan's relationship to the following:

- (a) Objectives of landscaping regulations Section 4.6.16;
- (b) Site and landscape design standards pursuant to Section 4.6.16.

An overall determination of consistency with respect to the above items is required in order for a landscaping plan to be approved.

Pursuant to LDR Section 4.6.16(C)(1)(a), prior to the issuance of a building permit for a structure or a paving permit, compliance with the requirements of LDR Section 4.6.16 shall be assured through the review and approval of a landscape plan pursuant to Section 2.4.3(C).

The proposed landscape improvements primarily consist of tree relocation and preservation, as well as additional installation of shrubs to ground covers to enhance the frontage along North Ocean Boulevard. The landscape plans were reviewed and found to comply with landscape requirements pursuant to LDR Section 4.6.16. An arborist report and tree disposition plan are submitted with the landscape plan; no mitigation for replacement or in-lieu fees are required by the modifications.

Review & Analysis: Architectural Elevations

LDR Section 2.4.5(I)(5), Findings

At the time of action on architectural elevations the approving Board shall make findings with respect to the objectives and standards as contained in the architectural regulations, Section 4.6.18. An overall determination of consistency with respect to the above is required in order for an architectural plan to be approved.

LDR Section 4.6.18(A)(2)

It is required that all site development, structures, buildings, or alterations to same, show proper design concepts, express honest design construction, and be appropriate to surroundings.

LDR Section 4.6.18(E), Criteria for board action, the following criteria shall be considered, by the Site Plan Review and Appearance Board or Historic Preservation Board, in the review of plans for building permits. If the following criteria are not met, the application shall be disapproved.

- 1. The plan or the proposed structure, is in conformity with good taste, good design, and in general contributes to the image of the City as a place of beauty, spaciousness, harmony, taste, fitness, broad vistas, and high quality.
- 2. The proposed structure, or project, is in its exterior design and appearance of quality such as not to cause the nature of the local environment or evolving environment to materially depreciate in appearance and value.
- 3. The proposed structure, or project, is in harmony with the proposed developments in the general area, with the Comprehensive Plan, and with the supplemental criteria which may be set forth for the Board from time to time.

The following Objective and Policy from the Neighborhood, Districts, & Corridors Element of the Always Delray Comprehensive Plan are applicable to the subject request.

<u>Policy NDC 1.3.5</u> Use the Commercial Core land use designation to stimulate the vitality and economic growth of the city while simultaneously enhancing and preserving the cultural and historic downtown area.

Objective NDC 2.2 Downtown and Surrounding Neighborhoods Protect and enhance the "Village by the Sea" character of the downtown and neighborhoods located east of I-95.

The proposed modifications are consistent with the surrounding area and the overall appearance of the building's Florida Vernacular architectural style. The access driveway, which acts as a tunnel with the decorative aluminum louvered vents, has a clearance of 8 feet and 4 inches and will primarily be used for valet parking operations, transporting vehicles from the main entrance of the hotel to the north parking lot. The raised pool deck is four feet from the top of the ground floor to the top of the deck. The deck, which measures 111 feet, 10 inches by 23 feet, 1 inch, will provide additional space for guests utilizing the hotel pool and outdoor areas. The deck includes steps, a handicap ramp, decorative planters, and a firepit. The pool equipment is being relocated to the north of the raised deck, which will be enclosed and will not be visible to guests. Below are renderings of the proposed access driveway tunnel and the pool deck expansion. The proposed modifications, which contribute to the image of the hotel and the overall image of the City, are in good taste and illustrate good design.





Reviewed by Others

The proposal was reviewed by the **Downtown Development Authority (DDA)** on March 9, 2020. The DDA Board recommended approval of the proposal.

Board Action Options

- A. Move **approval** of the Class II Site Plan Modification (2020-106) associated with the construction of a raised pool deck above an enclosed vehicular accessway from the north parking lot to the main entrance for the **Opal Grand Hotel** located at 10 North Ocean Boulevard, finding that the request is consistent with the Comprehensive Plan and meets the criteria set forth in the Land Development Regulations.
- B. Move to **deny** the Class II Site Plan Modification (2020-106) associated with construction of a raised pool deck above an enclosed vehicular accessway from the north parking lot to the main entrance for the **Opal Grand Hotel** located at 10 North Ocean Boulevard, finding that the request is not consistent with the Comprehensive Plan and does not meet the criteria set forth in the Land Development Regulations.
- C. Move to continue with direction.


		BUILDING FRO (AS PER T	NTAGE HEIGH ABLE 4.3.4(K)	. 02.2/.0.1		
		(/101 E111	71DLL 1.0.1(11)	L.D.I (.)		
ROAD/ BUILDING SIDE	BUILDING HEIGHT (FEET)	% BUILDING FRONTAGE (MIN. / MAX.)	REQUIRED SETBACK (FEET)	REQUIRED BUILDING FRONTAGE AT SETBACK (FEET)	PROPOSED BUILDING FRONTAGE	
NORTH OCEAN BLVD.	FINISHED GRADE TO 37'-0"	TØ% / 9Ø%	10'-0" MAX.	353' / 454'	ø '	
	397' LOT FRONTAGE	REMAINING LENGTH	15'-Ø" MIN.	151' / 50'	478'-@"	
	ALLOWABLE MIN. BUILDING LENGTH ALLOWABLE MAX. BUILDING LENGTH PROPOSED BUILDING LENGTH WITHIN THE ALLOWABLE 5'-0' & 10'-0' FRONT SETBACK PROPOSED BUILDING LENGTH A MIN. OF 15'-0' FRONT SETBACK BUILDING HEIGHT OPEN SPACE			I. BUILDING FRONTAGE SHAL ABLE 5'-0" & 10'-0" SETBACI		
			454'-0" = 90% MAX. BUILDING FRONTAGE SHALL BE CONSTRUCTED WITHIN THE ALLOWABLE 5'-0" & 10'-0" SETBACKS.			
			Ø'-Ø ' = Ø%			
			478'-0" = 100 %			
			REQUIRED: MIN. 25'-0"/48'-0"	PROVID 18'-6' (1	DED: TOP OF CABANA SUITES)	
			REQUIRED:	PROVID	ED	

PROPOSED SITE PLAN

SCALE: 1"= 30'

			NTAGE HEIGH ΓABLE 4.3.4(K)			
ROAD/ BUILDING SIDE	BUILDING HEIGHT (FEET)	% BUILDING FRONTAGE (MIN. / MAX.)	REQUIRED SETBACK (FEET)	REQUIRED BUILDING FRONTAGE AT SETBACK (FEET)	PROPOSED BUILDING FRONTAGE	
ATLANTIC AVENUE (LOWER LEVEL)	FINISHED GRADE TO 37'-0"	TØ% / 9Ø%	10'-0" MAX.	278' / 357'	283'-6'	
	391' LOT FRONTAGE	10% / 30% REMAINING LENGTH	15'-0' MIN.	40' / 119'	49'-0"	
ATLANTIC AVENUE (UPPER LEVEL)	31'-@" TO 48'-@" 391' LOT FRONTAGE	70% / 90%	15'-0" MIN.	278' / 357'	357'-@"	
		10% / 30% REMAINING LENGTH	5'-0" MIN.	40' / 119'	40'-0" (10%)	
	ALLOWABLE MIN. BUILDING LENGTH		278'-0" = 70% MIN. BUILDING FRONTAGE SHALL BE CONSTRUCTED WITHIN THE ALLOWABLE 5'-0" & 10 '-0" SETBACKS.			
	ALLOWABLE MAX. BUILDING LENGTH		357'-0" = 90% MAX. BUILDING FRONTAGE SHALL BE CONSTRUCTED WITHIN THE ALLOWABLE 5'-0" & $ 0\rangle$ ' SETBACKS.			
	PROPOSED BUILDING LENGTH WITHIN THE ALLOWABLE 5'-0" & 10'-0" FRONT SETBACK		283'-6" = 71.4%			
	PROPOSED BUILDING LENGTH A MIN. OF 15'-0' FRONT SETBACK		49'-0" = 12.3 %			
	BUILDING HEIGHT		REQUIRED: MIN. 25'-0"/48'-0"	PROVIDED: 42'-II" (ROOF DECK AI	BOVE AVG. CROWN OF RD.	
	OPEN SPACE		REQUIRED:	PROVIDED:		

		BUILDING FRO	NTAGE HEIGH	T SETBACK	
		(AS PER T	ABLE 4.3.4(K)	L.D.R.)	
ROAD/ BUILDING SIDE	BUILDING HEIGHT (FEET)	% BUILDING FRONTAGE (MIN. / MAX.)	REQUIRED SETBACK (FEET)	REQUIRED BUILDING FRONTAGE AT SETBACK (FEET)	PROPOSED BUILDING FRONTAGE
ANDREWS Avenue	FINISHED GRADE TO 42'-11"	7 <i>0% / 90%</i>	10'-0" MAX.	54' / TØ'	12'-@"
	77'-4 7/8" LOT FRONTAGE	REMAINING LENGTH	15'-0" MIN.	23' / ד'	26'-6"
	ALLOWABLE MIN. BU			BUILDING FRONTAGE SHALL BLE 5'-0" & 10'-0" SETBACK	
	ALLOWABLE MAX. BUILDING LENGTH PROPOSED BUILDING LENGTH WITHIN THE ALLOWABLE 5'-0' & 10'-0' FRONT SETBACK		10'-0'=90% Max. Building frontage shall be constructed within the allowable 5'-0" & $10'-0'$ setbacks.		
			12'- 0" = 15.6%		
PROPOSED BUILDING LI OF 15'-0' FRONT SETBAC		26'-6" = 34.4 %			
	0 2	BUILDING HEIGHT		DDO (IDED	
			REQUIRED: MIN. 25'-0"/48'-0"	PROVIDED: 42'-11 ' (ROO F DECK ABC	OVE AVG. CROWN OF RD.)

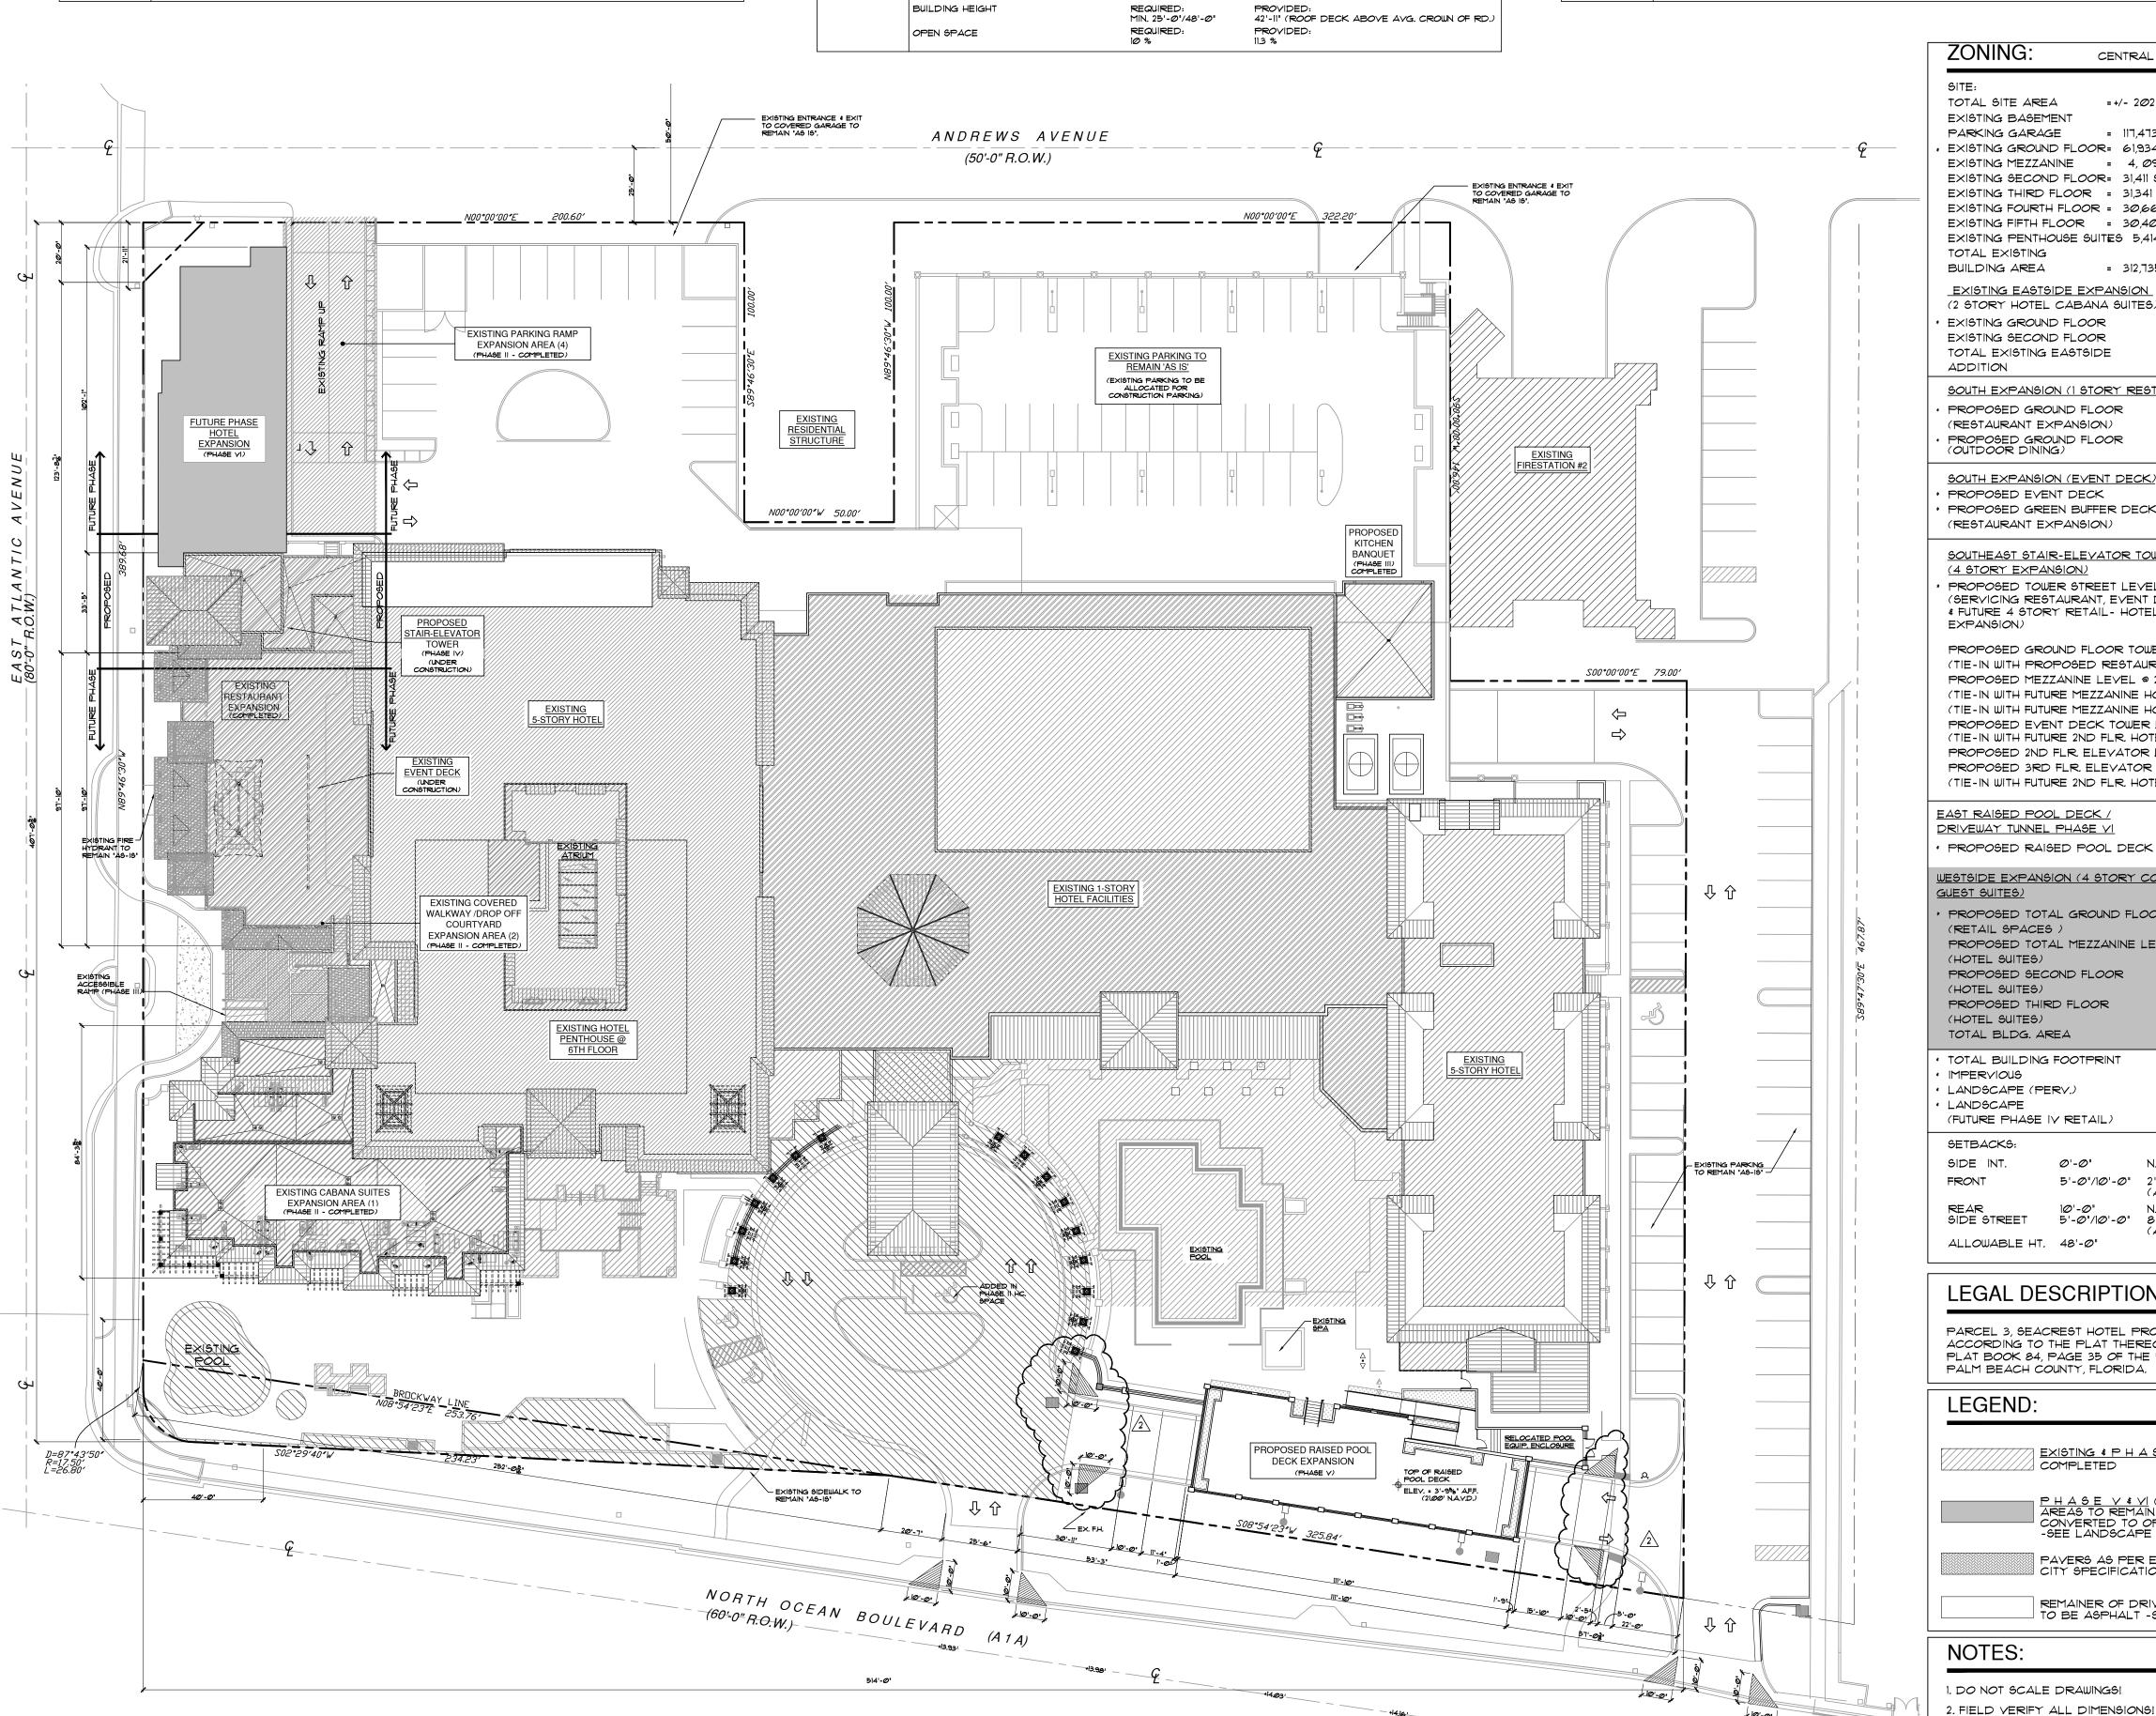

ZONING: CENTRAL BUSINESS DISTRICT TOTAL SITE AREA =+/- 202,180 S.F. 100% EXISTING BASEMENT PARKING GARAGE = 117,473 S.F. EXISTING GROUND FLOOR = 61,934 S.F. 3*0.*7 % EXISTING MEZZANINE = 4, 098 S.F. EXISTING SECOND FLOOR= 31,411 S.F. EXISTING THIRD FLOOR = 31,341 S.F. EXISTING FOURTH FLOOR = 30,662 S.F. PHASE III EXISTING FIFTH FLOOR = 30,402 S.F. EXISTING PENTHOUSE SUITES 5,414 S.F. TOTAL EXISTING BUILDING AREA = 312,735 S.F. EXISTING EASTSIDE EXPANSION (2 STORY HOTEL CABANA SUITES) ADDITIONAL 1,152 SQ.FT. @ 6 SPACES/1000 SQ.FT. EXISTING GROUND FLOOR = 5,760 S.F. 2.8 % EXISTING SECOND FLOOR = 5,417 S.F. TOTAL EXISTING EASTSIDE = 11,177 S.F. ADDITION SOUTH EXPANSION (I STORY RESTAURAUNT EXPANSION) PROPOSED GROUND FLOOR = 4,253 S.F. 2.1 % (RESTAURANT EXPANSION) PROPOSED GROUND FLOOR (OUTDOOR DINING) = 2,152 S.F. 1 % PHASE III SOUTH EXPANSION (EVENT DECK) = 3,943 S.F. PROPOSED EVENT DECK PROPOSED GREEN BUFFER DECK = 1,132 S.F. (RESTAURANT EXPANSION) TOTAL DECK AREA: 5,075 SQ. FT. SOUTHEAST STAIR-ELEVATOR TOWER (4 STORY EXPANSION) PHASE IV PROPOSED TOWER STREET LEVEL = 910 S.F. 0.4 % (SERVICING RESTAURANT, EVENT DECK # FUTURE 4 STORY RETAIL - HOTEL EXPANSION) PROPOSED GROUND FLOOR TOWER @ 1,747 SQ. FT. (TIE-IN WITH PROPOSED RESTAURANT EXPANSION) PHASE III) PROPOSED MEZZANINE LEVEL @ 221 SQ. FT. (TIE-IN WITH FUTURE MEZZANINE HOTEL EXPANSION) (TIE-IN WITH FUTURE MEZZANINE HOTEL EXPANSION) PROPOSED EVENT DECK TOWER LOBBY @ 816 SQ. FT. (TIE-IN WITH FUTURE 2ND FLR. HOTEL EXPANSION) PROPOSED 2ND FLR. ELEVATOR LOBBY @ 227 SQ. FT. PROPOSED 3RD FLR. ELEVATOR LOBBY @ 672 SQ. FT (TIE-IN WITH FUTURE 2ND FLR. HOTEL EXPANSION) EAST RAISED POOL DECK PHASE V DRIVEWAY TUNNEL PHASE VI PROPOSED RAISED POOL DECK = 3,993 S.F. 1.9 % WESTSIDE EXPANSION (4 STORY COMMERCIAL/HOTEL GUEST SUITES) PROPOSED TOTAL GROUND FLOOR = 4,116 S.F. 2.0 % (RETAIL SPACES) PROPOSED TOTAL MEZZANINE LEVEL = 3,851 S.F. (HOTEL SUITES) PROPOSED SECOND FLOOR = 3,690 S.F. (HOTEL SUITES) PROPOSED THIRD FLOOR = 3,7Ø3 S.F. (HOTEL SUITES) TOTAL BLDG. AREA = 15,360 S.F. TOTAL BUILDING FOOTPRINT = 73,561 S.F. 36.3 % IMPERVIOUS = 100,967 S.F. 50.0 % 1 SPACES/ROOM (REQUIRED) LANDSCAPE (PERV.) = 22,806 S.F. 11 % LANDSCAPE (FUTURE PHASE IV RETAIL) = 5,339 S.F. 2.7 % SETBACKS: SIDE INT. Ø'-Ø" N.A. EXISTING 5'-0"/10'-0" 2'-5"/5'-0"/10'-0" (ALONG ATLANTIC AVE.) FRONT N.A. EXISTING 5'-0"/10'-0" 8'-2" SIDE STREET (ALONG ANDREWS AVE.) ALLOWABLE HT. 48'-0" LEGAL DESCRIPTION EXISTING PARALLEL PARKING PARCEL 3, SEACREST HOTEL PROPERTY -PLAT NO. 2, ACCORDING TO THE PLAT THEREOF AS RECORDED IN PLAT BOOK 84, PAGE 35 OF THE PUBLIC RECORDS OF PALM BEACH COUNTY, FLORIDA. LEGEND: EXISTING & PHASE | & || AFTER CONVERTED TO COMPLETED ACCESSIBLE PARKING

PHASE V & VI (FUTURE PHASE) AREAS TO REMAIN "AS IS" OR

CONVERTED TO OPEN SPACE -SEE LANDSCAPE PLAN

PAYERS AS PER EXISTING

REMAINER OF DRIVEWAYS

TO BE ASPHALT -SEE CIVIL DWGS.

CITY SPECIFICATIONS.

3. CONTRACTOR TO VERIFY ALL EXISTING

CONDITIONS, AND NOTIFY ARCHITECT IF ANY

4. ALL AREA CALCULATIONS ARE APPROX.

5. VERIFY ALL SLOPES OF PROPOSED

SIDEWALKS W/ CIVIL DRAWINGS.

DESCRIPANCY W/ DRAWINGS. (SEE GENERAL NOTES)



ADDITION AND RENOVATION: PROPOSED PARKING:

I STORY RESTAURANT EXPANSION

PROPOSED RESTAURANT @ 4,253 SQ.FT. @ 6 SPACES/1000 SQ.FT. (REQUIRED) = 26 SPACES PROPOSED RELOCATED OUTDOOR SEATING @ 2,152 SQ.FT. (NOTED: EXISTING 1,000 SQ.FT.= 6 SPACES)

= <u>1 SPACES</u>

= <u>33 SPACES</u>

TOTAL PARKING REQUIRED

I STORY BANQUET/KITCHEN ADDITION PROPOSED KITCHEN ADDITION @ NW CORNER/ 1,282 SQ.FT. (NO ADDIT. PARKING REQUIRED).

EVENT DECK

PROPOSED EVENT DECK @ 3,943 SQ.FT. @ 6 SPACES/1000 SQ.FT. (REQUIRED) = <u>24 SPACES</u> PROPOSED GREEN BUFFER DECK @ 1,132 SQ.FT. (ASTRO TURF SURFACE NOT OCCUPIABLE SPACE)

ELEVATOR- STAIR TOWER

PROPOSED STREET-LEVEL ENTRY @ 635 SQ. FT. _(TIE-IN TO FUTURE RETAIL GROUND FLOOR PHASE V) PROPOSED GROUND FLOOR TOWER @ 1,747 SQ. FT. (TIE-IN WITH PROPOSED RESTAURANT EXPANSION

PROPOSED MEZZANINE LEVEL @ 229 SQ. FT. (TIE-IN WITH MEZZANINE HOTEL EXPANSION) PROPOSED EVENT DECK TOWER LOBBY @ 816 SQ. FT. (TIE-IN WITH MEZZANINE HOTEL EXPANSION) MPROPOSED 2ND FLR. ELEVATOR LOBBY @ 556 SQ. FT. (TIE-IN WITH 2ND FLR. HOTEL EXPANSION) PROPOSED 3RD FLR. ELEVATOR LOBBY @ 311 SQ. FT.

(TIE-IN WITH FUTURE 3RD FLR. HOTEL EXPANSION) THIS PERMIT RAISED POOL DECK W/ DRIVEWAY TUNNEL PROPOSED RAISED POOL DECK @ 3,780 SQ. FT.

(EXCAVATION AND RAMPING OF EXT'G. DRIVEWAY) PROPOSED RAISED POOL DECK @ 3,993 SQ. FT. (BUILD OVER PROPOSED DRIVEWAY TUNNEL) POOL EQUIPMENT ENCLOSURE @ 400 SQ. FT.

4 STORY COMMERCIAL/HOTEL GUEST SUITES ADDITION PROPOSED GROUND FLOOR RETAIL SPACE @ 2,663 SQ.FT. @ 4.5 SPACES/1000 SQ.FT. (REQUIRED) = (11.8 SPACES) 12 SPACES

PROPOSED (15) 4-STORY HOTEL GUESTROOM SUITES ≥ © SE CORNER (RANGING FROM 383 SQ.FT. TO 1,104 SQ.FT.. NOTE: (2) EXISTING HOTEL SUITES ELIMINATED IN EXISTING HOTEL FOR NEW HOTEL CONN. CORRIDOR @ EXISTING HOTEL FLOORS 2ND \$ 3RD.

= (10.5 - 1.4 = 9.1) 10 SPACES

= 506 SPACES

TOTAL PARKING REQUIRED FOR HOTEL RENOVATION/ADDITION = 19 SPACES TOTAL PARKING REQUIRED FOR EXISTING HOTEL 4 HOTEL RENOVATION/ADDITION =

EXISTING HOTEL (REQUIRED) = 383 SPACES EXTG. 2 STORY (8)CABANA SUITE (REQ.)= 6 SPACES PROPOSED HOTEL RENOV./ADDITION = 19 SPACES EXISTING PARKING = 489 SPACES 50 SPACE VARIANCE (JUNE 1990) = 50 SPACES TOTAL EXISTING PARKING = 539 SPACES PHASE II PARKING CONDITION EXISTING H.C. PARKING = 2 SPACES = 4 SPACES

EXISTING STANDARD PARKING = 26 SPACES TOTAL SPACE ELIMINATED = 32 SPACES TOTAL EXISTING PARKING = 507 SPACES ADDITIONAL HC SPACE (PHASE II) = 1 SPACE TOTAL EXISTING PARKING = 508 SPACES PHASE III ADDITIONAL HC PARKING = 4 SPACE = 2 SPACE PARKING SPACE ELIMINATED

TOTAL PARKING PARKING REQUIRED EXISTING HOTEL = +371 SPACES REQUIRED

INTERIOR RENOVATION (SPA & ADMIN.) =-6.22 CREDIT SPACES

PHASE II (CABANA SUITES, COURTYARD & RAMP) = +6 SPACES REQUIRED PHASE III (PROPOSED RESTAURANT EXPANSION) = +33 SPACES REQUIRED

PHASE III (PROPOSED EVENT DECK) = +24 SPACES REQUIRED PHASE III (PROPOSED STAIR-ELEVATOR TOWER)

= +Ø SPACES REQUIRED

= +10 SPACES REQUIRED

PHASE IV (GROUND FLOOR RETAIL) = +12 SPACES REQUIRED PHASE IV (SOUTH WEST HOTEL EXPANSION)

TOTAL OVERALL PARKING REQUIRED = 456 SPACES REQUIRED

architecture, planning and design AA-26002044

TEL: 561-276-6011 FAX: 561-276-6129

1045 East Atlantic Ave. Suite 303 Delray Beach, Florida 33483

ISSUED FOR PERMIT H BIDS

PERMIT 2.28.22

CONSTRUCTION

PROJECT TITLE **PROPOSED**

OPAL GRAND RAISED POOL DECK/ DRIVEWAY TUNNEL (PHASE V)

10 N. OCEAN BLVD. DELRAY BEACH, FL

CLIENT APPROVAL

REVISIONS REVISED 1.17.22 PER CITY COMMENTS: - PROVIDE OVERALL SITE PLAN (FOR REFERENCE ONLY). REVISED 6.03.22 PER CITY - COORDINATE W/ CIVIL DWGS, IN RESPONSE TO COMMENTS TO PROVIDE SIGHT TRIANGLE AT INTERSECTION OF DRIVEWAY

THIS DRAWING IS NOT FOR CONSTRUCTION, IT HAS BEEN ISSUED FOR GOVERNMENTAL

REVIEW AND/OR PRELIMINARY PRICING

FILE NUMBER


312A101

DRAWING TITLE **PROPOSED**

OVERALL SITE PLAN (FOR REF. ONLY)

11.012.21 GE/JC JOB NUMBER

20190312 DRAWING NUMBER

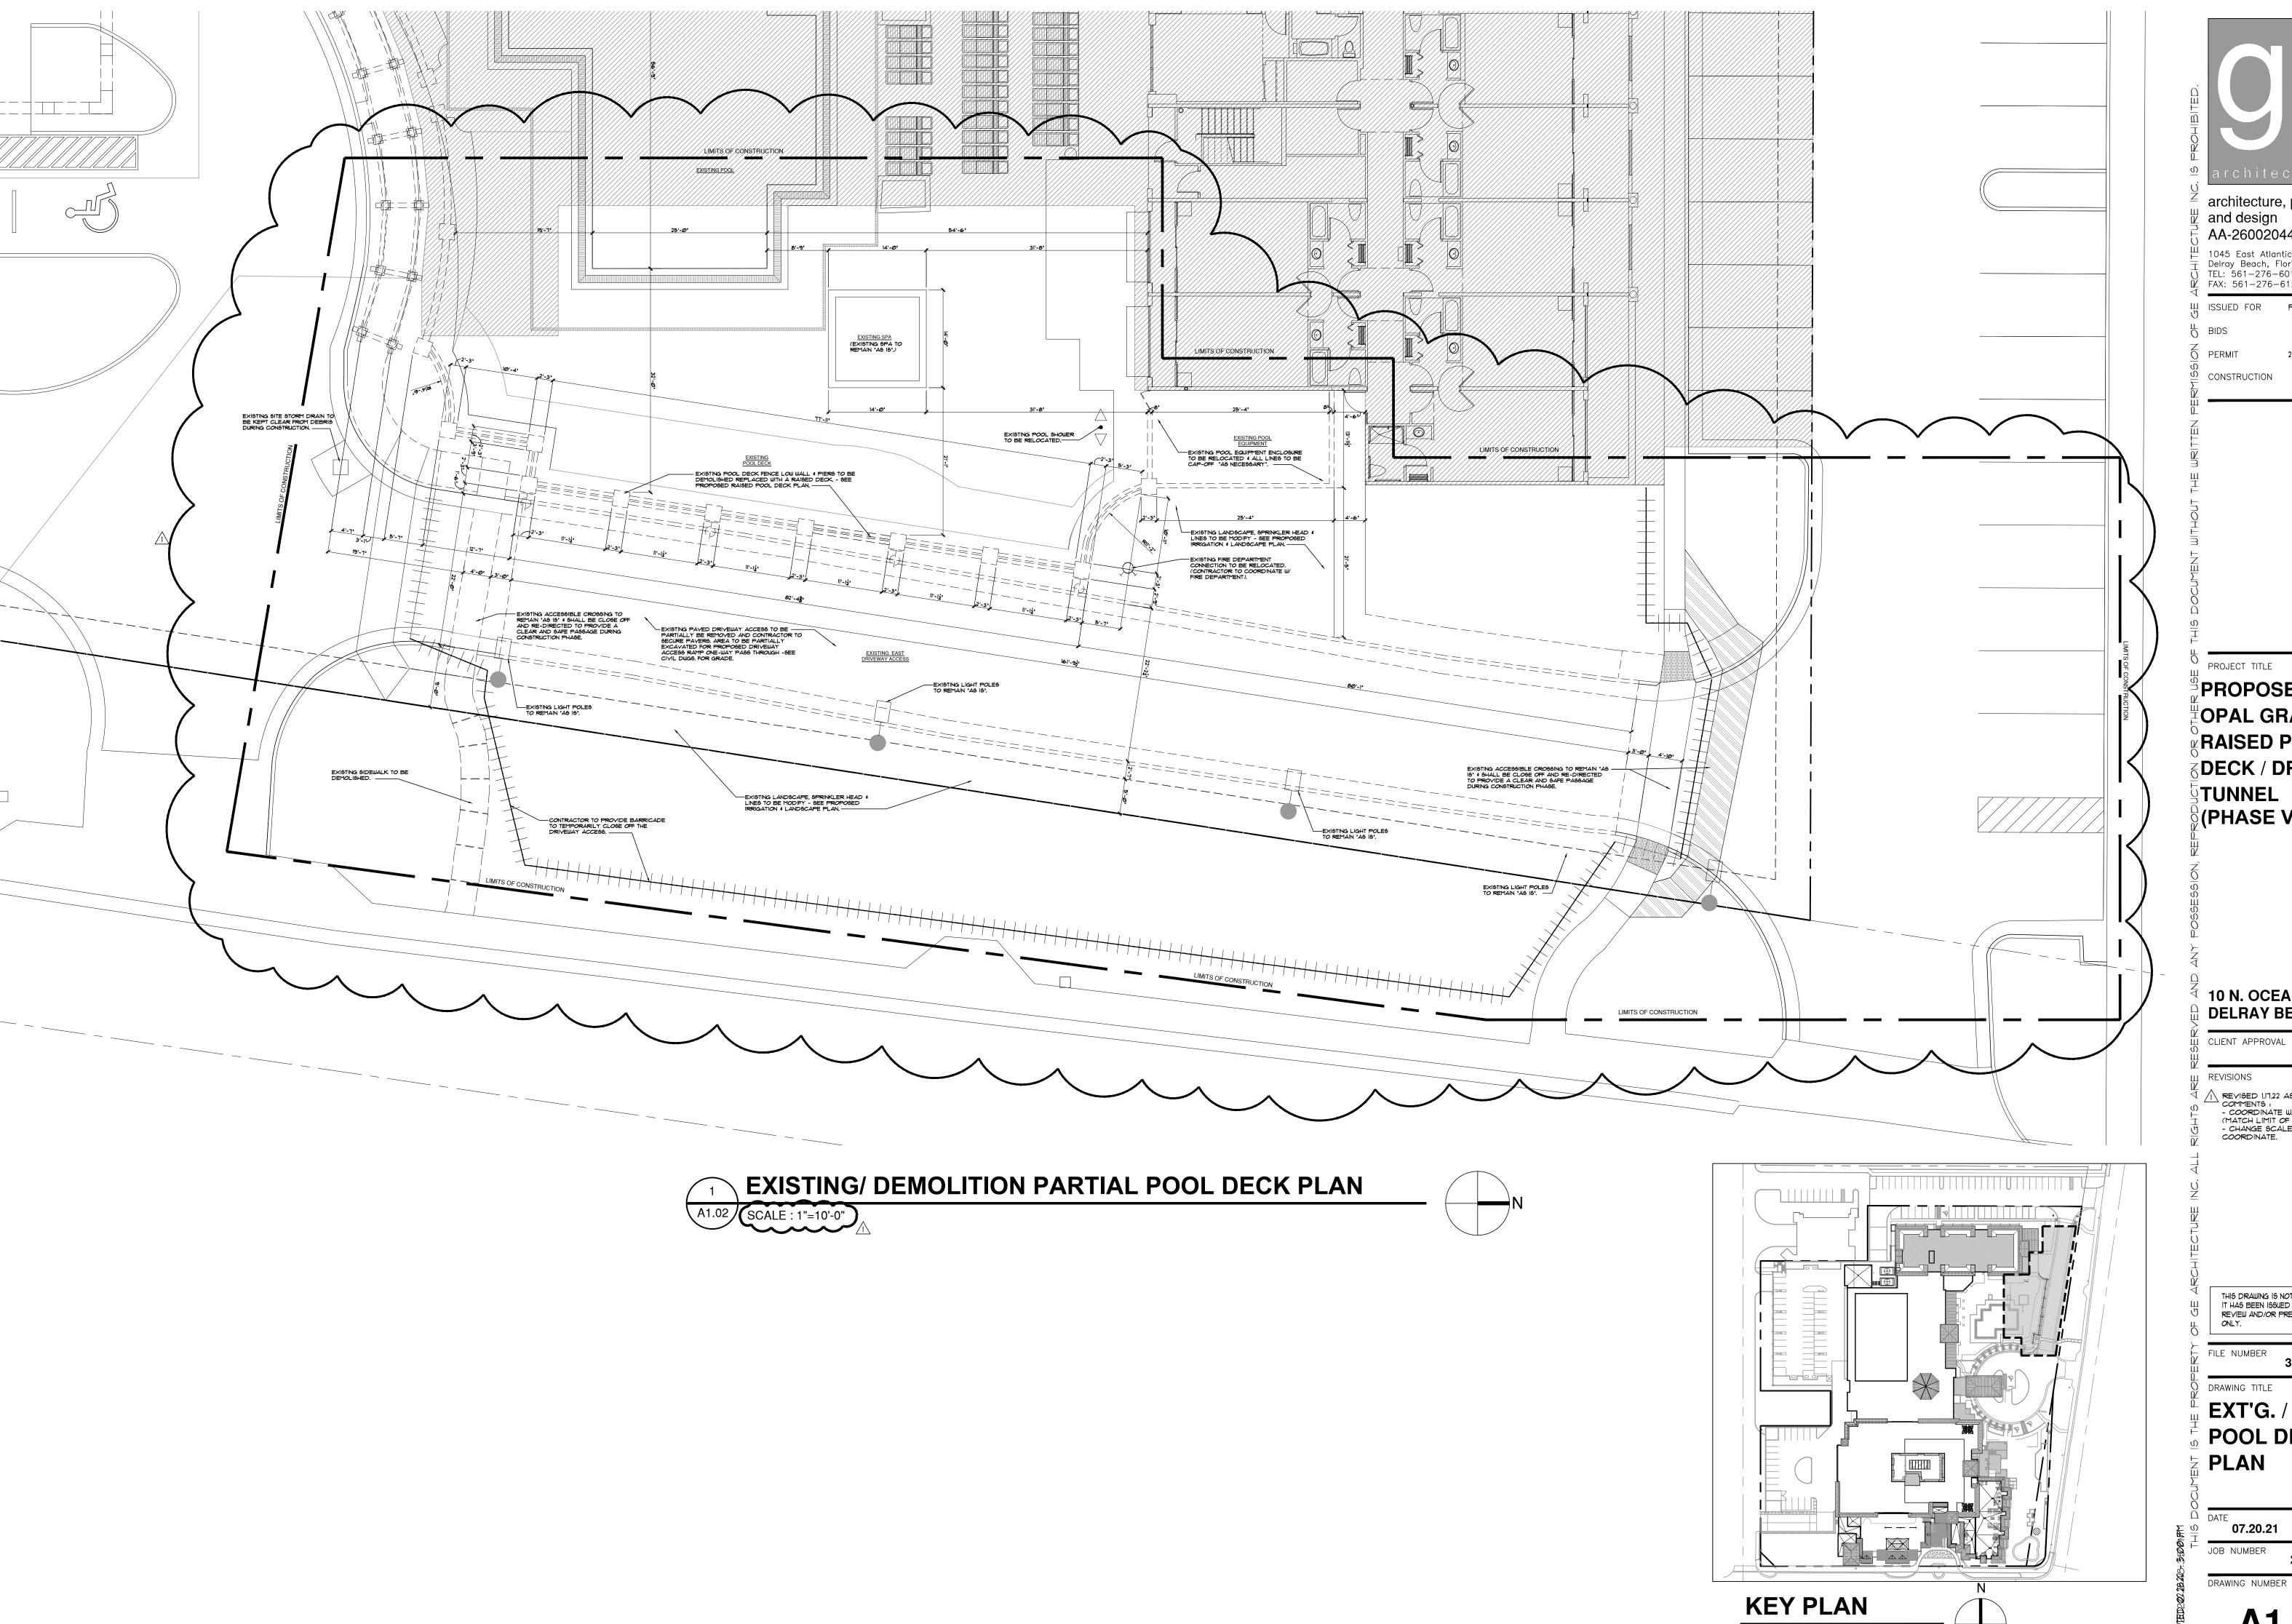

1 1045 East Atlantic Ave. Suite 303 E Delray Beach, Florida 33483 TEL: 561-276-6011 FAX: 561-276-6129

ISSUED FOR PERMIT

BIDS

CONSTRUCTION

PROJECT TITLE PROPOSED BOPAL GRAND KRAISED POOL

DECK / DRIVEWAY TUNNEL (PHASE V)

10 N. OCEAN BLVD. DELRAY BEACH, FL

CLIENT APPROVAL

REVISIONS


REVISED 1.17.22 AS PER CITY
COMMENTS:
- COORDINATE W/ CIVIL DWGS.
(MATCH LIMIT OF CONSTRUCTION)
- CHANGE SCALE TO 1'=10'-0' TO
COORDINATE.

THIS DRAWING IS NOT FOR CONSTRUCTION, IT HAS BEEN ISSUED FOR GOVERNMENTAL REVIEW AND/OR PRELIMINARY PRICING

FILE NUMBER 312A102

DRAWING TITLE EXT'G. / DEMO **POOL DECK** PLAN

GE/JC 07.20.21 JOB NUMBER 20190312

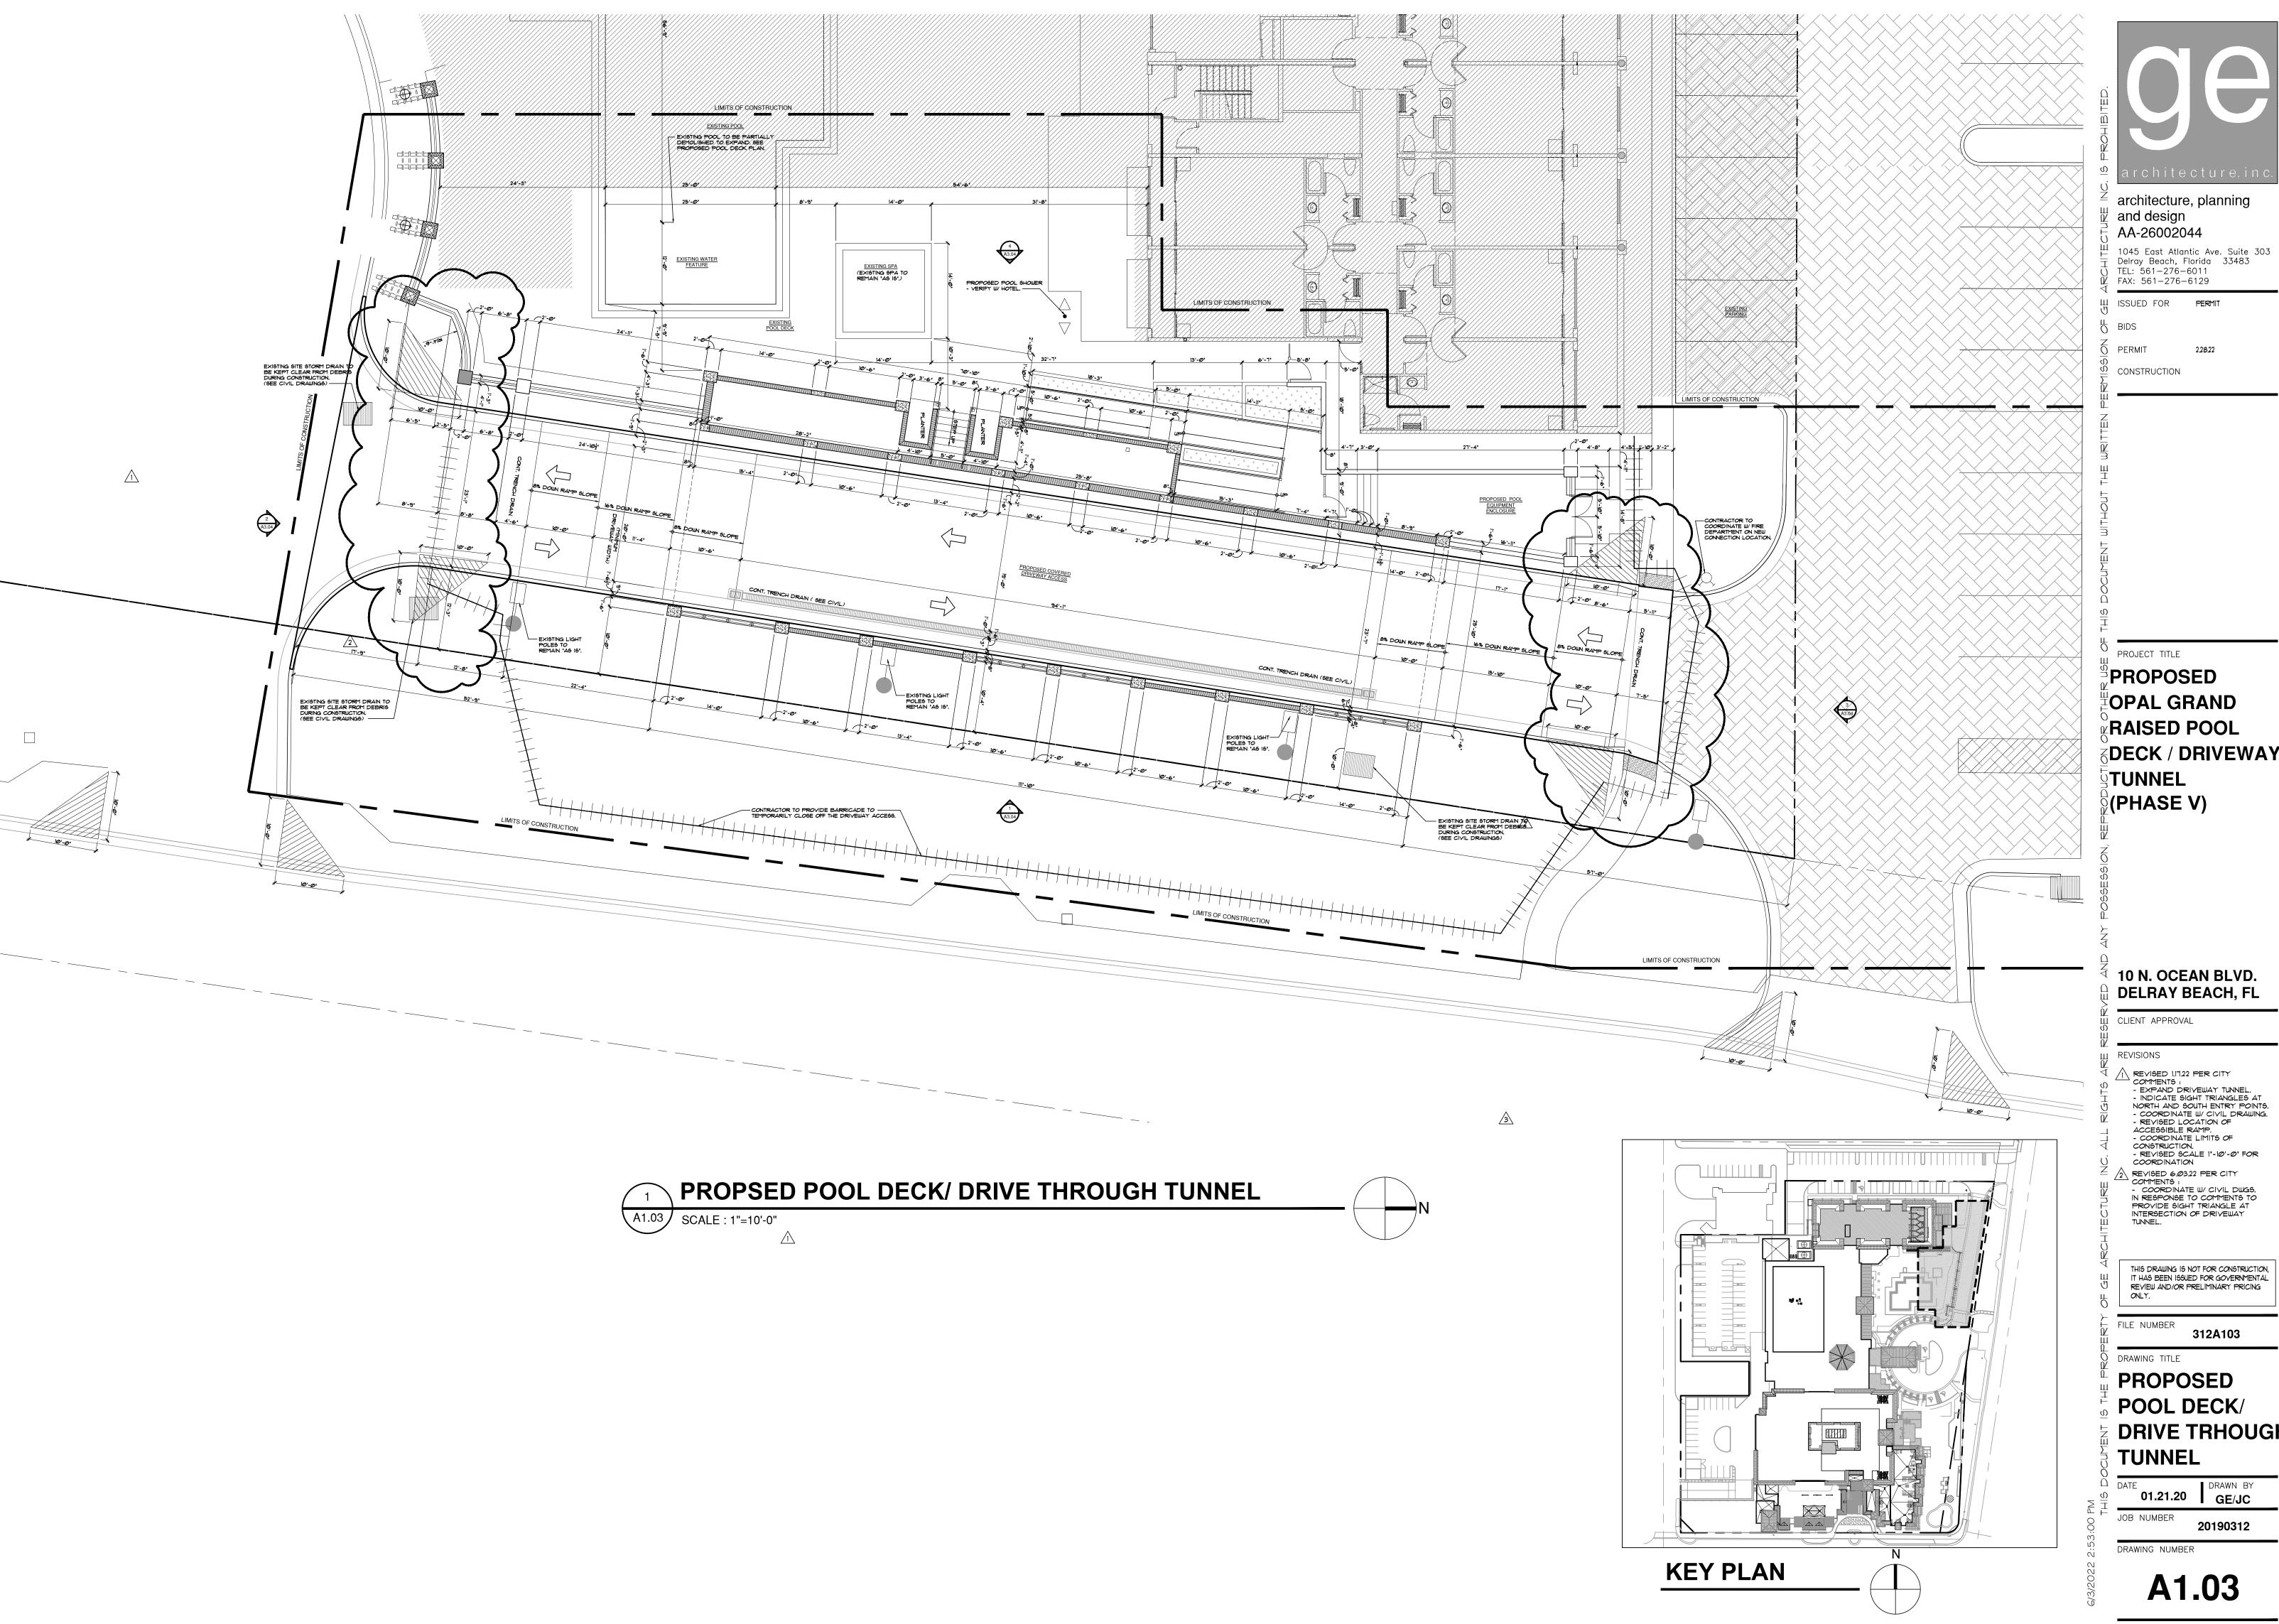

ISSUED FOR PERMIT

PROPOSED #OPAL GRAND RAISED POOL **DECK / DRIVEWAY**

5TUNNEL (PHASE V)

10 N. OCEAN BLVD.

REVISIONS

REVISED 1.17.22 PER CITY REVISED 1.17.22 PER CITY
COMMENTS:
- EXPAND DRIVEWAY TUNNEL.
- INDICATE SIGHT TRIANGLES AT
NORTH AND SOUTH ENTRY POINTS.
- COORDINATE W CIVIL DRAWING.
- REVISED LOCATION OF
ACCESSIBLE RAMP.
- COORDINATE LIMITS OF
CONSTRUCTION.
- REVISED SCALE I'-10'-0' FOR
COORDINATION

REVISED 6.03.22 PER CITY 2 REVISED 6.03.22 PER CITY
COMMENTS:
- COORDINATE W/ CIVIL DWGS.
IN RESPONSE TO COMMENTS TO
PROVIDE SIGHT TRIANGLE AT
INTERSECTION OF DRIVEWAY
TUNNEL.

THIS DRAWING IS NOT FOR CONSTRUCTION, IT HAS BEEN ISSUED FOR GOVERNMENTAL REVIEW AND/OR PRELIMINARY PRICING

FILE NUMBER


312A103

PROPOSED POOL DECK/ **DRIVE TRHOUGH**

01.21.20 | DRAWN BY GE/JC

20190312

A1.03

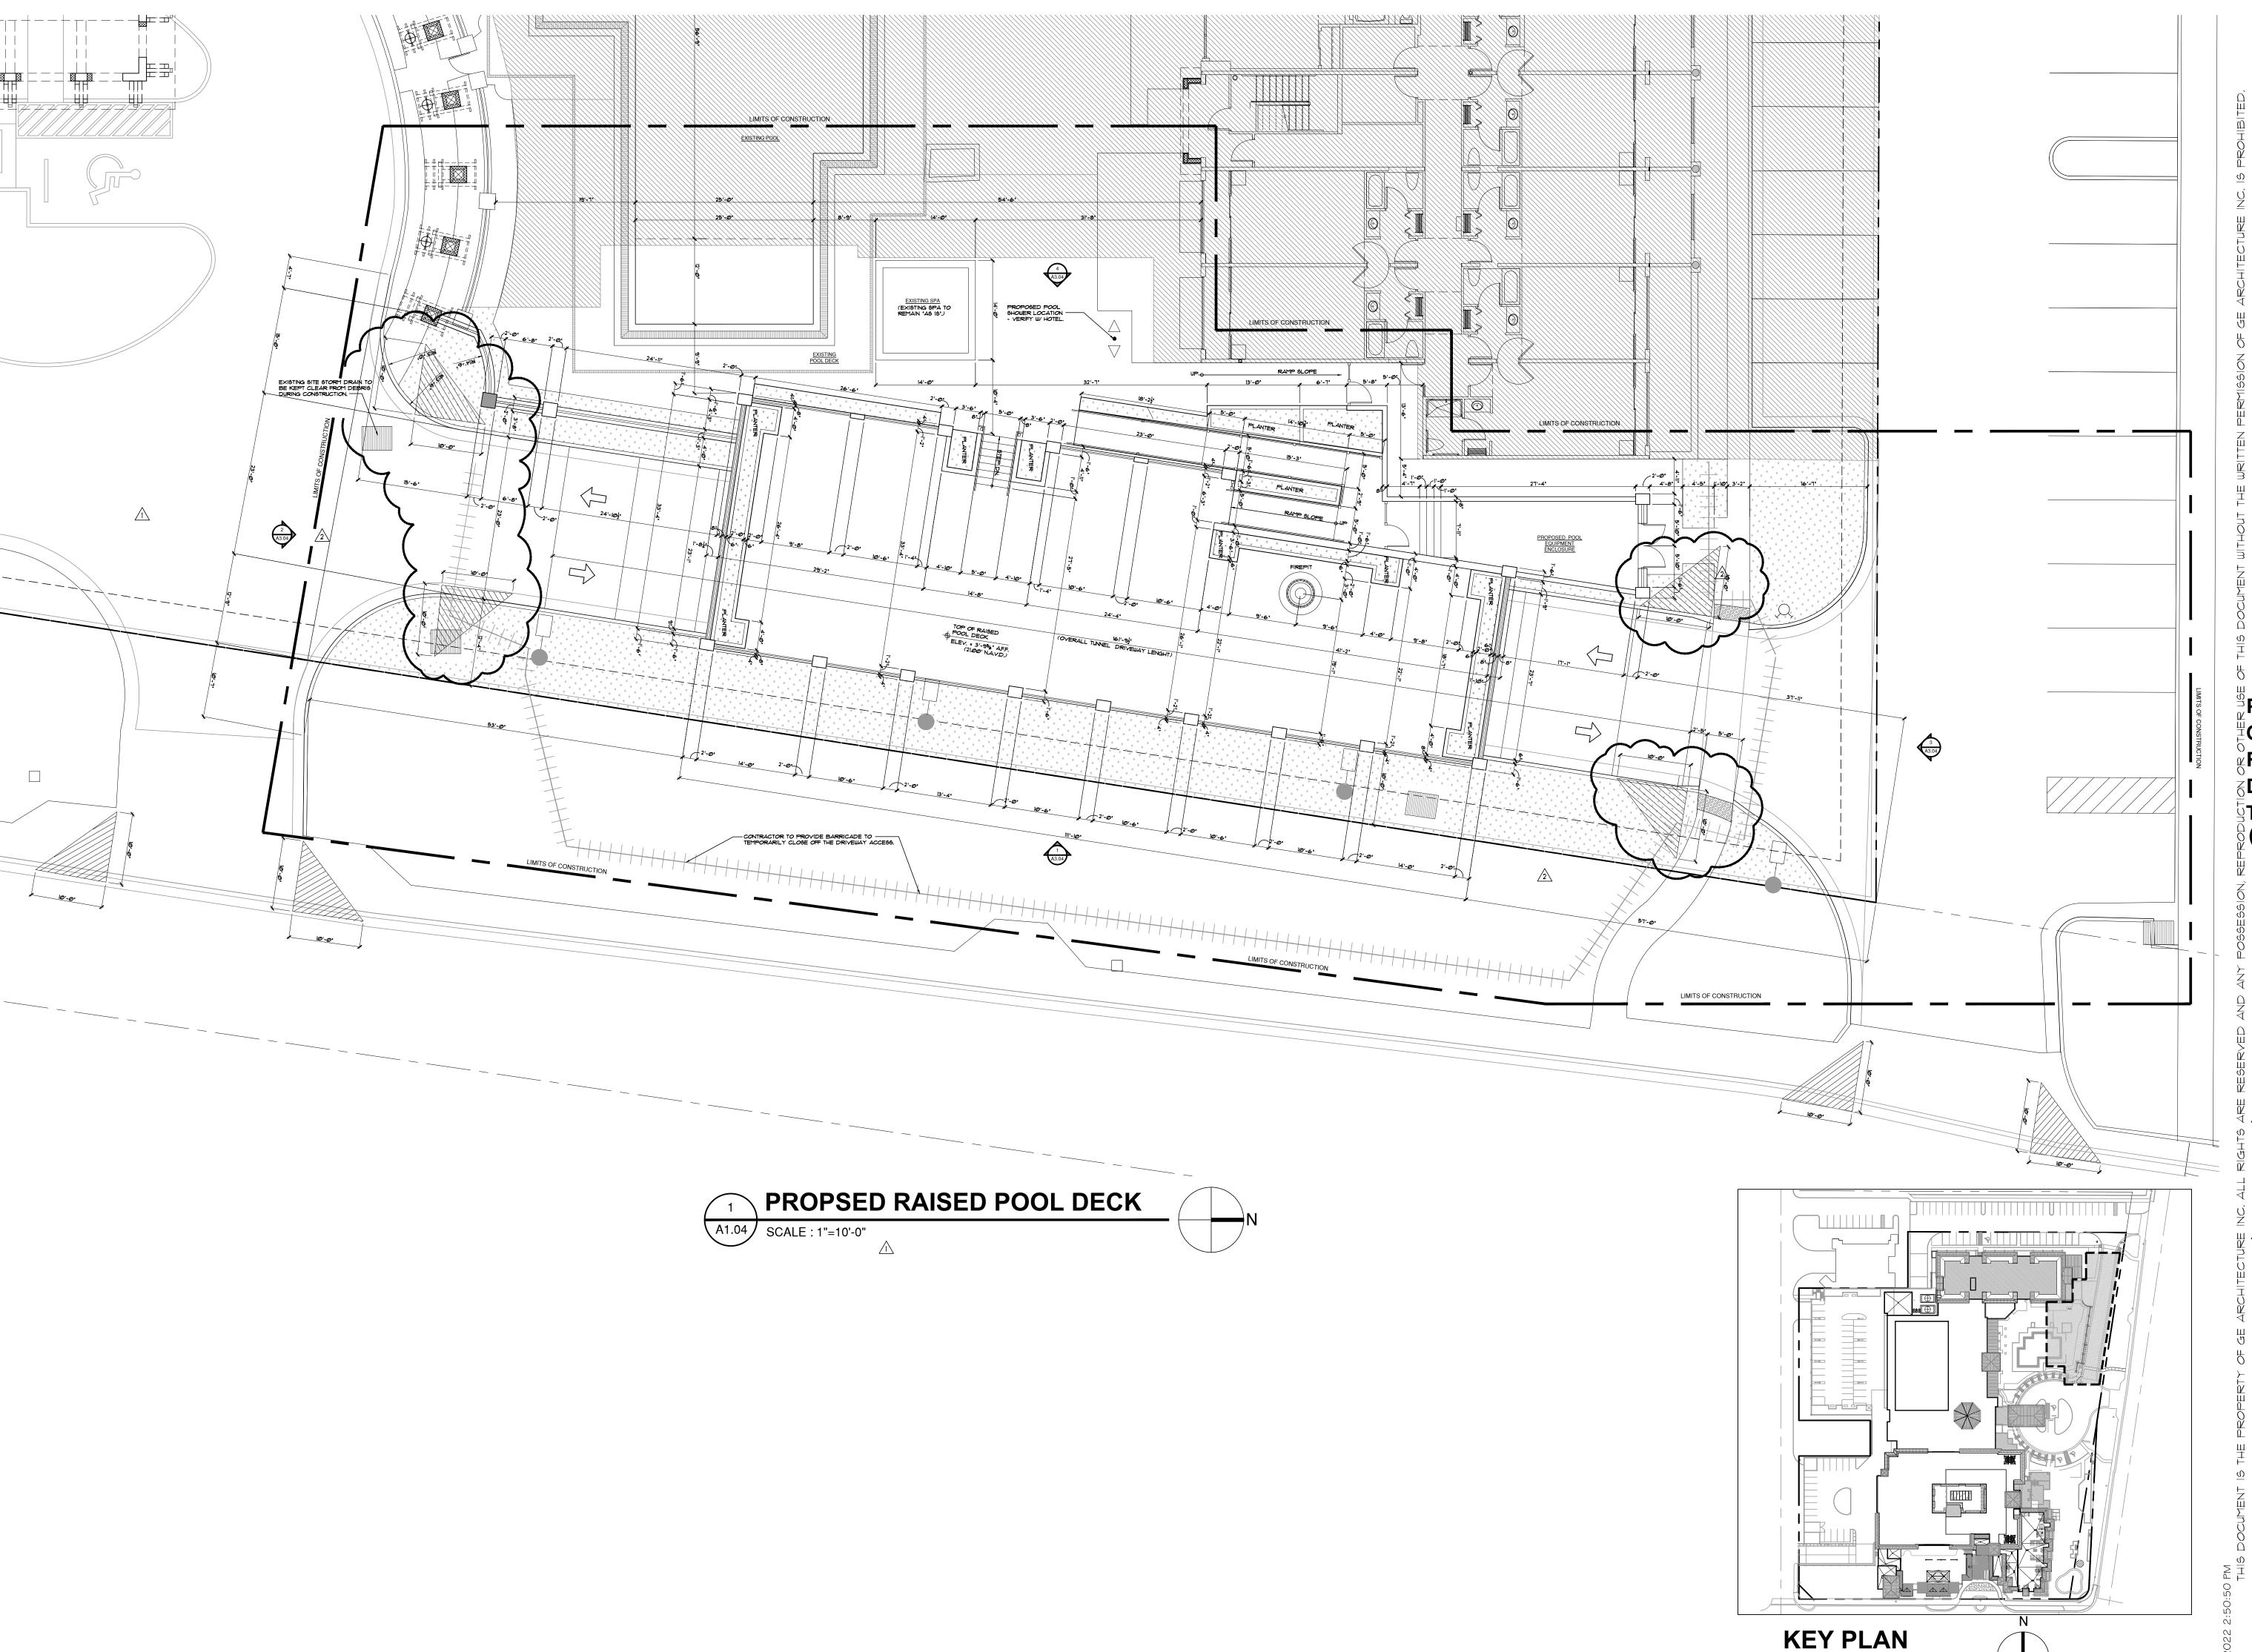



1 1045 East Atlantic Ave. Suite 303 E Delray Beach, Florida 33483 ETL: 561-276-6011 FAX: 561-276-6129

ISSUED FOR PERMIT

CONSTRUCTION

PROJECT TITLE

PROPOSED #OPAL GRAND **KRAISED POOL DECK / DRIVEWAY ≒TUNNEL** (PHASE V)

10 N. OCEAN BLVD. DELRAY BEACH, FL

CLIENT APPROVAL

REVISIONS

REVISED 1.17.22 PER CITY
COMMENTS:
- INDICATE SIGHT TRIANGLES AT
NORTH AND SOUTH ENTRY POINTS.
- COORDINATE W/ CIVIL DRAWING.
- REVISED LOCATION OF
ACCESSIBLE RAMP.
- COORDINATE LIMITS OF
CONSTRUCTION.
- REVISED SCALE I"-10"-0" FOR
COORDINATION
- INCREASED PROPOSED RAISED
POOL DECK FINISH FLOOR.

REVISED 6.03.22 PER CITY
COMMENTS:
- COORDINATE W/ CIVIL DWGS.
IN RESPONSE TO COMMENTS TO
PROVIDE SIGHT TRIANGLE AT
INTERSECTION OF DRIVEWAY
TUNNEL.

THIS DRAWING IS NOT FOR CONSTRUCTION, IT HAS BEEN ISSUED FOR GOVERNMENTAL REVIEW AND/OR PRELIMINARY PRICING

FILE NUMBER


312A104 DRAWING TITLE

PROPOSED RAISED POOL DECK PLAN

01.21.20 DRAWN BY GE/JC JOB NUMBER

20190312 DRAWING NUMBER

A1.04

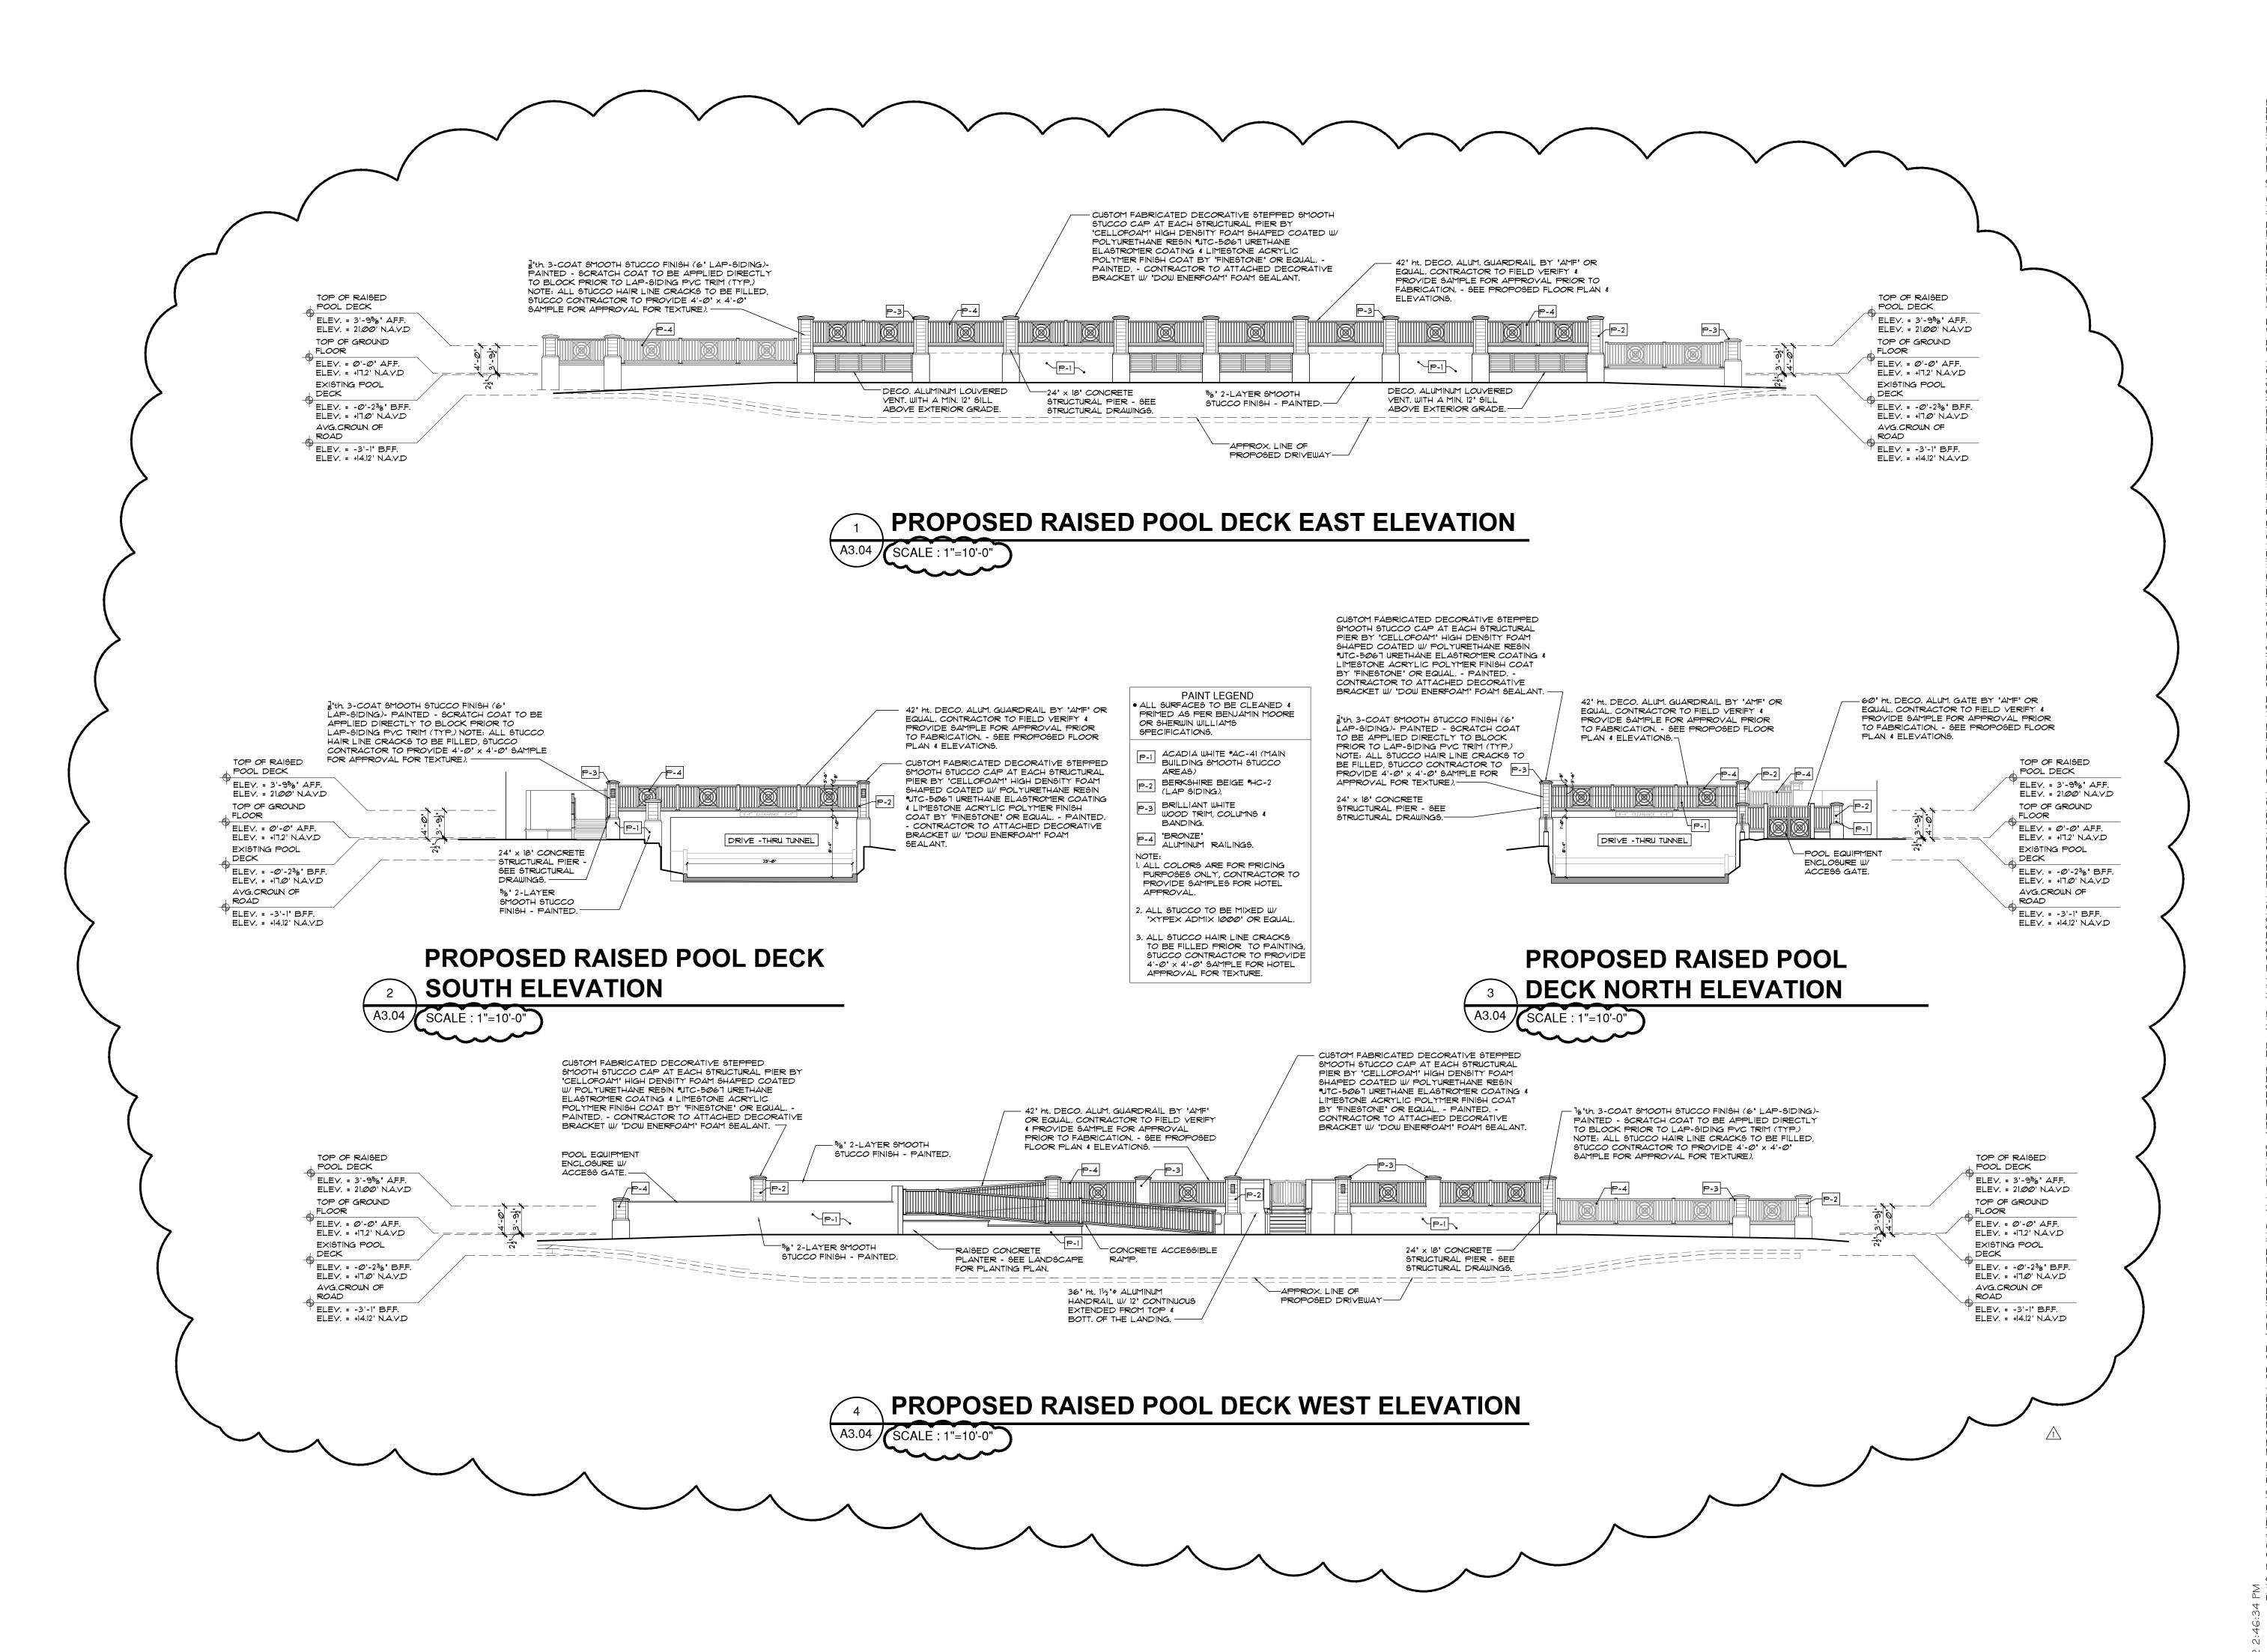



1045 East Atlantic Ave. Suite 303 Delray Beach, Florida 33483 TEL: 561-276-6011 FAX: 561-276-6129

ISSUED FOR PERMIT

BIDS

PERMIT

CONSTRUCTION

PROJECT TITLE

PROPOSED OPAL GRAND RAISED POOL DECK/ DRIVEWAY TUNNEL (PHASE V)

10 N. OCEAN BLVD. DELRAY BEACH, FL

CLIENT APPROVAL

REVISIONS

REVISED 1.17.22 PER CITY COMMENTS:
- EXPAND DRIVEWAY TUNNEL. - INDICATE SIGHT TRIANGLES AT NORTH AND SOUTH ENTRY POINTS. - COORDINATE W/ CIVIL DRAWING. - REVISED LOCATION OF ACCESSIBLE RAMP. - COORDINATE LIMITS OF CONSTRUCTION.

- REVISED SCALE 1'-10'-0' FOR ROAD REFERENCE.

THIS DRAWING IS NOT FOR CONSTRUCTION, IT HAS BEEN ISSUED FOR GOVERNMENTAL REVIEW AND/OR PRELIMINARY PRICING

FILE NUMBER 312A304

DRAWING TITLE


PROPOSED RAISED POOL DECK ELEVATIONS

1.21.20

DRAWING NUMBER

20190312

GE/JC

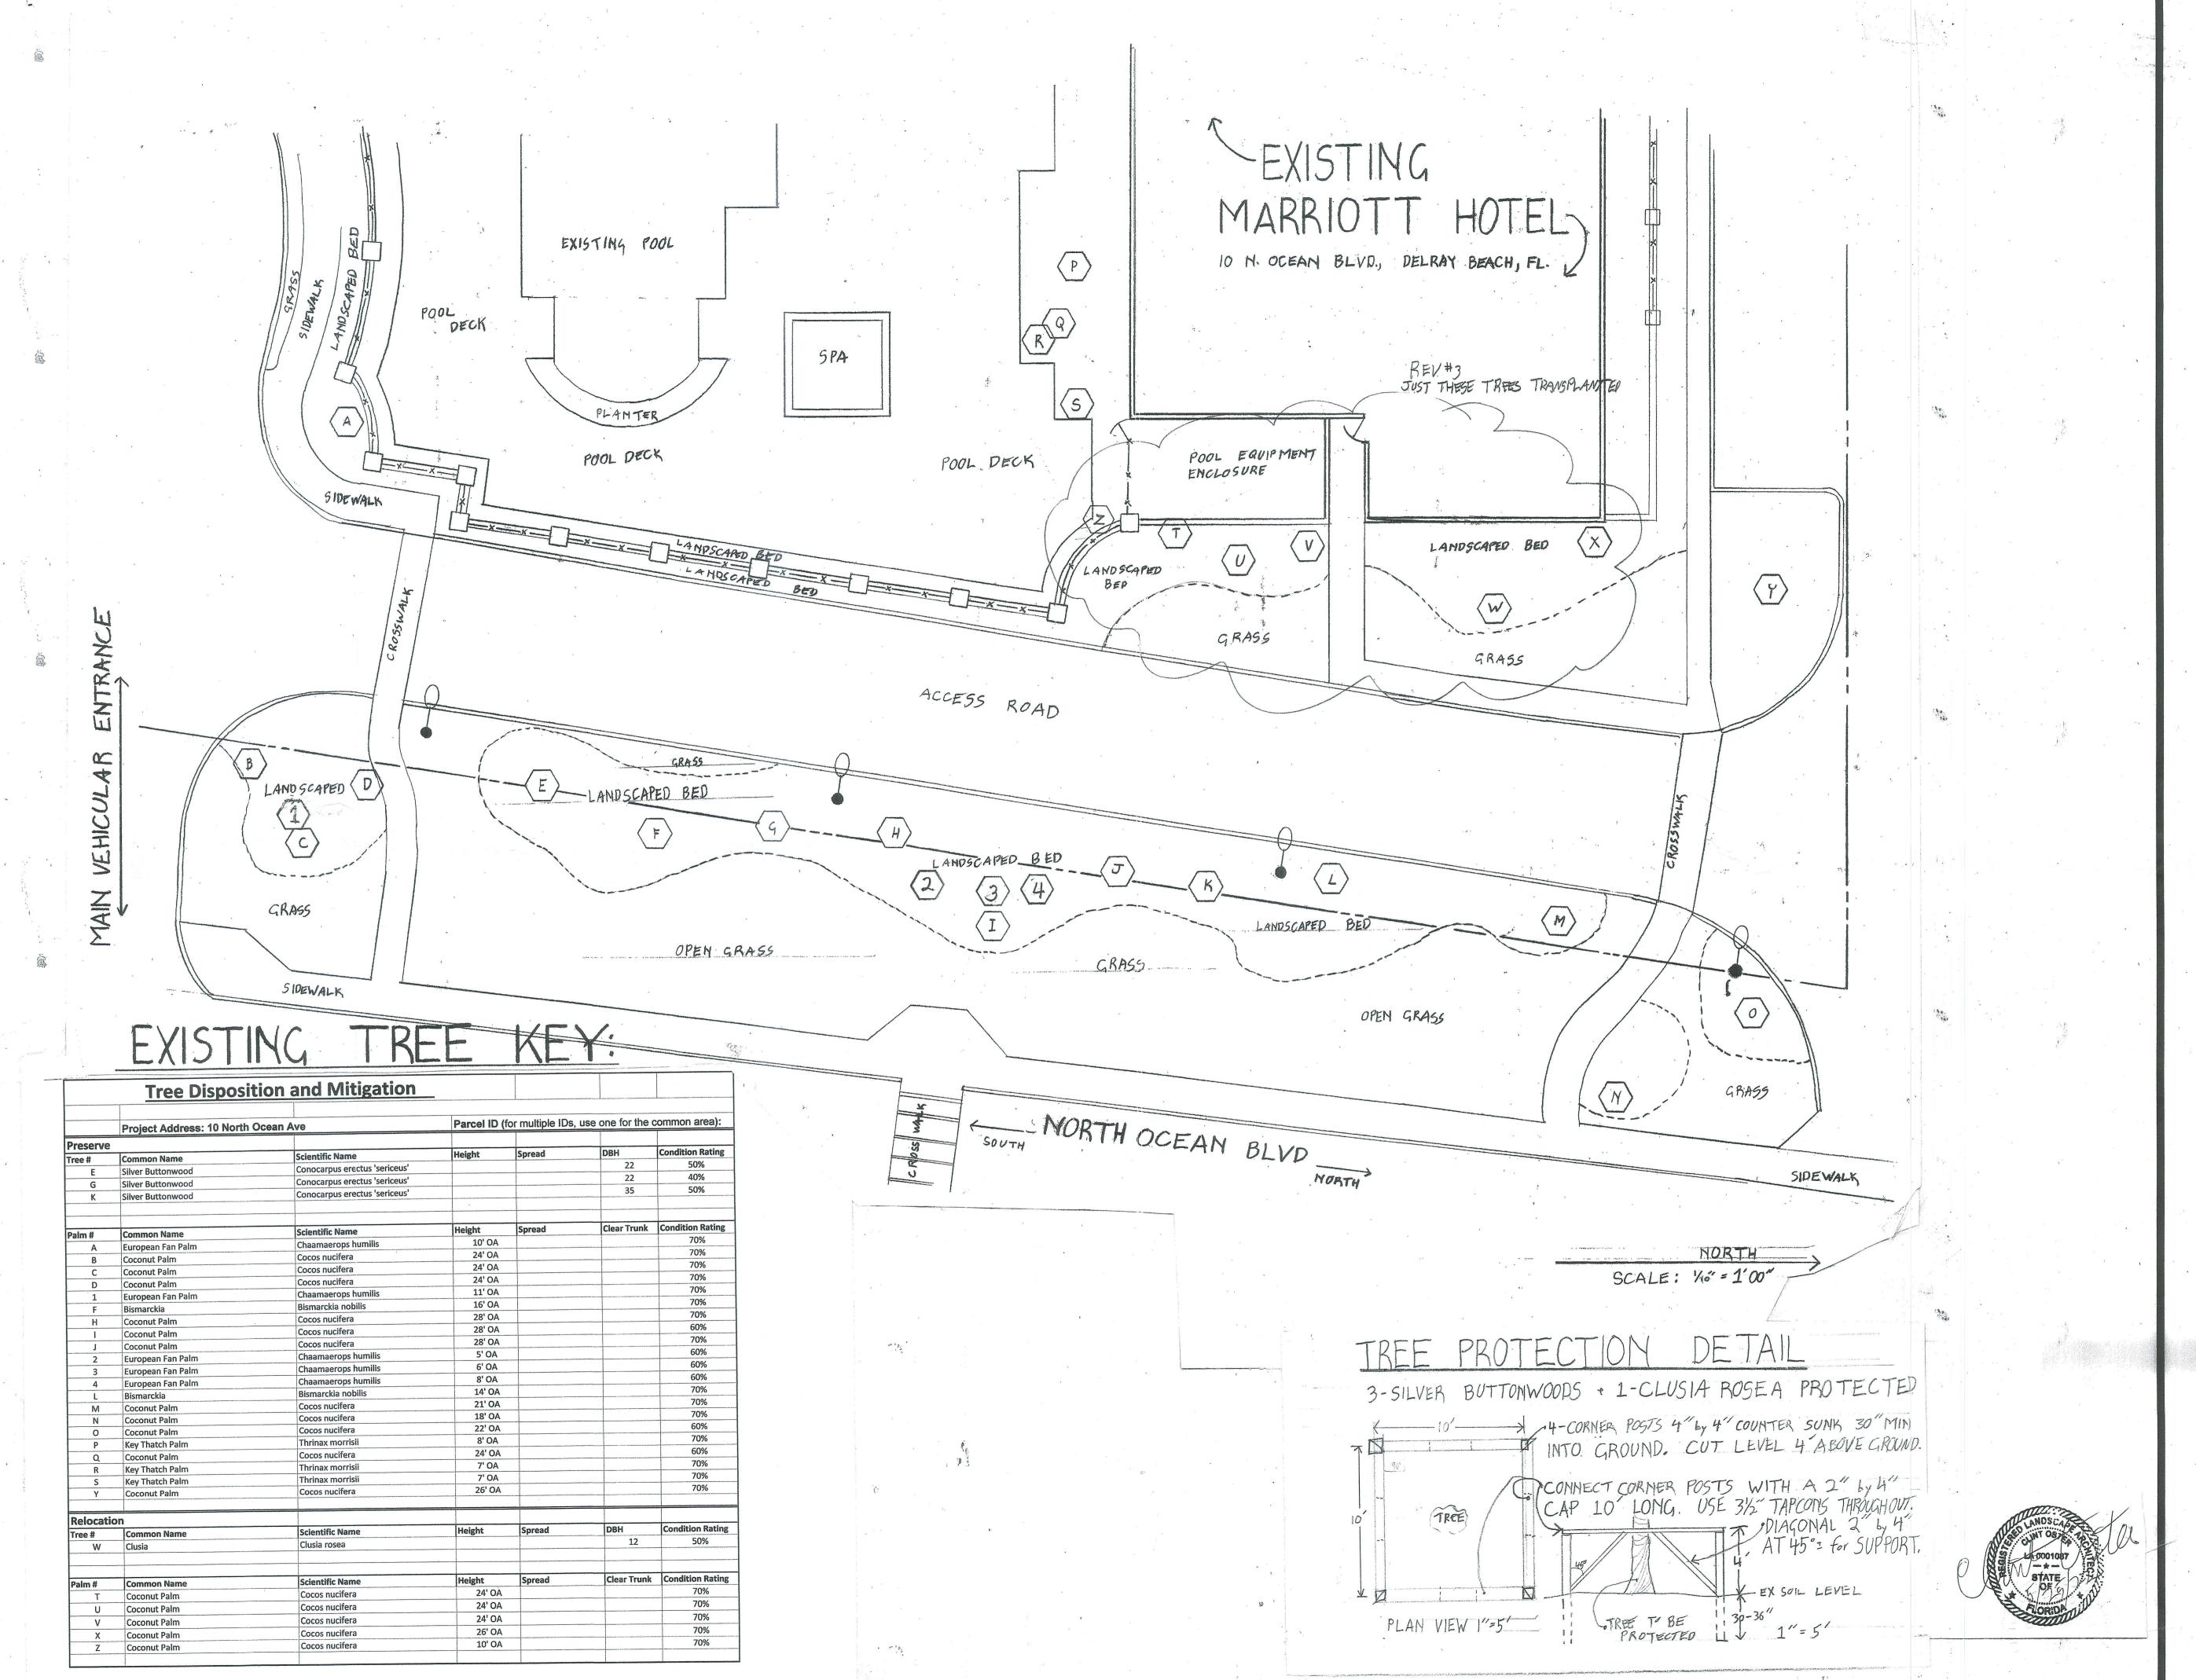

NATIONAL PRINTPAST NO. 6103ACTB-24X36

1-22-22 UPDATE

5-6-22 ADDRESS


5-25-22 ARBORIST. REPORT ADDED

CLON O
CHECKED

11-21-19
SCALE
1"- 10
JOB NO.
SHEET

SHEET

1
OF 2
SHEETS

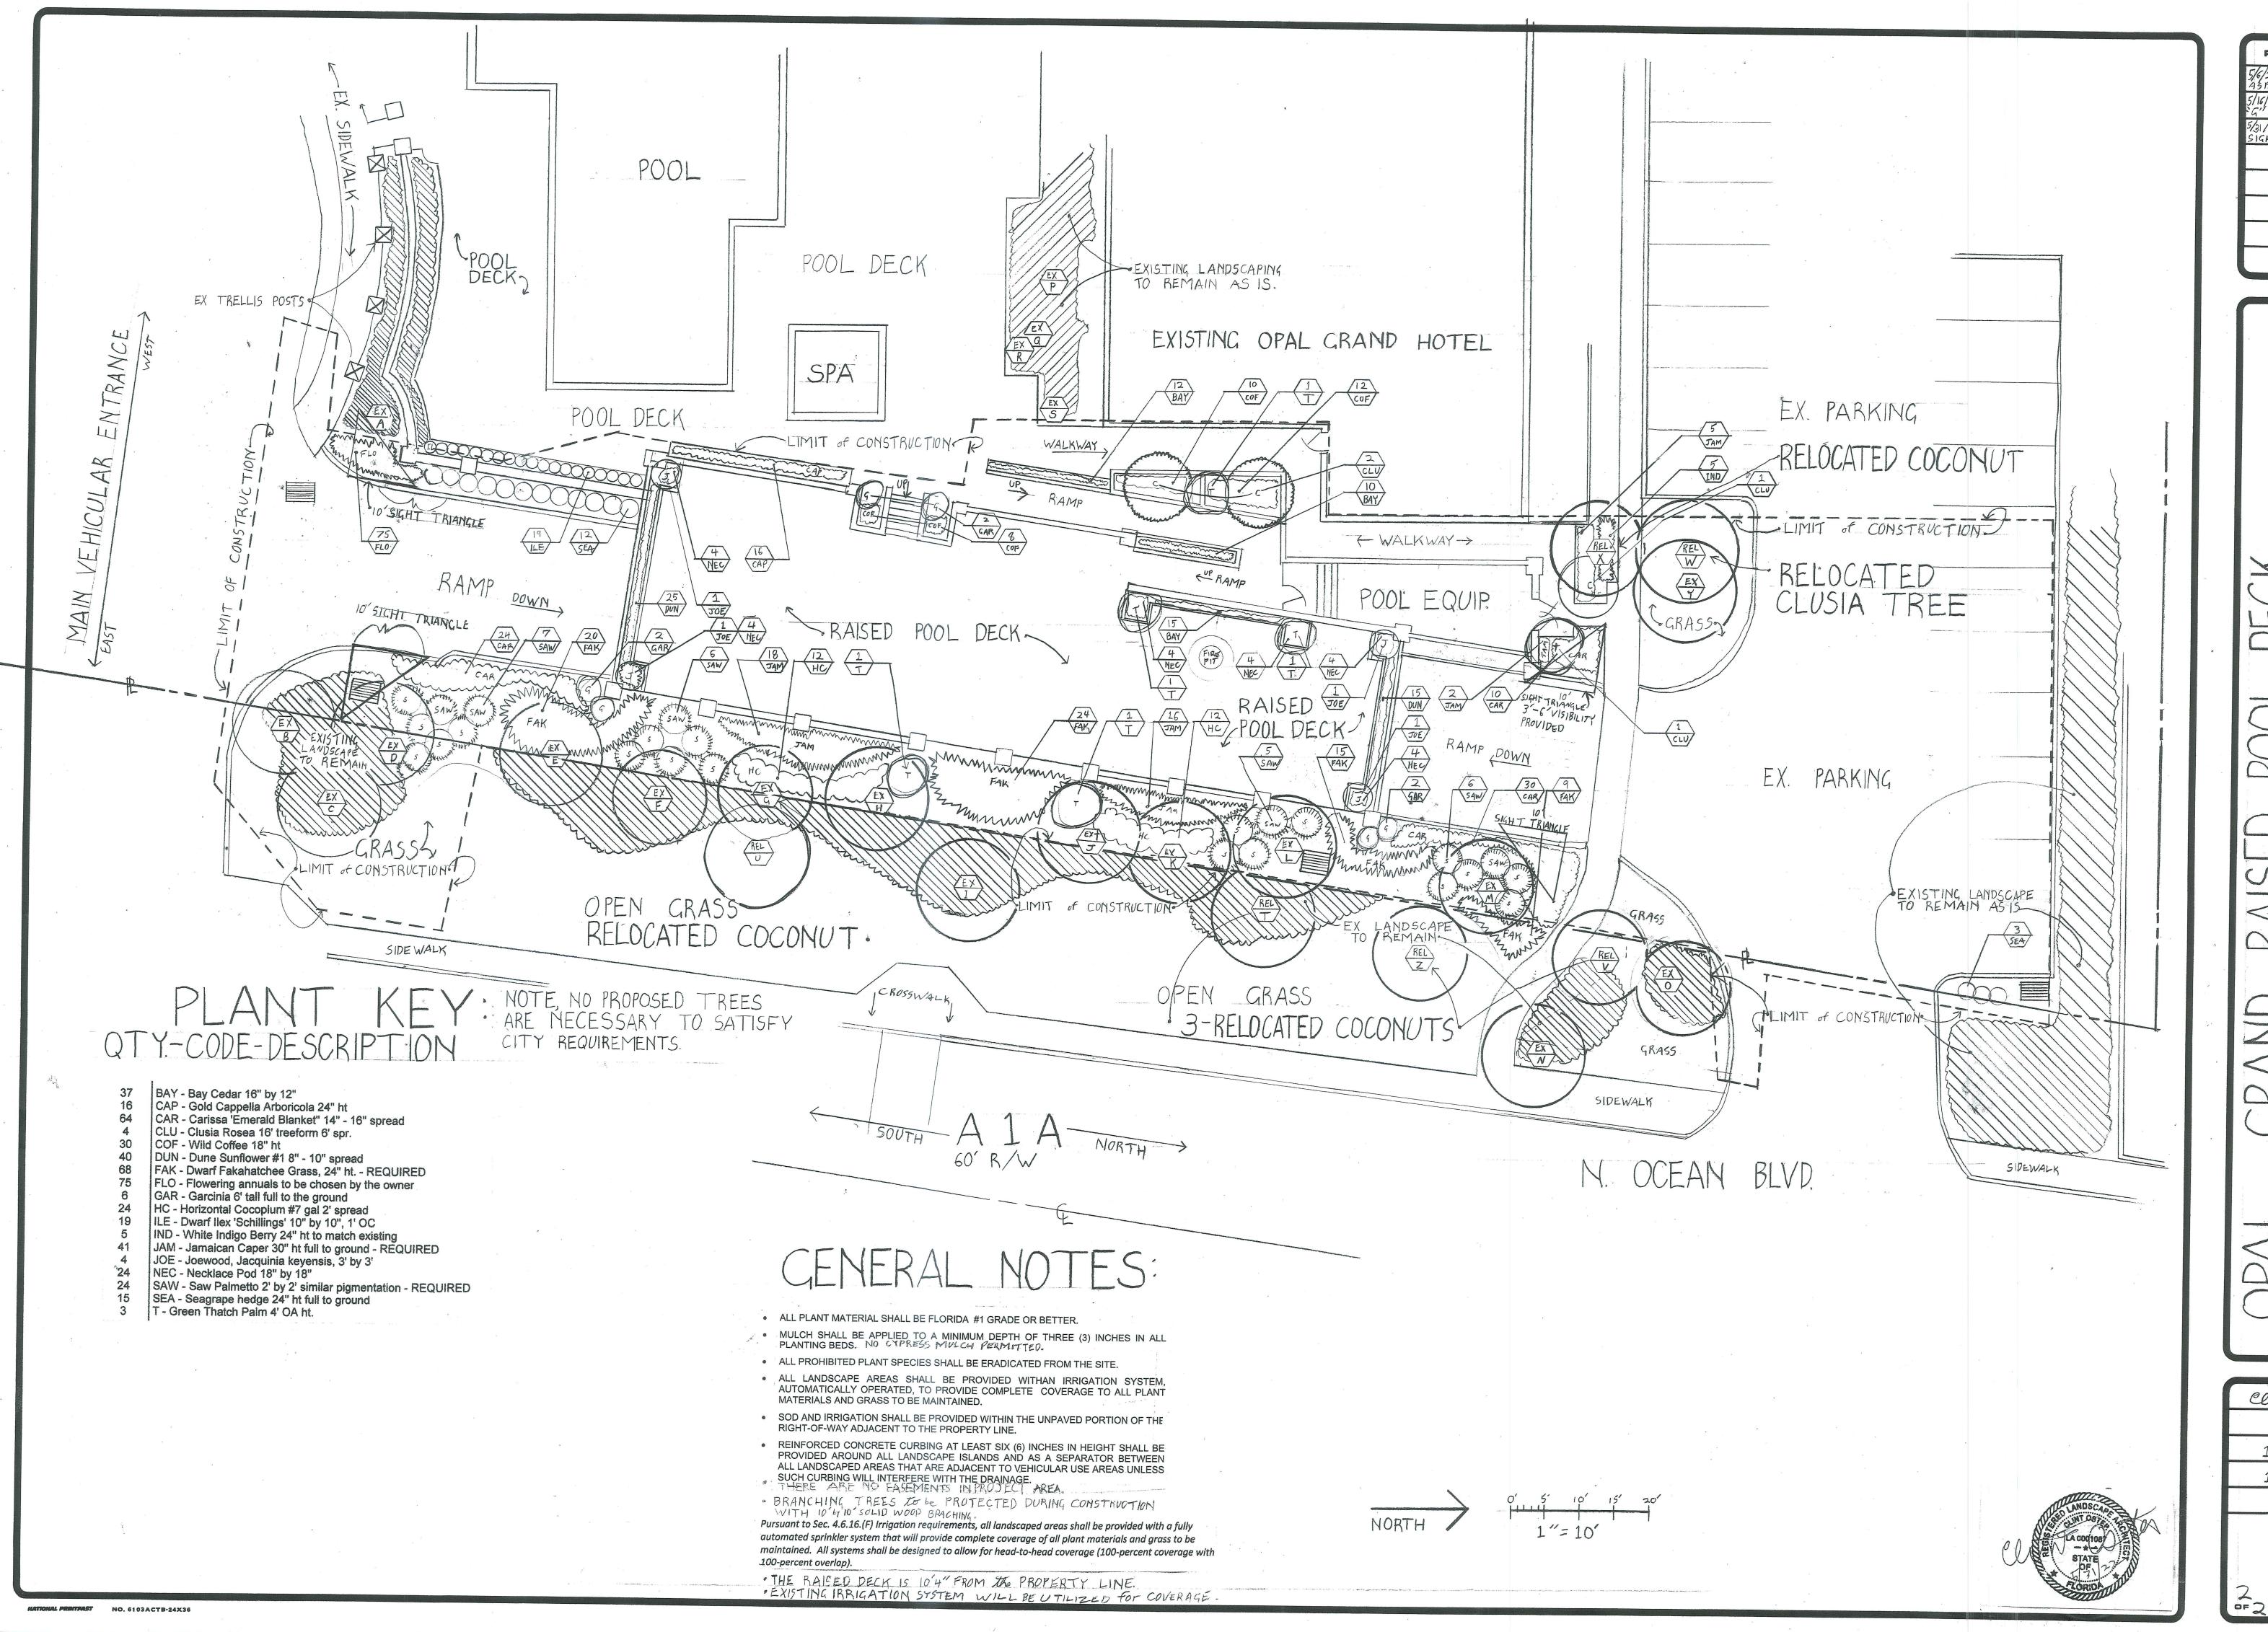

FEVISIONS BY

5/6/22 ADD HOTES
ASTER CITY COMMENTS

5/16/22 LOCATE TREE C.O.

5/31/22 MOVE
SIGHT TRIAMIE

C.O.

CLINT O.

CHECKED

1-22-22

SCALE
1"=10'

JOB NO.

SHEET