


"ANY TRESS OR SHRUBS PLACED WITHIN WATER, SEWER OR DRAINAGE EASEMENTS SHALL CONFORM TO THE CITY OF DELRAY BEACH STANDARD DETAILS LD 1.1 AND LD."

"EXISTING NATIVE SOIL WITHIN ALL LANDSCAPE ISLANDS, INTERIOR LANDSCAPE STRIPS AND PERIMETER LANDSCAPE STRIPS, ADJACENT TO VEHICULAR USE AREAS, SHALL BE EXCAVATED DOWN TO A DEPTH OF THIRTY (30) INCHES BELOW EXISTING GRADE, EXCEPT FOR A 12" BUFFER FROM THE INSIDE OF THE CURB OR PAVEMENT. A SUITABLE PLANTING SOIL MIXTURE OF FIFTY/FIFTY (50/50), SIXTY/FORTY (60/40) (SAND/TOPSOIL) OR AS OTHERWISE INDICATED BY THE REGISTERED LANDSCAPE ARCHITECT, SHALL EITHER BE BACKFILLED IN PLACE OF THE NATIVE SOIL OR EFFICIENTLY MIXED WITH THE NATIVE SOIL TO CREATE AN OPTIMUM ENVIRONMENT FOR SUCCESSFUL ROOT DEVELOPMENT. IF NATIVE SOIL IS TO BE MIXED, IT SHALL FIRST BE SCREENED TO REMOVE ROCKS AND DEBRIS LARGER THAN ONE-HALF (1/2) INCH IN DIAMETER PRIOR TO MIXING. ALL PROPERTIES UNDER THIS SECTION SHALL BE REQUIRED TO HAVE AN OPEN BED INSPECTION PRIOR TO BACKFILLING TO INSURE THE THIRTY (30) INCH DEPTH HAS BEEN MET."

"ALL PROHIBITED PLANT SPECIES SHALL BE ERADICATED FROM THE DEVELOPMENT SITE AND REESTABLISHMENT OF PROHIBITED SPECIES SHALL NOT BE PERMITTED."


PLEASE MODIFY GENERAL NOTE #7. AND ANY OTHER NOTES RELATING TO IRRIGATION, TO ALLOW 100% COVERAGE AND 100% OVERLAP, AS PER SEC.4.6.16. LANDSCAPE REGULATIONS.

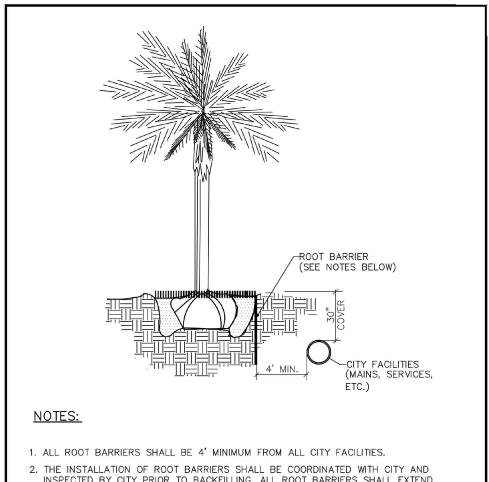


- INSPECTED BY CITY PRIOR TO BACKFILLING. ALL ROOT BARRIERS SHALL EXTEND UP TO FINISHED GRADE.
- 3. ROOT BARRIERS SHALL BE MINIMUM 36" DEEP. APPROVED PRODUCTS INCLUDE "DEEP ROOT" AND "ROOT SOLUTIONS". FLEXIBLE BARRIERS SHALL BE 36" PANELS MANUFACTURED BY BIOBARRIER. 4. ALL ROOT BARRIERS SHALL BE INSTALLED IN ACCORDANCE WITH MANUFACTURERS

CITY OF DELRAY BEACH
ENVIRONMENTAL SERVICES DEPARTMENT
434 SOUTH SWINTON AVENUE, DELRAY BEACH, PLORIDA 33444

TYPICAL TREE WITH ROOT BARRIER | LD 1.1

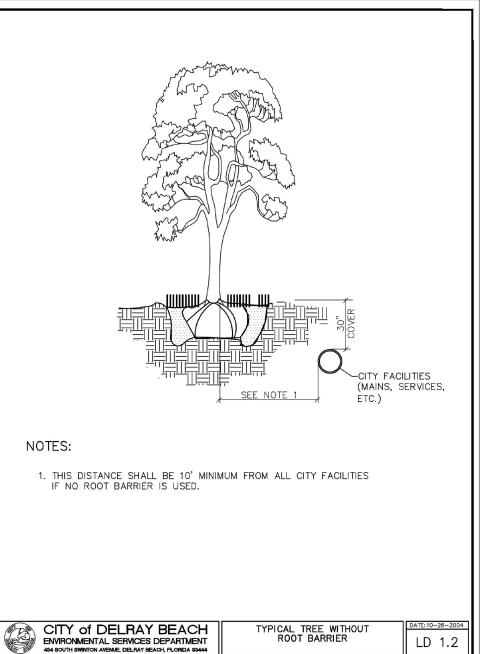

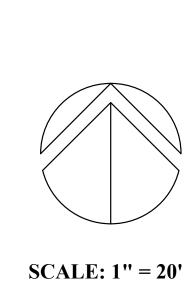



landscape architects

and planners

LC - 0000396 2300 Corporate Blvd. NW. Suite 214 Boca Raton, Florida 33431 Ph: 561.955.8623

Fax: 561.362.4749

email: landscapearchitects@dsboca.com

07-08-21 SPRAB Rev 07-28-21 SPRAB Commen

08-26-2021 Site Permit 01-21-2022 Site Permit 06-20-2022 Owner Changes

10-31-2022 Owner Changes 11-21-2022 SPRAB Rev. **OCTOBER 11, 2021**


G.C. DRAWN BY:

M.J. APPROVED BY:

This drawing is the property of Design Studio Boca, and is an instrument of service not to be reproduced in whole or in part without the express written permission of same.

SHEET

 \mathbf{CD}

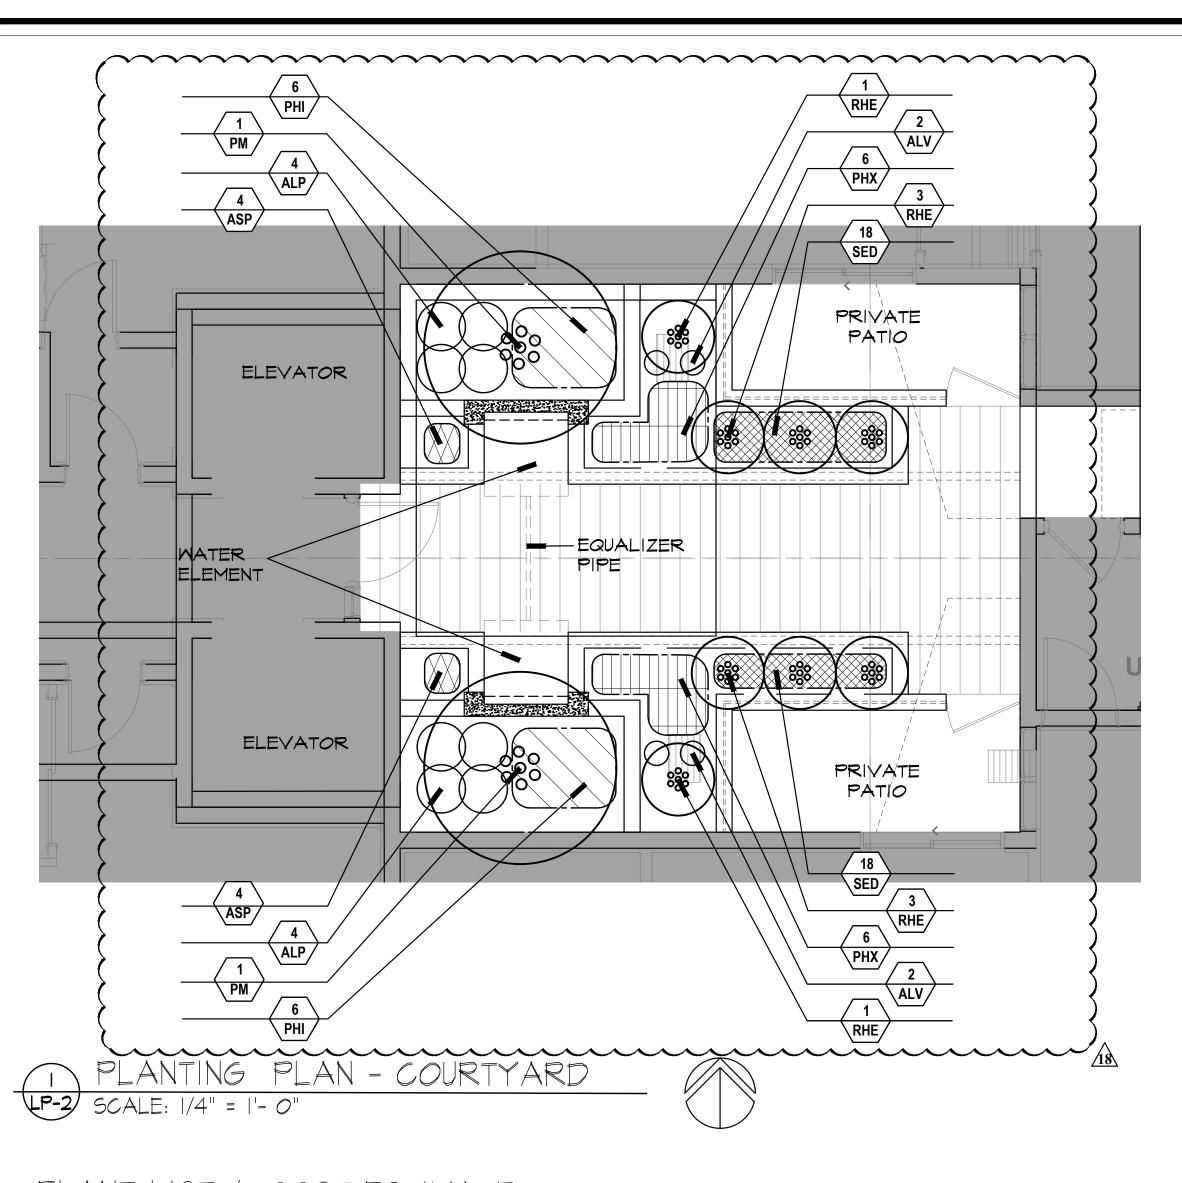

-(2) WATER WALL (+8' ABOVE FFE.) RAISED PLANTER -- RAISED PLANTER (+48" ABOVE SLAB) (+24" ABOVE SLAB PRIVATE PATIO ELEVATOR IN RAISED PLANTER -(+24" ABOVE SLAB) EQUALIZER (3) TYPICAL ELEMENT NICHE LIGHT RAISED PLANTER (+24" ABOVE SLAB) ELEVATOR : PRIVATE PATIO RAISED PLANTER -RAISED PLANTER (+48" ABOVE SLAB) (+24" ABOVE SLAB) (2) WATER WALL (+8' ABOVE FFE.)

WATER ELEMENT SCHEDULE

- BASIN: 24" DEPTH WITH BLACK MEXICAN BEACH PEBBLES AT THE FINISH: FUNIDA GEM LAGOON
- (2) WALL FINISH: CERAMIC MATRIX CRECENT V-TILE #CB28M COLOR: SULTRA BLACK
- 3 LIGHTING UNDER WALL (6) UPRIGHT ON WATER WALL
- (4) COURTYARD FLOORING BELGARD PORCELAIN PAVER DAYLIGHT NN OI RD SIZE: 12" × 48"

NOTE: ALL PLANTERS TO HAVE (2) PHASE DRAIN, ELECTRIC AND IRRIGATION.

LAYOUT PLAN - COURTYARD



ROOT BARRIER (SEE NOTES BELOW) 1. ALL ROOT BARRIERS SHALL BE 4' MINIMUM FROM ALL CITY FACILITIES. 2. THE INSTALLATION OF ROOT BARRIERS SHALL BE COORDINATED WITH CITY AND INSPECTED BY CITY PRIOR TO BACKFILLING. ALL ROOT BARRIERS SHALL EXTEND UP TO FINISHED GRADE. 3. ROOT BARRIERS SHALL BE MINIMUM 36" DEEP. APPROVED PRODUCTS INCLUDE "DEEP ROOT" AND "ROOT SOLUTIONS". FLEXIBLE BARRIERS SHALL BE 36" PANELS MANUFACTURED BY BIOBARRIER. 4. ALL ROOT BARRIERS SHALL BE INSTALLED IN ACCORDANCE WITH MANUFACTURERS WRITTEN INSTRUCTIONS. CITY of DELRAY BEACH TYPICAL TREE WITH ROOT BARRIER ENVIRONMENTAL SERVICES DEPARTMENT 434 SOUTH SWINTON AVENUE, DELRAY BEACH, FLORIDA 33444

1. THIS DISTANCE SHALL BE 10' MINIMUM FROM ALL CITY FACILITIES IF NO ROOT BARRIER IS USED. CITY of DELRAY BEACH ENVIRONMENTAL SERVICES DEPARTMENT
434 SOUTH SWINTON AVENUE, DELRAY BEACH, FLORIDA 33444

"ANY TRESS OR SHRUBS PLACED WITHIN WATER, SEWER OR DRAINAGE EASEMENTS SHALL CONFORM TO THE CITY OF DELRAY BEACH STANDARD DETAILS LD 1.1 AND

"EXISTING NATIVE SOIL WITHIN ALL LANDSCAPE ISLANDS, INTERIOR LANDSCAPE STRIPS AND PERIMETER LANDSCAPE STRIPS, ADJACENT TO VEHICULAR USE AREAS, SHALL BE EXCAVATED DOWN TO A DEPTH OF THIRTY (30) INCHES BELOW EXISTING GRADE, EXCEPT FOR A 12" BUFFER FROM THE INSIDE OF THE CURB OR PAVEMENT. A SUITABLE PLANTING SOIL MIXTURE OF FIFTY/FIFTY (50/50), SIXTY/FORTY (60/40) (SAND/TOPSOIL) OR AS OTHERWISE INDICATED BY THE REGISTERED LANDSCAPE ARCHITECT, SHALL EITHER BE BACKFILLED IN PLACE OF THE NATIVE SOIL OR EFFICIENTLY MIXED WITH THE NATIVE SOIL TO CREATE AN OPTIMUM ENVIRONMENT FOR SUCCESSFUL ROOT DEVELOPMENT. IF NATIVE SOIL IS TO BE MIXED, IT SHALL FIRST BE SCREENED TO REMOVE ROCKS AND DEBRIS LARGER THAN ONE-HALF (1/2) INCH IN DIAMETER PRIOR TO MIXING. ALL PROPERTIES UNDER THIS SECTION SHALL BE REQUIRED TO HAVE AN OPEN BED INSPECTION PRIOR TO BACKFILLING TO INSURE THE THIRTY (30) INCH DEPTH HAS BEEN MET."

"ALL PROHIBITED PLANT SPECIES SHALL BE ERADICATED FROM THE DEVELOPMENT SITE AND REESTABLISHMENT OF PROHIBITED SPECIES SHALL NOT BE PERMITTED."

KEY	QTY. TOTAL	BOTANICAL/COMMON NAME	HEIGHT	SPREAD	CLEAR TRK.	SPA.	REMARKS
PM	2	Ptychosperma macarthurii	16-18'	8-10'			Multi-trunks, 7-9 minimu
		Macarthur palm					Full heads
SHRUBS AND GROU	UNDCOVERS	~~~~~	~~~	~~~	~~~	~~	~~~~
KEY	QTY. TOTAL	BOTANICAL/COMMON NAME	HEIGHT	SPREAD	CLEAR TRK.	SPA.	REMARKS
ASP	8	Asparagus densiflorus 'Myers'	16"	16"		2' o.c.	Full clump
		Foxtail Fern					7 Gallon cont.
ALP	8	Alpinia purpurata	24"	24"		2' o.c.	Full clump
		Red Ginger					7 Gallon cont.
ALV	4	Alpinia z. 'Variegata'	24"	24"		2' o.c.	Full clump
		Variegated Shell Ginger					7 Gallon cont.
PHX	12	Philodendron 'Xanadu'	16"	16"		2' o.c.	Full clump
		Dwarf Philodendron					7 Gallon cont.
PHI	12	Philldendrom sellum	18"	18"		2' o.c.	Full clump
		Split Leaf Philodendrom					7 Gallon cont.
RHE	8	Rhaphis excelsa	5'-6'	24-30"			Full clump
		Lady Palm					15 Gallon cont.
SED	36	Sedum acre 'Gold Moss'	12"	12"		12"	Full cont.
		Goldmoss stonecrop					3" Gallon cont.

MISCELLANEOUS

Sod to be Empire Zoysia.

Planting soil -1/2 cu. yd. per tree and 4" depth at all hedges and mass planting beds.

Sand - Palms to be planted in clean sand; $\frac{1}{2}$ cu.yd.per palm.

Mulch – 3" depth of shredded "dark brown" hybrid mulch B grade or better at all hedges and mass planting beds.

GENERAL NOTES

- * Indicates plant material native to Florida
- All sod to be Empire Zoysia sod.
- All plant materials shall conform to the standards for Florida No. 1 or better as given in "Grades and Standards for
- Nursery Plants", Latest Edition, State of Florida Department of Agriculture, Tallahassee, or thereto. • All trees shall be properly guyed and staked at the time of planting to ensure proper establishment.
- The planting soil for all planting areas shall be composed of a minimum of 30% muck or horticulturally acceptable organic material. The minimum soil depth shall be four inches in all hedges and mass planting beds and ½ cu.yd.per tree. Palms to be planted in clean sand.
- Three inches minimum of shredded "dark brown" hybrid mulch shall be installed around each tree and palm and throughout mass planting beds, the use of Cypress mulch is strongly discourage.
- Irrigation system to provide 100% coverage to landscaped areas with 50% overlap. Irrigation to be an automatic system with
- a rain gauge/moisture sensor shut-off.
- In case of discrepancies, planting plan takes precedence over plant list.
- Landscape contractor is responsible for his own quantity take-offs.

design studio boca

landscape architects and planners

LC - 0000396 2300 Corporate Blvd. NW. Suite 214 Boca Raton, Florida 33431 Ph: 561.955.8623

Fax: 561.362.4749 email: landscapearchitects@dsboca.com

04-01-2021 Building comments Courtyard Design 06-25-21 GMP **08-26-2021 Site Permit** 01-21-2022 Site Permit **06-20-2022 Owner Changes** 11-21-2022 SPRAB Rev.


OCTOBER 11, 2021


G.C. DRAWN BY:

M.J. APPROVED BY:

This drawing is the property of Design Studio Boca, and is an instrument of service not to be reproduced in whole or in part without the express written

permission of same.

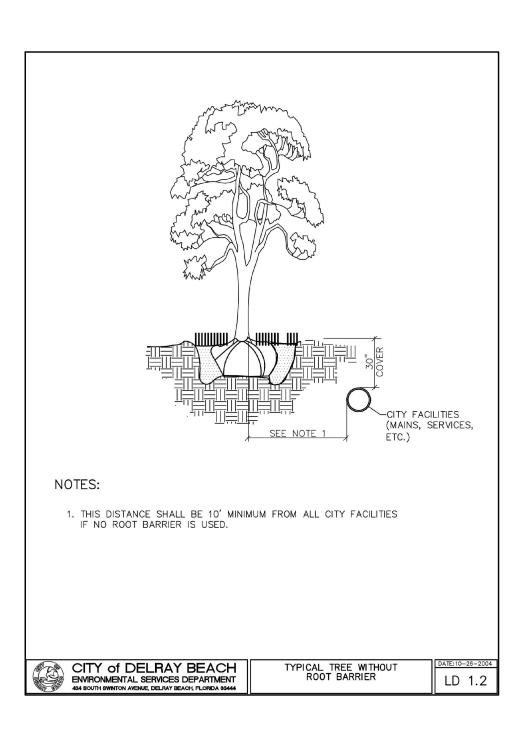

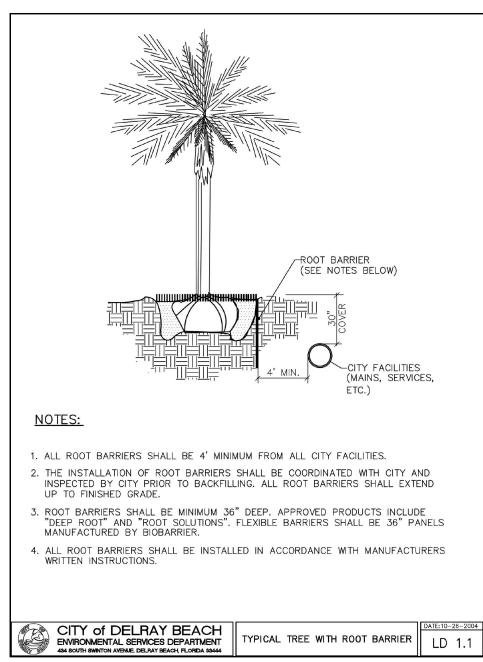

"EXISTING NATIVE SOIL WITHIN ALL LANDSCAPE ISLANDS, INTERIOR LANDSCAPE STRIPS AND PERIMETER LANDSCAPE STRIPS, ADJACENT TO VEHICULAR USE AREAS, SHALL BE EXCAVATED DOWN TO A DEPTH OF THIRTY (30) INCHES BELOW EXISTING GRADE, EXCEPT FOR A 12" BUFFER FROM THE INSIDE OF THE CURB OR PAVEMENT. A SUITABLE PLANTING SOIL MIXTURE OF FIFTY/FIFTY (50/50), SIXTY/FORTY (60/40) (SAND/TOPSOIL) OR AS OTHERWISE INDICATED BY THE REGISTERED LANDSCAPE ARCHITECT, SHALL EITHER BE BACKFILLED IN PLACE OF THE NATIVE SOIL OR EFFICIENTLY MIXED WITH THE NATIVE SOIL TO CREATE AN OPTIMUM ENVIRONMENT FOR SUCCESSFUL ROOT DEVELOPMENT. IF NATIVE SOIL IS TO BE MIXED, IT SHALL FIRST BE SCREENED TO REMOVE ROCKS AND DEBRIS LARGER THAN ONE-HALF (1/2) INCH IN DIAMETER PRIOR TO MIXING. ALL PROPERTIES UNDER THIS SECTION SHALL BE REQUIRED TO HAVE AN OPEN BED INSPECTION PRIOR TO BACKFILLING TO INSURE THE THIRTY (30) INCH DEPTH HAS BEEN MET."

"ALL PROHIBITED PLANT SPECIES SHALL BE ERADICATED FROM THE DEVELOPMENT SITE AND REESTABLISHMENT OF PROHIBITED SPECIES SHALL NOT BE PERMITTED."

PLANT LIST

KEY	QTY. TOTAL	BOTANICAL/COMMON NAME	HEIGHT	SPREAD	CLEAR TRK.	SPA.	REMARKS
ED	4	Elaepcarpus decipiens	8-9'	3-4'			Full to base,
CN	27	Cocos nucifera 'Green Malay' Green Malayan Coconut Palm		Wood as	noted on plan		Cone shape, 2" Cal Stagg. Ht. groups, Full heads
	27 4	@ 15' of wood @ 24' of wood					
CR ⁴	39	Clusia rosea	14'	5-6'	8' c.t.		Full canopy, 4" Cal.
PS		Pitch Apple			401 .		Multi-trunk
ro	3	Phoenix sylvestris Silver Date Palm			12' c.t.		Matched, diamond cu full heads
LJ	1	Ligustrum japonicum Wax Privet	8-9'	7-8'			Full canopy
TH/24		Thrihex merhicii	12'0.a.				Multi-trunk, 3" Cal.
2		Key thatch palm	12 0.4.				DoubleTrunk
СВ	2	Calophyllum brasiliense Brazil Beauty-leaf	12-14'	5-6'			Full canopy Multi-trunk, 3" Cal.
SHRUBS AND GROU		DOTANICAL (COMMON NAME	UELOUE	000540	OL FAR TRIC	004	DEMA DICO
KEY BBK	QTY. TOTAL	BOTANICAL/COMMON NAME Bougainvillea 'Barbara Karst'	HEIGHT 5-6'	2-3'	CLEAR TRK.	SPA.	REMARKS Full Head,
	·	Bougainvillea Tree Standard					Purple, 45 Gallon
CLU	17	Clusia guttifera Small leaf Clusia	4'	20-22"	full to base	30" o.c.	Full cont. 15 Gallon cont.
CLU1	24	Clusia guttifera Small leaf Clusia	6'	20-22"	full to base	36" o.c.	Full cont. 25 Gallon cont.
CON ^a	217	Conocarpus erectus Green Buttonwood	4'	20-22"	full to base	30" o.c.	Full cont. 15 Gallon cont.
CES^	55	Conocarpus e. 'Sericeus' Silver Buttonwood	4'	18"	full to base	2' o.c.	Full cont. 15 Gallon cont.
CRI	16	Crinum asiaticum Crinum Lily	30"	30"			Multi-Full Clump
HEL^	550	Helianthus debilis Beach Sunflower	6"	12"		12" o.c.	Full Cont.
FIC	805	Ficus microcarpa 'Green Island'	14	14		18"o.c.	1 gal. Fûlt cont.
		Green Island Ficus					3 Gallon cont.
GAR	5	Garcinia Spicata Garcina	6'				Full cont.
GAR1	4	Garcinia Spicata Garcina	4'				Full cont.
JAS	149	Jasminum volubile Waxleaf Jasmine	18"	18"		2' o.c.	Full cont. 7 Gallon cont.
MON	30	Monstera Deliciosa Swiss Cheese Plant	18"	18"		2' o.c.	Full cont. 7 Gallon cont.
NEP	45	Nephrolepis exaltata Boston Fern	18"	18"		18" o.c.	Full cont. 3 Gallon cont.
NOD	98	Nerium oleander 'Dwarf' Dwarf Oleander	16"	16"	}	2' o.c.	Full cont., Pink flower 3 Gallon cont.
PHO3	5	Phoenix roebellini 'Triple' Pygmy Date Palm		-8-	3-5' c.t.		Triple trunk,
PHI	64	Philldendrom sellum Split Leaf Philodendrom	18"	18"		2' o.c.	Full clump 7 Gallon cont.
POD	42	Podocarpus macrophyllus Hedge Japanese Yew	48"		full to base	2' o.c.	Full cont. 15 Gallon cont.
SER^	18	Serenoa repens Silver Saw Palmetto	24"	24"		2' o.c.	Full cont. 7 Gallon
SCH	66	Schefflera arboricola Dwarf Schefflera	18"	18"		2' o.c.	Full cont. 7 Gallon cont.
TRI1 [^]	140	Tripsacum dactyloides Dwarf Fakahatchee Grass	12"	12"		12" o.c.	Full clump 3 Gallon cont.
1		Dwall Farallawillee Glass		1			o Ganon Cont.

^ Indicates plant material native to Florida

MISCELLANEOUS Sod to be Empire Zoysia.

920

Planting soil –1/2 cu. yd. per tree and 4" depth at all hedges and mass planting beds.

Sand - Palms to be planted in clean sand; ½ cu. yd. per palm.

Uniola paniculata

Sea Oats

Mulch – 3" depth of shredded "dark brown" hybrid mulch B grade or better at all hedges and mass planting beds.

12"

12" o.c. | Full cont.

1 gal. cont.

GENERAL NOTES

- ^ Indicates plant material native to Florida
- All sod to be Empire Zoysia sod.
- All plant materials shall conform to the standards for Florida No. 1 or better as given in "Grades and Standards for
- Nursery Plants", Latest Edition, State of Florida Department of Agriculture, Tallahassee, or thereto. All trees shall be properly guyed and staked at the time of planting to ensure proper establishment.
- The planting soil for all planting areas shall be composed of a minimum of 30% muck or horticulturally acceptable organic material. The minimum soil depth shall be four inches in all hedges and mass planting beds and ½ cu.yd.per tree. Palms
- to be planted in clean sand. • Three inches minimum of shredded "dark brown" hybrid mulch shall be installed around each tree and palm and throughout mass planting beds, the use of Cypress mulch is strongly discourage.
- Irrigation system to provide 100% coverage to landscaped areas with 100% overlap. Irrigation to be an automatic system with a rain gauge/moisture sensor shut-off.
- In case of discrepancies, planting plan takes precedence over plant list.
- Landscape contractor is responsible for his own quantity take-offs.

LANDSCAPE TABULAR DATA

a. Total paved area 7,493 SF.

b. Required interior green space = $\underline{749}$ SF. (10% of total paved area).

C. Interior green space provided 3,100 SF.

d. Total number of trees required 6 (1 interior tree is required for each 125 sq.ft. of required interior

e. Number of interior trees provided <u>7</u> trees. 2 (6 Key Thatch Plan Double), 1 Wax Pivet. 2 Brazil Beauty-leaf, 2 Macarthur Palm

f. Perimeter green space required 4,885 SF. (depth of buffers x length). North Buffer: $423 LF X 5 = 2{,}115 SF Required. (3,470 SF Provided)$ South Buffer: $432 LF \times 5 = 2,160 SF Required$. (2,770 SF Provided) West Buffer: 122 LF X 5 = 610 SF Required. (970 SF Provided) 4,885 SF. Required

g. Perimeter green space provided 7,210 SF.

h. Number of perimeter trees required 32.6 trees (977 / 30 L.F. = 32.6) i. Number of perimeter trees provided <u>64</u> trees.

North Buffer - 14 Trees Required = 15 Pitch Apple, 8 Coconut Palms South Buffer - 15 Trees Required = 21 Pitch Apple, 23 Coconut Palms. West Buffer - 4 Trees Required = 3 Sylvester Date Palm, 3 Pitch Apple, 4 Japanese Blueberry

XERISCAPE CALCULATIONS

j. Required shrubs and ground covers 1,700 SF (30% of required interior and perimeter green space,

see b &f).

k. Shrubs and ground cover provided 5,090 SF.

I. Required native plant materials <u>425 SF</u> (25% of required shrubs & ground cover, see j).

m. Native plant materials provided 3,570 SF.

n. Number of native trees required <u>19</u> trees (50% of required trees, see d & h)

o. Native trees provided 41 trees.

39 Pitch Apple, 2 Key Thatch Plan Double (6:2)

Tree Diversity Required: 5 Species. Tree Diversity Provided: 8 Species.

landscape architects and planners LC - 0000396 2300 Corporate Blvd. NW. Suite 214

Boca Raton, Florida 33431 Ph: 561.955.8623 Fax: 561.362.4749 email: landscapearchitects@dsboca.com

10-31-2022 Owner Changes OCTOBER 11, 2021 G.C. DRAWN BY: M.J.

06-25-21 GMP

07-08-2021 SRAB Review

07-28-2021 SRAB Commen

08-26-2021 Site Permit

01-21-2022 Site Permit

06-20-2022 Owner Changes

This drawing is the property of Design Studio Boca, and is an instrument of service not to be reproduced in whole or in part without the express written permission of same.

APPROVED BY:

LP-3

GENERAL PLANTING SPECIFICATIONS:

l. Scope:

The work includes furnishing all plants, materials, equipment and labor necessary for planting of plant materials indicated on the drawings and in these specifications. A list of plants is attached to these specifications.

2. Plant Materials & Protection:

A. All plant materials shall be nursery grown unless otherwise noted.

- Spread (or Spr.): Indicates average spread to midpoint of current season's growth. - <u>Height (or O.A.):</u> Indicates overall height from top of ball to midpoint of current

- C.T.: Indicates clear trunk measurement from top of ball to first branching (see tree \$ Palm Planting Diagrams)

- <u>Meter of Wood (or Meter of Hard Grey Wood):</u> Indicates measurement of Palms from top of ball to top of solid trunk before start of frond stalks or green "boots". (See Palm Planting Diagram)

B. <u>Quantities:</u>

All quantities indicated on the plant list are intended as a quide for the bidders and does not relieve the bidder of his responsibility to do a comprehensive plant take off. Should a discrepancy occur between the bidder's take off and the plant list quantity, the Architect/Landscape Architect is to be notified for clarification prior to the submission of bids.

C. Quality and Sizes:

Plants shall have a habit of arouth that is normal for the species and shall be healthu. vigorous and equal or exceed the measurements specified in the plant list, which are the minimum acceptable sizes. Plants shall be measured with branches in normal position. Pruning (Section IV.J.) should not reduce acceptable size and shape of tree, and should be done after acceptance of Architect/Landscape Architect.

Requirements for measurements, branching, grading, quality, balling and burlapping of plants in the plant list generally follow the code of standards currently recommended by the American Association of Nurserymen, Inc., in the American Standard for Nursery Stock. Plant materials shall be graded Fancy No.1 or better as outlined under U.A.E. Grades & Standards for nursery plants. Plants that meet the requirements specified, but do not have the normal balance of height and spread typical for the respective plant, shall not be accepted. All plant material to be healthy, pest and disease free.

D. <u>Substitution:</u>

Plant substitution requests by the Contractor will be considered by the Architect/Landscape Architect only upon submission of proof that any plant is not obtainable in the type or size specified. The Landscape Architect shall determine the nearest equivalent replacement in an obtainable size and variety. The unit price of the substitute item shall not exceed the bid item replaced, without approval of the Owner.

E. <u>Protection of Plants:</u>

I. Root Protection

A. Balled and Burlapped Plants (B \$ B) shall be dug with natural balls of earth of sufficient diameter and depth to encompass the fibrous and feeding root system necessary for full recovery of the plant. Balls shall be firmly wrapped with burlap or similar materials and bound with twine, cord, or wire mesh. All collected plants shall be balled and burlapped.

B. Container Grown Plants: Plants arown in containers will be accepted as B & B, providing that all other specified requirements are met. Container grown plants shall meet plant sizes as specified on the plant list and on the plans, and shall not be governed by container sizes. Minimum root balls or container grown material shall be no more than 25% less proportionately in size than that stated in "Grades \$ Standards" for nursery plants. These plants shall have been grown in the container for a maximum of two years prior to installation and shall exhibit a fully developed root system when removed from the container.

All plant material shall be protected from possible bark injury or breakage of branches. All plants transported by open trucks shall be adequately covered to prevent windburn, drying or damage to plants.

3. Protection After Delivery:

Plants which cannot be planted immediately upon delivery to the site shall be covered with moist soil, mulch, or other protection from the drying of wind and sun. All plants shall be watered as necessary until accepted. Storage period shall not exceed seventy-two (72) hours.

4. Protection of Palms:

Only a minimum of fronds shall be removed from the crown of the palm trees to facilitate moving and handling. Clear trunk (C.T.) shall be as specified after the minimum of fronds have been removed. Coconut palms shall be "hard" trees grown in marl or sand. Cabbage palm buds shall be tied with a biodegradable cord to be left in place until the tree is well established in its new location. All palms shall be triple braced and staked with new, clean lumber at least 6" in length to resist tree

5. Protection During Planting:

Trees moved by winch or crane shall be thoroughly protected from chain marks, girdling or bark slippage by means of other approved methods.

3. Materials:

A. Commercial Fertilizer: Commercial fertilizer shall be organic fertilizer containing nitrogen, phosphoric acid and potash in equal percentages, 6-6-6 with micro nutrients.

Nitrogen shall be not less than 50 % from organic source. Inorganic chemical nitrogen shall not be derived from the sodium form of nitrate. Fertilizers shall be delivered to the site in unopened original containers, each bearing the manufacturer's quaranteed analysis. Any fertilizer that becomes caked or otherwise damaged shall not be

The following shall be sterilized, certified and free of seed:

B. Peat: Peat shall be horticultural peat composed of not less than 60% decomposed organic matter by weight, on an oven dried basin. Peat shall be delivered to the site in a workable condition, free from lumps.

C. Planting Soil:Planting soil for all plantings shall be sandy loam and shall contain a 25% minimum amount of decomposed organic matter. There must be a slight acid reaction to the soil with no excess of calcium carbonate. Planting soil shall be free from clay, stones, plants, roots, and other foreign materials which might be a hindrance to planting operations or be detrimental to good plant growth and shall be delivered in a loose friable condition and applied in accordance with the planting specifications and details.

D. Mulch: Mulch material to be shredded cypress mulch B grade or better, moistened at time of installation to prevent wind displacement. Alternate mulch material may be noted elsewhere in these drawings.

E. Drainage Stone (when applicable): Drainage stone shall be gravel or crushed stone reasonably free of sharp edges - $\frac{1}{2}$ "-1 $\frac{1}{2}$ " in diameter - as required in the bottom of raised planters.

F. Filter Fabric: (when applicable): Filter fabric, as required between gravel and soil in planters to be Dewitt "Filter-fabric" (800)888-9669 or equal.

4. Planting Operations:

A. Soil Preparation:

All existing soil and new fill/berms shall be treated with an approved weed killer such as "Round Up" according to manufacturer's specifications.

Location for plants and outlines of areas to be planted are indicated on the drawings. All plant locations shall be staked in the field by the Contractor, to the satisfaction of the Architect/Landscape Architect. Where construction or utilities below around or overhead are encountered or where changes have been made in the construction, necessary adjustments will be approved by the Architect/Landscape Architect.

C. Excavation for Planting:

Excavation of holes shall extend to the required sub-grades as specified hereunder. Plant pits shall be circular in outline and shall have a profile which conforms to the "Typical Tree & Palm Planting Details" (attached). The minimum depth of plant pits specified below shall be measured from the finishing grade. Shrub planting beds shall be "bed-prepared" and not "pit-prepared".

Balled and Burlapped Plants:

After final setting, loosen wrappings of balled and burlapped plants and roll wrappings back from top of ball, leaving ball unbroken. Cut off excessive amounts of burlap and remove in sufficient quantity to eliminate creation of voids upon decomposition.

E. <u>Container Grown Plants:</u>

Container grown plants shall, when delivered, have sufficient root growth to hold earth intact when removed from container. They shall not be root bound. Containers shall be removed to prevent damage to plant or root system according to diagrams (attached). Plant bits for container materials shall be formed flat on the bottom to avoid air pockets at the bottom of root balls.

F. Pit Sizes:

Minimum diameter (Width) and depth of planting pits for balled and burlapped, and container grown plants shall be as follows:

-Diameter-Trees: 18" greater than diameter of ball or spread of roots.

-Diameter-Shrubs: 6" greater than diameter of ball or spread of roots. -Depth-Trees and Shrubs: 4" greater than depth of ball or roots to provide 4" of topsoil backfill under the root ball. (Large, heavy trees and shrubs shall sit directly on excavated pit bottom to prevent settlement) -Depth-Vine's and Ground Covers: Pits shall be large enough for adequate planting.

<u>Backfilling:</u>

When pit has been excavated as specified in Paragraph IV-C, the pit shall be backfilled with material as specified in Paragraph III. A, B, C, D, and IV. B and shown in the Typical Tree and Shrub diagrams (attached).

H. <u>Setting Trees and Shrubs:</u>

Unless otherwise specified, all trees and shrubs shall be planted in pits, centered and set on four inches (4") of compacted topsoil to such depths that the finished grade level of the plant after settlement shall be the same as that at which the plant was grown. They shall be planted upright and faced to give the best appearance or relationship to adjacent structures. No burlap shall be pulled out from under the balls. Platforms, wire and surplus binding from top and sides of the balls shall be removed. All broken or frayed roots shall be cut off cleanly. Soil shall be placed and compacted thoroughly avoiding injury and shall be settled by watering. No filling around trunks will be permitted. After the ground settles, additional soil shall be filled in, to the level of the finished grade, allowing for two inches (2") of mulch. Form a shallow saucer around each plant by placing a ridge of soil along the edge of the plant pit.

Setting Palms:

All palms shall be planted in sand, thoroughly washed in during planting operations and with a shallow saucer depression left at the soil line forfuture waterings. Saucer areas shall be top-dressed two inches (2") deep with topsoil raked and left in a neat, clean

<u> Pruning - New Plant Material:</u>

Remove dead and broken branches from all plant material. Prune to retain typical growth habit of individual plants with as much height and spread as is practicable. Make all cuts with sharp instrument flush with trunk or adjacent branch, in such a manner as to insure elimination of stubs. "Headback" cuts at right angles to line of growth will not be permitted. Trees shall not be poled or topped. Remove trimmings from site.

(See "Tupical Tree Planting Diagram" included herein.) Guy all trees 11/2 inches in caliber and areater, in three directions with two strands of No. 12 galvanized wire attached to approved anchors driven below grade. When securing wires to trees, cover all wires which may come in contact with any part of tree with new rubber hose. Place quys not less than 1/3 of the height of tree above finished grade and above substantial limbs (one inch [I"] in diameter or more), if possible. All hoses shall be interlocked around tree trunk. Place anchors so that guys are equally spaced and at 45 degree angles to horizon. Keep guys tight until project completion.

All trees and shrub beds shall be mulched immediately after planting to a Three inch (3") depth. Prevent wind displacement of mulch by thoroughly wetting down.

Excess excavated soil shall be disposed of by the Contractor at no additional expense to the Owner, at Owner's discretion.

Relocated Material (when applicable):

Existing material shown on the plan to be relocated shall be root-pruned as far ahead of time as necessary to move them safely, and shall be protected and treated as new material, as previously specified. Planting shall be in accord with these specifications.

O. <u>Disposition of Existing Material:</u>

All existing plant material not shown as remaining or relocated shall be removed from the site at no additional cost to the Owner, at Owner's discretion.

<u>5. Sod</u>

The Landscape Contractor shall submit a unit price per cubic yard for the supply and distribution of planting soil as herein before specified, to be applied at a depth of one inch (I"), to all areas receiving sod. (The use of this one inch (I") of soil shall be at the discretion of the Architect/Landscape Architect after evaluation of the existing soil on the site.)

It shall be the responsibility of the Landscape Contractor to finish (fine) grade all landscape areas, eliminating all bumps, depressions, sticks, stones and other debris to the satisfaction of the Architect/Landscape Architect

C. The sod shall be as called for on the landscape plans. Sod shall be of firm tough texture, having a compact growth of grass with good root development, and shall contain no weeds or any other objectionable vegetation. The soil embedded in the sod shall be good earth, free from stones and debris and all sod shall be free from fungus, vermin and other diseases.

D. Before being cut and lifted, the sod shall have been moved at least three times with a lawn mower, with the final mowing not more than seven days before the sod is cut. The sod shall be carefully cut into uniform dimensions.

E. Solid sod shall be laid with closely abutting joints with a tamped or rolled, even surface. It shall be the responsibility of the Contractor to bring the sod edge in a neat, clean manner to the edge of all paving and shrub areas. If, in the opinion of the Architect/Landscape Architect, top-dressing is necessary after rolling, clean sand will be evenly applied over the entire surface and thoroughly washed in.

<u>6. Clean-up:</u>

Any soil, peat or similar material which has been brought onto any paved areas shall be removed promptly keeping these areas clean as the work progresses. Upon completion of the planting, all excess soil, stones and debris which has not been previously cleaned up shall be removed from the site or disposed of as directed by the Architect/Landscape Architect.

7. Maintenance:

Maintenance shall begin immediately after each plant is planted and shall continue until all planting has passed final inspection and acceptance by the Owner. Maintenance shall include watering, weeding, cultivating, removal of dead materials, resetting plants to proper grades or upright position and restoration of the planting saucer and any other necessary operations. Proper protection to lawn areas and existing plant materials shall be provided and any damage resulting from planting operations shall be repaired promptly.

The Contractor shall deep-water all trees and shrubs for a period of ninety (90) days after planting. In the event an irrigation system is operable, Contractor shall see that adequate water is supplied for that period.

8. Inspection and Acceptance:

Inspection of work to determine completion of contact, exclusive of the possible replacement of plants, will be made by the Owner and/or Landscape Architect at the conclusion of all planting and at the written request of the Contractor.

<u>Acceptance:</u>

After inspection, the Contractor will be notified by the Owner of the acceptance of all plant material and workmanship, exclusive of the possible replacement of plants subject to quarantee.

9. Guarantee and Replacement:

The Contractor shall furnish a written avarantee warrantina all materials, workmanship and plant materials, except sod for a period of ONE YEAR from the time of final acceptance by the Owner. All plan materials shall be alive and in satisfactory condition and growth for each specific kind of plant at the end of quarantee period. Where vandalism is agreed by the Architect/Landscape Árchitect as the cause for replacement, the Contractor shall not be responsible for replacement during the one-year quarantee after final acceptance. Sod shall be avaranteed for a THREE MONTH period, dating from the time of acceptance.

Replacement:

During quarantee period, any plant required under this contract that is dead or not in satisfactory condition, as determined by the Architect/Landscape Architect, shall be replaced within two weeks of notification by the Architect/Landscape Architect. The Contractor shall be responsible for the full replacement cost of plant materials.

<u>Material and Operations:</u>

All replacements shall be plants of the same kind and size as specified in the plant list. They shall be furnished and planted as specified herein.

10. Care and Maintenance Schedule:

A. The Contractor shall furnish the Owner's Maintenance staff with a written and detailed description for the care and maintenance of all plant materials and irrigation systems at the time of final inspection. Contractor will also provide a one year Landscape Maintenance Contract, to take affect affect after Substantial Completion of the project. It will be in the Owner's discretion to accept or reject this contract.

Permits and Regulations:

A. The Contractor shall give all notices and comply with all laws, ordinances, rules and regulations bearing on the conduct of this work as drawn and specified.

12. Protection of Work and Property:

- A. The Contractor shall continuously maintain adequate protection of all his work from damage and theft and shall protect the Owner's property from injury and loss arising in connection with this contract, making good any such loss or injury or damage except where caused by Owner or his agents. He shall adequately provide and maintain passageways, quard fences, lights and other protections required by public authority according to State, Federal and local ordinances.
- B. The Contractor shall provide protection for existing trees and other plant material as designated by drawings, by Owner's representative or by local authorities. Such protection shall consist of fencing or such devices as will prevent harm to material from excavation, breakage, chemical or other types of damage.
- C. A competent superintendent, foreman or workman capable of reading drawings and acting on behalf of the Contractor shall be kept on the work during its

13. Changes In The Work:

- A. The Contractor shall conduct a soil survey of the site to determine the need for any additives to overcome severe conditions not met by normal planting soil requirements. A report of any problems shall be submitted to the Owner and the Architect/Landscape Architect for approval prior to installation, along with a cost break-down of additional services needed.
- B. The Contractor shall advise the Owner and Landscape Architect of any special site conditions (high water table, light or soil conditions, etc.) that might require change of plant material or adjustment to finish elevation shown. The Owner will approve any changes thus determined.


14. Landscape Architect:

A. The Landscape Architect is the author of the design and agents for its execution. When his services are used by the Owner for supervision, he shall act impartially between the Owner and Contractor and shall have authority to reject all work and materials which do not conform to the contract. All decisions of the Landscape Architect shall be final.


The Contractor shall remove from the site all materials considered not up to specifications by the Landscape Architect and replace with suitable materials.

<u>15. Obstructions:</u>


A. The Contractor shall acquaint himself with the existence and location of all surface and subsurface structures, utilities and installations before commencing any work, and shall avoid any disturbance or damage to them throughout the course of the work. Repairs to any utilities, subsurface structures and installations and surface obstructions damaged by the Contractor shall be at the Contractor's own time and expense.

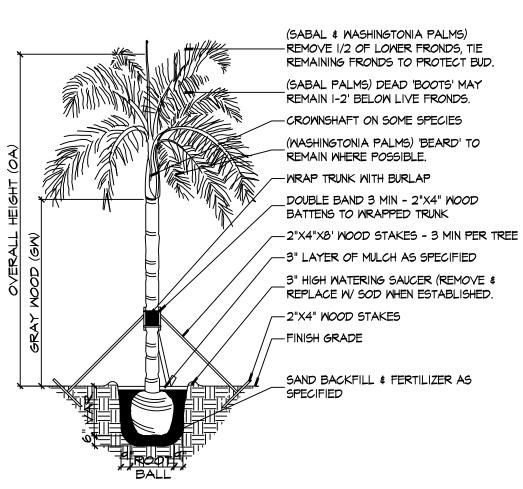

TYPICAL PALM PLANTING DETAIL

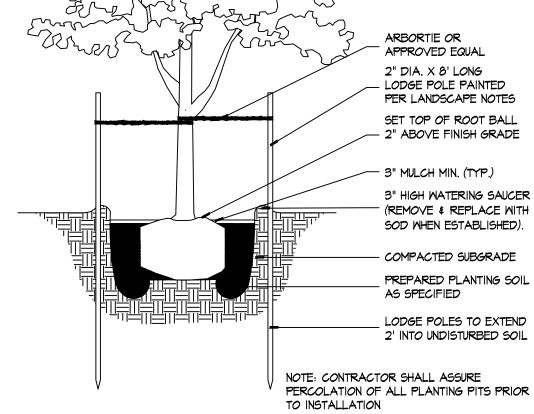


SMALL TREE PLANTING DETAIL

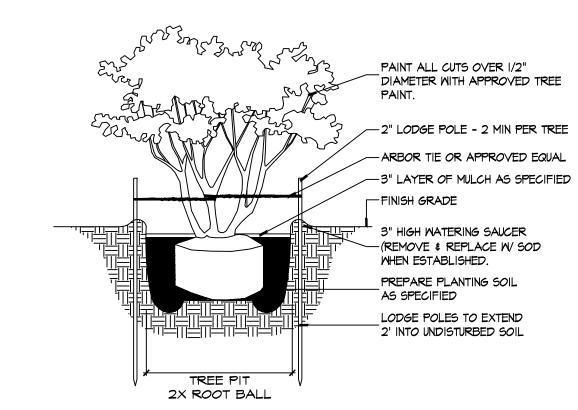

MULTI TRUNK TREE PLANTING DETAIL

TYPICAL SHRUB PLANTING DETAIL

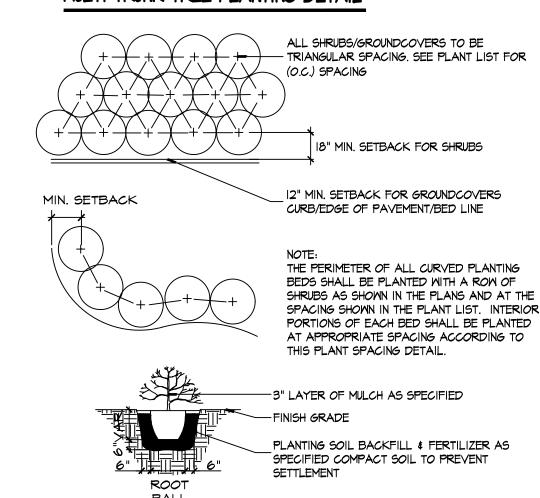

landscape architects and planners

LC - 0000396 2300 Corporate Blvd. NW. Suite 214 Boca Raton, Florida 33431 Ph: 561.955.8623

Fax: 561.362.4749 email: landscapearchitects@dsboca.com

9

04-01-2021 Building comments Courtyard Design 06-25-21 GMP


OCTOBER 11, 2021

DRAWN BY: M.J. APPROVED BY:

G.C.

This drawing is the property of instrument of service not to be reproduced in whole or in part without the express written permission of same.

LP-4

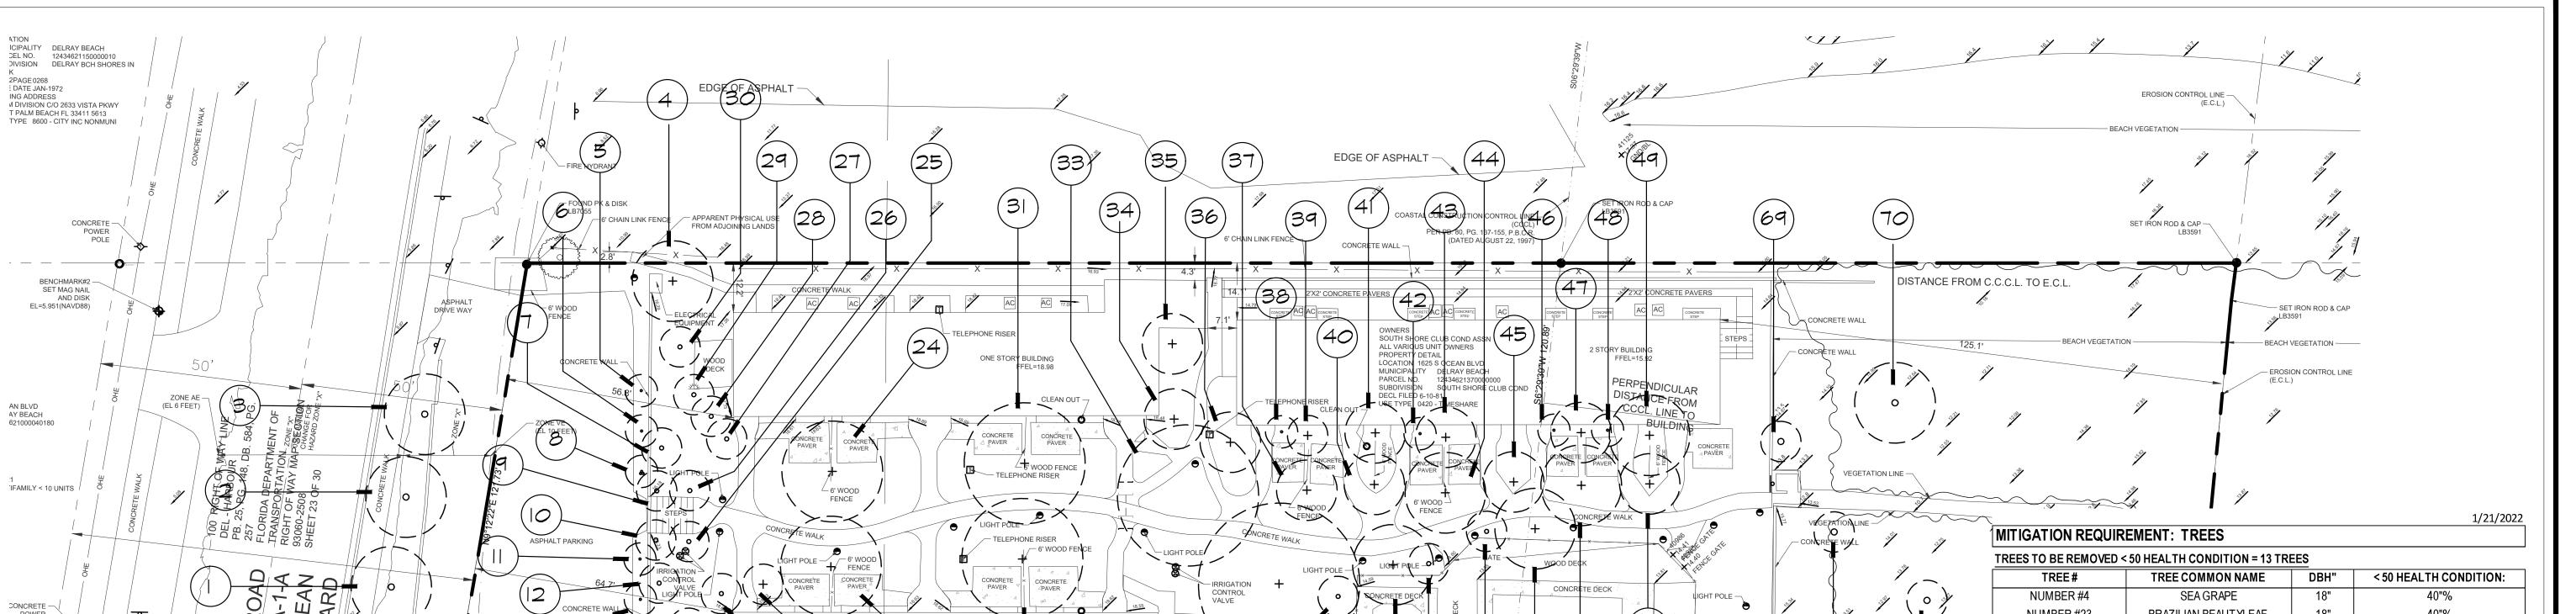

5' PVC FENCE

PB.79, PG. 70

MUNICIPALITY DELRAY BEACH
PARCEL NO. 12434621660000020
SUBDIVISION DELRAY OCEAN ESTATES
BOOK 29261 PAGE 242

APPLEGATE MICHELLE APPLEGATE RICHARD &

PROPERTY DETAIL LOCATION 1705 S OCEAN BLVD

USE TYPE 0100 - SINGLE FAMILY

(1	/-
SCA	LE: 1"	= 20'

SEWER MANHOLE -

T MAG NAIL AND DISK 85(NAVD88)

	7/2/2021		1625 S. Oce	an Blvd. Delr	ay Beach, Fl	_			
Tree #	Common Name	Scientific Name	Height	Spread	DBH	Health Condition	Health Rating %	Comments	Disposition
1	Coconut Palm	Cocos nucifera	20' gw	NA		Good	85%	K deficient	REMOVE
2	Coconut Palm	Cocos nucifera	15' gw	NA		Good	85%		REMOVE
3	Coconut Palm	Cocos nucifera	15' gw	NA		Good	90%		REMOVE
4	Sea Grape	Coccoloba uvifera	15'	20'	26"	Poor	40%	Codom @ 8"	REMOVE
5	Christmas Palm	Adonidia merrillii	8'	NA		Fair	7 5%	low trunk wounding	REMOVE
6	Christmas Palm	Adonidia merrillii	8'	NA		Fair	75%	low trunk wounding	REMOVE
7	Sabal Palm	Sabal palmetto	20'	NA		Good	85%	Relo candidate	REMOVE
8	Christmas Palm	Adonidia merrillii	8'	NA		Fair	70%	Triple	REMOVE
9	Sabal Palm	Sabal palmetto	15'	NA		Good	85%	Relo candidate	REMOVE
10	Sabal Palm	Sabal palmetto	20'	NA		Good	85%	Relo candidate	REMOVE
11	Christmas Palm	Adonidia merrillii	8'	NA		Fair	75%	low trunk wounding	REMOVE
12	Sabal Palm	Sabal palmetto	20'	NA		Good	85%	Relo candidate	REMOVE
13	Christmas Palm	Adonidia merrillii	8'	NA		Fair	75%	low trunk wounding	REMOVE
14	Christmas Palm	Adonidia merrillii	8'	NA		Fair	75%	low trunk wounding	REMOVE
15	Christmas Palm	Adonidia merrillii	14'	NA		Fair	75%	low trunk wounding	REMOVE
16	Sabal Palm	Sabal palmetto	20'	NA		Good	85%	Relo candidate	REMOVE
17	Sabal Palm	Sabal palmetto	20'	NA		Good	85%	Relo candidate	REMOVE
18	Sabal Palm	Sabal palmetto	10'	NA		Good	85%	Relo candidate	REMOVE
19	Sabal Palm	Sabal palmetto	20'	NA		Good	85%	Relo candidate	REMOVE
20	Sabal Palm	Sabal palmetto	20'	NA		Good	85%	Relo candidate	REMOVE
21	Sabal Palm	Sabal palmetto	20'	NA		Good	85%	Relo candidate	REMOVE
22	Jatropha Tree	Jatropha integerrima	10'	10'	6"	Fair	80%	Multi-trunk	REMOVE
23	Brazilian Beautyleaf	Calophyllum brasiliense	20'	25'	24"	Poor	40%	co-dom; cavaties	REMOVE
24	Brazilian Beautyleaf	Calophyllum brasiliense	15'	25'	32"	Poor	40%	co-dom; cavities	REMOVE
25	Sabal Palm	Sabal palmetto	15'	NA		Good	85%	Relo candidate	REMOVE
26	Sabal Palm	Sabal palmetto	15'	NA		Good	85%	Relo candidate	REMOVE
27	Sabal Palm	Sabal palmetto	15'	NA		Good	85%	Relo candidate	REMOVE
28	Sabal Palm	Sabal palmetto	20'	NA		Good	85%	Relo candidate	REMOVE
29	Sabal Palm	Sabal palmetto	15'	NA		Good	85%	Relo candidate	REMOVE
30	Sabal Palm	Sabal palmetto	15'	NA		Good	85%	Relo candidate	REMOVE
31	Brazilian Beautyleaf	Calophyllum brasiliense	15'	30'	36"	Poor	40%		REMOVE
32	Brazilian Beautyleaf	Calophyllum brasiliense	15'	30'	36"	Poor	40%		REMOVE
33	Brazilian Beautyleaf	Calophyllum brasiliense	35'	35'	36"	Fair-Poor	60%	Multi-trunk	REMOVE
34	Brazilian Beautyleaf	Calophyllum brasiliense	15'	15'	12"	Fair	65%		REMOVE
35	Gumbo Limbo	Bursera simarouba	15'	15'	12"	Good-Fair	75%		REMOVE
Tree #	Common Name	Scientific Name	Height	Spread	DBH	Health Condition	Health Rating %	Comments	Disposition

- 5' LIMITED ACCESS EASEMENT PB. 79, PG. 70

LAGUNA MZRYI

PROPERTY DETAIL LOCATION 1701 S OCEAN BLVD MUNICIPALITY DELRAY BEACH

PARCEL NO. 12434621660000010 SUBDIVISION DELRAY OCEAN ESTATES BOOK 24867 PAGE 921

Tree #	Common Name	Scientific Name	Height	Spread	DBH	Health Condition	Health Rating %	Comments	Disposition
36	Brazilian Beautyleaf	Calophyllum brasiliense	15'	15'	12"	Poor	50%	Leaning	REMOVE
37	Brazilian Beautyleaf	Calophyllum brasiliense	15'	15'	32"	Poor	40%	Co-dom	REMOVE
38	Ponytail Palm	Beaucarnea recurvata	15'	NA		Good	75%		REMOVE
39	Brazilian Beautyleaf	Calophyllum brasiliense	15'	10'	10"	Poor	50%	Leaning	REMOVE
40	Brazilian Beautyleaf	Calophyllum brasiliense	15'	15'	18"	Poor	40%	Multi-trunk	REMOVE
41	Brazilian Beautyleaf	Calophyllum brasiliense	15'	15'	18"	Poor	40%	Multi-trunk	REMOVE
42	Ponytail Palm	Beaucarnea recurvata	18'	NA		Good	75%		REMOVE
43	Brazilian Beautyleaf	Calophyllum brasiliense	15'	15'	12"	Poor	50%		REMOVE
44	Brazilian Beautyleaf	Calophyllum brasiliense	20'	20'	12"	Poor	50%		REMOVE
45	Brazilian Beautyleaf	Calophyllum brasiliense	15'	15'	12"	Fair	65%		REMOVE
46	Ponytail Palm	Beaucarnea recurvata	15'	NA		Poor	50%		REMOVE
47	Brazilian Beautyleaf	Calophyllum brasiliense	15'	15'	24"	Poor	40%	Multi-trunk	REMOVE
48	Ponytail Palm	Beaucarnea recurvata	10'	NA		Fair	65%		REMOVE
49	Brazilian Beautyleaf	Calophyllum brasiliense	25'	20'	14"	Poor	40%		REMOVE
50	Brazilian Beautyleaf	Calophyllum brasiliense	15'	15'	12"	Poor	50%		REMOVE
51	Brazilian Beautyleaf	Calophyllum brasiliense	15'	20'	21"	Poor	40%		REMOVE
52	Brazilian Beautyleaf	Calophyllum brasiliense	15'	20'	36"	Poor	40%	Multi-trunk; trunk crack	REMOVE
53	Sabal Palm	Sabal palmetto	20'	NA		Good	85%		REMOVE
54	Sabal Palm	Sabal palmetto	25'	NA		Good	85%	Relo candidate	REMOVE
55	Brazilian Beautyleaf	Calophyllum brasiliense	15'	20'	24"	Fair	65%		REMOVE
56	Sabal Palm	Sabal palmetto	25'	NA		Good	85%	Relo candidate	REMOVE
57	Sabal Palm	Sabal palmetto	20'	NA		Good	85%	Relo candidate	REMOVE
58	Brazilian Beautyleaf	Calophyllum brasiliense	15'	40'	36"	Poor	40%	Multi-trunk	REMOVE
59	Areca Palm	Dypsis lutescens	20'	NA		Good	75%		REMOVE
60	Areca Palm	Dypsis lutescens	20'	NA		Good	75%		REMOVE
61	Areca Palm	Dypsis lutescens	20'	NA		Good	75%		REMOVE
62	Areca Palm	Dypsis lutescens	20'	NA		Good	75%		REMOVE
63	Areca Palm	Dypsis lutescens	15'	NA		Fair	65%	Stunted	REMOVE
64	Areca Palm	Dypsis lutescens	15'	NA		Fair	65%	Stunted	REMOVE
65	Areca Palm	Dypsis lutescens	15'	NA		Fair	65%	Stunted	REMOVE
66	Areca Palm	Dypsis lutescens	15'	NA		Fair	65%	Stunted	REMOVE
67	Sabal Palm	Sabal palmetto	8'	NA		Good	85%	in beach dune	REMOVE
68	Sabal Palm	Sabal palmetto	15'	NA		Good	85%	in beach dune	REMOVE
69	Sabal Palm	Sabal palmetto	10'	NA		Good	85%	in beach dune	REMOVE
70	Coconut Palm	Cocos nucifera	20'	NA		Good	90%	in beach dune	REMOVE

Internationa Society of Arboriculture #5495A Landscape Inspectors Association of Florida #2007-0039 Certified Pest Control Operator JF4420

American Society of Consulting Arborists RCA #646 Internationa Society of Arboriculture FL-0762A Landscape Inspectors Association of Florida #2007-007

FOUND IRON ROD

CONCRETE DECK

84.7' TIE TO C.C.C.L

PERPENDICULAR

DISTANCE FROM CCCL. LINE TO

BUILDING

	TREES TO BE REMOVED < 50 HEALTH CONDITION = 13 TREES							
	TREE#	TREE COMMON NAME	DBH"	< 50 HEALTH CONDITION:				
	NUMBER #4	SEA GRAPE	18"	40"%				
	NUMBER #23	BRAZILIAN BEAUTYLEAF	18"	40"%				
	NUMBER #24	BRAZILIAN BEAUTYLEAF	12"	40"%				
	NUMBER #31	BRAZILIAN BEAUTYLEAF	12"	40"%				
	NUMBER #32	BRAZILIAN BEAUTYLEAF	12"	40"%				
	NUMBER #37	BRAZILIAN BEAUTYLEAF	10"	40"%				
	NUMBER #40	BRAZILIAN BEAUTYLEAF	12"	40"%				
L.	NUMBER #41	BRAZILIAN BEAUTYLEAF	12"	40"%				
	NUMBER #47	BRAZILIAN BEAUTYLEAF	12"	40"%				
T	NUMBER #49	BRAZILIAN BEAUTYLEAF	12"	40"%				
	NUMBER #51	BRAZILIAN BEAUTYLEAF	24"	40"%				
	NUMBER #52	BRAZILIAN BEAUTYLEAF	24"	40"%				
	NUMBER #58	BRAZILIAN BEAUTYLEAF	24"	40"%				

PROPOSED TREES FOR MITIGATION (USING A TREE PER TREE REPLACEMENT **TOTAL = 13 PITCH APPLE TREE**

TREES TO BE REMOVED > 50 HEALTH CONDITION = 11 TREES									
TREE#	TREE COMMON NAME	DBH"	> 50 HEALTH CONDITION:						
NUMBER #22	JAT ROPHA T REE	6"	80%						
NUMBER #33	BRAZILIAN BEAUTYLEAF	36"	60%						
NUMBER #34	BRAZILIAN BEAUTYLEAF	12"	65%						
NUMBER #35	GUMBO LIMBO	12"	75%						
NUMBER #36	BRAZILIAN BEAUTYLEAF	12"	50%						
NUMBER #39	BRAZILIAN BEAUTYLEAF	10"	50%						
NUMBER #43	BRAZILIAN BEAUTYLEAF	12"	50%						
NUMBER #44	BRAZILIAN BEAUTYLEAF	12"	50%						
NUMBER #45	BRAZILIAN BEAUTYLEAF	12"	65%						
NUMBER #50	BRAZILIAN BEAUTYLEAF	12"	50%						
NUMBER #55	BRAZILIAN BEAUTYLEAF	24"	65%						

TOTAL = 160" CALIPER REMOVED

PROPOSED TREES FOR MITIGATION (USING INCH FOR INCH REPLACEMENT):

4 JAPANESE BLUBERRY 2" CAL. = 8" 37 PITCH APPLE 4" CAL. = 148" 1 WAX PIVET 3" CAL. = 3" 2 BRAZIL BEAUTY-LEAF 3" CAL. = 6"

TOTAL = 165" CALIPER PROPOSED (*) INCHES USED OVER MINIMUN 2" REQUIREMENT

CALIPER OF TREE TO BE REPLACED USING A PAYMENT IN-LIEU

= 160" CAL. REMOVED - 90" CAL. PROPOSED (21 PITCH APPLE + 3 LUSTER HOLLY PROPOSED TREE) TOTAL = 70" CALIPER (SEE CODE SEC. 4.6.19) \$ 63,300.00

MITIGATION REQUIREMENT: PALMS

PALMS TO BE REMOVED = 46 TREES (All Palms > 50% Health Condition)

PALMS TO BE REMOVED: 7 (CHRIST MAS PALM) 4 (COCONUT PALM) 23 (SABAL PALM) 4 (PONYTAIL PALM) 8 (ARECA PALM) TOTAL = 46 PALMS REMOVED

PROPOSED PALM-FOR-MITIGATION: 3 SYLVESTER DATE PALM (12' C.T.) (16'HT.) 24 COCONUT PALM, 9 KEYTHATCH PALM DOUBLE (16'HT.) 3 KEYTHATCH PALM TRIPLE (16'HT.) 2 MACARTHUR PALM (20 - 24 'HT. TOTAL = 41 PALMS PROPOSED

PALMS TO BE REPLACED USING A PAYMENT IN-LIEU

46 PALMS REMOVED - 34 PALMS PROPOSED = TOTAL = 7 PALMS (PER PREVIOUS PROJECTS) \$ 2,800.00



landscape architects and planners

LC - 0000396 2300 Corporate Blvd. NW. Suite 214 Boca Raton, Florida 33431 Ph: 561.955.8623 Fax: 561.362.4749

email: landscapearchitects@dsboca.com

TRE

04-01-2021 Building comments / 06-25-21 GMP 08-26-2021 Site Permit 01-21-2022 Site Permit

OCTOBER 11, 2021

G.C. DRAWN BY: M.J.

APPROVED BY:

This drawing is the property of Design Studio Boca, and is an instrument of service not to be reproduced in whole or in part without the express written permission of same.