

CITY OF DELRAY BEACH 100 N.W. 1st AVENUE, DELRAY BEACH, FL 33444

Solicitation Addendum

Addendum No.: 8

Solicitation No.: 2019-022

Project No.: 16-098

Solicitation Title: City Marina Construction

Addendum Date: March 27, 2019

Purchasing Contact: Ryan Lingholm, LingholmR@mydelraybeach.com

THIS ITBC IS HEREBY AMENDED AS SET FORTH HEREIN BELOW. THIS ADDENDUM NO. 8 IS HEREBY INCORPORATED IN AND MADE A PART OF ITBC NO. 2019-022.

ADD:

SECTION 2.7 PERMITTING

City permit fees shall be waived for this project. Additionally, Army Core of Engineers (ACOE) and Palm Beach County Health Department (PBCHD) permits have already been paid for by the City. Therefore, the awarded Bidder should not be responsible for any permit fees for this project.

REPLACE:

Exhibit A Drawings, Sheet Nos. C 1.0 and C 2.0

Sheet Nos. C 1.0 and C 2.0 are hereby replaced in their entirety with the attached revised Sheet Nos. C 1.0 and C 2.0. Revisions to these sheets are noted utilizing dotted line boxes.

REPLACE:

Exhibit A Drawings, Sheet No. C 3.0

Sheet No. C 3.0 is hereby replaced in its entirety with the attached revised Sheet No. C 3.0. Revisions to this sheet are noted utilizing a revision cloud.

REPLACE:

Exhibit A Drawings, Sheet No. C 4.1

Sheet No. C 4.1 is hereby replaced in its entirety with the attached revised Sheet No. C 4.1. Revisions to this sheet are noted utilizing a revision cloud.

REPLACE:

Exhibit A Drawings, Sheet No. G 5.0

Sheet No. G 5.0 is hereby replaced in its entirety with the attached revised Sheet No. G 5.0. Revisions to this sheet are noted utilizing dotted line boxes.

REPLACE:

Exhibit A Drawings, Sheet No. S4.2

Sheet No. S4.2 is hereby replaced in its entirety with the attached revised Sheet No. S4.2. Revisions to this sheet are noted utilizing a revision cloud.


NOTE: Items that are struck through are deleted. Items that are <u>underlined</u> have been added. All other terms and conditions remain as stated in this solicitation.

End of Addendum

INSTRUCTIONS:

Receipt of this addendum must be acknowledged as instructed in the solicitation document. Failure to acknowledge receipt of this Addendum may result in the disqualification of Bidder's response.



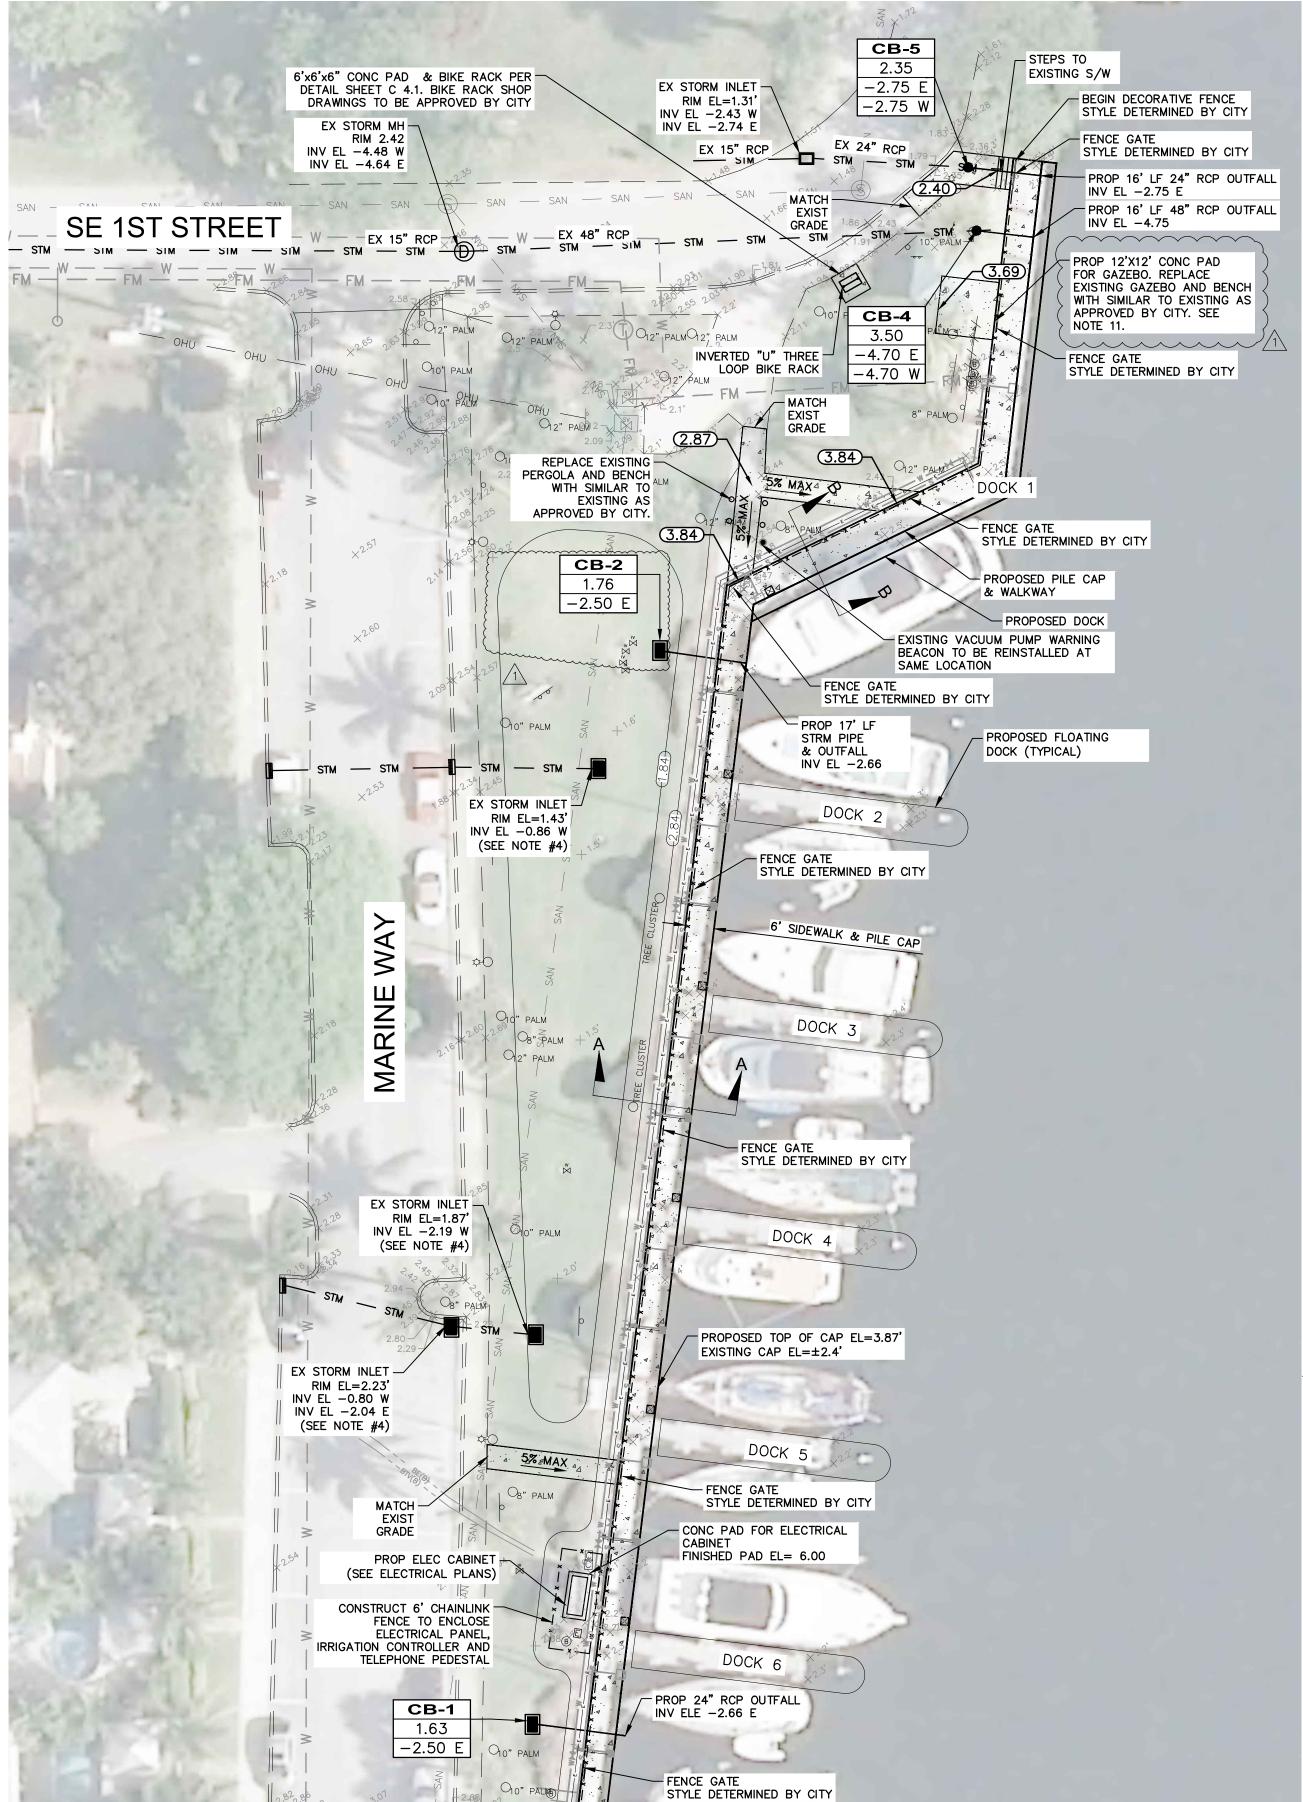

LEGEND

PROPOSED FILL

FLOW DIRECTION

CATCH BASIN

CONCRETE PAVEMENT

FINISHED GROUND ELEVATION

EXISTING GROUND ELEVATION




North


10


SCALE IN FEET

(17.45)

~~>

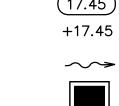

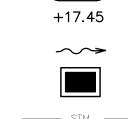

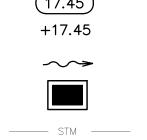

— — W —

----- SAN -----

— — FM —

EXISTING WATER MAIN EXISTING GRAVITY SEWER EXISTING FORCE MAIN

EXISTING DRAINAGE PIPE

EXISTING BURIED ELECTRIC EXISTING BURIED CATV

DRAINAGE PIPE PROPOSED WATER MAIN PROPOSED SANITARY SEWER



NOTES

- 1. WASTOP INLINE CHECK VALVE, OR APPROVED EQUAL, TO BE INSTALLED AT ALL STORM OUTFALLS TO INTRACOASTAL.
- 2. THE ANNULAR SPACE BETWEEN THE SEAWALL AND ANY SEAWALL PROTRUSION SHALL BE SEALED WITH LINK-SEAL AS APPROVED BY THE CITY AND ENGINEER.
- 3. PROPOSED WALKWAYS TO BE ADA COMPLIANT; 5% MAX LONGITUDINAL SLOPE 2% MAX CROSS SLOPE.
- 4. PROPOSED GRATES SHALL BE FIBERGLASS, ALUMINUM(WITH BOND BREAKER). OR APPROVED EQUAL. GRATES OF ALL EXISTING DITCH BOTTOM INLETS TO REMAIN SHALL BE REPLACED WITH SAME MATERIAL AS PROPOSED INLETS
- 5. STORM STRUCTURES SHALL RECEIVE BITUMINOUS EXTERIOR COATINGS IN COMPLIANCE WITH FDOT SECTIONS 459 AND 916.
- 6. CONTRACTOR SHALL PROVIDED SIGNED & SEALED STRUCTURAL PLANS AND CALCULATIONS FOR GAZEBOS AND PERGOLA CONFORMING WITH LATEST FLORIDA BUILDING CODE AND DESIGNED TO WITHSTAND MINIMUM 180MPH WIND SPEED. GAZEBO SHALL HAVE STANDING SEAM METAL ROOF.
- 7. BMP SNOUT SHALL BE INSTALLED WITH HARDWARE ALLOWING WASTOP INLINE CHECK VALVES TO BE REMOVED/SERVICED.
- 8. ALL STEPS SHALL HAVE UNIFORM RISER HEIGHTS AND UNIFORM TREAD DEPTHS. RISERS SHALL BE MIN. 4" & 7" MAX. HEIGHT. TREAD DEPTH SHALL BE 11" MIN.
- 9. SEE SHEET C 2.0 FOR SECTIONS.
- 10. PROPOSED FILL SHALL BE CLEAN AND FREE OF DELETERIOUS MATERIAL AND BE OF SIMILAR COMPOSITION AS ADJACENT SOIL. CONTRACTOR SHALL SUBMIT SPECIFICATIONS FOR SOIL BROUGHT FROM OFFSITE TO BE APPROVED BY ENGINEER PRIOR TO INSTALLATION. SOIL SHALL BE SUITABLE FOR PROPOSEI LANDSCAPING AND SHALL MEET STRUCTURAL PROPERTIES WHERE REQUIRED
- CONTRACTOR SHALL PROVIDED SIGNED & SEALED STRUCTURAL PLANS AND CALCULATIONS FOR GAZEBOS AND PERGOLA CONFORMING WITH FLORIDA BUILDING CODE, 2017 EDITION, AND DESIGNED TO WITHSTAND MINIMUM 180MPH WIND SPEED. GAZEBO SHALL HAVE STANDING SEAM METAL ROOF. CONTRACTOR SHALL OBTAIN HISTORIC PRESERVATION BOARD APPROVAL,
- 12. MANATEE GRATES SHALL BE INSTALLED AT ALL SEAWALL OUTFALLS. SEE SHEET S4.2 FOR DETAIL.

DRAINAGE STRUCTURES											
STRUCTURE	DOWNSTREAM PIPE Ø	STRUCTURE BOTTOM	BOTTOM EL	FDOT INDEX							
CB-1	24"	30R	24"X36" GRATE	60" TYPE J ROUND	-5.50	200					
CB-2	24"	30R	24"X36" GRATE	60" TYPE J ROUND	-5.50	200					
CB-3	24"	30R	24"X36" GRATE	60" TYPE J ROUND	-5.50	200					
CB-4	48"	72RTB96	5' Ø MANHOLE	96" TYPE J ROUND	-8.20	200					
CB-5	24"	30R	5' Ø MANHOLE	60" TYPE J ROUND	-5.75	200					



SEE THIS SHEET FOR CONTINUATION



Phone: (561) 243-7322 Fax: (561) 243-7060 www.mydelraybeach.com



ENGINEER'S SEAL	DESIGNED BY	CAC
LINOHNLLIN J JLAL	DRAWN BY	CAC
	CHECKED BY	TEM
	QC BY	SJC
THOMAS MUELLER, PE		
P.E., LIC. NO. 58119	DATE	3/27/2019

	DESIGNED BY	CAC	\bigcirc	3-27-19	REMOV OF EX CB & PIPE. STRUCTURAL CLARIFICAT		
-	DRAWN BY	CAC					
	CHECKED BY	TEM					
	QC BY	SJC					
Ξ							
	DATE	3/27/2019	REVISION	DATE	DESCRIPTION	BY	


THE CITY OF DELRAY BEACH CITY MARINA: SEAWALL, DOCK, AND SITE IMPROVEMENTS


GRADING & DRAINAGE PLAN


PROJECT NO. 16-098 SHEET NO.

FILE ID. 1004.33


C 1.0 OF 36

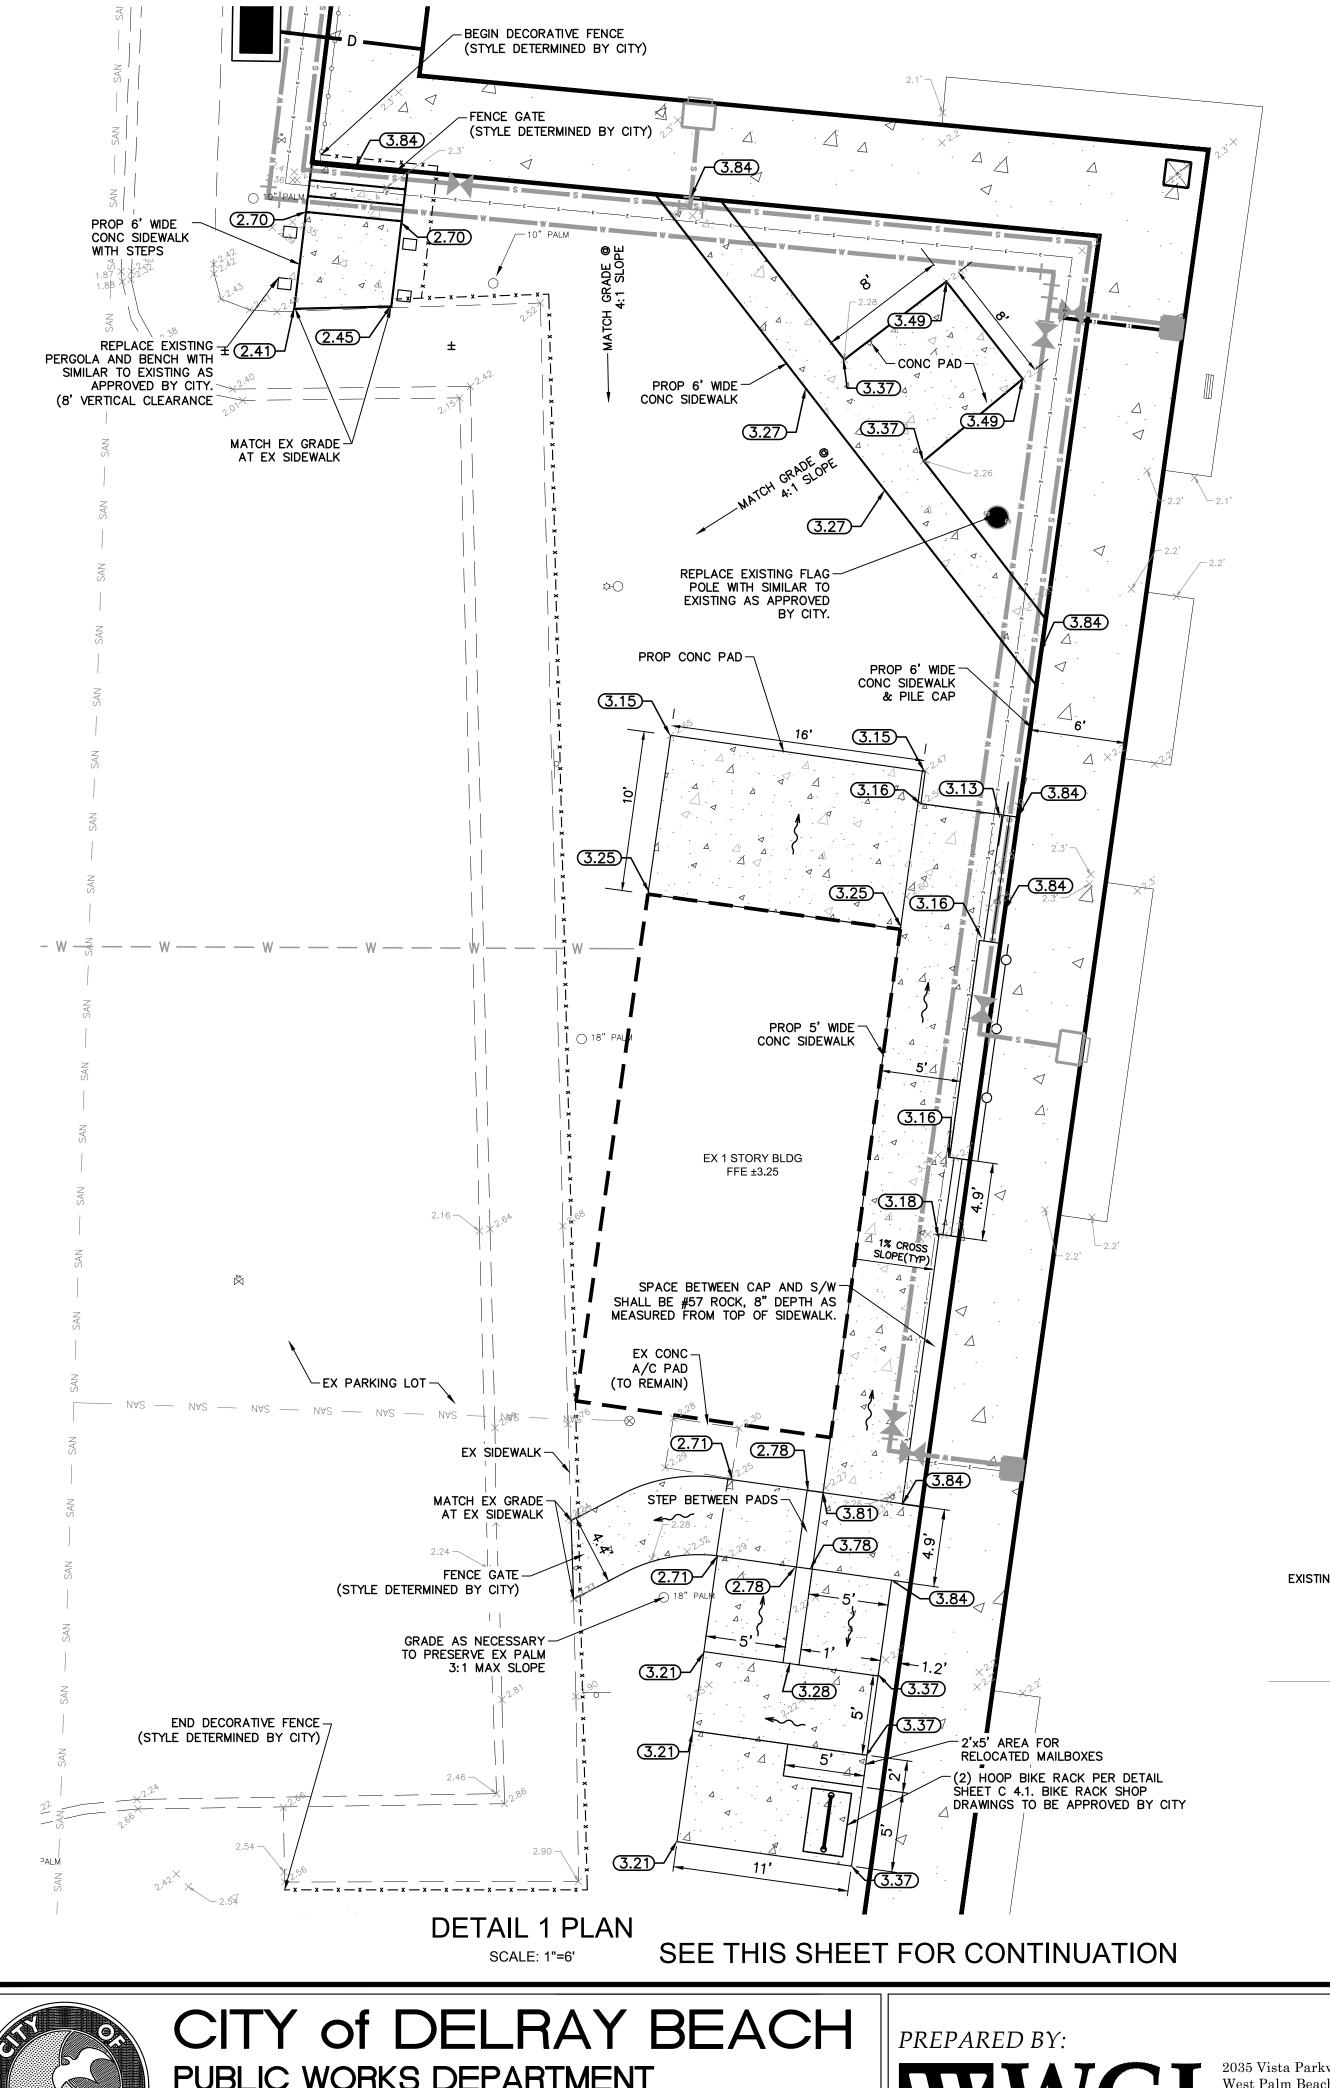

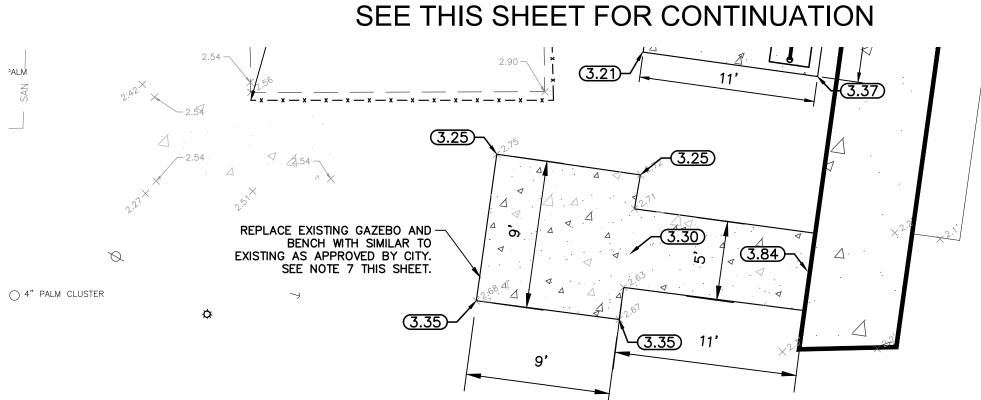

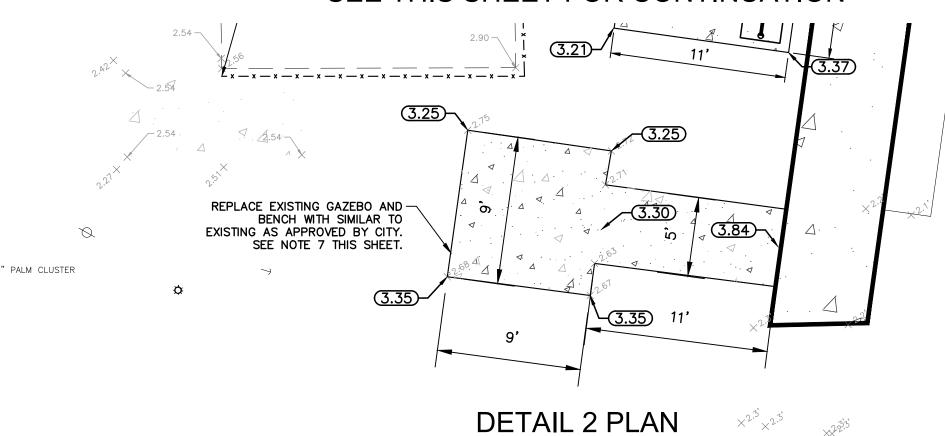

SCALE: 1"=6'

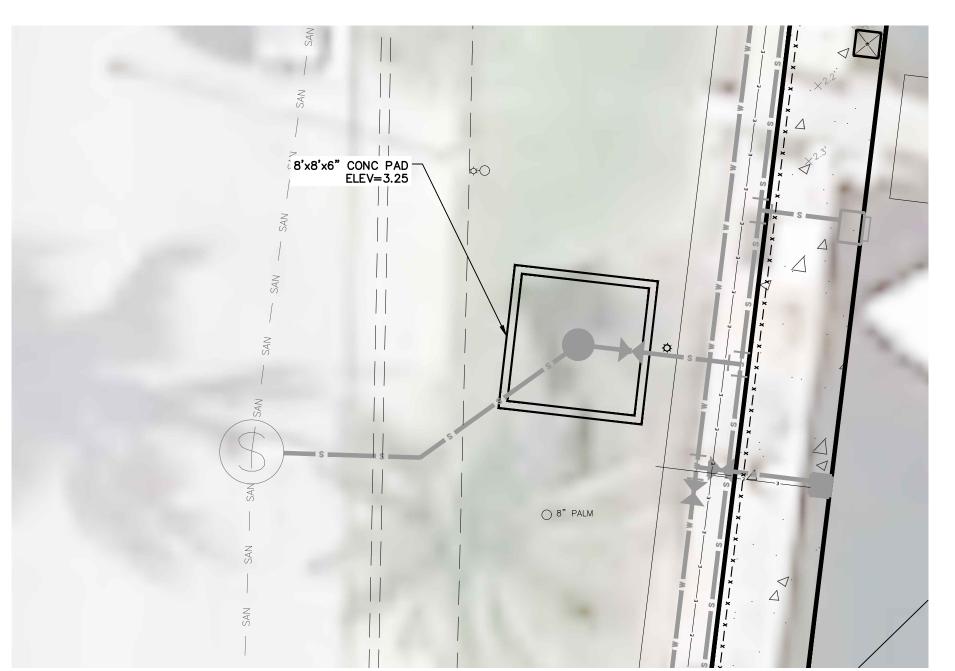

PUMP STATION PAD SCALE: 1"=6'

NOTES

- WASTOP INLINE CHECK VALVE AND BMP SNOUT OIL AND DEBRIS STOP OR APPROVED EQUAL, TO BE INSTALLED IN THE DISCHARGE PIPE OF THE DOWNSTREAM STRUCTURE FOR ALL STORM OUTFALLS TO INTRACOASTAL.
- 2. THE ANNULAR SPACE BETWEEN THE SEAWALL AND ANY SEAWALL PROTRUSION SHALL BE SEALED WITH LINK-SEAL AS APPROVED BY THE CITY AND ENGINEER.
- 3. PROPOSED WALKWAYS TO BE ADA COMPLIANT; 5% MAX LONGITUDINAL SLOPE 2% MAX CROSS SLOPE.
- 4. SECTION B-B TO BE USED WHERE FDOT RAILING IS PROPOSED.
- 5. PROPOSED FILL SHALL BE CLEAN AND FREE OF DELETERIOUS MATERIAL AND BE OF SIMILAR COMPOSITION AS ADJACENT SOIL. CONTRACTOR SHALL SUBMIT SPECIFICATIONS FOR SOIL BROUGHT FROM OFFSITE TO BE APPROVED BY ENGINEER PRIOR TO INSTALLATION. SOIL SHALL BE SUITABLE FOR PROPOSED LANDSCAPING AND SHALL MEET STRUCTURAL PROPERTIES WHERE REQUIRED.
- 6. ALL STEPS SHALL HAVE UNIFORM RISER HEIGHTS AND UNIFORM TREAD DEPTHS. RISERS SHALL BE MIN. 4" & 7" MAX. HEIGHT. TREAD DEPTH SHALL BE 11" MIN.
- CONTRACTOR SHALL PROVIDED SIGNED & SEALED STRUCTURAL PLANS AND CALCULATIONS FOR GAZEBOS AND PERGOLA CONFORMING WITH FLORIDA BUILDING CODE, 2017 EDITION, AND DESIGNED TO WITHSTAND MINIMUM 180MPH WIND SPEED. GAZEBO SHALL HAVE STANDING SEAM METAL ROOF. CONTRACTOR SHALL OBTAIN HISTORIC PRESERVATION BOARD APPROVAL, IF

~~~~~~~~/<sub>/</sub>

### **LEGEND**

CONCRETE PAVEMENT

PROPOSED FILL

FINISHED GROUND ELEVATION EXISTING GROUND ELEVATION

FLOW DIRECTION CATCH BASIN

EXISTING DRAINAGE PIPE

EXISTING WATER MAIN

EXISTING GRAVITY SEWER

EXISTING FORCE MAIN EXISTING BURIED ELECTRIC

EXISTING BURIED CATV

DRAINAGE PIPE

PROPOSED WATER MAIN PROPOSED SANITARY SEWER

→ W — \_\_\_\_ s \_\_\_\_

SCALE IN FEET

4 4 4 4

(17.45)

+17.45

~~<del>></del>

----- STM -----

— — W —

----- SAN -----

— — FM —

——— — BE(B) — — ———

\_\_\_\_ D \_\_\_\_

- PROPOSED PILE CAP/WALKWAY (SEE STRUCTURAL PLANS FOR DETAILS) DECORATIVE FENCE (STYLE DETERMINED BY CITY) CONTRACTOR TO SUBMIT SHOP DRAWINGS SEALED BY ENGINEER. FENCE SHALL COMPLY WITH FLORIDA BUILDING CODE, LATEST. 3.84') 4:1 SLOPE -EXISTING GROUND -TOP EL AT WATER = 3.87PROPOSED FILL SEE NOTE 5 ±7.2'

> TYPICAL SECTION A-A SCALE: N.T.S.

ALUMINUM PIPE GUIDERAIL — PER FDOT INDEX 870 PROPOSED PILE CAP/WALKWAY (SEE STRUCTURAL PLANS 0.5' FOR DETAILS) BASE PLATE WITH SHIM PLATES -TOP EL AT WATER = 3.87EL VARIES -(1.75 MIN) EXISTING GROUND -

> TYPICAL SECTION B-B SCALE: N.T.S.



Call before you dig.

 $\bigcirc$ 



Phone: (561) 243-7322 Fax: (561) 243-7060 www.mydelraybeach.com

| ENGINEER'S SE   | <u>-</u> 🛮 🗎 | DESIG |
|-----------------|--------------|-------|
| LINOINLLIN 3 3L | -/\L         | DRAW  |
|                 |              | CHECK |
|                 |              | QC BY |
|                 |              |       |
| THOMAS MUELLER, | PE           |       |

P.E., LIC. NO. 581

| EAL  | DESIGNED BY | CAC       | $\triangle$ | 3-27-19 | STRUCTURAL CLARIFICATION |    |  |
|------|-------------|-----------|-------------|---------|--------------------------|----|--|
| _/\L | DRAWN BY    | CAC       |             |         |                          |    |  |
|      | CHECKED BY  | TEM       |             |         |                          |    |  |
|      | QC BY       | SJC       |             |         |                          |    |  |
|      |             |           |             |         |                          |    |  |
| PE   |             |           |             |         |                          |    |  |
| 119  | DATE        | 3/27/2019 | REVISION    | DATE    | DESCRIPTION              | BY |  |


THE CITY OF DELRAY BEACH CITY MARINA: SEAWALL, DOCK, AND SITE IMPROVEMENTS


**GRADING & DRAINAGE DETAILS** 


PROJECT NO. 16-098 SHEET NO. C 2.0 OF 36

FILE ID. 1004.33

### SEE THIS SHEET FOR CONTINUATION

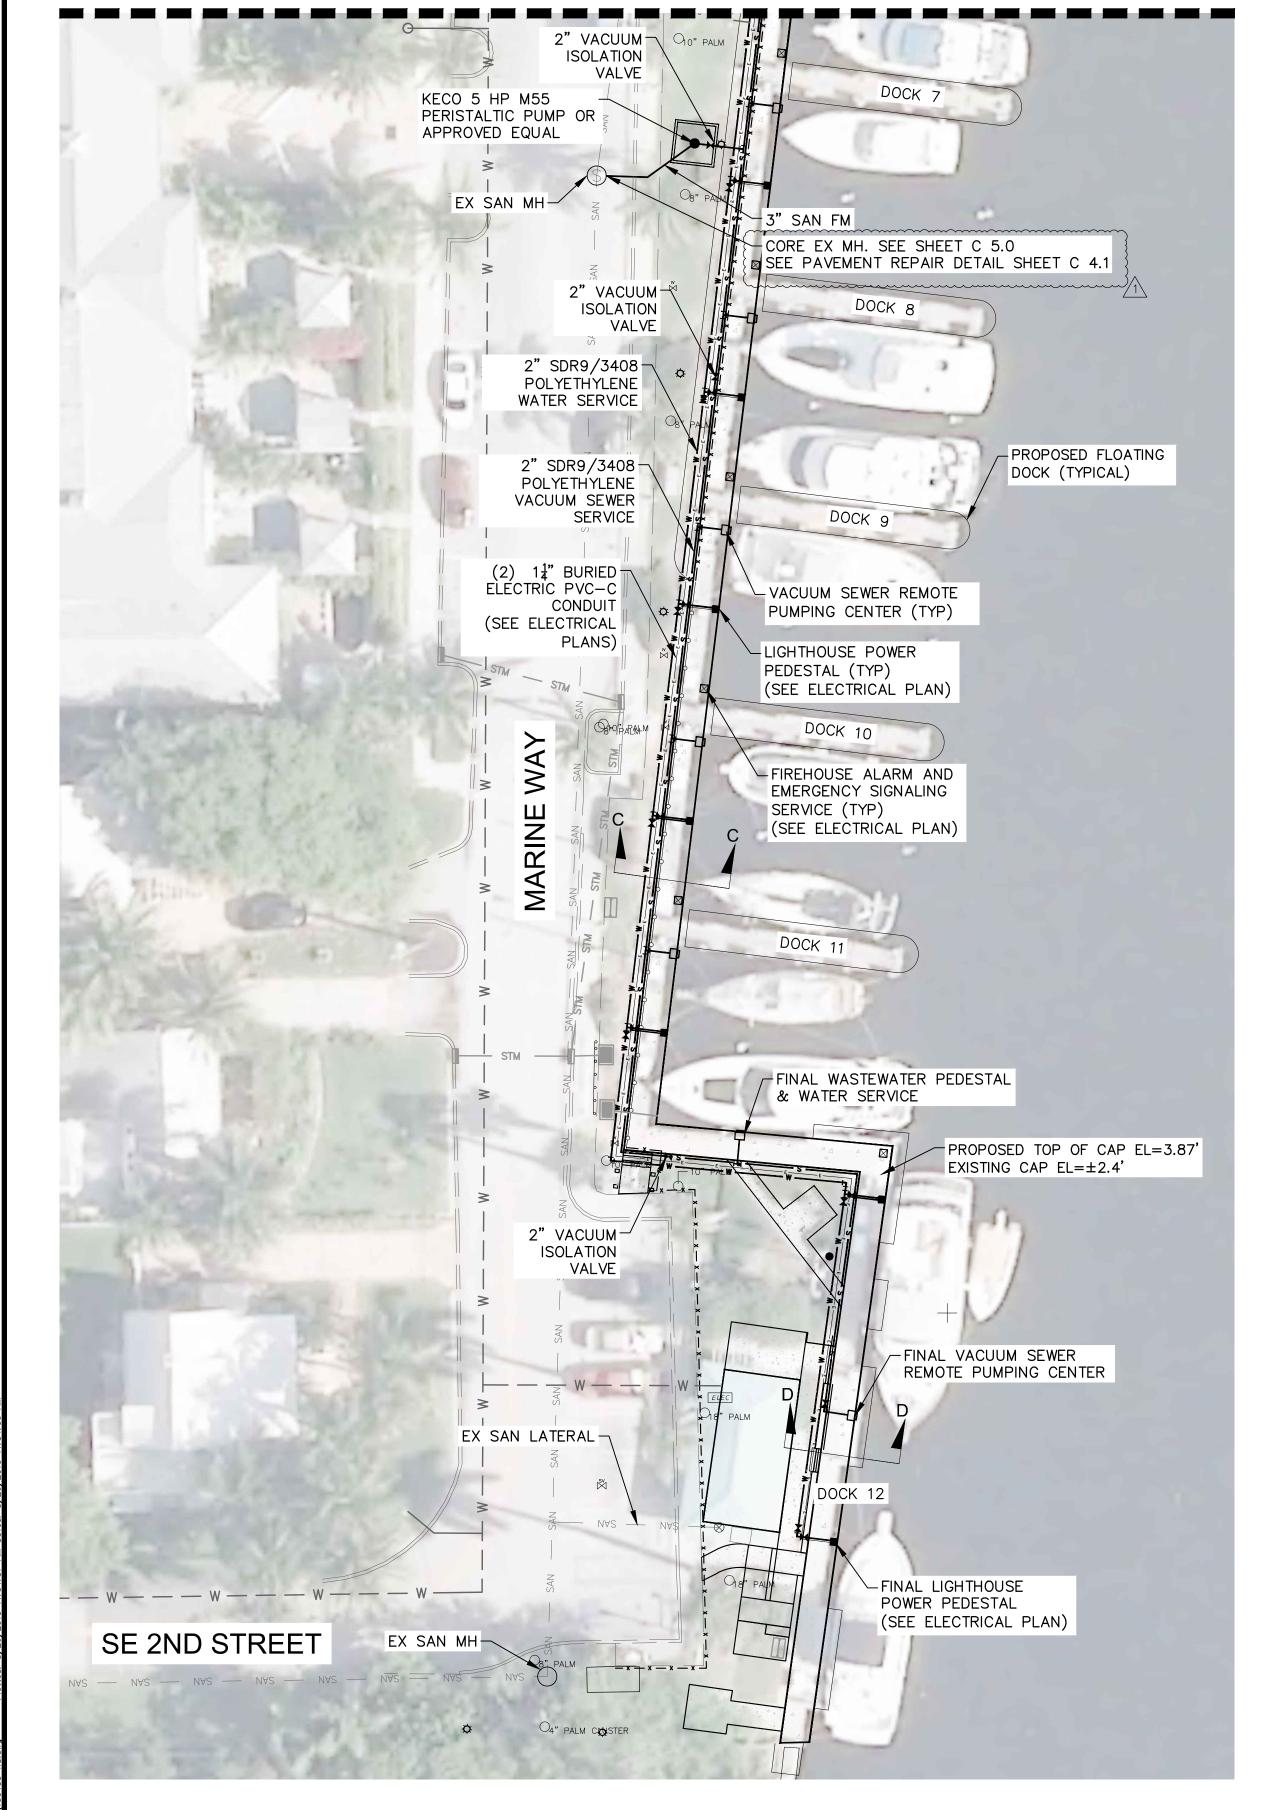

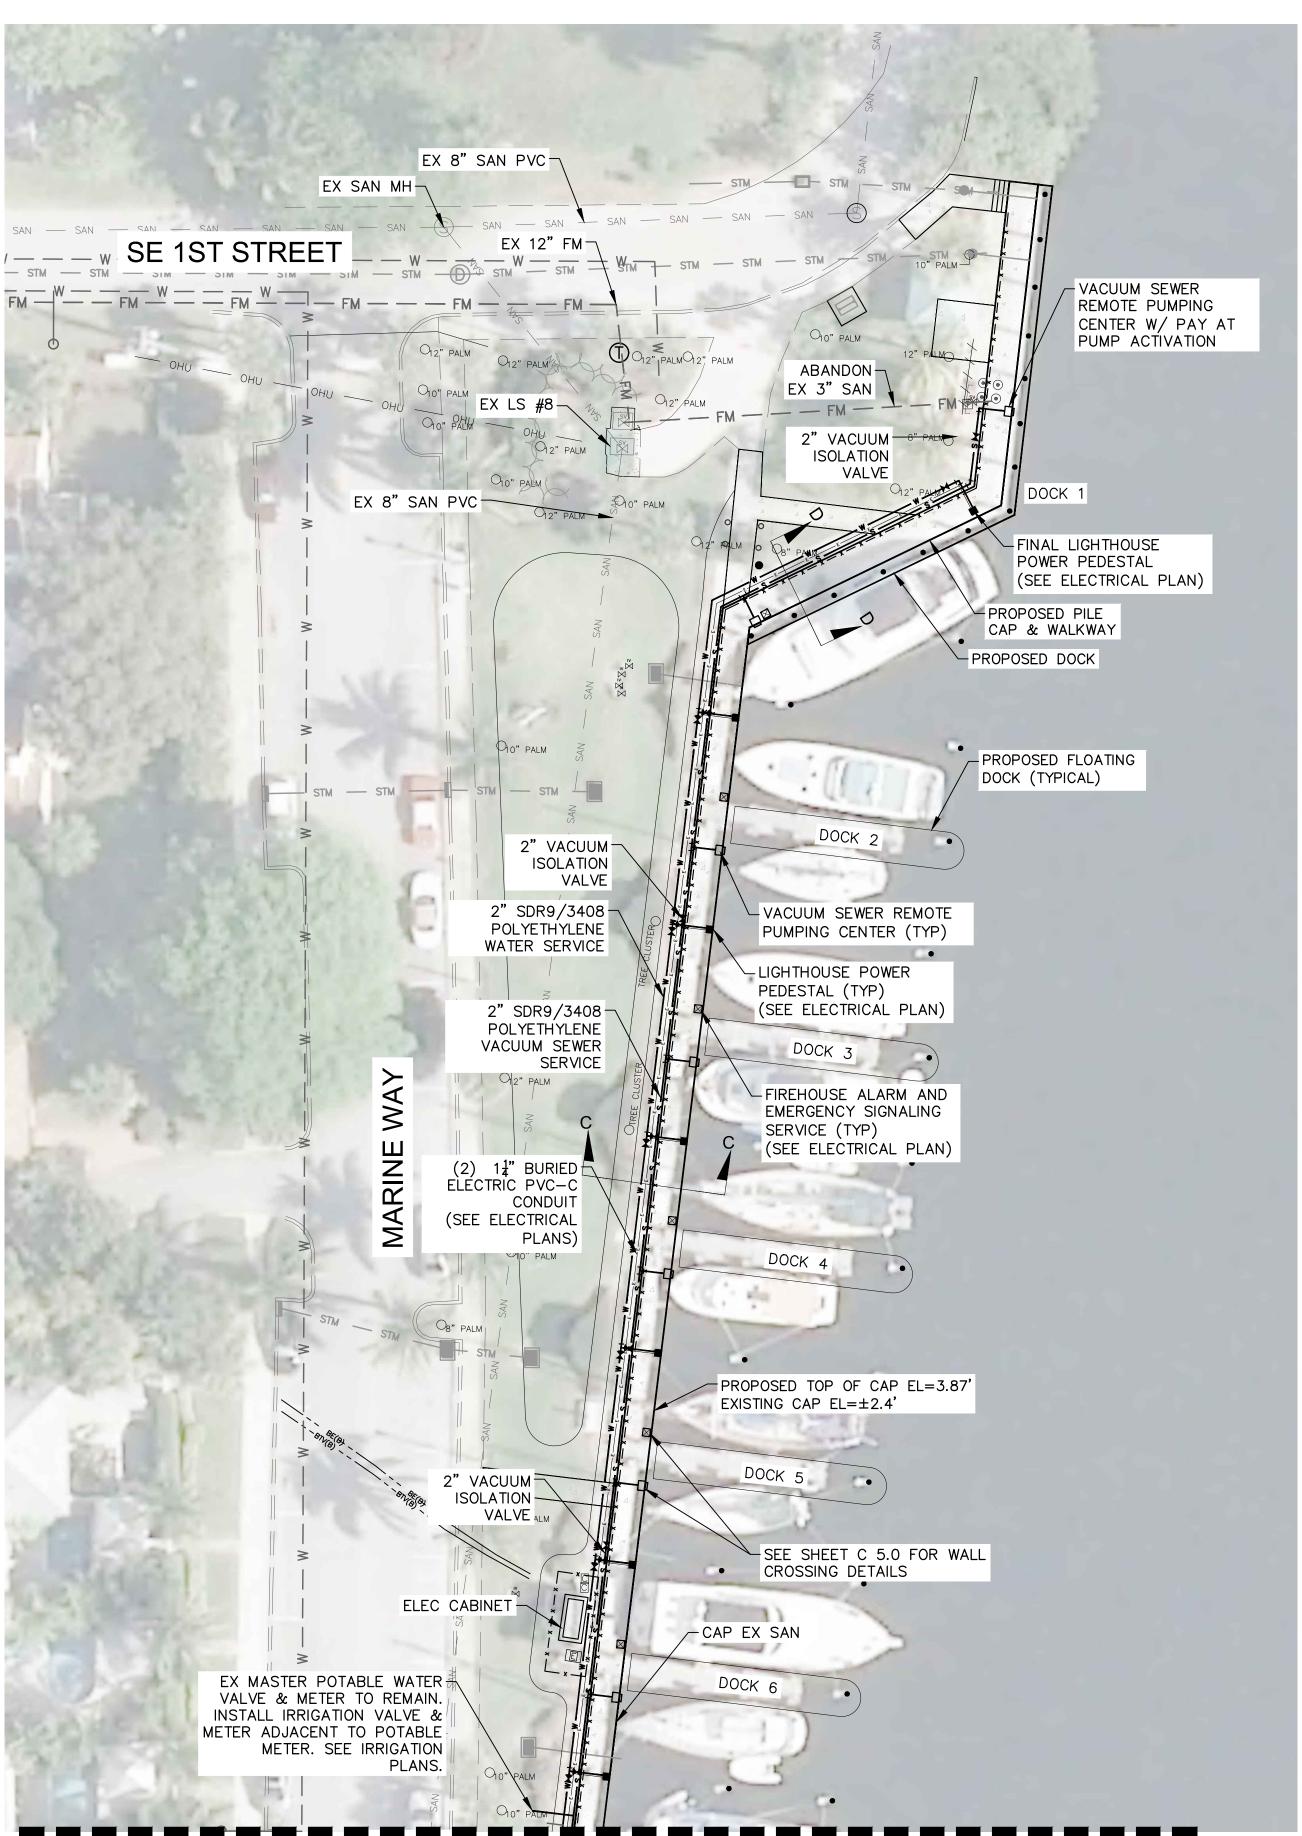

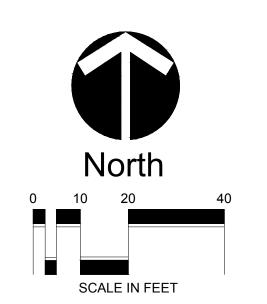

### **LEGEND**

EXISTING DRAINAGE PIPE \_\_\_\_\_ NTS \_\_\_\_ EXISTING WATER MAIN — — W — EXISTING GRAVITY SEWER \_\_\_\_\_ SAN \_\_\_\_ EXISTING FORCE MAIN — — FM — EXISTING BURIED ELECTRIC EXISTING BURIED CATV DRAINAGE PIPE PROPOSED WATER MAIN PROPOSED SANITARY SEWER VACUUM SEWER REMOTE PUMPING CENTER LIGHTENING HOUSE POWER PEDISTAL FIREHOUSE ALARM AND EMERGENCY SIGNALING SERVICE

### WATER & WASTEWATER NOTES

- 1. SEE SHEET C 5.0 FOR WATER & WASTEWATER SECTIONS & DETAILS.
- 2. ALL WATER AND VACUUM SEWER, OR ELECTRIC PIPE INSTALLED UNDER WALKWAY TO BE SLEEVED.
- 3. ALL DRY AND WET UTILITY COMPONENTS SHALL BE NEW AND NOT EXISTING-RELOCATED.
- 4. THE ANNULAR SPACE BETWEEN THE SEAWALL AND ANY SEAWALL PROTRUSION SHALL BE SEALED WITH LINK-SEAL AS APPROVED BY THE CITY AND ENGINEER.
- 5. WATER AND WASTEWATER SERVICE PIPING SHALL HAVE A MIN COVER OF 1' UNLESS OTHERWISE STATED.
- 6. FORCE MAIN SEPARATION TO PUBLIC WATER MAINS SHALL BE 6' MINIMUM IN ACCORDANCE WITH F.A.C. RULE 62-555.314.
- 7. VACUUM BREAKERS SHALL BE INSTALLED ON ALL HOSE BIBS.



### SEE THIS SHEET FOR CONTINUATION



Phone: (561) 243-7322 Fax: (561) 243-7060 www.mydelraybeach.com



| ENGINEER'S SEAL      | DESIGNED BY | CAC     |
|----------------------|-------------|---------|
| LINOHNELIN O OLINE   | DRAWN BY    | CAC     |
|                      | CHECKED BY  | TEM     |
|                      | QC BY       | SJC     |
|                      |             |         |
| THOMAS MUELLER, PE   |             |         |
| P.E., LIC. NO. 58119 | DATE        | 3/26/20 |


|   | DESIGNED BY | CAC       | $\triangle$ | 9-22-19 | PAVEMENT RESTOR & HOSE BIB PER HEALTH DEPT |    |  |
|---|-------------|-----------|-------------|---------|--------------------------------------------|----|--|
| - | DRAWN BY    | CAC       |             |         |                                            |    |  |
|   | CHECKED BY  | TEM       |             |         |                                            |    |  |
|   | QC BY       | SJC       |             |         |                                            |    |  |
|   |             |           |             |         |                                            |    |  |
| - |             |           |             |         |                                            |    |  |
|   | DATE        | 3/26/2019 | REVISION    | DATE    | DESCRIPTION                                | BY |  |

THE CITY OF DELRAY BEACH CITY MARINA: SEAWALL, DOCK, AND SITE IMPROVEMENTS

WATER & WASTEWATER PLAN


PROJECT NO. 16-098 SHEET NO. C 3.0 OF 36


FILE ID. 1004.33

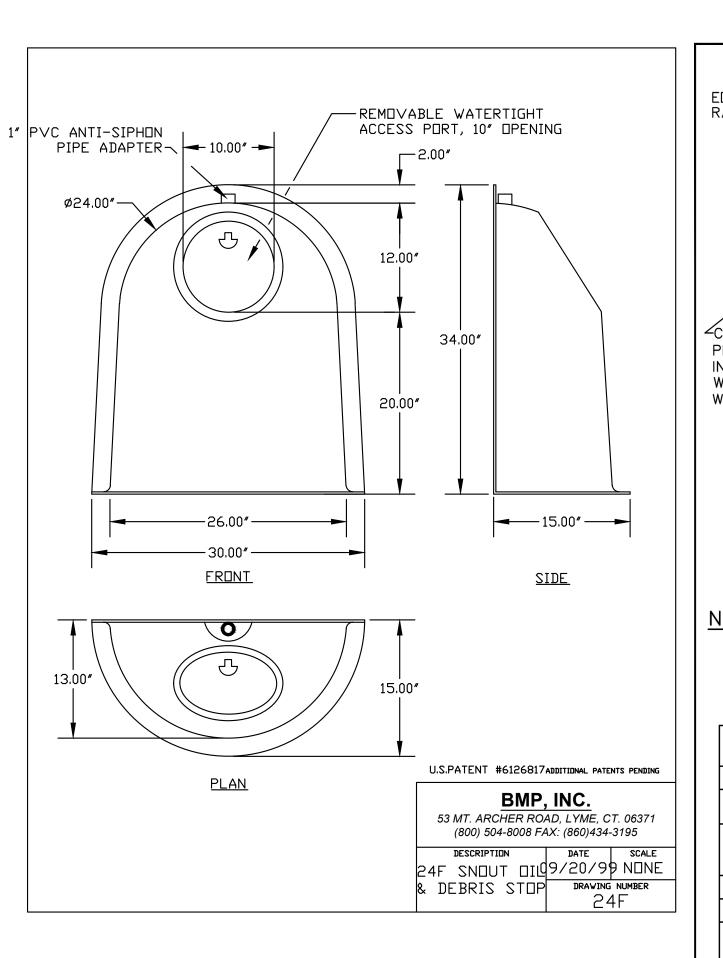



**SNOUT OIL & DEBRIS STOP DETAIL** 

SCALE: NONE

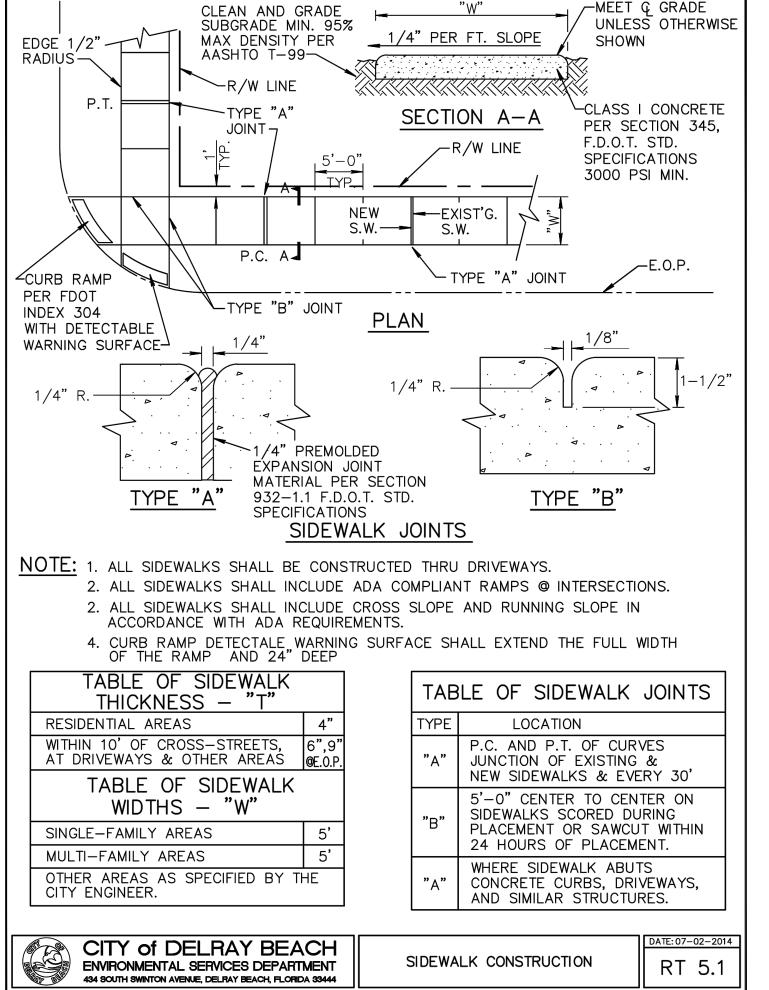

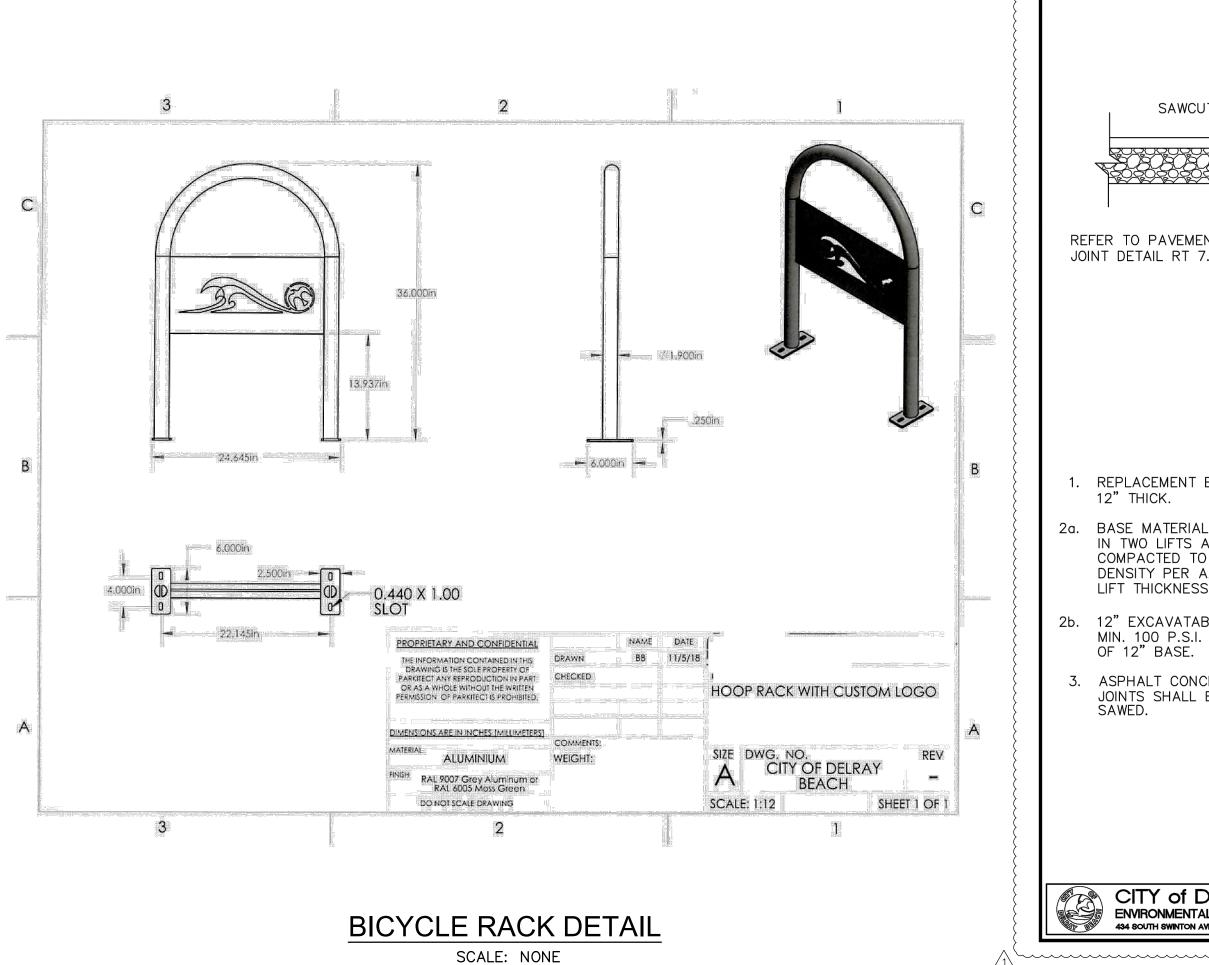


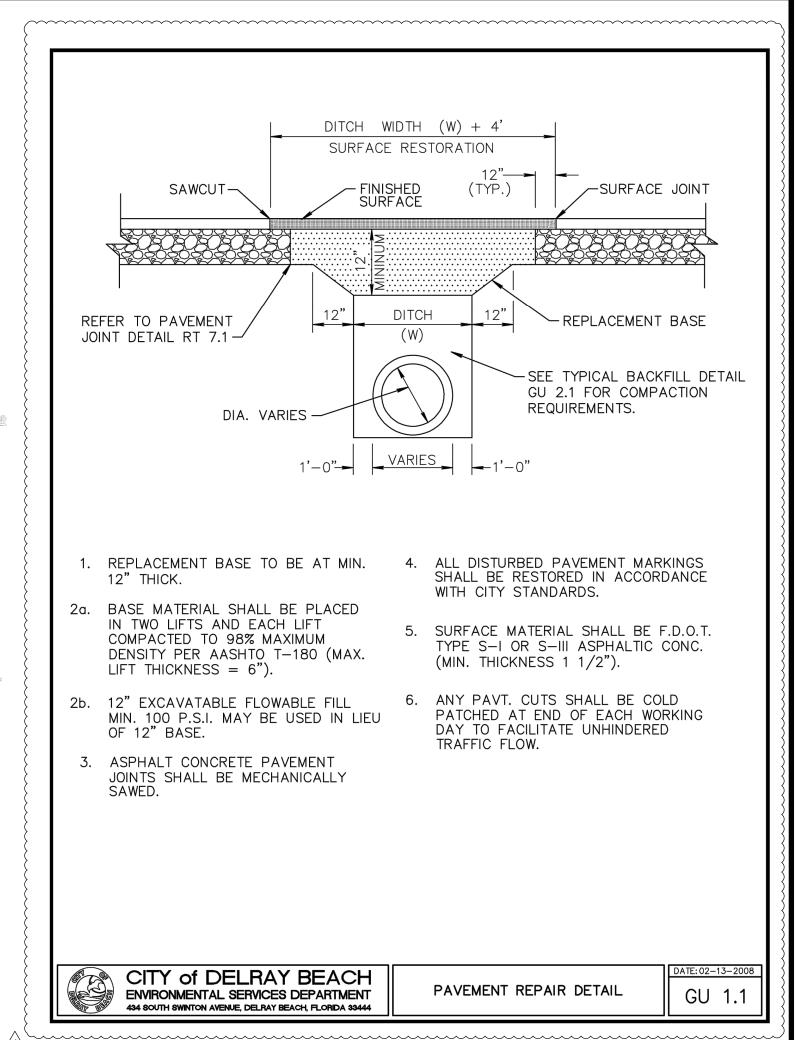

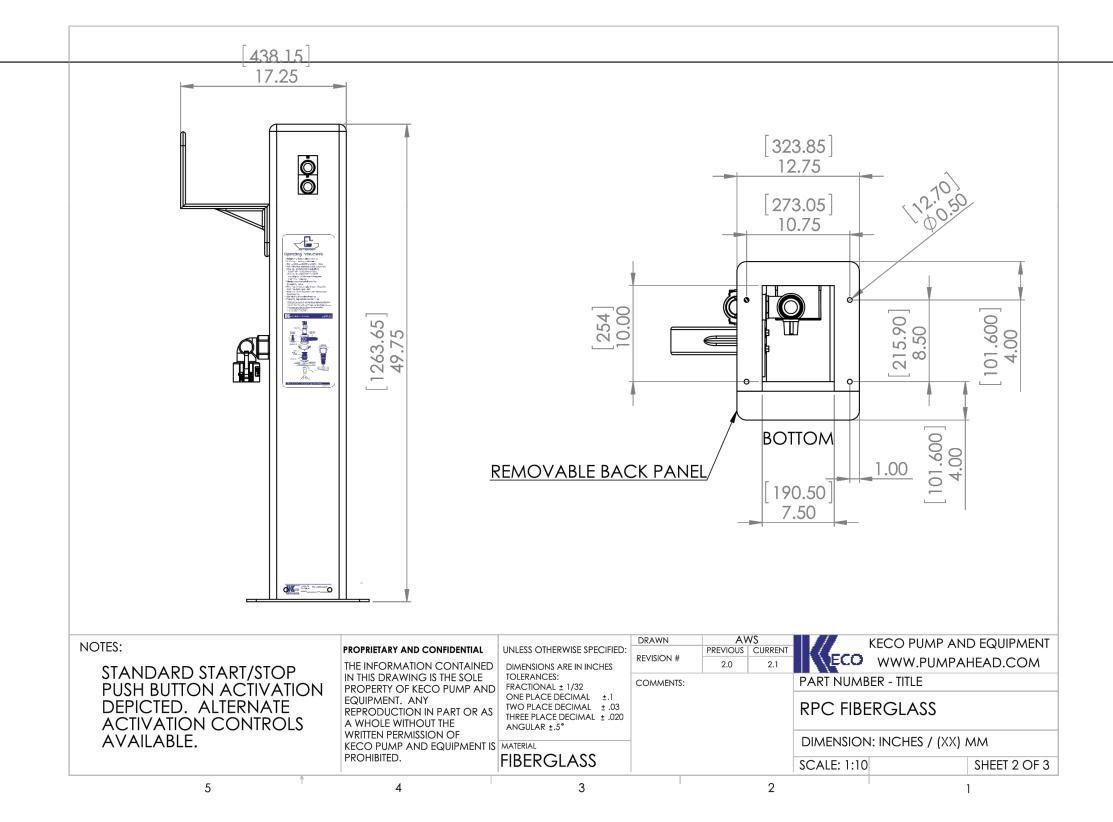

REMOTE PUMPING CENTER DETAIL

SCALE: NONE

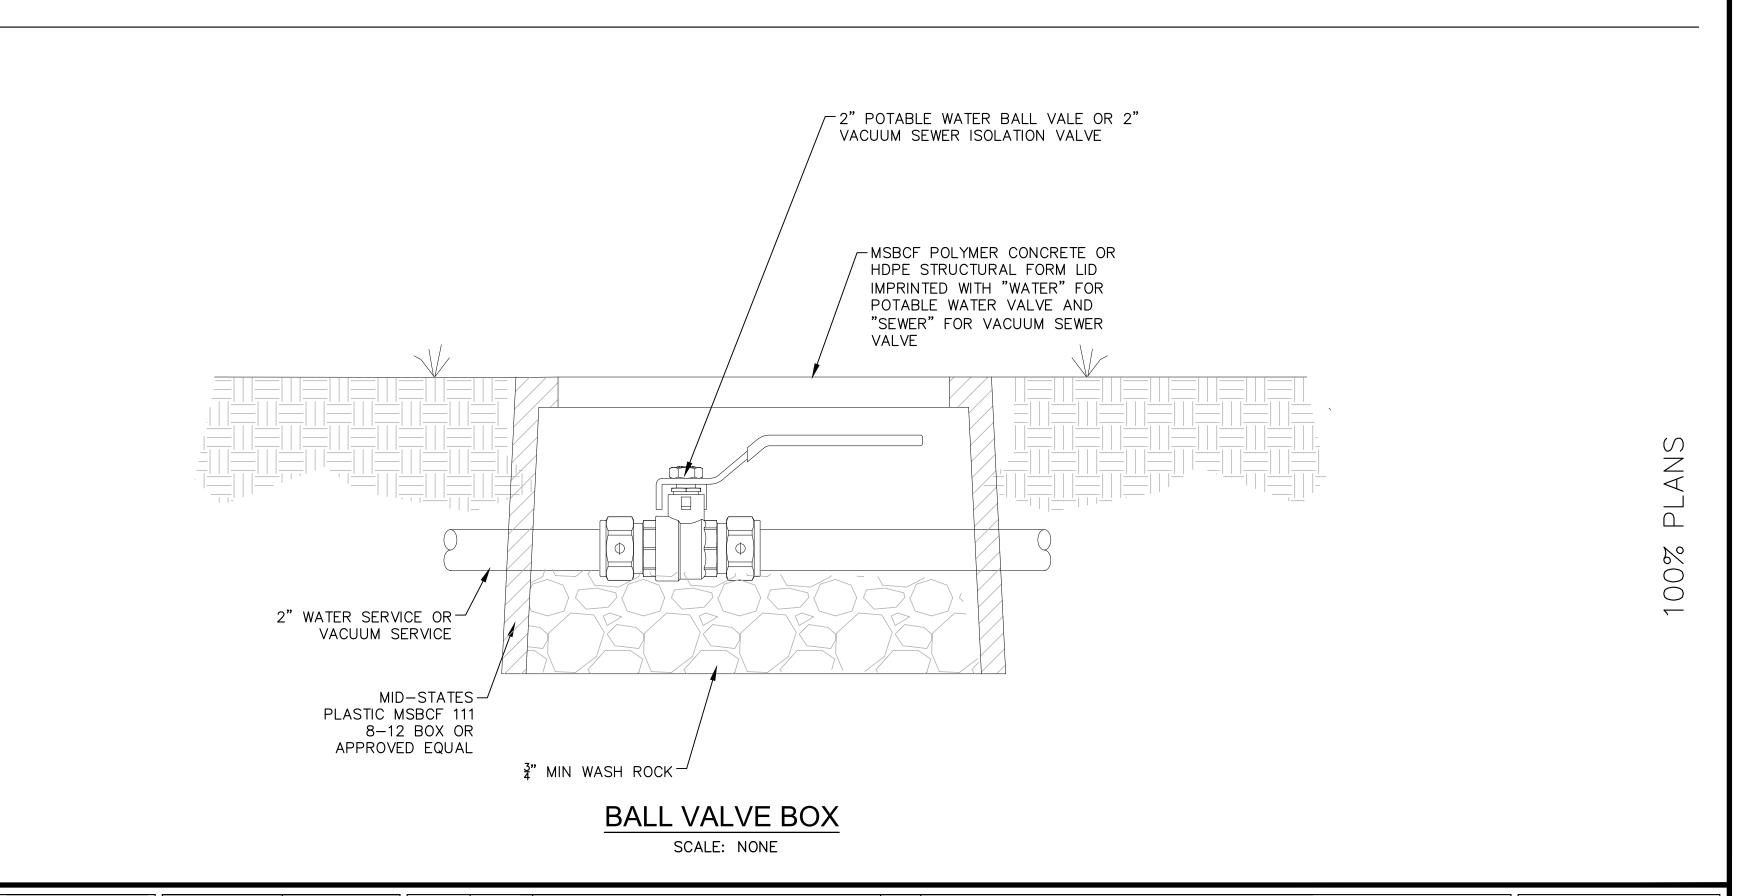

# CITY of DELRAY BEACH PUBLIC WORKS DEPARTMENT


434 SOUTH SWINTON AVENUE, DELRAY BEACH, FLORIDA 33444 Phone: (561) 243-7322 Fax: (561) 243-7060 www.mydelraybeach.com



| ENGINEER'S SEAL      | DESIGNED BY | SCC       |          | 3/26/19 | ADDED DETAIL |    |  |
|----------------------|-------------|-----------|----------|---------|--------------|----|--|
| LINOINLLIN J JLAL    | DRAWN BY    | CAC       |          |         |              |    |  |
|                      | CHECKED BY  | TEM       |          |         |              |    |  |
|                      | QC BY       | SJC       |          |         |              |    |  |
|                      |             |           |          |         |              |    |  |
| THOMAS MUELLER, PE   |             |           |          |         |              |    |  |
| P.E., LIC. NO. 58119 | DATE        | 3/26/2019 | REVISION | DATE    | DESCRIPTION  | BY |  |
|                      |             |           |          |         |              |    |  |

PROJECT NO. THE CITY OF DELRAY BEACH CITY MARINA: SEAWALL, DOCK, AND SITE IMPROVEMENTS SITE DETAILS

16-098 SHEET NO. C 4.1 OF 36 FILE ID. 1004.33

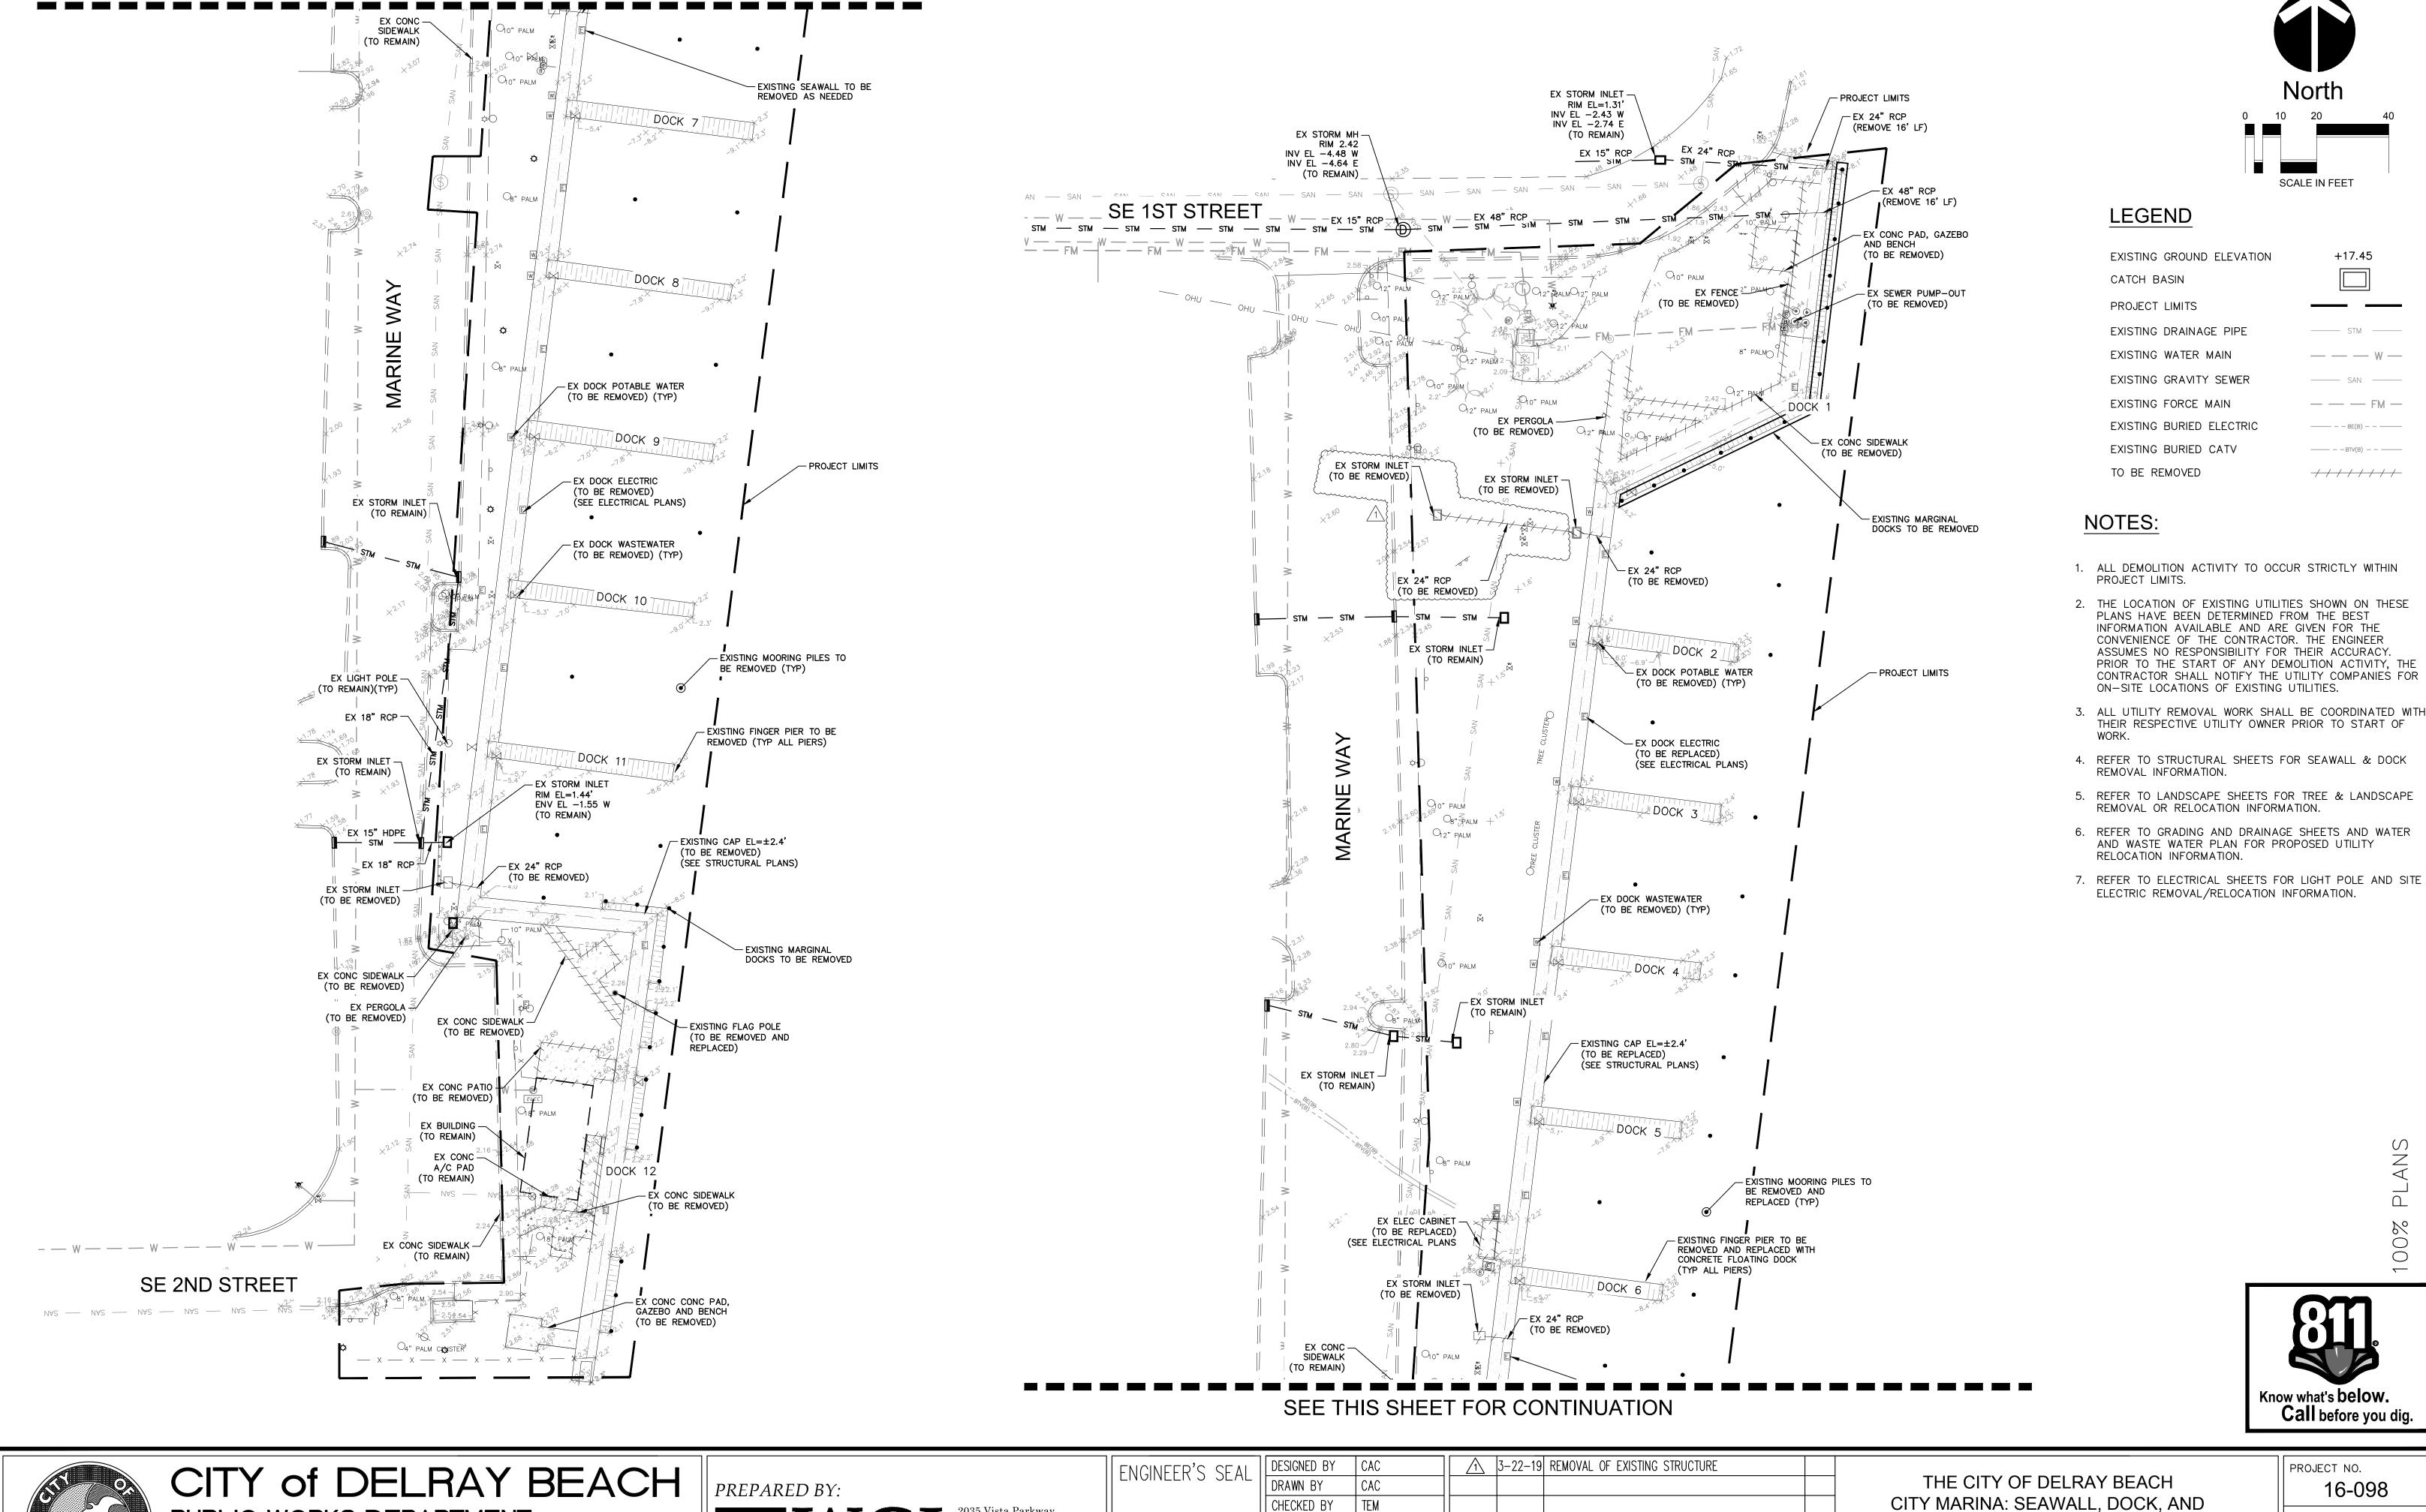

West Palm Beach, FL 33411
Phone No. 561.687.2220
Fax No. 561.687.1110
Cert No. 6091 - LB No. 7055

THOMAS MUELLER, PE

P.E., LIC. NO. 58119 | DATE

1/11/2019

|REVISION| DATE

DESCRIPTION

SEE THIS SHEET FOR CONTINUATION

PUBLIC WORKS DEPARTMENT

434 SOUTH SWINTON AVENUE, DELRAY BEACH, FLORIDA 33444

Phone: (561) 243-7322 Fax: (561) 243-7060 www.mydelraybeach.com

SHEET NO. SITE IMPROVEMENTS G 5.0 of 36 DEMOLITION PLAN FILE ID. 1004.33

+17.45

