



Development Services Department

BOARD ACTION REPORT – APPEALABLE ITEM

Project Name: Boston's on the Beach
Project Location: 17 Salina Avenue
Request: Class I Site Plan Modification
PCN: 12-43-46-16-28-001-0040
Board: Site Plan Review and Appearance Board
Meeting Date: August 28, 2019

Board Action:

Approved (6-0 Price Patton absent)

Project Description:

The subject property is located on the west side of East Atlantic Ave and A-1-A-within the Central Business District (CBD) and consists of OCEAN PARK DELRAY LTS 4 & 5 (LESS S OCEAN BLVD R/W), LTS 11 THRU 13 & LTS 14 THRU 16 (LESS W 2.67 FT SALINA AVE R/W) BLK 1 . The Masonry Modern style structure property contains a two-story restaurant; 50 Oceans and Boston's.

The proposed minor façade changes to the 1937 Masonry Modern Style building are in conformity with good taste and design and will contribute to the image of downtown Delray along East Atlantic Avenue and A-1-A. The applicant is proposing to add the nana doors for a more open look to the restaurant and bar area and provide shade and protection from other weather elements. It will also give it a more modern and sophisticated look. The surrounding area, which includes Café Luna Rosa and Burger Fi, will continue to benefit from the streetscape which will not be disrupted as only minor façade changes are being proposed.

The front elevation (east) includes the installation of impact nana doors with turtle glass, in addition nana doors are being introduced at the pass-through windows at the bar and restaurant area. The north elevation is removing a stem wall to allow access to the stairwell to the second-floor restaurant, 50 Ocean's and on the south elevation a door is being introduced to allow connectivity to the Sandbar and Boston's.

Board Comments:

N/A

Public Comments:

N/A

Associated Actions:

N/A

Next Action: The SPRAB action is final unless appealed by the City Commission.



SITE PLAN REVIEW AND APPEARANCE BOARD STAFF REPORT

DEVELOPMENT SERVICES DEPARTMENT

100 NW 1ST AVENUE, DELRAY BEACH, FLORIDA 33444

PLANNING & ZONING DIVISION: (561) 243-7040 • BUILDING DIVISION: (561) 243-7200

SITE PLAN REVIEW AND APPEARANCE BOARD

Meeting: August 28,
2019

File No.: 2019-240 SPF-SPR-
CLI

Application Type: Class I Site Plan Modification

General Data:

Owner: Robert Currie

Location: 17 Salina Ave

PCN: 12-43-46-16-28-001-0040

Property Size: 0.69 Acres

FLUM: CC (Commercial Core)

Zoning: CBD (Central Business District)

Adjacent Zoning:

- North: CBD
- South: CBD
- East: Beach
- West: RM (Multi Family)

Existing Land Use: Restaurant

Proposed Land Use: Restaurant



Item before the Board:

The action before the Board is for the consideration of a Class I Site Plan Modification for **17 Salina Avenue** pursuant to LDR Section 2.4.5 (G), including:

- ☐ Architectural Elevations
- ☐ Site Plan

Optional Board Motions for Action Items:

1. Move to continue with direction.
2. Move approval of the Class I (2019-240) Site Plan Modification, and Architectural Elevations for **17 Salina Avenue**, as amended and finding that the request is consistent with the Comprehensive Plan and meets criteria set forth in Sections 2.4.5(G)(5), 2.4.5(I)(5), 4.6.18(E), and Chapter 3 of the Land Development Regulations.
3. Move denial of the Class I (2019-240) Site Plan Modification, and Architectural Elevations for **17 Salina Avenue**, by finding that the request is inconsistent with the Comprehensive Plan and does not meet criteria set forth in Sections 2.4.5(G)(5), 2.4.5(I)(5), 4.6.16, 4.6.18(E), and Chapter 3 of the Land Development Regulations.

Project Planner:
Jennifer Buce
buce@mydelraybeach.com
561-243-7138

Review Dates:
August 28

Attachments:
1. Building Elevations



Assessment and Summary:

The property consists of 0.74 acres and is currently zoned CBD (Central Business District). The project consists of minor architectural elevation changes to the façade of the existing building which include the removal of the stem wall on the north elevation to make an opening to the stairwell, remove the overhead doors, and existing windows facing the east elevation and the introduction of impact Nana sliding glass doors under the covered area at front entrance and the entrance to the main restaurant to open up the bar area and provide more shelter from the elements of rain and other environmental elements. A door is also being proposed on the southside that will provide a connection from the Sandbar to Boston's

Background:

The subject property is located on the west side of East Atlantic Ave and A-1-A-within the Central Business District (CBD) and consists of OCEAN PARK DELRAY LTS 4 & 5 (LESS S OCEAN BLVD R/W), LTS 11 THRU 13 & LTS 14 THRU 16 (LESS W 2.67 FT SALINA AVE R/W) BLK 1 . The Masonry Modern style structure property contains a two-story restaurant; 50 Oceans and Boston's.

Boston's has a long history of approvals through the Site Plan Review and Appearance Board as well as two variances for parking starting as early as 1987. The approvals range from the addition of 1,400 square feet to the building, to the conversion of 3 hotel rooms with a total of 700 SF to office space, 200 SF cooler adjacent to the southeast side of the motel to the rear of the restaurant building, enclosure of the stairwell which resulted in a total of 445 SF, outdoor bar area and enclosure of the second floor balcony and the last approval in 2011 which consisted of the demolition of the northernmost building of the existing hotel, existing tiki bar, easternmost portion of the interior wall along the south elevation on the lower level and replace nano doors with fixed glass windows on second level on the east elevation.

Now before the board is a Class I Site Plan Modification which includes minor changes to the façade.

Project Description:

The subject request includes minor changes to the façade which will create a look and feel that the restaurant and bar area is more open and accessible to its customers. The nana doors will open inside and not into the public right-of-way.

Site Plan Analysis:

The following items identified in the Land Development Regulations shall specifically be addressed by the Site Plan Review and Appearance Board (SPRAB) for final action on the site and development applications/requests, as presented.

LDR Section 4.4.13(D) – Dimensional Requirements by CBD Sub District

The following table indicates that the development proposal meets the requirement as they pertain to the Central Core sub-district of the CBD District. Pursuant to Table 4.4.13(C), the following dimensional requirements are applicable, East Atlantic Avenue is classified as a Primary Street.

| | East Atlantic Avenue | |
|---|-----------------------|----------|
| | Front Requirement | Provided |
| Setbacks | 10' min./ 15' max. | 0' |
| Building Frontage Required on Primary Streets | 75% min./ 100%max | 100% |

*Existing Nonconformity

Storefront and Glazing Area:

Pursuant to LDR Section 4.4.13(E)(4)(e) the storefront is a frontage type along the sidewalk level of the ground story, typically associated with commercial uses. Storefront Dimensions Table 4.4.13(I) provides the dimensional requirements for all elements contained in a storefront as indicated in the chart below:



| Commercial Storefronts | Dimensional Requirements | | Proposed |
|------------------------|--------------------------|---------|----------------------|
| | Minimum | Maximum | East Atlantic Avenue |
| Building Setback | 10 ft. | 15 ft. | 0' |
| Storefront Width | N/A | 75' | 85.8' * |
| Storefront Base | 9" | 3' | 9" |
| Glazing Height** | 8 ft. | --- | 10'6" |
| Required Openings | 80% | --- | 90% |
| Awning Projection | 5' | - | N/A |

*Existing Nonconformity

Architectural Elevations Analysis:

Pursuant to LDR Section 4.4.13(F), the CBD has seven permitted architectural styles, which are described and illustrated in the Central Business District Architectural Design Guidelines. Pursuant to LDR Section 4.6.18(E), the following criteria shall be considered by the Site Plan Review and Appearance Board in the review of plans for building permits. If the following criteria are not met, the application shall be disapproved.


1. The plan or the proposed structure is in conformity with good taste, good design, and in general contributes to the image of the City as a place of beauty, spaciousness, harmony, taste, fitness, broad vistas, and high quality.
2. The proposed structure, or project, is in its exterior design and appearance of quality such as not to cause the nature of the local environment or evolving environment to materially depreciate in appearance and value.
3. The proposed structure, or project, is in harmony with the proposed developments in the general area, with the Comprehensive Plan, and with the supplemental criteria which may be set forth for the Board from time to time.

The proposed minor façade changes to the 1937 Masonry Modern Style building are in conformity with good taste and design and will contribute to the image of downtown Delray along East Atlantic Avenue and A-1-A. The applicant is proposing to add the nana doors for a more open look to the restaurant and bar area and provide shade and protection from other weather elements. It will also give it a more modern and sophisticated look. The surrounding area, which includes Café Luna Rosa and Burger Fi, will continue to benefit from the streetscape which will not be disrupted as only minor façade changes are being proposed.

The front elevation (east) includes the installation of impact nana doors with turtle glass, in addition nana doors are being introduced at the pass-through windows at the bar and restaurant area. The north elevation is removing a stem wall to allow access to the stairwell to the second-floor restaurant, 50 Ocean's and on the south elevation a door is being introduced to allow connectivity to the Sandbar and Boston's.

Review by Others:

- The DDA (Downtown Development Authority) will review this proposal at their meeting in September.

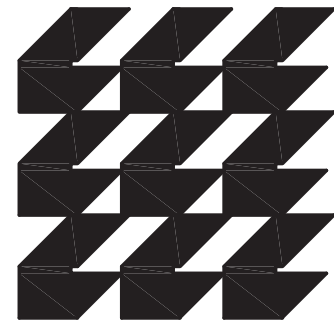

CURRIE
SOWARDS
AGUILA
ARCHITECTS

Architects, Planners
& Interior Designers

AA26001584
134 N.E. 1st Avenue
Delray Beach, Florida 33444
TEL: 561 276-4951
FAX: 561 243-8184
E-mail: office@csa-architects.com

ISSUED FOR : SPRAB 1.25.2011
RESUBMIT SPRAB 8.15.2011
BIDS

PERMIT 6.13.2011
RESUBMIT PERMIT 9.12.2011
CONSTRUCTION

SEAL

PROJECT TITLE

BOSTON'S
RESTAURANT
RENOVATION

40 S. OCEAN BLVD.
DELRAY BEACH, FL

REVISIONS

RESPONSE TO BLDG. DEPT.
7/21/2011
OWNER REQUESTED CHANGES
9/12/2011


THESE DRAWINGS ARE PREPARED PER
ESTABLISHED INDUSTRY STANDARDS AND
REPRESENT THE ARCHITECT AND ENGINEERS
DESIGN CONCEPT. THEY ARE NOT INTENDED
TO PROVIDE EVERY DETAIL OR CONDITION
REQUIRED TO CONSTRUCT THE PROJECT.
THE CONTRACTOR THROUGH SUBMITTALS
AND OTHER COORDINATION EFFORTS IS
FULLY RESPONSIBLE FOR PROVIDING A
COMPLETE AND OPERATIONAL PROJECT
WHETHER INDICATED ON THE PLANS OR NOT.

FILE NUMBER
100901A101.dwg

DRAWING TITLE
SITE PLAN

DATE 6.13.2011 DRAWN BY
JOB NUMBER 100901
DRAWING NUMBER

A1.01

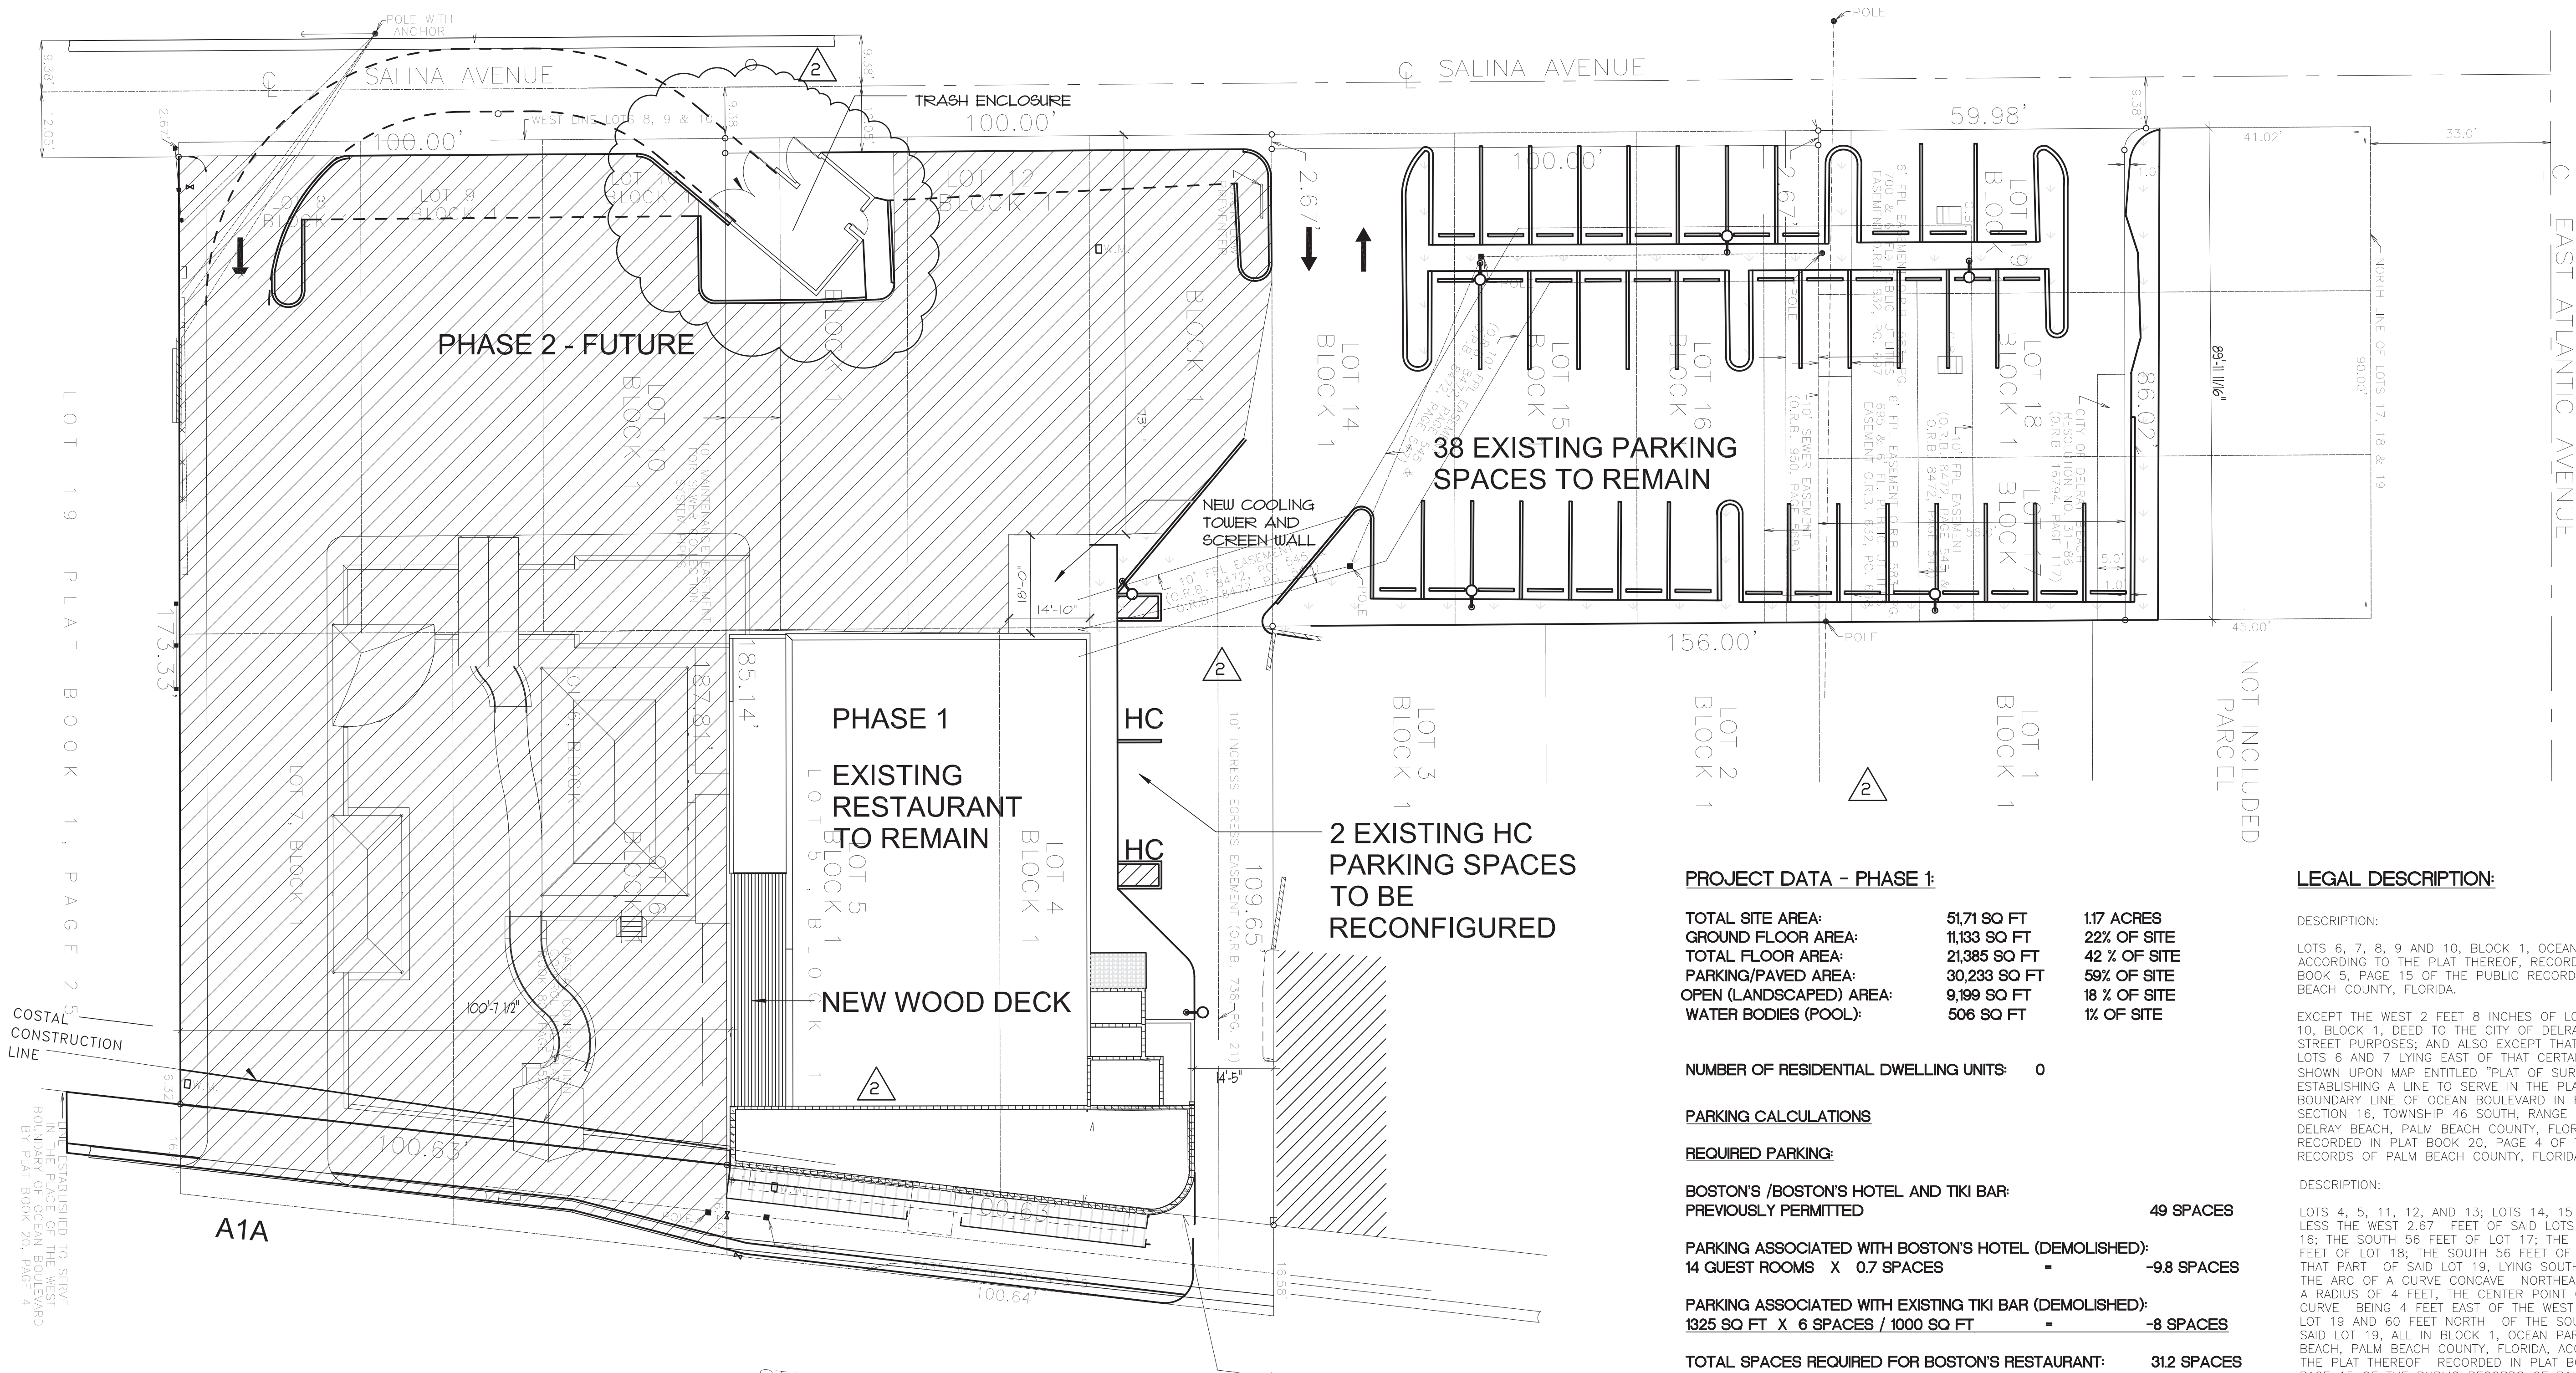

PROJECT DATA - PHASE 1:

| | | |
|-------------------------|--------------|--------------|
| TOTAL SITE AREA: | 51,71 SQ FT | 1.17 ACRES |
| GROUND FLOOR AREA: | 11,133 SQ FT | 22% OF SITE |
| TOTAL FLOOR AREA: | 21,385 SQ FT | 42 % OF SITE |
| PARKING/PAVED AREA: | 30,233 SQ FT | 59% OF SITE |
| OPEN (LANDSCAPED) AREA: | 9,199 SQ FT | 18 % OF SITE |
| WATER BODIES (POOL): | 506 SQ FT | 1% OF SITE |

NUMBER OF RESIDENTIAL DWELLING UNITS: 0

PARKING CALCULATIONS

REQUIRED PARKING:

BOSTON'S /BOSTON'S HOTEL AND TIKI BAR:
PREVIOUSLY PERMITTED 49 SPACES

PARKING ASSOCIATED WITH BOSTON'S HOTEL (DEMOLISHED):
14 GUEST ROOMS X 0.7 SPACES = -9.8 SPACES

PARKING ASSOCIATED WITH EXISTING TIKI BAR (DEMOLISHED):
1325 SQ FT X 6 SPACES / 1000 SQ FT = -8 SPACES

TOTAL SPACES REQUIRED FOR BOSTON'S RESTAURANT: 312 SPACES

BOSTON'S NEW 2ND FLOOR DECK:
448 SQ FT • 6SPACES/1000 SQ FT = 2.7 SPACES

TOTAL REQUIRED PARKING: 34 SPACES

PROVIDED PARKING:

EXISTING STANDARD SPACES TO REMAIN: 38 SPACES
EXISTING HC SPACES TO REMAIN: 2 SPACES

TOTAL PROVIDED PARKING: 40 SPACES

ZONING: CENTRAL BUSINESS DISTRICT - BEACH AREA

| | | |
|----------------|---------------|-------------|
| SETBACKS: | REQUIRED | PROVIDED |
| FRONT: | 0' (ARCADED) | 0' |
| REAR: | 10' | 72'-10" |
| INTERIOR SIDE: | 0' | 14'-5" |
| SIDE STREET: | N/A | N/A |
| HEIGHT: | 25' MIN. -40' | MAX. 27'-2" |
| FLOORS: | N/A | 2 |

LEGAL DESCRIPTION:

DESCRIPTION:

LOTS 6, 7, 8, 9 AND 10, BLOCK 1, OCEAN PARK,
ACCORDING TO THE PLAT THEREOF, RECORDED IN PLAT
BOOK 5, PAGE 15 OF THE PUBLIC RECORDS OF PALM
BEACH COUNTY, FLORIDA.

EXCEPT THE WEST 2 FEET 8 INCHES OF LOTS 8, 9 AND
10, BLOCK 1, DEED TO THE CITY OF DELRAY BEACH FOR
STREET PURPOSES; AND ALSO EXCEPT THAT PART OF
LOTS 6 AND 7 LYING EAST OF THAT CERTAIN LINE AS
SHOWN UPON MAP ENTITLED "PLAT OF SURVEY FOR
ESTABLISHING A LINE TO SERVE IN THE PLACE OF WEST
BOUNDARY LINE OF OCEAN BOULEVARD IN FRACTIONAL
SECTION 16, TOWNSHIP 46 SOUTH, RANGE 43 EAST,
DELRAY BEACH, PALM BEACH COUNTY, FLORIDA" AS
RECORDED IN PLAT BOOK 20, PAGE 4 OF THE PUBLIC
RECORDS OF PALM BEACH COUNTY, FLORIDA.


DESCRIPTION:

LOTS 4, 5, 11, 12, AND 13; LOTS 14, 15 AND 16,
LESS THE WEST 2.67' FEET OF SAID LOTS 14, 15, AND
16; THE SOUTH 56 FEET OF LOT 17; THE SOUTH 56
FEET OF LOT 18; THE SOUTH 56 FEET OF LOT 19; AND
THAT PART OF SAID LOT 19, LYING SOUTHWESTERLY OF
THE ARC OF A CURVE CONCAVE NORTHEASTERLY WITH
A RADIUS OF 4 FEET, THE CENTER POINT OF SAID
CURVE BEING 4 FEET EAST OF THE WEST LINE OF SAID
LOT 19 AND 60 FEET NORTH OF THE SOUTH LINE OF
SAID LOT 19, ALL IN BLOCK 1, OCEAN PARK, DELRAY
BEACH, PALM BEACH COUNTY, FLORIDA, ACCORDING TO
THE PLAT THEREOF RECORDED IN PLAT BOOK 5 AT
PAGE 15 OF THE PUBLIC RECORDS OF PALM BEACH
COUNTY, FLORIDA, LESS AND EXCEPT THE RIGHT OF WAY
OF STATE ROAD A-1-A (OCEAN BOULEVARD) AS NOW
LAID OUT AND IN USE AND AS SHOWN ON THE PLAT OF
SURVEY FOR ESTABLISHING A LINE TO SERVE IN THE
PLACE OF THE WEST BOUNDARY LINE OF OCEAN
BOULEVARD AS RECORDED IN PLAT BOOK 20, PAGE 4,
PUBLIC RECORDS OF PALM BEACH COUNTY, FLORIDA.



LOCATION MAP

SCALE: N.T.S.

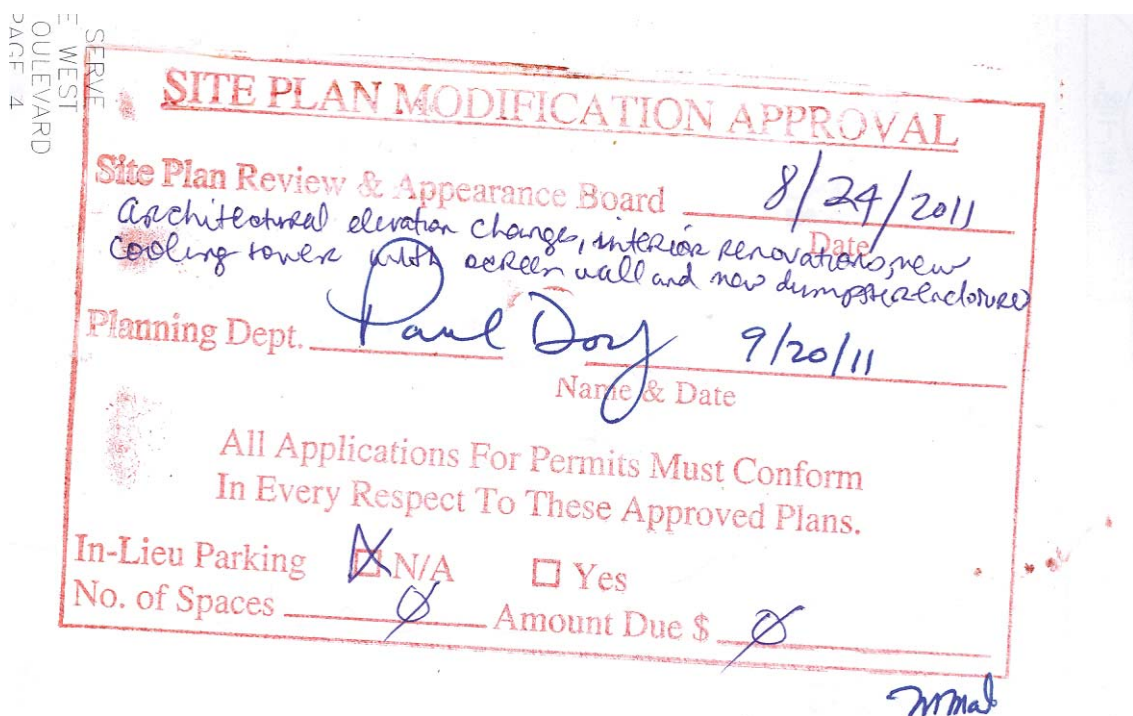

PERMIT SET 9.12.2011



CURRIE
SOWARDS
AGUILA
architects

Architecture • Planning
Interiors • Sustainable Design

AA26001584
185 NE 4TH AVENUE SUITE 101
DELRAY BEACH, FL 33483
T: (561) 276-4951 F: (561) 243-8184
E-MAIL: office@csa-architects.com

| | |
|--------------|---|
| ISSUED FOR : | . |
| BIDS | . |
| PERMIT | . |
| CONSTRUCTION | . |
| SEAL | . |

PROJECT TITLE
BOSTON'S
RESTAURANT
RENOVATION

| |
|--|
| REVISIONS |
| 1 -RESPONSE TO SPRAB COMMENTS 8/08/2019. |


THESE DRAWINGS ARE PREPARED PER ESTABLISHED INDUSTRY STANDARDS AND REPRESENT THE ARCHITECT AND ENGINEERS DESIGN CONCEPT. THEY ARE NOT INTENDED TO PROVIDE EVERY DETAIL OR CONDITION REQUIRED TO CONSTRUCT THE BUILDING. THE CONTRACTOR THROUGH SUBMITTALS AND OTHER COORDINATION EFFORTS IS FULLY RESPONSIBLE FOR PROVIDING A COMPLETE AND OPERATIONAL BUILDING WHETHER INDICATED ON THE PLANS OR NOT.

FILE NUMBER
100901A201_19.dwg

DRAWING TITLE
SECTION,
ELEVATION

| | |
|----------------------|----------------|
| DATE 7.12.2019 | DRAWN BY JC |
| JOB NUMBER 190703 | |
| DRAWING NUMBER | |

A3.01

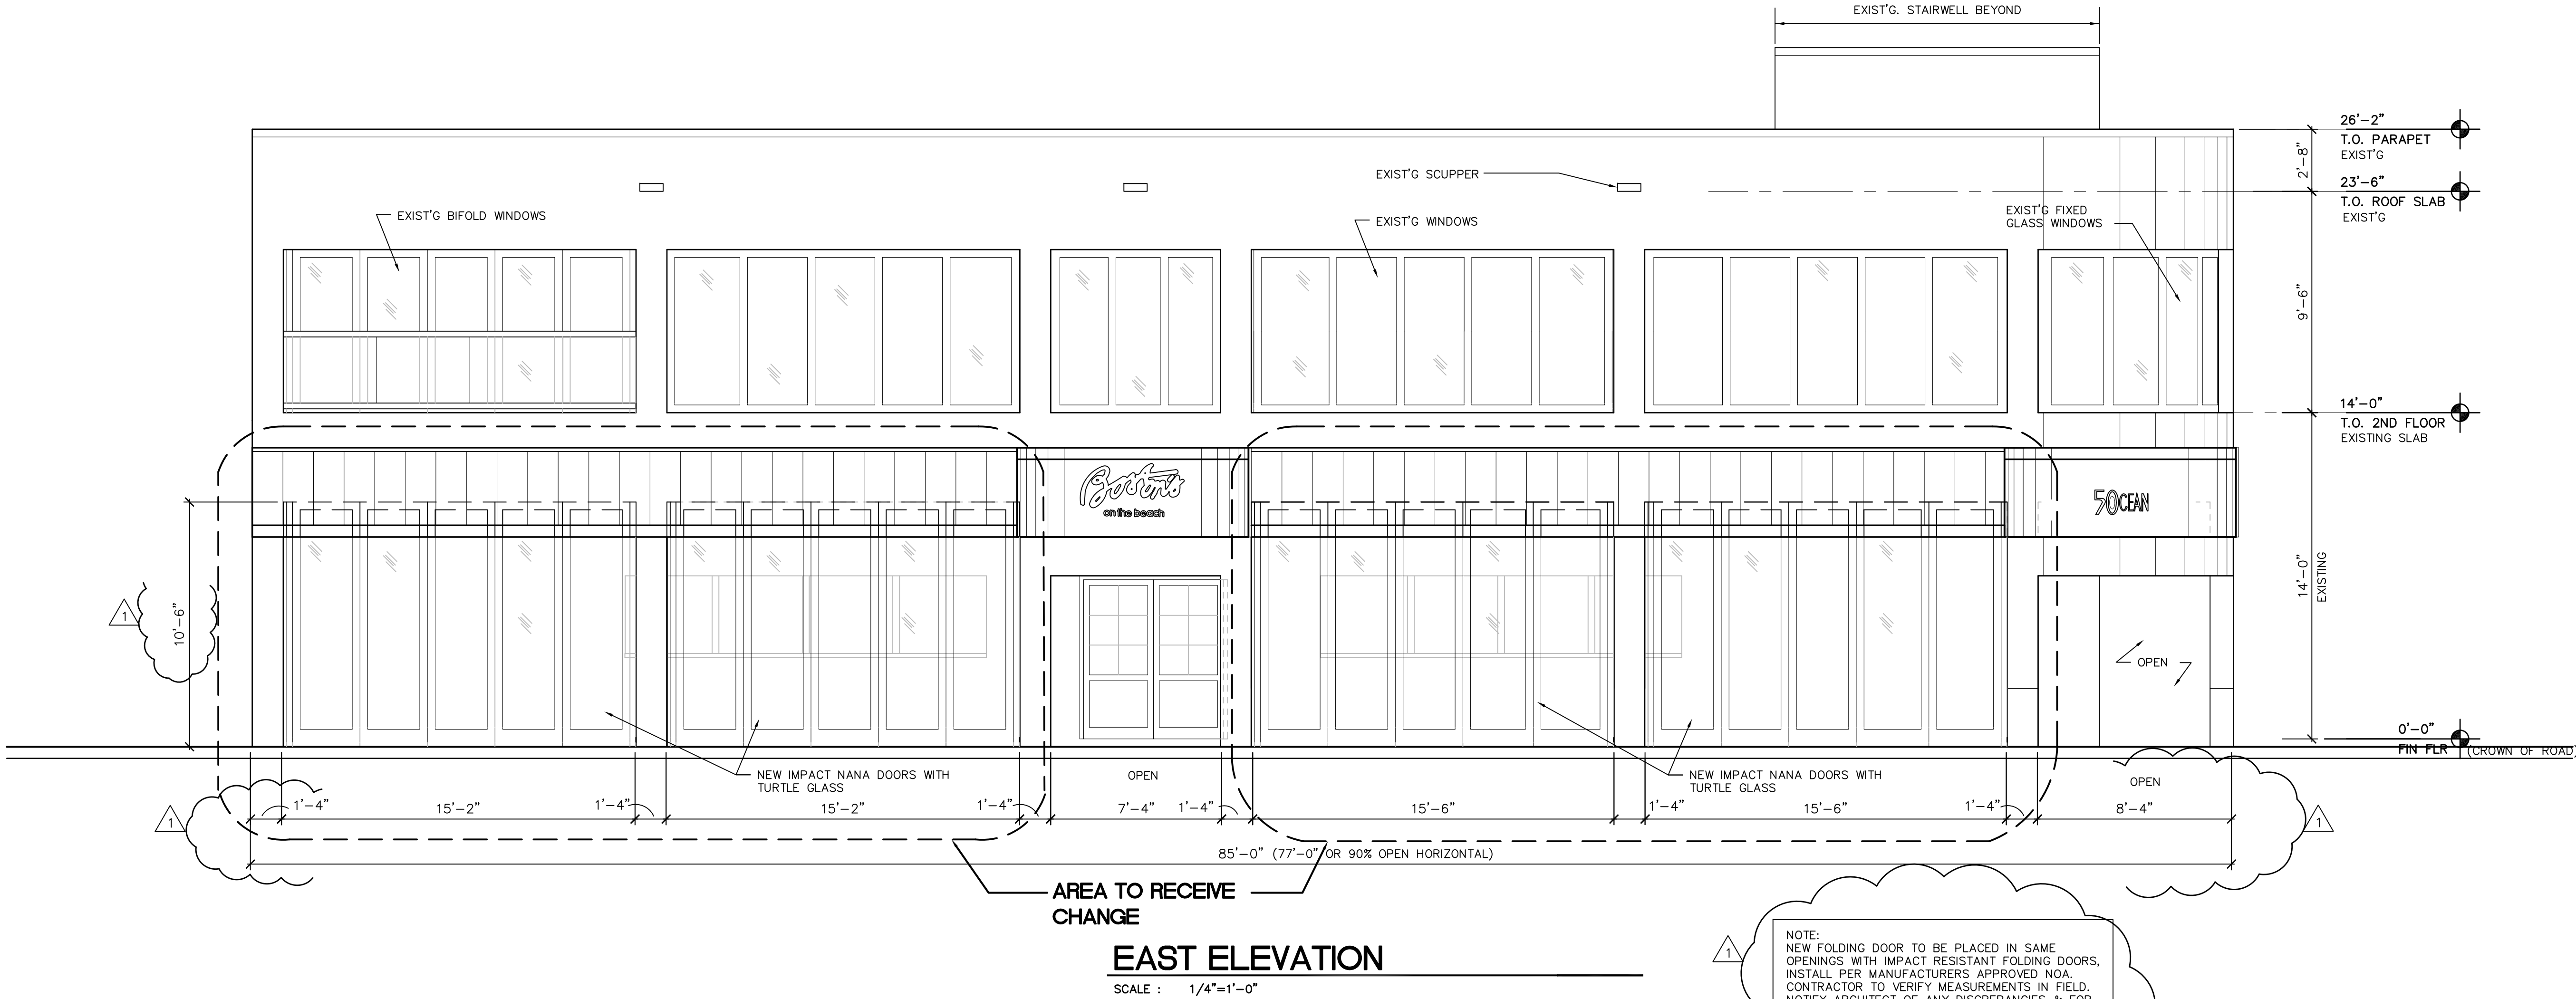

SPRAB 2019-7-12



AA26001584
185 NE 4TH AVENUE SUITE 101
DELRAY BEACH, FL 33483
T: (561) 276-4951 F: (561) 243-8184
E-MAIL: office@csa-architects.com

BOSTON'S RESTAURANT RENOVATION

THESE DRAWINGS ARE PREPARED PER ESTABLISHED INDUSTRY STANDARDS AND REPRESENT THE ARCHITECT AND ENGINEER'S DESIGN CONCEPT. THEY ARE NOT INTENDED TO PROVIDE EVERY DETAIL OR CONDITION REQUIRED TO CONSTRUCT THE BUILDING. THE CONTRACTOR THROUGH SUBMITTALS AND OTHER COORDINATION EFFORTS IS FULLY RESPONSIBLE FOR PROVIDING A COMPLETE AND OPERATIONAL BUILDING, WHETHER INDICATED ON THE PLANS OR NOT.


DRAWING TITLE

FIRST
FLOOR PLAN

A2.01

FIRST FLOOR PLAN

SCALE : $1/4"=1'-0"$

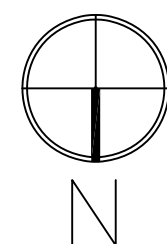



**CURRIE
SOWARDS
AGUILA**
architects

*Architecture • Planning
Interiors • Sustainable Design*
AA26001584
185 NE 4TH AVENUE SUITE 101
DELRAY BEACH, FL 33483
T: (561) 276-4951 F: (561) 243-8184
E-MAIL: office@csa-architects.com

ISSUED FOR :
BIDS
PERMIT
CONSTRUCTION
SEAL

PROJECT TITLE
**BOSTON'S
RESTAURANT
RENOVATION**

REVISIONS
1 -RESPONSE TO SPRAB
COMMENTS 8/08/2019.

THESE DRAWINGS ARE PREPARED PER
ESTABLISHED INDUSTRY STANDARDS AND
REPRESENT THE ARCHITECT AND ENGINEERS
DESIGN CONCEPT. THEY ARE NOT INTENDED
TO PROVIDE EVERY DETAIL OR CONDITION
REQUIRED TO CONSTRUCT THE BUILDING.
THE CONTRACTOR THROUGH SUBMITTALS
AND OTHER COORDINATION EFFORTS IS
FULLY RESPONSIBLE FOR PROVIDING A
COMPLETE AND OPERATIONAL BUILDING
WHETHER INDICATED ON THE PLANS OR NOT.


FILE NUMBER
100901A201_19.dwg

DRAWING TITLE
**EXTERIOR
ELEVATIONS**

DATE
7.12.2019
DRAWN BY
JC
JOB NUMBER
190703
DRAWING NUMBER
1


A3.02

SPRAB 2019-7-12

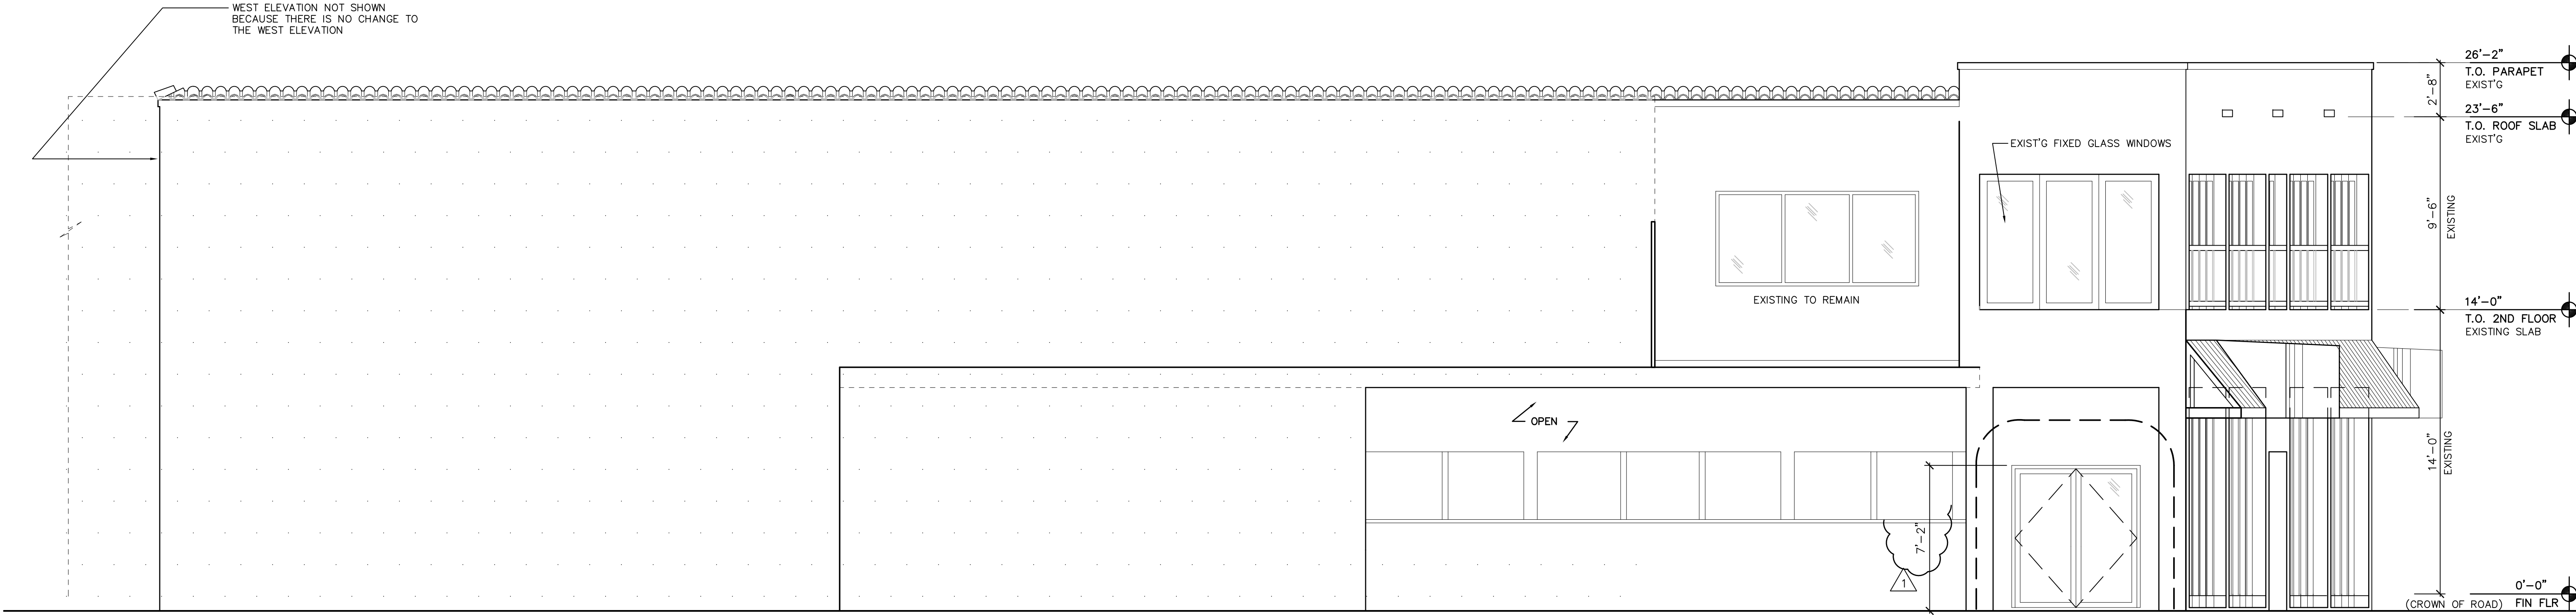

SOUTH ELEVATION

SCALE : 1/4"=1'-0"

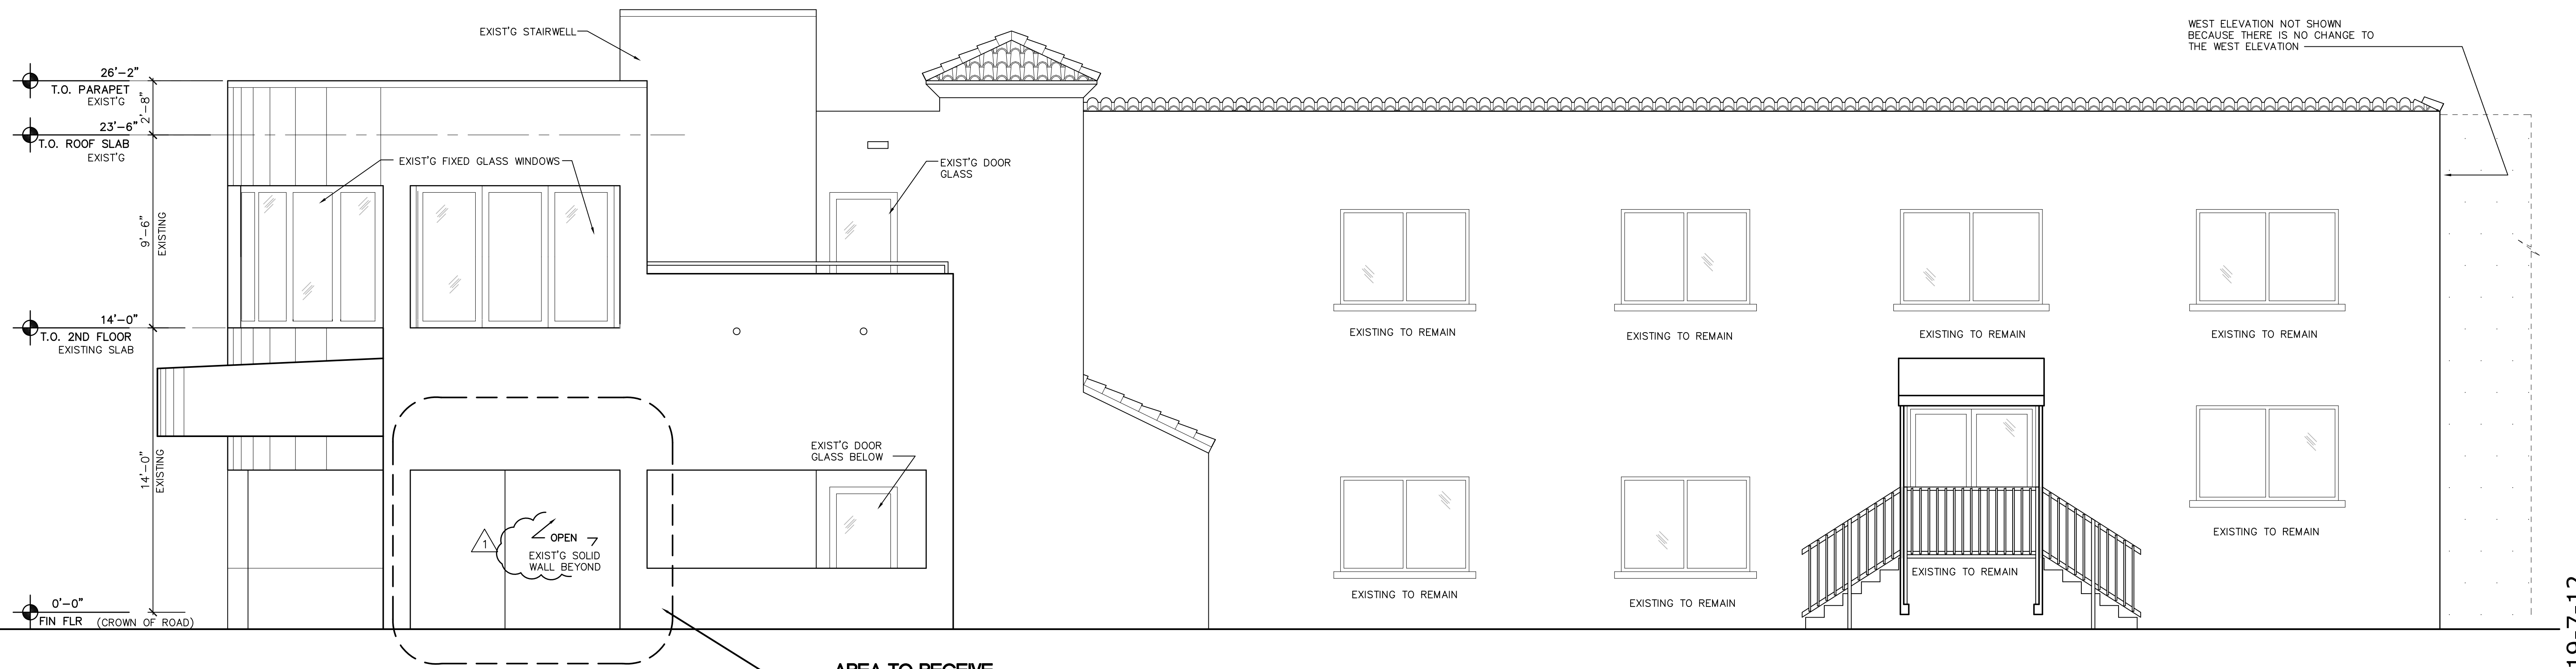

NORTH ELEVATION

SCALE : 1/4"=1'-0"



BEFORE



AFTER

BOSTON'S
Delray Beach, FL.

3d View

08/09/19

