


EX PROPERTY BOUNDARY LINES — – – — EX ADJACENT BOUNDARY LINES PROP PROPERTY BOUNDARY LINES EX STORM WATER LINE EX SANITARY SEWER LINE —S——— PROP SANITARY LINE -WI- PROP WATER SERVICE PROP STORM STRUCTURES

# WATER DISTRIBUTION NOTES:

- 1. CONTRACTOR SHALL FOLLOW GUIDELINES AND PROCEDURES OUTLINED BY UTILITY PROVIDER, AND HAVE UTILITY PROVIDER'S MANUAL ON-SITE AT ALL TIMES. THIS POLICY MANUAL SHALL BE CONSIDERED PART OF THE CONSTRUCTION DOCUMENTS AS IT PERTAINS TO APPROVED MATERIALS, INSTALLATION METHODS, INSPECTION NOTIFICATION AND AS-BUILT/PROJECT CLOSEOUT REQUIREMENTS.
- 2. ALL HIGH DENSITY POLYETHYLENE PIPE AND FITTINGS SHALL MEET THE REQUIREMENTS OF AASHTO M 294 LATEST REVISIONS. ALL PIPING TO BE NON-PERFORATED TUBING.
- 3. ALL PVC PIPE SHALL BE C900(SDR), AND ALL DIP PIPE SHALL BE C151 CLASS.
- 4. ALL WATER AND SEWER SYSTEM MATERIALS AND CONSTRUCTION SHALL BE IN ACCORDANCE WITH CITY OF DELRAY BEACH STANDARDS.
- 5. WATER AND SEWER MAIN HORIZONTAL AND VERTICAL SEPARATIONS SHALL COMPLY WITH PALM BEACH COUNTY CRITERIA/REQUIREMENTS, UNLESS OTHERWISE AGREED UPON BY THE CITY IN ADVANCE OF ANY APPLICABLE FIELD INSTALLATIONS.
- 6. ALL WATER MAINS SHALL BE INSTALLED WITH A MINIMUM PIPE COVER OF 36 INCHES FOR PVC AND 30 INCHES FOR DIP.
- 7. ALL DISINFECTION SHALL MEET DISINFECTION SPECS. (C651- 05) OR LATEST REVISION.
- 8. NO BENEFICIAL USE SHALL BE MADE OF THE PROPOSED WATER MAINS TO BE INSTALLED PER THIS PERMIT WITHOUT WRITTEN APPROVAL FROM THE FLORIDA DEPARTMENT OF HEALTH IN PALM BEACH COUNTY.
- 9. MIN. 12" VERTICAL SEPARATION REQUIRED BETWEEN WATER MAINS AND GAS, ELECTRIC, AND OTHER PUBLIC UTILITIES.

# SANITARY SEWER NOTES:

- 1. MATERIALS:
- A. ALL PVC SEWER PIPE AND FITTINGS SHALL BE NON-PRESSURE POLYVINYL CHLORIDE (PVC) PIPE CONFORMING TO ASTM D 3034, SDR 26, WITH PUSH-ON RUBBER GASKET JOINTS.
- B. ALL FITTINGS AND ACCESSORIES SHALL BE AS MANUFACTURED OR SUPPLIED BY THE PIPE MANUFACTURER OR APPROVED EQUAL. C. ALL SANITARY CLEANOUTS WITHIN PAVEMENT SHALL HAVE A LID THAT IS H20 LOADING.
- 2. INSTALLATION:
- A. PIPE AND FITTINGS:
- 1) SEWER PIPE SHALL BE INSTALLED IN ACCORDANCE WITH ASTM D2321, AND THE UNI-BELL PLASTICS PIPE ASSOCIATION'S "RECOMMENDED PRACTICE FOR THE INSTALLATION OF PVC SEWER PIPE".
- 2) BEDDING AND INITIAL BACKFILL (12 INCHES) OVER SEWER MAINS AND SERVICES SHALL BE SAND WITH NO ROCK LARGER THAN 1" IN DIAMETER. 3/4" WASHED ROCK WILL BE USED IN WATER OR WHERE UNSUITABLE BEDDING EXISTS. ALL OTHER FILL SHALL NOT HAVE ROCK LARGER THAN 6" IN DIAMETER.
- 3) SEWER PIPES SHALL BE INSTALLED WITH A MINIMUM OF 1% SLOPE. B. CLEANOUTS:
- 1) CLEANOUTS SHALL BE SET PLUMB TO LINE AND GRADE ON FIRM CLEAN SUBGRADE PROVIDING UNIFORM BEARING UNDER THE BASE. 2) ALL OPENINGS AND JOINTS SHALL BE SEALED WATER-TIGHT.
- C. SERVICE:
- 1) MINIMUM SLOPE OF ALL SERVICE LINES SHALL BE 1.00%.
- 2) EACH SERVICE CONNECTION SHALL BE PLUGGED WATER-TIGHT WITH AN APPROVED PLUG.
- 3) CONNECTION OF SERVICES TO BUILDING'S PLUMBING SHALL BE COORDINATED WITH THE ARCHITECTURAL DRAWINGS.
- 3. TESTING:
- A. AFTER CONSTRUCTION OF THE SEWER SYSTEM, THE ENGINEER MAY REQUIRE A VISUAL INFILTRATION AND/OR EXFILTRATION TEST TO BE PERFORMED ON THE ENTIRE SYSTEM OR ANY PART THEREOF.
- B. AN AIR TEST MAY BE SUBSTITUTED FOR THE WATER EXFILTRATION TEST, UPON APPROVAL OF THE ENGINEER.
- C. SEWER PIPE LEAKAGE ALLOWABLE SHALL NOT EXCEED 150 GALLONS PER DAY PER INCH DIAMETER PER MILE IN A TWO HOUR TEST PERIOD FOR ANY SECTION TESTED. NO VISIBLE LEAKAGE SHALL BE ALLOWED.
- D. CONTRACTOR IS RESPONSIBLE FOR CORRECTING ANY DEFICIENCIES PRIOR TO THE CERTIFICATION TO ANY AGENCY.
- E. GENERAL CONTRACTOR SHALL EMPLOY AN INDEPENDENT INSPECTOR FOR 100% CONTINUOUS INSPECTION OF THE BEDDING AND BACKFILL OPERATION. COMPACTION TESTS SHALL BE TAKEN AT THE BOTTOM OF TRENCH AND AT EACH LIFT OF BACKFILL.
- F. GENERAL CONTRACTOR SHALL EMPLOY A LICENSED SURVEYOR AS0BUILT TOP OF PIPE ELEVATIONS TAKEN WHEN BEDDING OPERATION IS 75% COMPLETE. THESE ELEVATIONS SHALL BE TAKEN AT POINTS OF CONNECTION, CHANGES IN DIRECTION AND AT MINIMUM 20' INTERVALS ALONG THE LENGTH OF THE PIPE. THESE ELEVATIONS SHALL BE RECORDED AS AS-BUILT DIMENSIONS ON SITE PLAN REVIEW BY PROJECT ENGINEER.
- G. ALL SANITARY LINES ARE TO BE FLUSHED PRIOR TO CONTRACTOR TURNOVER OF THE FACILITY.

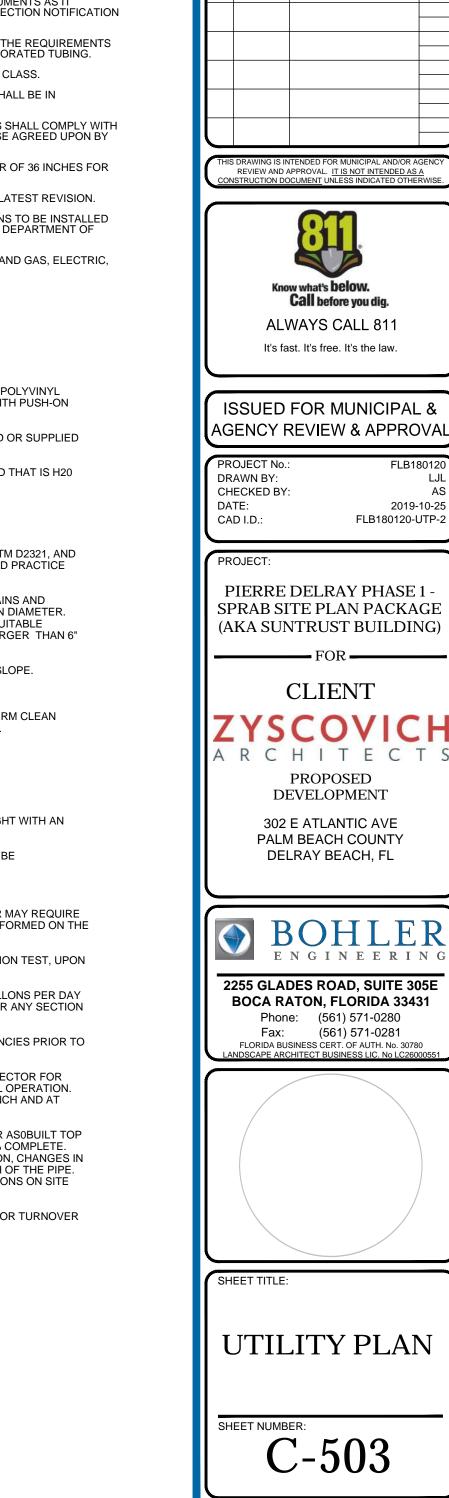

REVISIONS

2019-11-22 SPRAB COMMENTS

COMMENT

CITY OF DELRAY

BEACH COMMENTS

SPRAB COMMENTS

TEAM GFA

FLB18012

2019-10-25

REVISION 4 - 2019-11-22


COMMENTS


DATE


2019-08-23


2019-09-10


2019-11-22

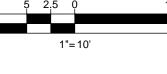

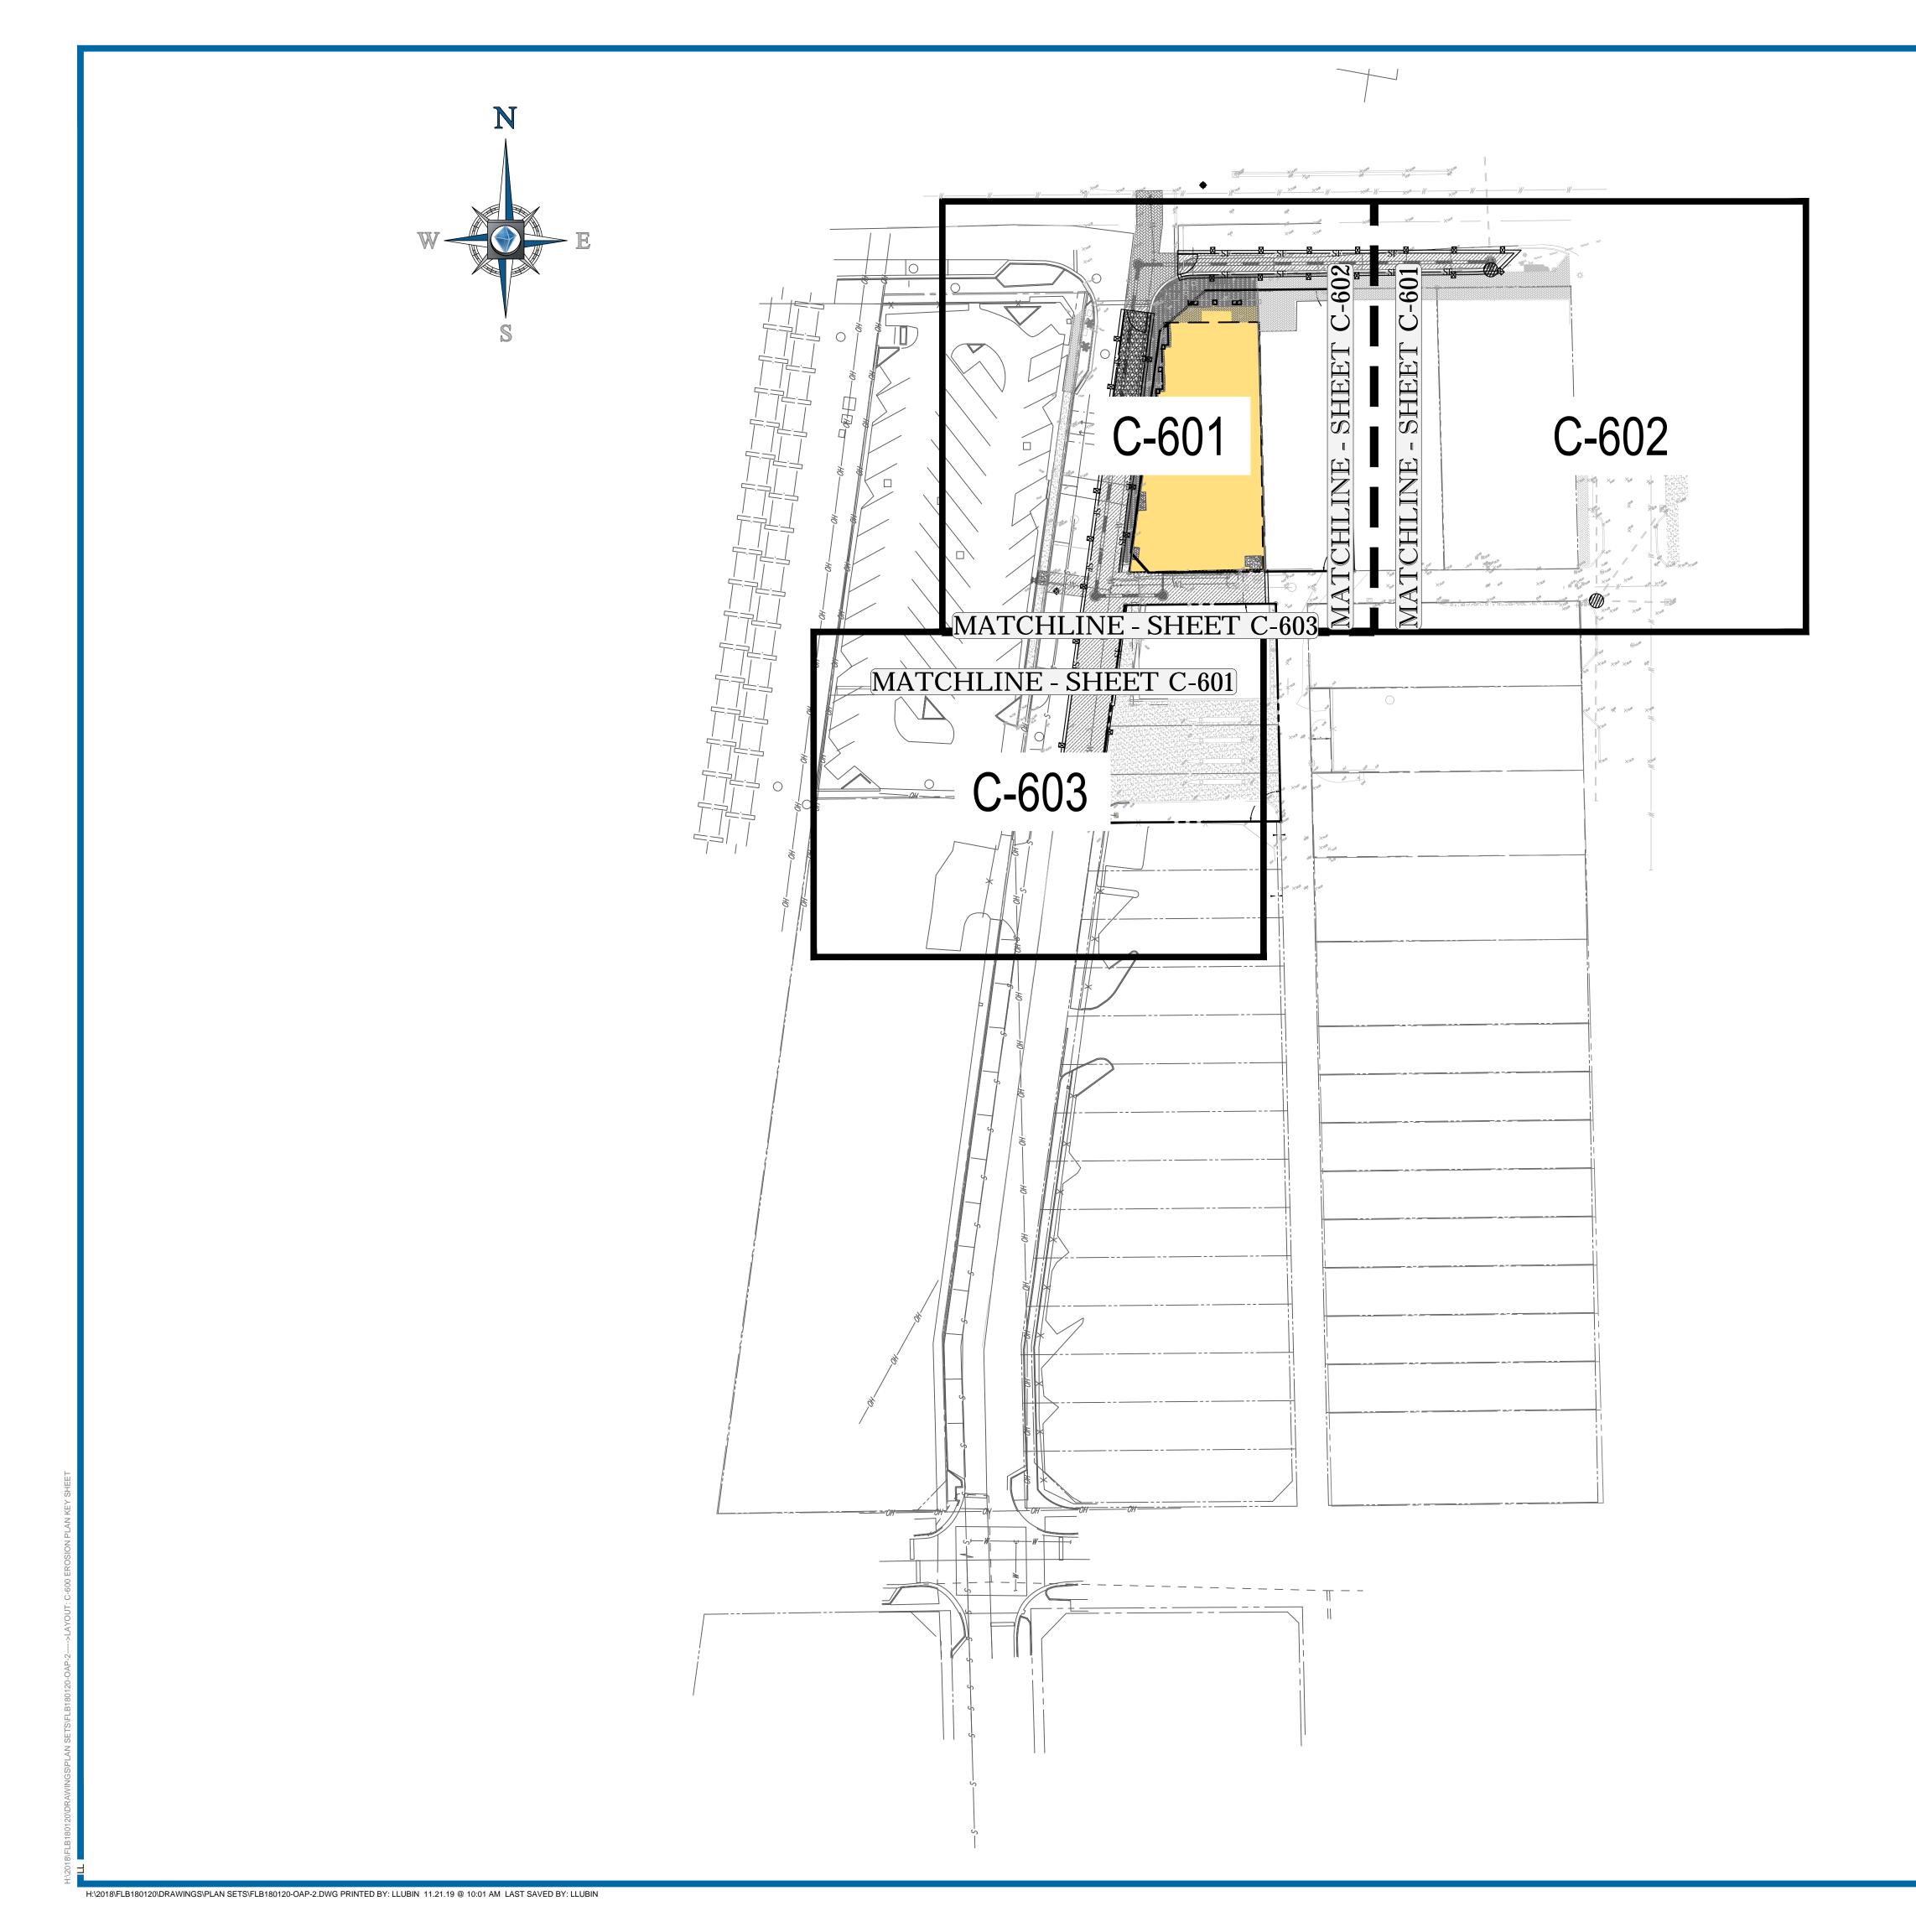

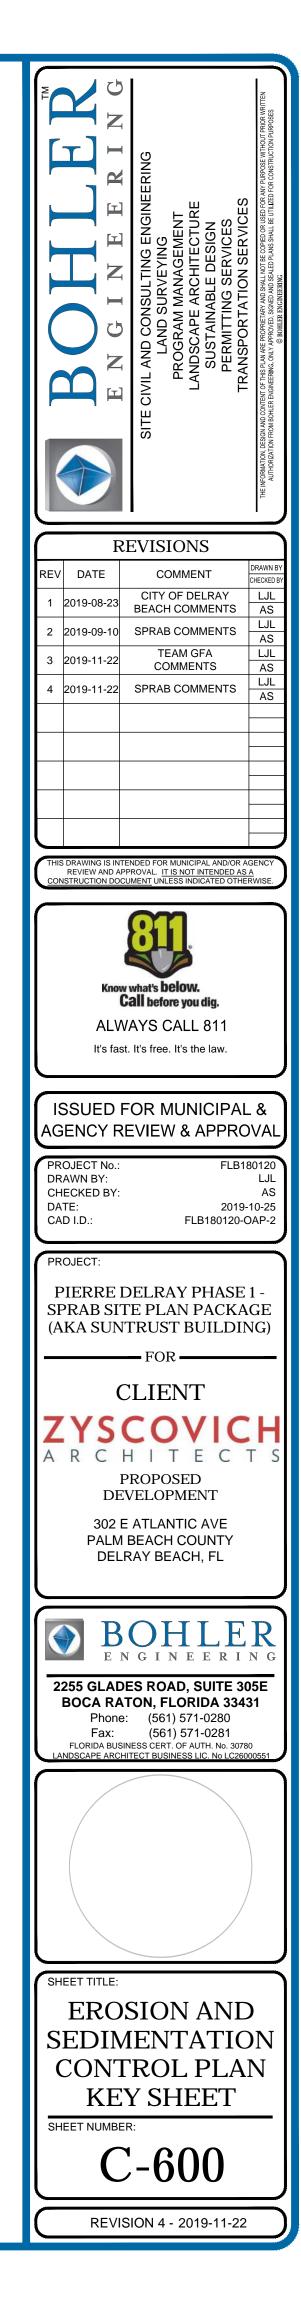

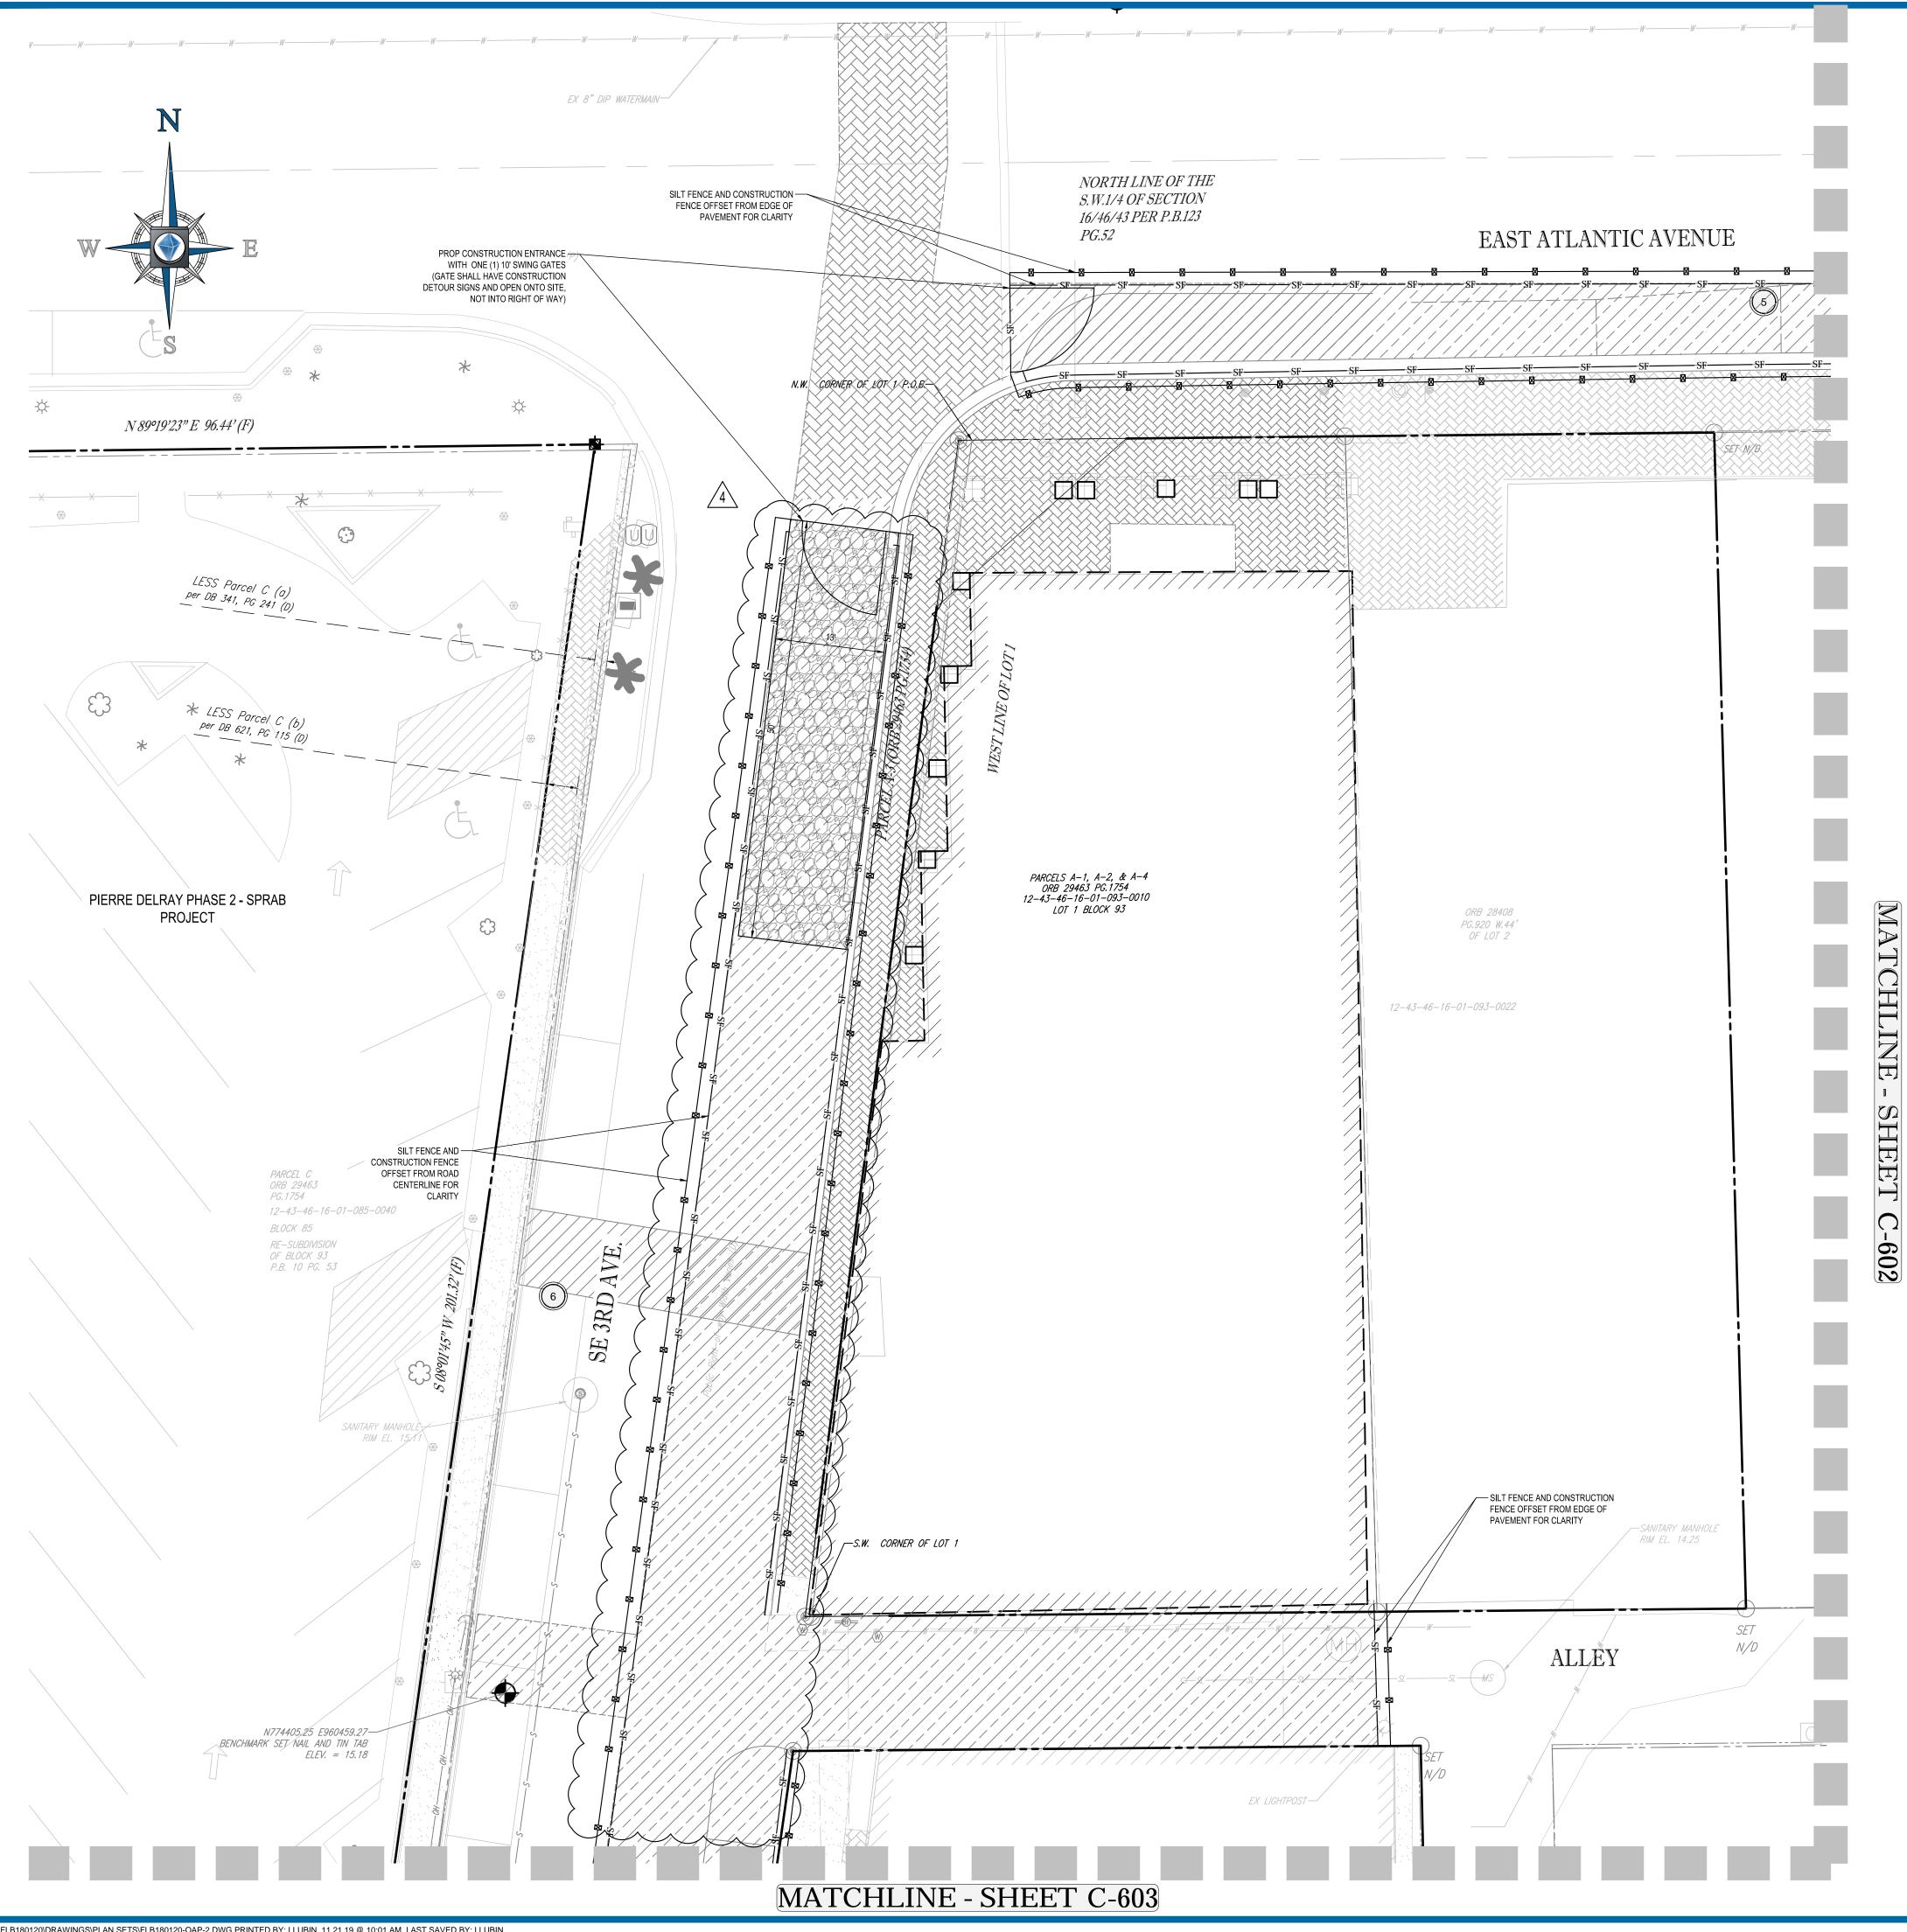

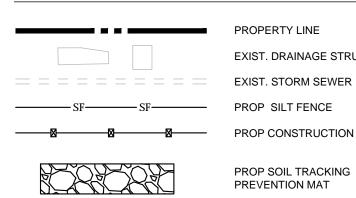

PROPERTY LINE EXIST. DRAINAGE STRUCTURES PROP SILT FENCE PROP CONSTRUCTION FENCE

> PROP SOIL TRACKING PREVENTION MAT

PROP INLET PROTECTION


#### POLLUTION PREVENTION NOTES:

- 1. EROSION AND SEDIMENT CONTROL BMP'S IN ADDITION TO THOSE PRESENTED ON THESE PLANS SHALL BE IMPLEMENTED AS NECESSARY TO PREVENT TURBID DISCHARGES FROM FLOWING ONTO ADJACENT PROPERTIES OR ROADWAYS, OFF SITE STORMWATER CONVEYANCES OR RECEIVING WATERS, OR ON SITE WETLANDS AND SURFACE WATERS. BMP'S SHALL BE DESIGNED, INSTALLED, AND MAINTAINED BY THE SITE OPERATOR TO ENSURE THAT OFF SITE SURFACE WATER QUALITY REMAINS CONSISTENT WITH STATE AND LOCAL REGULATIONS. [THE OPERATOR IS THE ENTITY THAT OWNS OR OPERATES THE CONSTRUCTION ACTIVITY AND HAS AUTHORITY TO CONTROL THOSE ACTIVITIES AT THE PROJECT NECESSARY TO ENSURE COMPLIANCE.]
- 2. OFF SITE SURFACE WATER DISCHARGES, OR DISCHARGES TO ONSITE WETLANDS OR SURFACE WATERS WITH TURBIDITY IN EXCESS OF 29 NEPHELOMETRIC TURBIDITY UNITS (NTU'S) ABOVE BACKGROUND LEVEL SHALL BE IMMEDIATELY CORRECTED. SUCH INCIDENTS SHALL BE REPORTED TO WATER RESOURCES WITHIN 24 HOURS OF THE OCCURRENCE. THE REPORT SHALL INCLUDE THE CAUSE OF THE DISCHARGE AND CORRECTIVE ACTIONS TAKEN.
- 3. THE OPERATOR SHALL ENSURE THAT ADJACENT PROPERTIES ARE NOT IMPACTED BY WIND EROSION, OR EMISSIONS OF UNCONFINED PARTICULATE MATTER IN ACCORDANCE WITH RULE 62-296.320(4)(C)1, F.A.C., BY TAKING APPROPRIATE MEASURES TO STABILIZE AFFECTED AREAS.
- 4. FUEL AND OTHER PETROLEUM PRODUCT SPILLS THAT ENTER STORMWATER DRAINS OR WATERBODIES, OR FUEL AND OTHER PETROLEUM PRODUCT SPILLS THAT ARE IN EXCESS OF 25 GALLONS SHALL BE CONTAINED, CLEANED UP, AND IMMEDIATELY REPORTED TO WATER RESOURCES. SMALLER GROUND SURFACE SPILLS SHALL BE CLEANED UP AS SOON AS PRACTICAL.
- 5. IF CONTAMINATED SOIL AND/OR GROUNDWATER IS DISCOVERED DURING DEVELOPMENT OF THE SITE, ALL ACTIVITY IN THE VICINITY OF THE CONTAMINATION SHALL IMMEDIATELY CEASE, AND WATER RESOURCES SHALL BE CONTACTED.
- 6. PRIOR TO DEMOLITION OF EXISTING ON SITE STRUCTURES AN ASBESTOS SURVEY AND/OR ASBESTOS NOTIFICATION MAY BE REQUIRED.
- 7. NATIONAL POLLUTANT DISCHARGE ELIMINATION SYSTEM: A. NPDES CONSTRUCTION GENERIC PERMIT COVERAGE SHALL BE OBTAINED AT LEAST 48 HOURS IN ADVANCE OF CONSTRUCTION COMMENCEMENT IN ACCORDANCE WITH RULE 62-621.300(4)(a), F.A.C
- B. A COPY OF THE CERTIFIED NPDES NOI, OR A COPY OF THE FDEP COVERAGE CONFIRMATION LETTER SHALL BE POSTED AT THE SITE IN ACCORDANCE WITH RULE 62-621.300(4)(A) PART III.C.2,
- F.A.C. C. A COPY OF THE CERTIFIED NPDES NOI, OR A COPY OF THE FDEP COVERAGE CONFIRMATION LETTER SHALL BE PROVIDED TO WATER RESOURCES IN ACCORDANCE WITH RULE 62-621.300(4)(a)PART III.D.1, F.A.C.
- D. THE SWPPP SHALL BE CERTIFIED IN ACCORDANCE WITH RULE 62-621.300(4)(a)PART V.D.6, F.A.C. E. A COPY OF THE SWPPP, AND COPIES OF THE INSPECTION AND MAINTENANCE RECORDS SHALL BE MAINTAINED AT THE PROJECT SITE, AND SHALL BE READILY AVAILABLE TO COUNTY OR STATE INSPECTORS.
- 8. THE DISCHARGE OF GROUNDWATER PRODUCED THROUGH DEWATERING, TO SURFACE WATERS, OR ANY PORTION OF THE MS4 WILL REQUIRE SEPARATE PERMITTING FROM THE FLORIDA DEPARTMENT OF ENVIRONMENTAL PROTECTION (DEP). PERMIT(S) SHALL BE OBTAINED PRIOR TO THE COMMENCEMENT OF DEWATERING.

## MAINTENANCE NOTES:


N.P.D.F.S. PERMIT COMPLIANCE REQUIRES INSPECTIONS EVERY 7 CALENDAR DAYS BY A NPDES QUALIFIED INSPECTOR AND PERIODIC INSPECTIONS WITHIN 24 HOURS OF ANY RAINFALL EVENT OF 0.5 INCHES OR GREATER. THESE INSPECTIONS MAY RESULT IN RECOMMENDATIONS FOR ROUTINE MAINTENANCE OF THE SOIL EROSION CONTROL DEVICES, AS WELL AS FURTHER MAINTENANCE AS OUTLINED BELOW.

- 1. THROUGHOUT THE CONSTRUCTION PERIOD, ALL MUD/SILT TRACKED ONTO EXISTING FDOT ROADS FROM THE SITE DUE TO CONSTRUCTION SHALL BE IMMEDIATELY REMOVED BY THE CONTRACTOR.
- 2. CATCH BASIN INLET AND CONCRETE FLUME FILTERS SHALL BE MAINTAINED CLEAN AT ALL TIMES THROUGHOUT THE CONSTRUCTION PERIOD. WEEKLY INSPECTIONS WILL BE PERFORMED EVERY 7 CALENDAR DAYS. IF A FILTER HAS HOLES OR IS INUNDATED WITH SEDIMENT, THE FILTER WILL REQUIRE REPLACEMENT.
- 3. CONSTRUCTION ACCESS AND TRACKING MAT MUST BE MAINTAINED AS NECESSARY. REPLENISH CRUSHED AGGREGATE IF PRESENT LAYER IS FILLED WITH SEDIMENT, POOLING WATER OR HAS RUTS. A NEW LAYER MAY BE ADDED IF OLD LAYERS BECOME COMPACTED.
- 4. SILT FENCE IS TO BE INSPECTED DAILY BY CONTRACTOR AND EVERY 7 CALENDAR DAYS BY NPDES QUALIFIED INSPECTOR. IF REPAIRS OR REPLACEMENT IS NECESSARY, IT SHALL BE PERFORMED IMMEDIATELY. THE SILT FENCE SHOULD BE TRENCHED IN, BACK-FILLED, AND STAPLED OR STAKED ACCORDING TO THE MANUFACTURER'S SPECIFICATIONS. MAINTENANCE INCLUDES THE REMOVING OF BUILT-UP SEDIMENT. WHEN THE SEDIMENT ACCUMULATES TO 1/3 OF THE HEIGHT OF THE FENCE, CONTRACTOR MAY HAVE TO REMOVE, REPLACE, RETRENCH, OR RE-BACKFILL THE FENCE IF IT FAILS. IT WOULD ALSO BE NECESSARY TO REINSTALL IF ANY PORTION OF THE FENCING WAS DAMAGED BY CONSTRUCTION MACHINERY.
- 5. SEEDING OR RESEEDING MAY BE REQUIRED IMMEDIATELY TO AREAS WHICH HAVE BEEN DAMAGED BY RUNOFF.
- 6. REMOVE ANY VISIBLE SEDIMENT FROM THE POND BOTTOM TO KEEP THE BASIN DESIGNED INFILTRATION PERFORMANCE
- 7. THE CONTRACTOR SHALL CONTINUOUSLY ENSURE THAT THE PERIMETER OF THE SITE, INCLUDING CONSTRUCTION ENTRANCES, IS SECURED FROM ALLOWING DEBRIS TO LEAVE THE SITE DUE TO CONSTRUCTION ACTIVITY OR RAINFALL EVENTS. A WEEKLY LOG SHALL BE UPDATED AND KEPT ON-SITE IN ACCORDANCE WITH THE NPDES PERMIT. BY BIDDING DOCUMENTS CONTRACTOR ACKNOWLEDGES HE/SHE IS AWARE OF NPDES GUIDELINES AND POLICIES AS WELL AS BEST MANAGEMENT PRACTICES AND ASSUMES SOLE RESPONSIBILITY FOR FINES IMPOSED BY GOVERNMENTAL AGENCIES DUE TO VIOLATIONS.

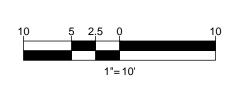

E N G I N E E R I N G E N G I N E E R I N G SITE CIVIL AND CONSULTING ENGINEERING LAND SURVEYING PROGRAM MANAGEMENT LANDSCAPE ARCHITECTURE SUSTAINABLE DESIGN PERMITTING SERVICES TRANSPORTATION SERVICES	THE INFORMATION, DESIGN AND CONTENT OF THIS PLAN ARE PROPRIETARY AND SHALL NOT BE COPIED OR USED FOR ANY PURPOSE WITHOUT PRIOR WRITTEN AUTHORIZATION FROM BOHLER ENGINEERING, ONLY APPROVED, SIGNED AND SEALED PLANS SHALL BE UTILIZED FOR CONSTRUCTION PURPOSES © BOHLER ENGINEERING, ONLY APPROVED, SIGNEERING, ONLY APPROVED, SIGNEERING,
	AWN BY
1  2019-08-23  CITY OF DELRAY BEACH COMMENTS    2  2019-09-10  SPRAB COMMENTS    3  2019-11-22  TEAM GFA COMMENTS	ECKED BY LJL AS LJL AS LJL AS LJL AS
THIS DRAWING IS INTENDED FOR MUNICIPAL AND/OR AGE REVIEW AND APPROVAL IT IS NOT INTENDED AS A	NCY
CONSTRUCTION DOCUMENT UNLESS INDICATED OTHERW	
Know what's below. Call before you dig. ALWAYS CALL 811 It's fast. It's free. It's the law.	
ISSUED FOR MUNICIPAL	&
AGENCY REVIEW & APPROV	/AL
PROJECT No.:      FLB180        DRAWN BY:         CHECKED BY:         DATE:      2019-10        CAD I.D.:      FLB180120-OA	LJL AS )-25
PROJECT: PIERRE DELRAY PHASE 1 SPRAB SITE PLAN PACKAG (AKA SUNTRUST BUILDING FOR	ΈE
CLIENT ZYSCOVIC A R C H I T E C T PROPOSED DEVELOPMENT 302 E ATLANTIC AVE PALM BEACH COUNTY DELRAY BEACH, FL	S
<b>BOHLES</b> ENGINEERIN <b>2255 GLADES ROAD, SUITE 305</b> <b>BOCA RATON, FLORIDA 33431</b> Phone: (561) 571-0280 Fax: (561) 571-0281 FLORIDA BUSINESS CERT. OF AUTH. No. 30780 LANDSCAPE ARCHITECT BUSINESS LIC. No LC260002	Ē
SHEET TITLE: EROSION AND SEDIMENTATION CONTROL PLAN PHASE I SHEET NUMBER:	
<u>C-601</u>	
REVISION 4 - 2019-11-22	



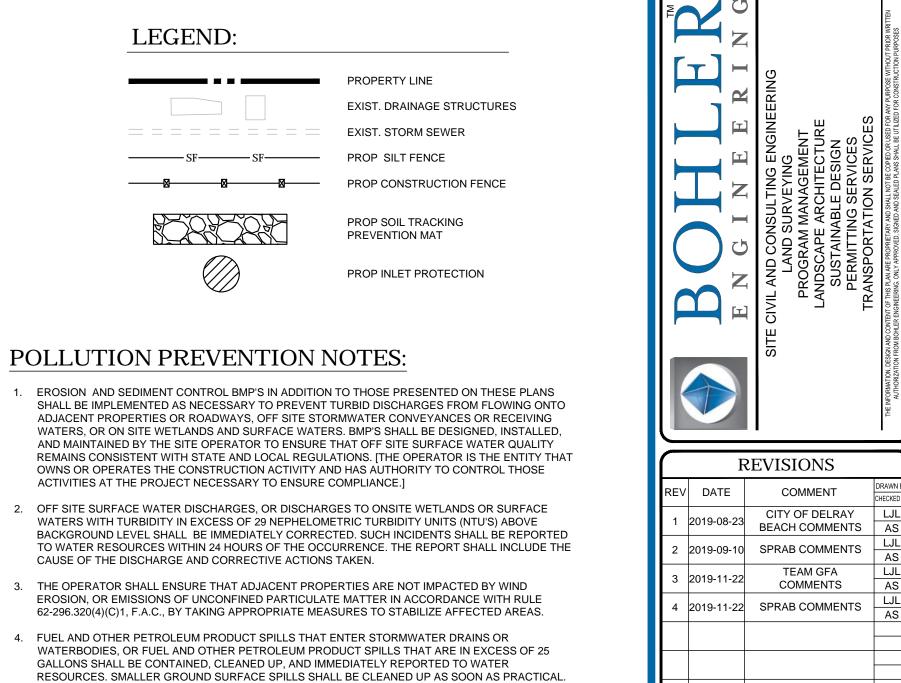


- 5. IF CONTAMINATED SOIL AND/OR GROUNDWATER IS DISCOVERED DURING DEVELOPMENT OF THE SITE, ALL ACTIVITY IN THE VICINITY OF THE CONTAMINATION SHALL IMMEDIATELY CEASE, AND WATER RESOURCES SHALL BE CONTACTED.
- 6. PRIOR TO DEMOLITION OF EXISTING ON SITE STRUCTURES AN ASBESTOS SURVEY AND/OR ASBESTOS NOTIFICATION MAY BE REQUIRED.
- NATIONAL POLLUTANT DISCHARGE ELIMINATION SYSTEM:
  A. NPDES CONSTRUCTION GENERIC PERMIT COVERAGE SHALL BE OBTAINED AT LEAST 48 HOURS IN ADVANCE OF CONSTRUCTION COMMENCEMENT IN ACCORDANCE WITH RULE 62-621.300(4)(a), F.A.C.
- B. A COPY OF THE CERTIFIED NPDES NOI, OR A COPY OF THE FDEP COVERAGE CONFIRMATION LETTER SHALL BE POSTED AT THE SITE IN ACCORDANCE WITH RULE 62-621.300(4)(A) PART III.C.2, F.A.C.
- C. A COPY OF THE CERTIFIED NPDES NOI, OR A COPY OF THE FDEP COVERAGE CONFIRMATION LETTER SHALL BE PROVIDED TO WATER RESOURCES IN ACCORDANCE WITH RULE 62-621.300(4)(a)PART III.D.1, F.A.C.
- D. THE SWPPP SHALL BE CERTIFIED IN ACCORDANCE WITH RULE 62-621.300(4)(a)PART V.D.6, F.A.C.
  E. A COPY OF THE SWPPP, AND COPIES OF THE INSPECTION AND MAINTENANCE RECORDS SHALL BE MAINTAINED AT THE PROJECT SITE, AND SHALL BE READILY AVAILABLE TO COUNTY OR STATE INSPECTORS.
- 8. THE DISCHARGE OF GROUNDWATER PRODUCED THROUGH DEWATERING, TO SURFACE WATERS, OR ANY PORTION OF THE MS4 WILL REQUIRE SEPARATE PERMITTING FROM THE FLORIDA DEPARTMENT OF ENVIRONMENTAL PROTECTION (DEP). PERMIT(S) SHALL BE OBTAINED PRIOR TO THE COMMENCEMENT OF DEWATERING.

## MAINTENANCE NOTES:

N.P.D.E.S. PERMIT COMPLIANCE REQUIRES INSPECTIONS EVERY 7 CALENDAR DAYS BY A NPDES QUALIFIED INSPECTOR AND PERIODIC INSPECTIONS WITHIN 24 HOURS OF ANY RAINFALL EVENT OF 0.5 INCHES OR GREATER. THESE INSPECTIONS MAY RESULT IN RECOMMENDATIONS FOR ROUTINE MAINTENANCE OF THE SOIL EROSION CONTROL DEVICES, AS WELL AS FURTHER MAINTENANCE AS OUTLINED BELOW.

- 1. THROUGHOUT THE CONSTRUCTION PERIOD, ALL MUD/SILT TRACKED ONTO EXISTING FDOT ROADS FROM THE SITE DUE TO CONSTRUCTION SHALL BE IMMEDIATELY REMOVED BY THE CONTRACTOR.
- 2. CATCH BASIN INLET AND CONCRETE FLUME FILTERS SHALL BE MAINTAINED CLEAN AT ALL TIMES THROUGHOUT THE CONSTRUCTION PERIOD. WEEKLY INSPECTIONS WILL BE PERFORMED EVERY 7 CALENDAR DAYS. IF A FILTER HAS HOLES OR IS INUNDATED WITH SEDIMENT, THE FILTER WILL REQUIRE REPLACEMENT.
- 3. CONSTRUCTION ACCESS AND TRACKING MAT MUST BE MAINTAINED AS NECESSARY. REPLENISH CRUSHED AGGREGATE IF PRESENT LAYER IS FILLED WITH SEDIMENT, POOLING WATER OR HAS RUTS. A NEW LAYER MAY BE ADDED IF OLD LAYERS BECOME COMPACTED.
- 4. SILT FENCE IS TO BE INSPECTED DAILY BY CONTRACTOR AND EVERY 7 CALENDAR DAYS BY NPDES QUALIFIED INSPECTOR. IF REPAIRS OR REPLACEMENT IS NECESSARY, IT SHALL BE PERFORMED IMMEDIATELY. THE SILT FENCE SHOULD BE TRENCHED IN, BACK-FILLED, AND STAPLED OR STAKED ACCORDING TO THE MANUFACTURER'S SPECIFICATIONS. MAINTENANCE INCLUDES THE REMOVING OF BUILT-UP SEDIMENT. WHEN THE SEDIMENT ACCUMULATES TO 1/3 OF THE HEIGHT OF THE FENCE, CONTRACTOR MAY HAVE TO REMOVE, REPLACE, RETRENCH, OR RE-BACKFILL THE FENCE IF IT FAILS. IT WOULD ALSO BE NECESSARY TO REINSTALL IF ANY PORTION OF THE FENCING WAS DAMAGED BY CONSTRUCTION MACHINERY.
- 5. SEEDING OR RESEEDING MAY BE REQUIRED IMMEDIATELY TO AREAS WHICH HAVE BEEN DAMAGED BY RUNOFF.
- 6. REMOVE ANY VISIBLE SEDIMENT FROM THE POND BOTTOM TO KEEP THE BASIN DESIGNED INFILTRATION PERFORMANCE
- 7. THE CONTRACTOR SHALL CONTINUOUSLY ENSURE THAT THE PERIMETER OF THE SITE, INCLUDING CONSTRUCTION ENTRANCES, IS SECURED FROM ALLOWING DEBRIS TO LEAVE THE SITE DUE TO CONSTRUCTION ACTIVITY OR RAINFALL EVENTS. A WEEKLY LOG SHALL BE UPDATED AND KEPT ON-SITE IN ACCORDANCE WITH THE NPDES PERMIT. BY BIDDING DOCUMENTS CONTRACTOR ACKNOWLEDGES HE/SHE IS AWARE OF NPDES GUIDELINES AND POLICIES AS WELL AS BEST MANAGEMENT PRACTICES AND ASSUMES SOLE RESPONSIBILITY FOR FINES IMPOSED BY GOVERNMENTAL AGENCIES DUE TO VIOLATIONS.

10 5 2.5 0 1 1"= 10'

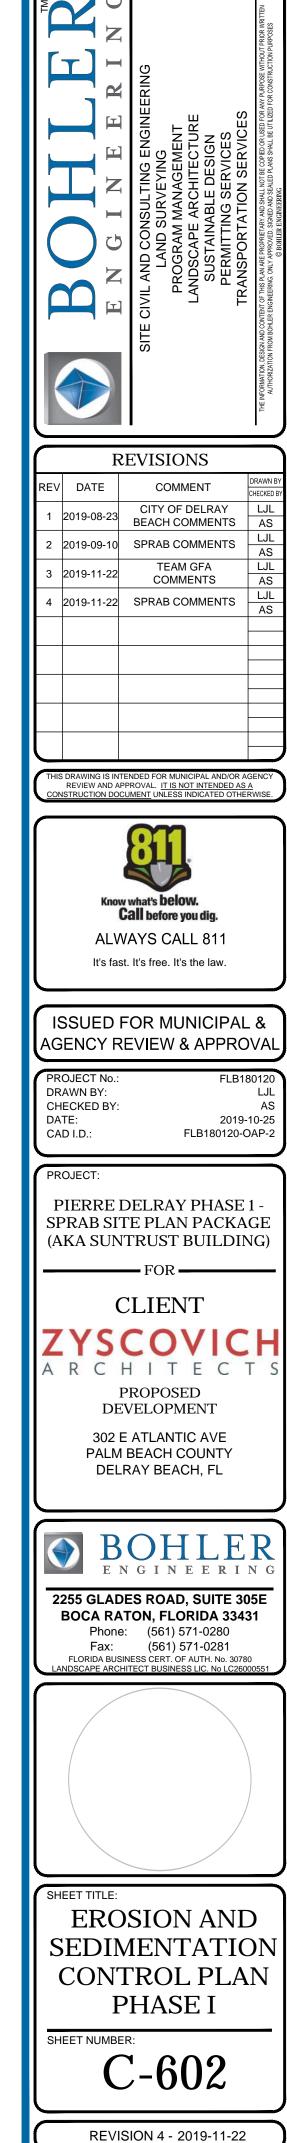



LEGEND:	
	PROPERTY LINE
	EXIST. DRAINAGE STRUCTURES
	EXIST. STORM SEWER
SF SF	PROP SILT FENCE
<u> </u>	PROP CONSTRUCTION FENCE
508,08,0	PROP SOIL TRACKING PREVENTION MAT
$\bigcirc$	PROP INLET PROTECTION


## POLLUTION PREVENTION NOTES:

- 1. EROSION AND SEDIMENT CONTROL BMP'S IN ADDITION TO THOSE PRESENTED ON THESE PLANS SHALL BE IMPLEMENTED AS NECESSARY TO PREVENT TURBID DISCHARGES FROM FLOWING ONTO ADJACENT PROPERTIES OR ROADWAYS, OFF SITE STORMWATER CONVEYANCES OR RECEIVING WATERS, OR ON SITE WETLANDS AND SURFACE WATERS. BMP'S SHALL BE DESIGNED, INSTALLED, AND MAINTAINED BY THE SITE OPERATOR TO ENSURE THAT OFF SITE SURFACE WATER QUALITY REMAINS CONSISTENT WITH STATE AND LOCAL REGULATIONS. [THE OPERATOR IS THE ENTITY THAT OWNS OR OPERATES THE CONSTRUCTION ACTIVITY AND HAS AUTHORITY TO CONTROL THOSE ACTIVITIES AT THE PROJECT NECESSARY TO ENSURE COMPLIANCE.]
- 2. OFF SITE SURFACE WATER DISCHARGES, OR DISCHARGES TO ONSITE WETLANDS OR SURFACE WATERS WITH TURBIDITY IN EXCESS OF 29 NEPHELOMETRIC TURBIDITY UNITS (NTU'S) ABOVE BACKGROUND LEVEL SHALL BE IMMEDIATELY CORRECTED. SUCH INCIDENTS SHALL BE REPORTED TO WATER RESOURCES WITHIN 24 HOURS OF THE OCCURRENCE. THE REPORT SHALL INCLUDE THE CAUSE OF THE DISCHARGE AND CORRECTIVE ACTIONS TAKEN.
- 3. THE OPERATOR SHALL ENSURE THAT ADJACENT PROPERTIES ARE NOT IMPACTED BY WIND EROSION, OR EMISSIONS OF UNCONFINED PARTICULATE MATTER IN ACCORDANCE WITH RULE 62-296.320(4)(C)1, F.A.C., BY TAKING APPROPRIATE MEASURES TO STABILIZE AFFECTED AREAS.
- 4. FUEL AND OTHER PETROLEUM PRODUCT SPILLS THAT ENTER STORMWATER DRAINS OR WATERBODIES, OR FUEL AND OTHER PETROLEUM PRODUCT SPILLS THAT ARE IN EXCESS OF 25 GALLONS SHALL BE CONTAINED, CLEANED UP, AND IMMEDIATELY REPORTED TO WATER RESOURCES. SMALLER GROUND SURFACE SPILLS SHALL BE CLEANED UP AS SOON AS PRACTICAL.
- 5. IF CONTAMINATED SOIL AND/OR GROUNDWATER IS DISCOVERED DURING DEVELOPMENT OF THE SITE, ALL ACTIVITY IN THE VICINITY OF THE CONTAMINATION SHALL IMMEDIATELY CEASE, AND WATER RESOURCES SHALL BE CONTACTED.
- 6. PRIOR TO DEMOLITION OF EXISTING ON SITE STRUCTURES AN ASBESTOS SURVEY AND/OR ASBESTOS NOTIFICATION MAY BE REQUIRED.
- 7. NATIONAL POLLUTANT DISCHARGE ELIMINATION SYSTEM: A. NPDES CONSTRUCTION GENERIC PERMIT COVERAGE SHALL BE OBTAINED AT LEAST 48 HOURS IN ADVANCE OF CONSTRUCTION COMMENCEMENT IN ACCORDANCE WITH RULE 62-621.300(4)(a), F.A.C.
- B. A COPY OF THE CERTIFIED NPDES NOI, OR A COPY OF THE FDEP COVERAGE CONFIRMATION LETTER SHALL BE POSTED AT THE SITE IN ACCORDANCE WITH RULE 62-621.300(4)(A) PART III.C.2, F.A.C.
- C. A COPY OF THE CERTIFIED NPDES NOI, OR A COPY OF THE FDEP COVERAGE CONFIRMATION LETTER SHALL BE PROVIDED TO WATER RESOURCES IN ACCORDANCE WITH RULE
- 62-621.300(4)(a)PART III.D.1, F.A.C. D. THE SWPPP SHALL BE CERTIFIED IN ACCORDANCE WITH RULE 62-621.300(4)(a)PART V.D.6, F.A.C. E. A COPY OF THE SWPPP, AND COPIES OF THE INSPECTION AND MAINTENANCE RECORDS SHALL BE MAINTAINED AT THE PROJECT SITE, AND SHALL BE READILY AVAILABLE TO COUNTY OR STATE INSPECTORS.
- 8. THE DISCHARGE OF GROUNDWATER PRODUCED THROUGH DEWATERING, TO SURFACE WATERS, OR ANY PORTION OF THE MS4 WILL REQUIRE SEPARATE PERMITTING FROM THE FLORIDA DEPARTMENT OF ENVIRONMENTAL PROTECTION (DEP). PERMIT(S) SHALL BE OBTAINED PRIOR TO THE COMMENCEMENT OF DEWATERING.


## MAINTENANCE NOTES:


N.P.D.E.S. PERMIT COMPLIANCE REQUIRES INSPECTIONS EVERY 7 CALENDAR DAYS BY A NPDES QUALIFIED INSPECTOR AND PERIODIC INSPECTIONS WITHIN 24 HOURS OF ANY RAINFALL EVENT OF 0.5 INCHES OR GREATER. THESE INSPECTIONS MAY RESULT IN RECOMMENDATIONS FOR ROUTINE MAINTENANCE OF THE SOIL EROSION CONTROL DEVICES, AS WELL AS FURTHER MAINTENANCE AS OUTLINED BELOW.

- 1. THROUGHOUT THE CONSTRUCTION PERIOD, ALL MUD/SILT TRACKED ONTO EXISTING FDOT ROADS FROM THE SITE DUE TO CONSTRUCTION SHALL BE IMMEDIATELY REMOVED BY THE CONTRACTOR.
- 2. CATCH BASIN INLET AND CONCRETE FLUME FILTERS SHALL BE MAINTAINED CLEAN AT ALL TIMES THROUGHOUT THE CONSTRUCTION PERIOD. WEEKLY INSPECTIONS WILL BE PERFORMED EVERY 7 CALENDAR DAYS. IF A FILTER HAS HOLES OR IS INUNDATED WITH SEDIMENT, THE FILTER WILL REQUIRE REPLACEMENT.
- 3. CONSTRUCTION ACCESS AND TRACKING MAT MUST BE MAINTAINED AS NECESSARY. REPLENISH CRUSHED AGGREGATE IF PRESENT LAYER IS FILLED WITH SEDIMENT, POOLING WATER OR HAS RUTS. A NEW LAYER MAY BE ADDED IF OLD LAYERS BECOME COMPACTED.
- 4. SILT FENCE IS TO BE INSPECTED DAILY BY CONTRACTOR AND EVERY 7 CALENDAR DAYS BY NPDES QUALIFIED INSPECTOR. IF REPAIRS OR REPLACEMENT IS NECESSARY, IT SHALL BE PERFORMED IMMEDIATELY. THE SILT FENCE SHOULD BE TRENCHED IN, BACK-FILLED, AND STAPLED OR STAKED ACCORDING TO THE MANUFACTURER'S SPECIFICATIONS. MAINTENANCE INCLUDES THE REMOVING OF BUILT-UP SEDIMENT. WHEN THE SEDIMENT ACCUMULATES TO 1/3 OF THE HEIGHT OF THE FENCE, CONTRACTOR MAY HAVE TO REMOVE, REPLACE, RETRENCH, OR RE-BACKFILL THE FENCE IF IT FAILS. IT WOULD ALSO BE NECESSARY TO REINSTALL IF ANY PORTION OF THE FENCING WAS DAMAGED BY CONSTRUCTION MACHINERY.
- 5. SEEDING OR RESEEDING MAY BE REQUIRED IMMEDIATELY TO AREAS WHICH HAVE BEEN DAMAGED BY RUNOFF.
- 6. REMOVE ANY VISIBLE SEDIMENT FROM THE POND BOTTOM TO KEEP THE BASIN DESIGNED INFILTRATION PERFORMANCE
- 7. THE CONTRACTOR SHALL CONTINUOUSLY ENSURE THAT THE PERIMETER OF THE SITE, INCLUDING CONSTRUCTION ENTRANCES, IS SECURED FROM ALLOWING DEBRIS TO LEAVE THE SITE DUE TO CONSTRUCTION ACTIVITY OR RAINFALL EVENTS. A WEEKLY LOG SHALL BE UPDATED AND KEPT ON-SITE IN ACCORDANCE WITH THE NPDES PERMIT. BY BIDDING DOCUMENTS CONTRACTOR ACKNOWLEDGES HE/SHE IS AWARE OF NPDES GUIDELINES AND POLICIES AS WELL AS BEST MANAGEMENT PRACTICES AND ASSUMES SOLE RESPONSIBILITY FOR FINES IMPOSED BY GOVERNMENTAL AGENCIES DUE TO VIOLATIONS.

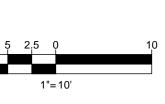

<image/> <image/>
REVISIONS
REV  DATE  COMMENT  DRAWN BY CHECKED BY    1  2019-08-23  CITY OF DELRAY BEACH COMMENTS  LJL    2  2019-09-10  SPRAB COMMENTS  LJL    3  2019-11-22  TEAM GFA COMMENTS  LJL    4  2019-11-22  SPRAB COMMENTS  LJL    AS
THIS DRAWING IS INTENDED FOR MUNICIPAL AND/OR AGENCY
REVIEW AND APPROVAL. IT IS NOT INTENDED AS A CONSTRUCTION DOCUMENT UNLESS INDICATED OTHERWISE.
Know what's below. Call before you dig. ALWAYS CALL 811 It's fast. It's free. It's the law.
ISSUED FOR MUNICIPAL &
AGENCY REVIEW & APPROVAL
PROJECT No.:      FLB180120        DRAWN BY:      LJL        CHECKED BY:      AS        DATE:      2019-10-25        CAD I.D.:      FLB180120-OAP-2
PROJECT: PIERRE DELRAY PHASE 1 - SPRAB SITE PLAN PACKAGE (AKA SUNTRUST BUILDING) FOR CLIENT CLIENT STANDARY SEACH I T E C T S PROPOSED DEVELOPMENT 302 E ATLANTIC AVE PALM BEACH COUNTY DELRAY BEACH, FL
<b>BOHLER</b> ENGINEERING <b>2255 GLADES ROAD, SUITE 305E</b> <b>BOCA RATON, FLORIDA 33431</b> Phone: (561) 571-0280 Fax: (561) 571-0281 FLORIDA BUSINESS CERT. OF AUTH. No. 30780 LANDSCAPE ARCHITECT BUSINESS LIC. No LC26000551
SHEET TITLE: EROSION AND SEDIMENTATION CONTROL PLAN PHASE I SHEET NUMBER:
C-603
REVISION 4 - 2019-11-22

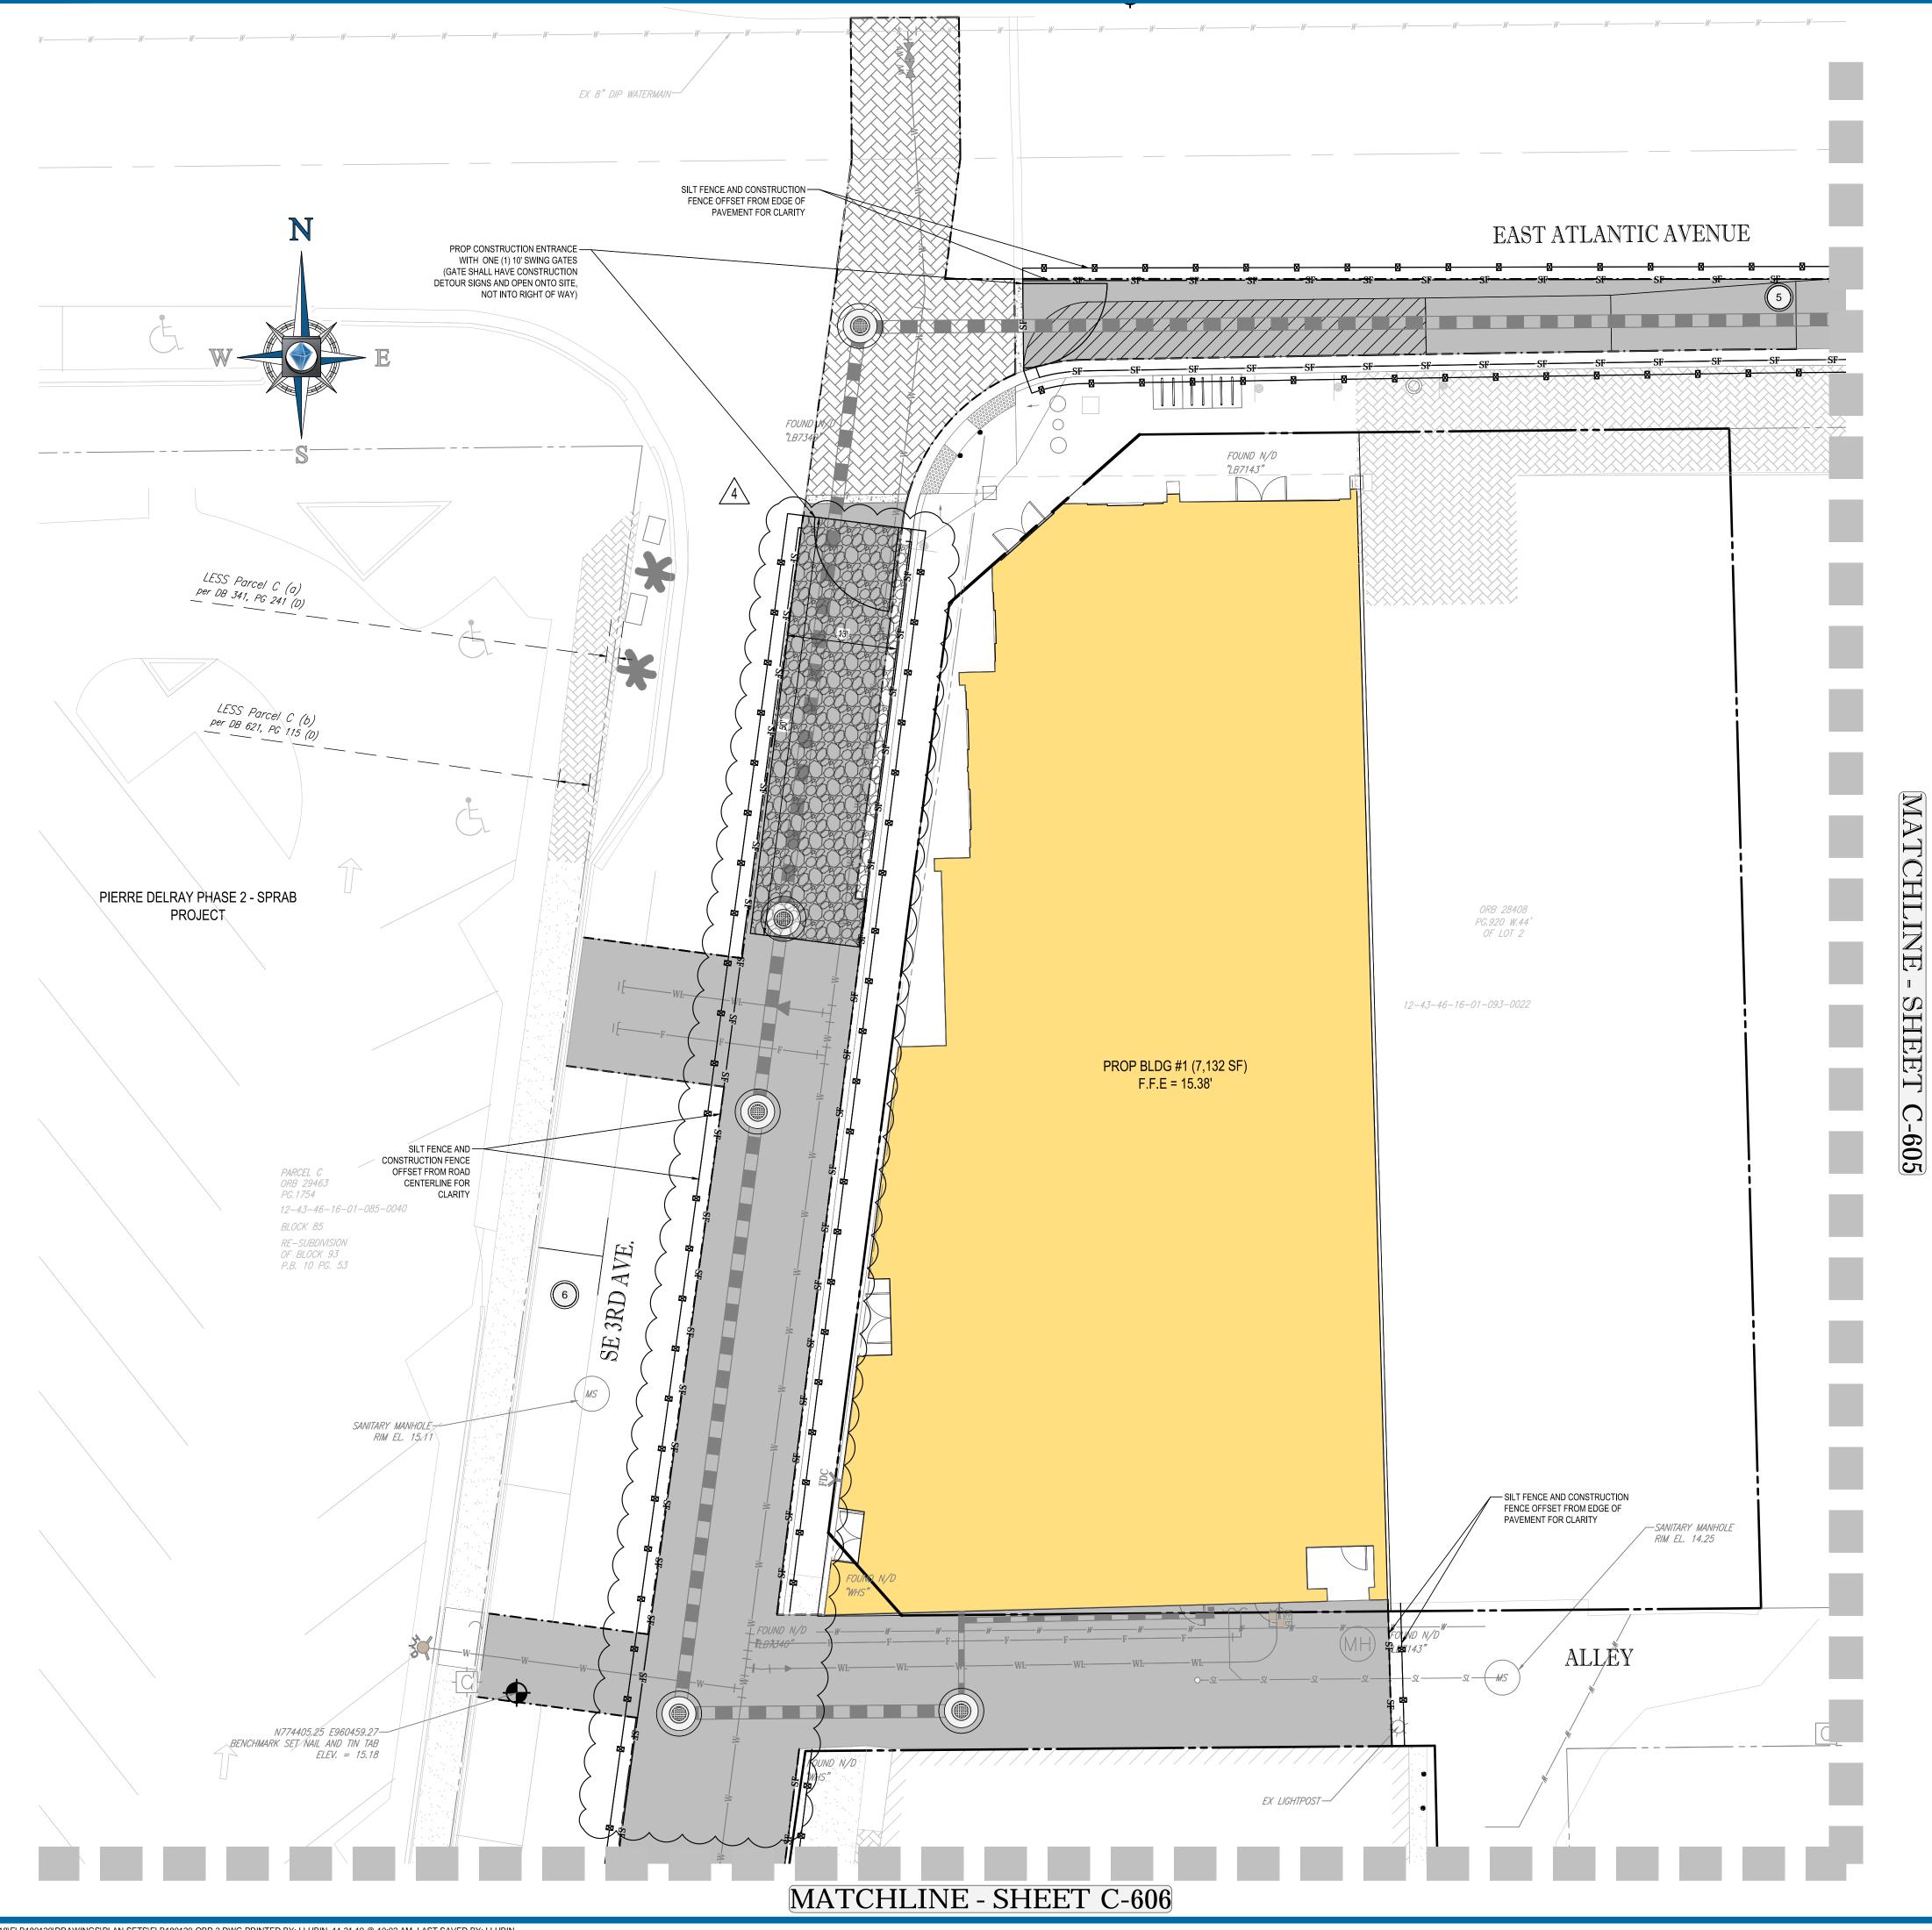

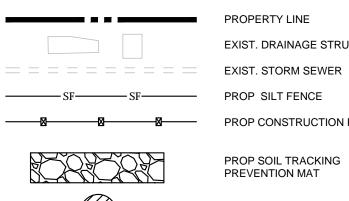

PROPERTY LINE EXIST. DRAINAGE STRUCTURES PROP CONSTRUCTION FENCE

> PROP SOIL TRACKING PREVENTION MAT

PROP INLET PROTECTION


## POLLUTION PREVENTION NOTES:

- 1. EROSION AND SEDIMENT CONTROL BMP'S IN ADDITION TO THOSE PRESENTED ON THESE PLANS SHALL BE IMPLEMENTED AS NECESSARY TO PREVENT TURBID DISCHARGES FROM FLOWING ONTO ADJACENT PROPERTIES OR ROADWAYS, OFF SITE STORMWATER CONVEYANCES OR RECEIVING WATERS, OR ON SITE WETLANDS AND SURFACE WATERS. BMP'S SHALL BE DESIGNED, INSTALLED, AND MAINTAINED BY THE SITE OPERATOR TO ENSURE THAT OFF SITE SURFACE WATER QUALITY REMAINS CONSISTENT WITH STATE AND LOCAL REGULATIONS. ITHE OPERATOR IS THE ENTITY THAT OWNS OR OPERATES THE CONSTRUCTION ACTIVITY AND HAS AUTHORITY TO CONTROL THOSE ACTIVITIES AT THE PROJECT NECESSARY TO ENSURE COMPLIANCE.]
- 2. OFF SITE SURFACE WATER DISCHARGES, OR DISCHARGES TO ONSITE WETLANDS OR SURFACE WATERS WITH TURBIDITY IN EXCESS OF 29 NEPHELOMETRIC TURBIDITY UNITS (NTU'S) ABOVE BACKGROUND LEVEL SHALL BE IMMEDIATELY CORRECTED. SUCH INCIDENTS SHALL BE REPORTED TO WATER RESOURCES WITHIN 24 HOURS OF THE OCCURRENCE. THE REPORT SHALL INCLUDE THE CAUSE OF THE DISCHARGE AND CORRECTIVE ACTIONS TAKEN.
- 3. THE OPERATOR SHALL ENSURE THAT ADJACENT PROPERTIES ARE NOT IMPACTED BY WIND EROSION, OR EMISSIONS OF UNCONFINED PARTICULATE MATTER IN ACCORDANCE WITH RULE 62-296.320(4)(C)1, F.A.C., BY TAKING APPROPRIATE MEASURES TO STABILIZE AFFECTED AREAS.
- 4. FUEL AND OTHER PETROLEUM PRODUCT SPILLS THAT ENTER STORMWATER DRAINS OR WATERBODIES, OR FUEL AND OTHER PETROLEUM PRODUCT SPILLS THAT ARE IN EXCESS OF 25 GALLONS SHALL BE CONTAINED, CLEANED UP, AND IMMEDIATELY REPORTED TO WATER RESOURCES. SMALLER GROUND SURFACE SPILLS SHALL BE CLEANED UP AS SOON AS PRACTICAL.
- 5. IF CONTAMINATED SOIL AND/OR GROUNDWATER IS DISCOVERED DURING DEVELOPMENT OF THE SITE, ALL ACTIVITY IN THE VICINITY OF THE CONTAMINATION SHALL IMMEDIATELY CEASE, AND WATER RESOURCES SHALL BE CONTACTED.
- 6. PRIOR TO DEMOLITION OF EXISTING ON SITE STRUCTURES AN ASBESTOS SURVEY AND/OR ASBESTOS NOTIFICATION MAY BE REQUIRED.
- 7. NATIONAL POLLUTANT DISCHARGE ELIMINATION SYSTEM: A. NPDES CONSTRUCTION GENERIC PERMIT COVERAGE SHALL BE OBTAINED AT LEAST 48 HOURS IN ADVANCE OF CONSTRUCTION COMMENCEMENT IN ACCORDANCE WITH RULE 62-621.300(4)(a),
- B. A COPY OF THE CERTIFIED NPDES NOI, OR A COPY OF THE FDEP COVERAGE CONFIRMATION LETTER SHALL BE POSTED AT THE SITE IN ACCORDANCE WITH RULE 62-621.300(4)(A) PART III.C.2, F.A.C. C. A COPY OF THE CERTIFIED NPDES NOI, OR A COPY OF THE FDEP COVERAGE CONFIRMATION
- LETTER SHALL BE PROVIDED TO WATER RESOURCES IN ACCORDANCE WITH RULE 62-621.300(4)(a)PART III.D.1, F.A.C.
- D. THE SWPPP SHALL BE CERTIFIED IN ACCORDANCE WITH RULE 62-621.300(4)(a)PART V.D.6, F.A.C. E. A COPY OF THE SWPPP, AND COPIES OF THE INSPECTION AND MAINTENANCE RECORDS SHALL BE MAINTAINED AT THE PROJECT SITE, AND SHALL BE READILY AVAILABLE TO COUNTY OR STATE INSPECTORS.
- 8. THE DISCHARGE OF GROUNDWATER PRODUCED THROUGH DEWATERING, TO SURFACE WATERS. OR ANY PORTION OF THE MS4 WILL REQUIRE SEPARATE PERMITTING FROM THE FLORIDA DEPARTMENT OF ENVIRONMENTAL PROTECTION (DEP). PERMIT(S) SHALL BE OBTAINED PRIOR TO THE COMMENCEMENT OF DEWATERING.


#### MAINTENANCE NOTES:

N.P.D.E.S. PERMIT COMPLIANCE REQUIRES INSPECTIONS EVERY 7 CALENDAR DAYS BY A NPDES QUALIFIED INSPECTOR AND PERIODIC INSPECTIONS WITHIN 24 HOURS OF ANY RAINFALL EVENT OF 0.5 INCHES OR GREATER. THESE INSPECTIONS MAY RESULT IN RECOMMENDATIONS FOR ROUTINE MAINTENANCE OF THE SOIL EROSION CONTROL DEVICES, AS WELL AS FURTHER MAINTENANCE AS OUTLINED BELOW.

- 1. THROUGHOUT THE CONSTRUCTION PERIOD, ALL MUD/SILT TRACKED ONTO EXISTING FDOT ROADS FROM THE SITE DUE TO CONSTRUCTION SHALL BE IMMEDIATELY REMOVED BY THE CONTRACTOR.
- 2. CATCH BASIN INLET AND CONCRETE FLUME FILTERS SHALL BE MAINTAINED CLEAN AT ALL TIMES THROUGHOUT THE CONSTRUCTION PERIOD. WEEKLY INSPECTIONS WILL BE PERFORMED EVERY 7 CALENDAR DAYS. IF A FILTER HAS HOLES OR IS INUNDATED WITH SEDIMENT, THE FILTER WILL REQUIRE REPLACEMENT.
- 3. CONSTRUCTION ACCESS AND TRACKING MAT MUST BE MAINTAINED AS NECESSARY. REPLENISH CRUSHED AGGREGATE IF PRESENT LAYER IS FILLED WITH SEDIMENT, POOLING WATER OR HAS RUTS. A NEW LAYER MAY BE ADDED IF OLD LAYERS BECOME COMPACTED.
- 4. SILT FENCE IS TO BE INSPECTED DAILY BY CONTRACTOR AND EVERY 7 CALENDAR DAYS BY NPDES QUALIFIED INSPECTOR. IF REPAIRS OR REPLACEMENT IS NECESSARY, IT SHALL BE PERFORMED IMMEDIATELY. THE SILT FENCE SHOULD BE TRENCHED IN, BACK-FILLED, AND STAPLED OR STAKED ACCORDING TO THE MANUFACTURER'S SPECIFICATIONS. MAINTENANCE INCLUDES THE REMOVING OF BUILT-UP SEDIMENT. WHEN THE SEDIMENT ACCUMULATES TO 1/3 OF THE HEIGHT OF THE FENCE, CONTRACTOR MAY HAVE TO REMOVE, REPLACE, RETRENCH, OR RE-BACKFILL THE FENCE IF IT FAILS. IT WOULD ALSO BE NECESSARY TO REINSTALL IF ANY PORTION OF THE FENCING WAS DAMAGED BY CONSTRUCTION MACHINERY.
- 5. SEEDING OR RESEEDING MAY BE REQUIRED IMMEDIATELY TO AREAS WHICH HAVE BEEN DAMAGED BY RUNOFF.
- 6. REMOVE ANY VISIBLE SEDIMENT FROM THE POND BOTTOM TO KEEP THE BASIN DESIGNED INFILTRATION PERFORMANCE
- 7. THE CONTRACTOR SHALL CONTINUOUSLY ENSURE THAT THE PERIMETER OF THE SITE, INCLUDING CONSTRUCTION ENTRANCES, IS SECURED FROM ALLOWING DEBRIS TO LEAVE THE SITE DUE TO CONSTRUCTION ACTIVITY OR RAINFALL EVENTS. A WEEKLY LOG SHALL BE UPDATED AND KEPT ON-SITE IN ACCORDANCE WITH THE NPDES PERMIT. BY BIDDING DOCUMENTS CONTRACTOR ACKNOWLEDGES HE/SHE IS AWARE OF NPDES GUIDELINES AND POLICIES AS WELL AS BEST MANAGEMENT PRACTICES AND ASSUMES SOLE RESPONSIBILITY FOR FINES IMPOSED BY GOVERNMENTAL AGENCIES DUE TO VIOLATIONS.

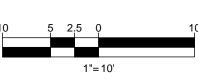

		SITE CIVIL AND CONSULTING ENGINEERING LAND SURVEYING PROGRAM MANAGEMENT LANDSCAPE ARCHITECTURE SUSTAINABLE DESIGN PERMITTING SERVICES TRANSPORTATION SERVICES	THE INFORMATION DESIGN AND CONTENT OF THIS PLAN ARE PROPRIETARY AND SHALL NOT BE COPIED OR USED FOR ANY PURPOSE WITHOUT PROR WRITTEN AUTHORIZATION FROM BOHLER ENGINEERING. ONLY APPROVED. SIGNED AND SEALED PLANS SHALL BE UTILIZED FOR CONSTRUCTION PURPOSES © BOHLER ENGINEERING.
$\geq$	т	EVICIÓNIC	5
	<u>ר</u>	REVISIONS	
REV	DATE		AWN BY CKED BY
1	2019-08-23	CITY OF DELRAY	JL
2	2019-09-10	SPRAB COMMENTS	AS LJL AS
		TEAM GEA I	AS _JL
3	2019-11-22	COMMENTS	AS
4	2019-11-22	SPRAB COMMENTS —	LJL AS
──			-
-			
			フ
THIS		TENDED FOR MUNICIPAL AND/OR AGEN	NCY
		CUMENT UNLESS INDICATED OTHERWI	ISE.
	ALV	wwhat's below. Call before you dig. VAYS CALL 811 st. It's free. It's the law.	
		FOR MUNICIPAL &	2
		REVIEW & APPROV	
C			
PR	OJECT No.:	FLB1801	120
	AWN BY: ECKED BY:		LJL AS
-	TE:	2019-10	
CA	D I.D.:	FLB180120-OBI	P-2
		FLB180120-OBI	P-2
PR F SI	OJECT: PIERRE PRAB SI	FLB180120-OBI DELRAY PHASE 1 TE PLAN PACKAG JTRUST BUILDING FOR — FOR	
PR F SI	OJECT: PIERRE PRAB SI KA SUN	DELRAY PHASE 1 TE PLAN PACKAG JTRUST BUILDING FOR	
PR F SI	OJECT: PIERRE PRAB SI KA SUN	DELRAY PHASE 1 TE PLAN PACKAG VTRUST BUILDING	
PR F SH (A	OJECT: PIERRE PRAB SI KA SUN	DELRAY PHASE 1 TE PLAN PACKAG TRUST BUILDING FOR CLIENT	
PR F SH (A	OJECT: PIERRE PRAB SI KA SUN	DELRAY PHASE 1 TE PLAN PACKAG TRUST BUILDING FOR CLIENT COVIC	
PR F SH (A	OJECT: PIERRE PRAB SI IKA SUN	DELRAY PHASE 1 TE PLAN PACKAG TRUST BUILDING FOR CLIENT COVICI H I T E C T	
PR F SH (A	OJECT: PRAB SI KA SUN	DELRAY PHASE 1 TE PLAN PACKAG TRUST BUILDING FOR CLIENT CLIENT H I T E C T PROPOSED	
PR F SH (A	OJECT: PRAB SI KA SUN	DELRAY PHASE 1 TE PLAN PACKAG TRUST BUILDING FOR CLIENT COVICI H I T E C T	
PR F SH (A	OJECT: PIERRE PRAB SI KA SUN KA SUN	DELRAY PHASE 1 TE PLAN PACKAG TRUST BUILDING FOR CLIENT CLIENT H I T E C T PROPOSED EVELOPMENT E ATLANTIC AVE	
PR F SH (A	OJECT: PIERRE PRAB SI KA SUN KA SUN	DELRAY PHASE 1 TE PLAN PACKAG TRUST BUILDING FOR CLIENT CLIENT H I T E C T PROPOSED EVELOPMENT E ATLANTIC AVE 1 BEACH COUNTY	
PR F SH (A	OJECT: PIERRE PRAB SI KA SUN KA SUN	DELRAY PHASE 1 TE PLAN PACKAG TRUST BUILDING FOR CLIENT CLIENT H I T E C T PROPOSED EVELOPMENT E ATLANTIC AVE	
PR F SI (A Z A	OJECT: PIERRE PRAB SI KA SUN ( YS R C DE 302 PALM DEL 255 GLAI	DELRAY PHASE 1 TE PLAN PACKAG TRUST BUILDING FOR CLIENT COVICE H I T E C T PROPOSED EVELOPMENT E ATLANTIC AVE BEACH COUNTY RAY BEACH, FL COHLER N G I N E E R I N DES ROAD, SUITE 305	
PR F SI (A Z A	OJECT: PIERRE PRAB SI KA SUN ( YS RC DE 302 PALM DEL 302 PALM DEL 255 GLAE BOCA RA Phone	DELRAY PHASE 1 TE PLAN PACKAG JTRUST BUILDING FOR CLIENT CLIENT COVICE H I T E C T PROPOSED EVELOPMENT E ATLANTIC AVE BEACH COUNTY RAY BEACH, FL CONFLET N G I N E E R I N DES ROAD, SUITE 305 ATON, FLORIDA 33431 e: (561) 571-0280	
PR FI (A Z A	OJECT: PIERRE PRAB SI KA SUN ( YS R C DE 302 PALM DEL 0 255 GLAE BOCA RA Phone Fax: FLORIDA BUS	DELRAY PHASE 1 TE PLAN PACKAG UTRUST BUILDING FOR CLIENT COVICE H I T E C T PROPOSED EVELOPMENT E ATLANTIC AVE BEACH COUNTY RAY BEACH, FL CONTRESS ROAD, SUITE 305 ATON, FLORIDA 33431 e: (561) 571-0280 (561) 571-0281 SINESS CERT. OF AUTH. No. 30780	
PR FI (A Z A	OJECT: PIERRE PRAB SI KA SUN ( YS R C DE 302 PALM DEL 0 255 GLAE BOCA RA Phone Fax: FLORIDA BUS	DELRAY PHASE 1 TE PLAN PACKAG JTRUST BUILDING FOR CLIENT CLIENT COVICE H I T E C T PROPOSED EVELOPMENT E ATLANTIC AVE BEACH COUNTY RAY BEACH, FL CONFLET N G I N E E R I N DES ROAD, SUITE 305 ATON, FLORIDA 33431 e: (561) 571-0280 (561) 571-0281	
PR FI (A Z A	OJECT: PIERRE PRAB SI KA SUN ( YS R C DE 302 PALM DEL 0 255 GLAE BOCA RA Phone Fax: FLORIDA BUS	DELRAY PHASE 1 TE PLAN PACKAG UTRUST BUILDING FOR CLIENT COVICE H I T E C T PROPOSED EVELOPMENT E ATLANTIC AVE BEACH COUNTY RAY BEACH, FL CONTRESS ROAD, SUITE 305 ATON, FLORIDA 33431 e: (561) 571-0280 (561) 571-0281 SINESS CERT. OF AUTH. No. 30780	
PR FI (A Z A	OJECT: PIERRE PRAB SI KA SUN ( YS R C DE 302 PALM DEL 0 255 GLAE BOCA RA Phone Fax: FLORIDA BUS	DELRAY PHASE 1 TE PLAN PACKAG UTRUST BUILDING FOR CLIENT COVICE H I T E C T PROPOSED EVELOPMENT E ATLANTIC AVE BEACH COUNTY RAY BEACH, FL CONTRESS ROAD, SUITE 305 ATON, FLORIDA 33431 e: (561) 571-0280 (561) 571-0281 SINESS CERT. OF AUTH. No. 30780	
	OJECT: PIERRE PRAB SI KA SUN N SR C DE 302 PALM DEL DE 302 PALM DEL DE 302 PALM DEL DE 302 PALM DEL	DELRAY PHASE 1 TE PLAN PACKAG UTRUST BUILDING FOR CLIENT COVICE H I T E C T PROPOSED EVELOPMENT E ATLANTIC AVE BEACH COUNTY RAY BEACH, FL CONTRESS ROAD, SUITE 305 ATON, FLORIDA 33431 e: (561) 571-0280 (561) 571-0281 SINESS CERT. OF AUTH. No. 30780	
	OJECT: PIERRE PRAB SI KA SUN ( YS R C DI 302 PALN DEL 255 GLAI BOCA RA Phone Florida BUS NDSCAPE ARC	DELRAY PHASE 1 TE PLAN PACKAG UTRUST BUILDING FOR CLIENT COVICE H I T E C T PROPOSED EVELOPMENT E ATLANTIC AVE BEACH COUNTY RAY BEACH, FL COHLES N G I N E E R I N DES ROAD, SUITE 305 ATON, FLORIDA 33431 e: (561) 571-0280 (561) 571-0281 SINESS CERT. OF AUTH. No. 30780 ENTECT BUSINESS LIC. No LC260005	
	OJECT: PIERRE PRAB SI KA SUN ( YS R C DI 302 PALN DEL 255 GLAI BOCA RA Phone Florida BUS NDSCAPE ARC	DELRAY PHASE 1 TE PLAN PACKAG UTRUST BUILDING FOR CLIENT COVICE H I T E C T PROPOSED EVELOPMENT E ATLANTIC AVE BEACH COUNTY RAY BEACH, FL CONTRESS ROAD, SUITE 305 ATON, FLORIDA 33431 e: (561) 571-0280 (561) 571-0281 SINESS CERT. OF AUTH. No. 30780	
	OJECT: PIERRE PRAB SI KA SUN YS RC DE 302 PALM DEL 255 GLAE BOCA RA Phone Fax: FLORIDA BUS NDSCAPE ARC Phone Fax: FLORIDA BUS NDSCAPE ARC	DELRAY PHASE 1 TE PLAN PACKAG JTRUST BUILDING FOR CLIENT COVICE H I T E C T PROPOSED EVELOPMENT E ATLANTIC AVE BEACH COUNTY RAY BEACH, FL COHLES N G I N E E R I N DES ROAD, SUITE 305 ATON, FLORIDA 33431 e: (561) 571-0280 (561) 571-0281 SINESS CERT. OF AUTH. No. 30780 HITECT BUSINESS LIC. No LC260005	
	OJECT: PIERRE PRAB SI KA SUN YS RC DE 302 PALM DE 302 PALM DE 255 GLAE BOCA RA Phone Fax: FLORIDA BUS NDSCAPE ARC EDIN	DELRAY PHASE 1 TE PLAN PACKAG JTRUST BUILDING FOR CLIENT COVICE H I T E C T PROPOSED EVELOPMENT E ATLANTIC AVE I BEACH COUNTY RAY BEACH, FL COHLES N G I N E E R I N DES ROAD, SUITE 305 ATON, FLORIDA 33431 e: (561) 571-0280 (561) 571-0281 SINESS CERT. OF AUTH. NO. 30780 HITECT BUSINESS LIC. NO LO260005	
	OJECT: PIERRE PRAB SI KA SUN YS RC DE 302 PALM DE 302 PALM DE 255 GLAE BOCA RA Phone Fax: FLORIDA BUS NDSCAPE ARC EDIN	DELRAY PHASE 1 TE PLAN PACKAG JTRUST BUILDING FOR CLIENT COVICE H I T E C T PROPOSED EVELOPMENT E ATLANTIC AVE BEACH COUNTY RAY BEACH, FL COHLES N G I N E E R I N DES ROAD, SUITE 305 ATON, FLORIDA 33431 e: (561) 571-0280 (561) 571-0281 SINESS CERT. OF AUTH. No. 30780 HITECT BUSINESS LIC. No LC260005	
	OJECT: PIERRE PRAB SI KA SUN YS RC DE 302 PALM DE DE DE DE DE DE DE DE DE DE	DELRAY PHASE 1 TE PLAN PACKAG JTRUST BUILDING FOR CLIENT COVICE H I T E C T PROPOSED EVELOPMENT E ATLANTIC AVE I BEACH COUNTY RAY BEACH, FL COHLES N G I N E E R I N DES ROAD, SUITE 305 ATON, FLORIDA 33431 e: (561) 571-0280 (561) 571-0281 SINESS CERT. OF AUTH. No. 30780 HITECT BUSINESS LIC. No LC260005	
	OJECT: PIERRE PRAB SI KA SUN YS RC DE 302 PALM DE DE DE DE DE DE DE DE DE DE	DELRAY PHASE 1 TE PLAN PACKAG JTRUST BUILDING FOR CLIENT COVICE H I T E C T PROPOSED EVELOPMENT E ATLANTIC AVE I BEACH COUNTY RAY BEACH, FL COHLES N G I N E E R I N DES ROAD, SUITE 305 ATON, FLORIDA 33431 e: (561) 571-0280 (561) 571-0281 SINESS CERT. OF AUTH. NO. 30780 HITECT BUSINESS LIC. NO LO260005	
	OJECT: PIERRE PRAB SI KA SUN YS RC DE 302 PALM DE DE DE DE DE DE DE DE DE DE	DELRAY PHASE 1 TE PLAN PACKAG UTRUST BUILDING FOR CLIENT COVICE H I T E C T PROPOSED EVELOPMENT E ATLANTIC AVE BEACH COUNTY RAY BEACH, FL COHLES N G I N E E R I N DES ROAD, SUITE 305 ATON, FLORIDA 33431 e: (561) 571-0280 (561) 571-0281 SHITECT BUSINESS LIC. NO LC260005	
	OJECT: PIERRE PRAB SI KA SUN YS RC DE 302 PALW DE 255 GLAE BOCA RA Phone Fax: FLORIDA BUS NDSCAPE ARC 255 GLAE BOCA RA Phone Fax: FLORIDA BUS NDSCAPE ARC YS RC DE ALW DEL PALW PALW DEL PALW DEL PALW DEL PALW DEL PALW PALW PALW PALW DEL PALW DEL PALW DEL PALW PALW PALW PALW PALW PALW PALW PA	DELRAY PHASE 1 TE PLAN PACKAG JTRUST BUILDING FOR CLIENT COVICE H I T E C T PROPOSED EVELOPMENT E ATLANTIC AVE BEACH COUNTY RAY BEACH, FL COHLENT OF NG I N E E R I N DES ROAD, SUITE 305 ATON, FLORIDA 33431 e: (561) 571-0280 (561) 571-0281 SINESS CERT. OF AUTH. No. 30780 HITECT BUSINESS LIC. No LC260005	
	OJECT: PIERRE PRAB SI KA SUN YS RC DE 302 PALW DE 255 GLAE BOCA RA Phone Fax: FLORIDA BUS NDSCAPE ARC 255 GLAE BOCA RA Phone Fax: FLORIDA BUS NDSCAPE ARC YS RC DE ALW DEL PALW PALW DEL PALW DEL PALW DEL PALW DEL PALW PALW PALW PALW DEL PALW DEL PALW DEL PALW PALW PALW PALW PALW PALW PALW PA	DELRAY PHASE 1 TE PLAN PACKAG UTRUST BUILDING FOR CLIENT COVICE H I T E C T PROPOSED EVELOPMENT E ATLANTIC AVE BEACH COUNTY RAY BEACH, FL COHLES N G I N E E R I N DES ROAD, SUITE 305 ATON, FLORIDA 33431 e: (561) 571-0280 (561) 571-0281 SHITECT BUSINESS LIC. NO LC260005	
	OJECT: PIERRE PRAB SI KA SUN YS RC DE 302 PALW DE 255 GLAE BOCA RA Phone Fax: FLORIDA BUS NDSCAPE ARC 255 GLAE BOCA RA Phone Fax: FLORIDA BUS NDSCAPE ARC YS RC DE ALW DEL PALW PALW DEL PALW DEL PALW DEL PALW DEL PALW PALW PALW PALW DEL PALW DEL PALW DEL PALW PALW PALW PALW PALW PALW PALW PA	DELRAY PHASE 1 TE PLAN PACKAG JTRUST BUILDING FOR CLIENT COVICE H I T E C T PROPOSED EVELOPMENT E ATLANTIC AVE BEACH COUNTY RAY BEACH, FL COHLENT OF NG I N E E R I N DES ROAD, SUITE 305 ATON, FLORIDA 33431 e: (561) 571-0280 (561) 571-0281 SINESS CERT. OF AUTH. No. 30780 HITECT BUSINESS LIC. No LC260005	
	OJECT: PIERRE PRAB SI KA SUN SR C DE 302 PALM DE 302 PALM DE 255 GLAE BOCA RA Phone Fax: FLORIDA BUS NDSCAPE ARC Phone Fax: FLORIDA BUS NDSCAPE ARC CONT EET TITLE: ERO EDIN CONT P EET NUMBI	DELRAY PHASE 1 TE PLAN PACKAG JTRUST BUILDING FOR CLIENT COVICE H I T E C T PROPOSED EVELOPMENT E ATLANTIC AVE BEACH COUNTY RAY BEACH, FL COHLENT OF NG I N E E R I N DES ROAD, SUITE 305 ATON, FLORIDA 33431 e: (561) 571-0280 (561) 571-0281 SINESS CERT. OF AUTH. No. 30780 HITECT BUSINESS LIC. No LC260005	

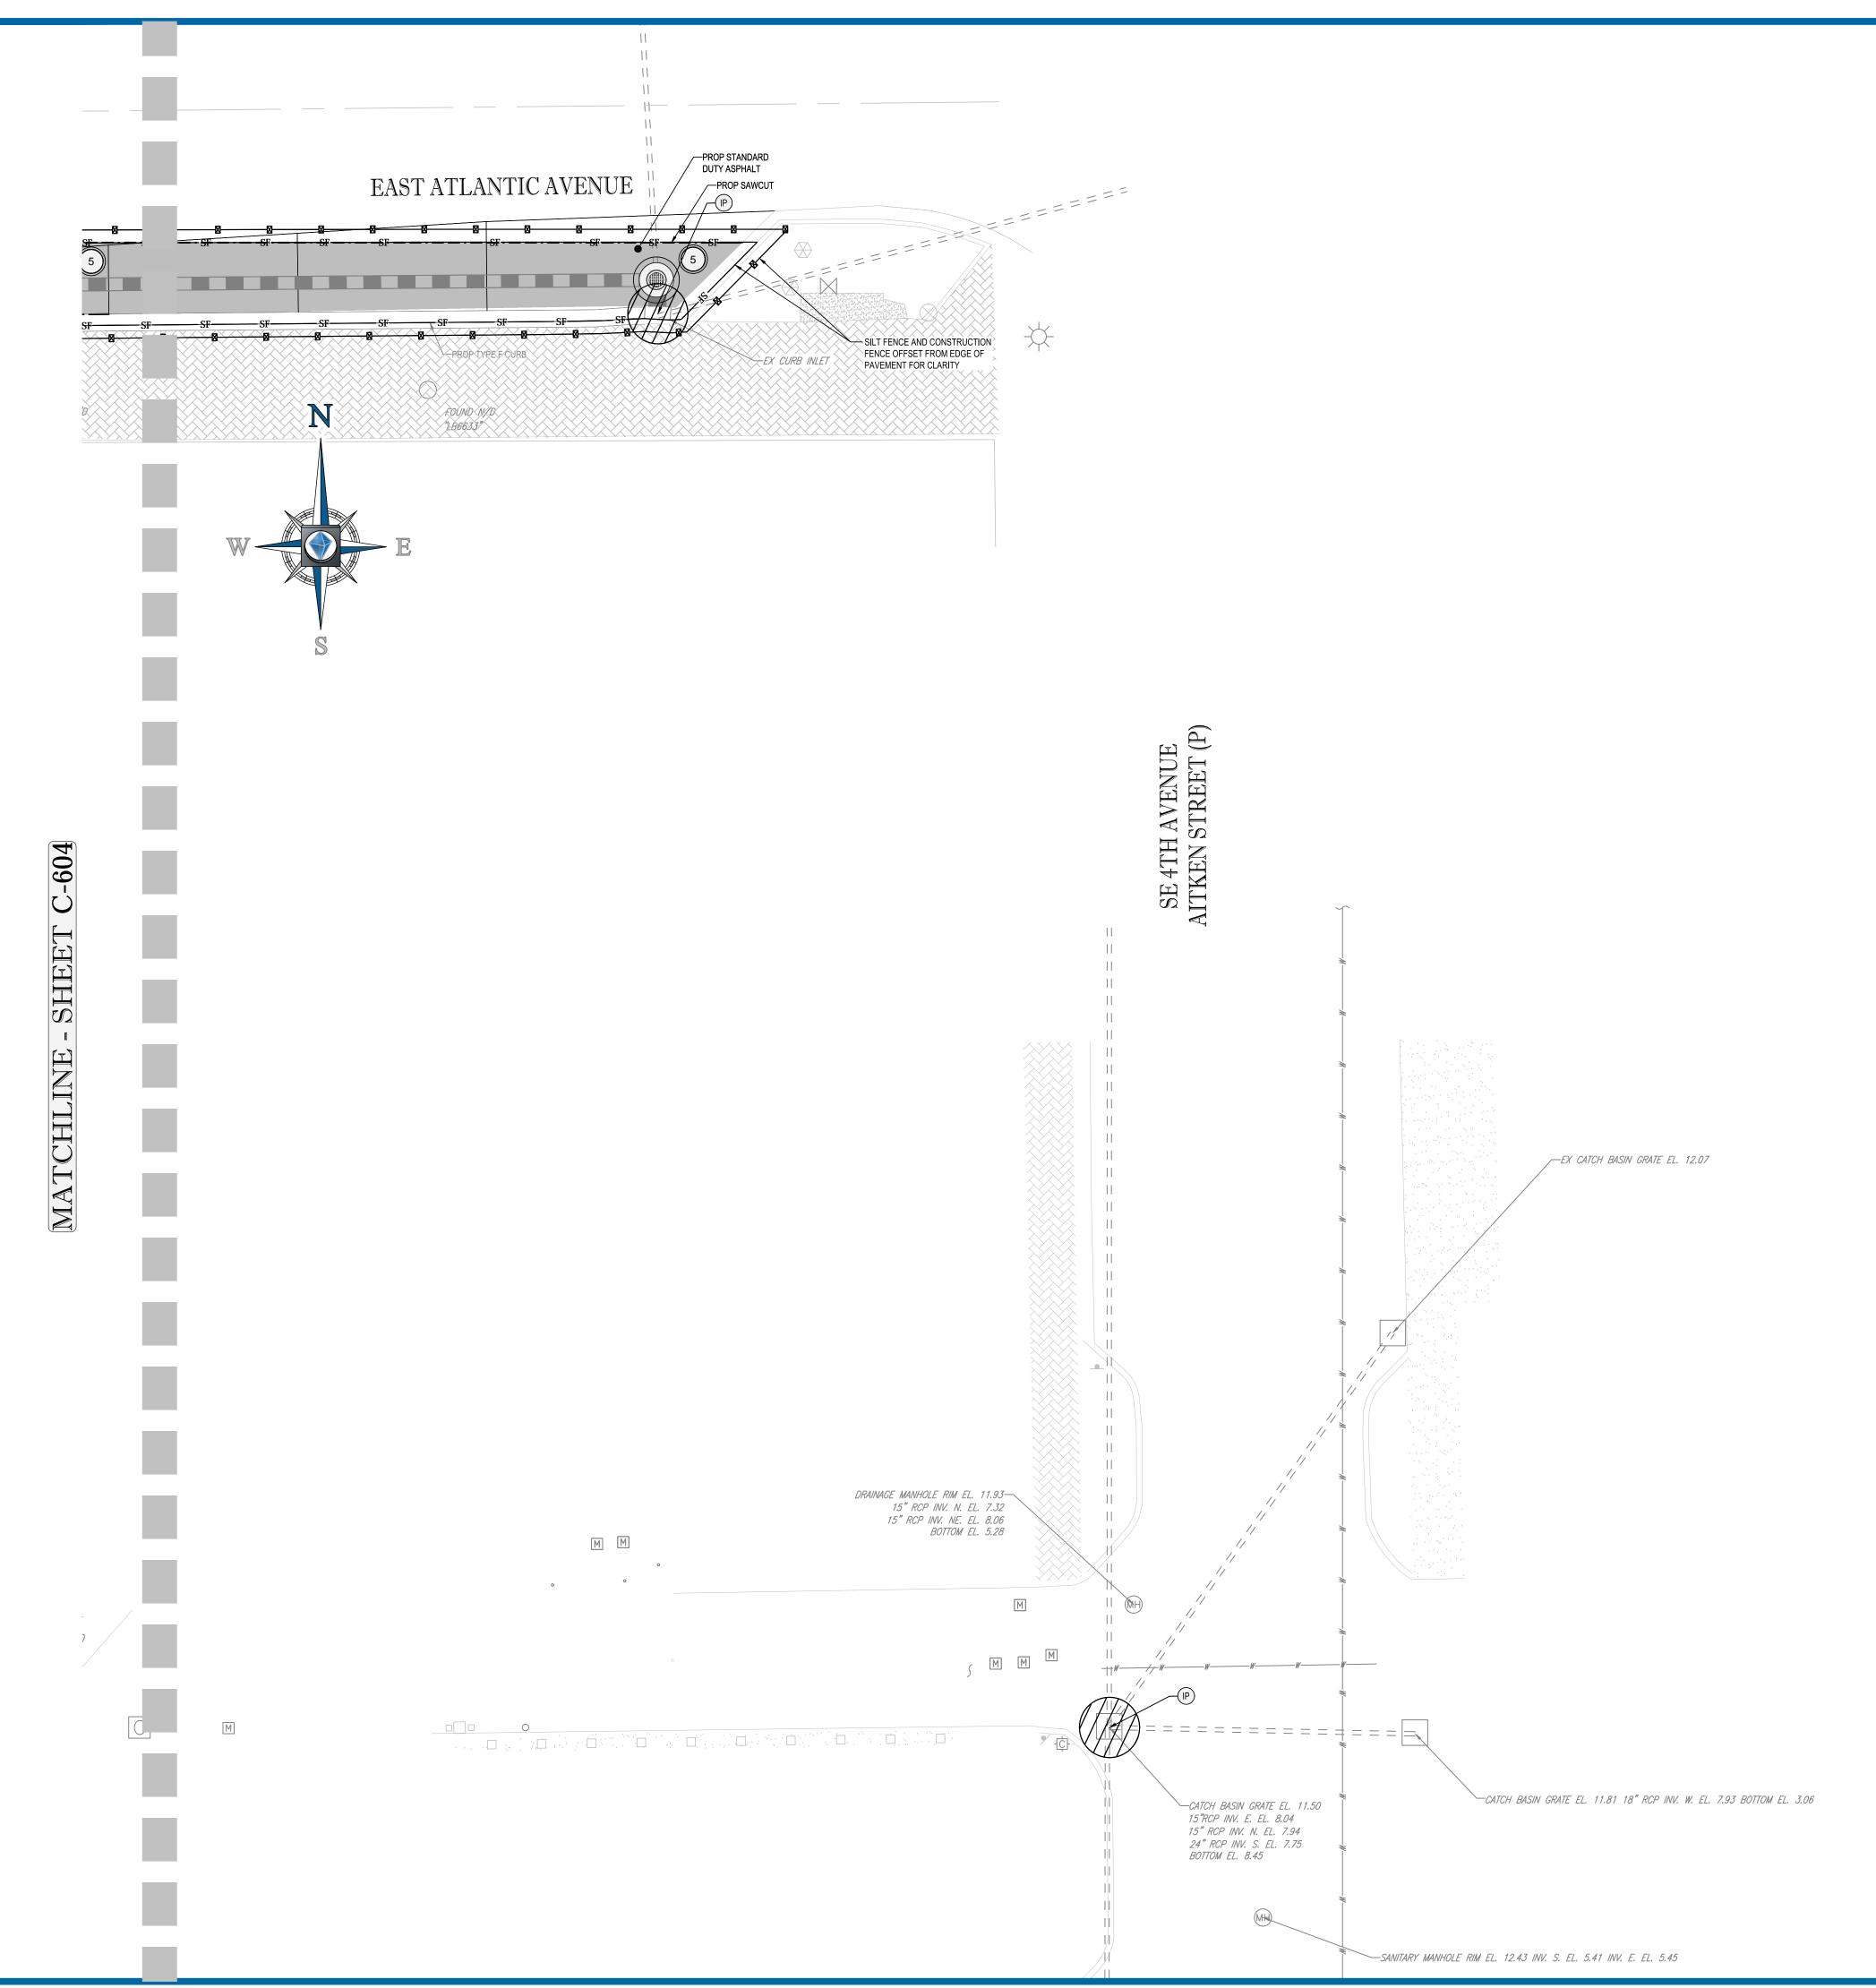

H:\2018\FLB180120\DRAWINGS\PLAN SETS\FLB180120-OBP-2.DWG PRINTED BY: LLUBIN 11.21.19 @ 10:02 AM LAST SAVED BY: LLUBIN

## LEGEND:



PROPERTY LINE EXIST. DRAINAGE STRUCTURES PROP SILT FENCE PROP CONSTRUCTION FENCE

PROP SOIL TRACKING PREVENTION MAT

PROP INLET PROTECTION


### POLLUTION PREVENTION NOTES:

- 1. EROSION AND SEDIMENT CONTROL BMP'S IN ADDITION TO THOSE PRESENTED ON THESE PLANS SHALL BE IMPLEMENTED AS NECESSARY TO PREVENT TURBID DISCHARGES FROM FLOWING ONTO ADJACENT PROPERTIES OR ROADWAYS, OFF SITE STORMWATER CONVEYANCES OR RECEIVING WATERS, OR ON SITE WETLANDS AND SURFACE WATERS. BMP'S SHALL BE DESIGNED, INSTALLED, AND MAINTAINED BY THE SITE OPERATOR TO ENSURE THAT OFF SITE SURFACE WATER QUALITY REMAINS CONSISTENT WITH STATE AND LOCAL REGULATIONS. [THE OPERATOR IS THE ENTITY THAT OWNS OR OPERATES THE CONSTRUCTION ACTIVITY AND HAS AUTHORITY TO CONTROL THOSE ACTIVITIES AT THE PROJECT NECESSARY TO ENSURE COMPLIANCE.]
- 2. OFF SITE SURFACE WATER DISCHARGES, OR DISCHARGES TO ONSITE WETLANDS OR SURFACE WATERS WITH TURBIDITY IN EXCESS OF 29 NEPHELOMETRIC TURBIDITY UNITS (NTU'S) ABOVE BACKGROUND LEVEL SHALL BE IMMEDIATELY CORRECTED. SUCH INCIDENTS SHALL BE REPORTED TO WATER RESOURCES WITHIN 24 HOURS OF THE OCCURRENCE. THE REPORT SHALL INCLUDE THE CAUSE OF THE DISCHARGE AND CORRECTIVE ACTIONS TAKEN.
- 3. THE OPERATOR SHALL ENSURE THAT ADJACENT PROPERTIES ARE NOT IMPACTED BY WIND EROSION, OR EMISSIONS OF UNCONFINED PARTICULATE MATTER IN ACCORDANCE WITH RULE 62-296.320(4)(C)1, F.A.C., BY TAKING APPROPRIATE MEASURES TO STABILIZE AFFECTED AREAS.
- 4. FUEL AND OTHER PETROLEUM PRODUCT SPILLS THAT ENTER STORMWATER DRAINS OR WATERBODIES, OR FUEL AND OTHER PETROLEUM PRODUCT SPILLS THAT ARE IN EXCESS OF 25 GALLONS SHALL BE CONTAINED, CLEANED UP, AND IMMEDIATELY REPORTED TO WATER RESOURCES. SMALLER GROUND SURFACE SPILLS SHALL BE CLEANED UP AS SOON AS PRACTICAL.
- 5. IF CONTAMINATED SOIL AND/OR GROUNDWATER IS DISCOVERED DURING DEVELOPMENT OF THE SITE, ALL ACTIVITY IN THE VICINITY OF THE CONTAMINATION SHALL IMMEDIATELY CEASE, AND WATER RESOURCES SHALL BE CONTACTED.
- 6. PRIOR TO DEMOLITION OF EXISTING ON SITE STRUCTURES AN ASBESTOS SURVEY AND/OR ASBESTOS NOTIFICATION MAY BE REQUIRED. 7. NATIONAL POLLUTANT DISCHARGE ELIMINATION SYSTEM:
- A. NPDES CONSTRUCTION GENERIC PERMIT COVERAGE SHALL BE OBTAINED AT LEAST 48 HOURS IN ADVANCE OF CONSTRUCTION COMMENCEMENT IN ACCORDANCE WITH RULE 62-621.300(4)(a),
- B. A COPY OF THE CERTIFIED NPDES NOI, OR A COPY OF THE FDEP COVERAGE CONFIRMATION LETTER SHALL BE POSTED AT THE SITE IN ACCORDANCE WITH RULE 62-621.300(4)(A) PART III.C.2, F.A.C. C. A COPY OF THE CERTIFIED NPDES NOI, OR A COPY OF THE FDEP COVERAGE CONFIRMATION
- LETTER SHALL BE PROVIDED TO WATER RESOURCES IN ACCORDANCE WITH RULE 62-621.300(4)(a)PART III.D.1, F.A.C.
- D. THE SWPPP SHALL BE CERTIFIED IN ACCORDANCE WITH RULE 62-621.300(4)(a)PART V.D.6, F.A.C. E. A COPY OF THE SWPPP, AND COPIES OF THE INSPECTION AND MAINTENANCE RECORDS SHALL BE MAINTAINED AT THE PROJECT SITE, AND SHALL BE READILY AVAILABLE TO COUNTY OR STATE INSPECTORS.
- 8. THE DISCHARGE OF GROUNDWATER PRODUCED THROUGH DEWATERING, TO SURFACE WATERS, OR ANY PORTION OF THE MS4 WILL REQUIRE SEPARATE PERMITTING FROM THE FLORIDA DEPARTMENT OF ENVIRONMENTAL PROTECTION (DEP). PERMIT(S) SHALL BE OBTAINED PRIOR TO THE COMMENCEMENT OF DEWATERING.

#### MAINTENANCE NOTES:


N.P.D.E.S. PERMIT COMPLIANCE REQUIRES INSPECTIONS EVERY 7 CALENDAR DAYS BY A NPDES QUALIFIED INSPECTOR AND PERIODIC INSPECTIONS WITHIN 24 HOURS OF ANY RAINFALL EVENT OF 0.5 INCHES OR GREATER. THESE INSPECTIONS MAY RESULT IN RECOMMENDATIONS FOR ROUTINE MAINTENANCE OF THE SOIL EROSION CONTROL DEVICES, AS WELL AS FURTHER MAINTENANCE AS OUTLINED BELOW.


- 1. THROUGHOUT THE CONSTRUCTION PERIOD, ALL MUD/SILT TRACKED ONTO EXISTING FDOT ROADS FROM THE SITE DUE TO CONSTRUCTION SHALL BE IMMEDIATELY REMOVED BY THE CONTRACTOR.
- 2. CATCH BASIN INLET AND CONCRETE FLUME FILTERS SHALL BE MAINTAINED CLEAN AT ALL TIMES THROUGHOUT THE CONSTRUCTION PERIOD. WEEKLY INSPECTIONS WILL BE PERFORMED EVERY 7 CALENDAR DAYS. IF A FILTER HAS HOLES OR IS INUNDATED WITH SEDIMENT, THE FILTER WILL REQUIRE REPLACEMENT.
- 3. CONSTRUCTION ACCESS AND TRACKING MAT MUST BE MAINTAINED AS NECESSARY. REPLENISH CRUSHED AGGREGATE IF PRESENT LAYER IS FILLED WITH SEDIMENT, POOLING WATER OR HAS RUTS. A NEW LAYER MAY BE ADDED IF OLD LAYERS BECOME COMPACTED.
- 4. SILT FENCE IS TO BE INSPECTED DAILY BY CONTRACTOR AND EVERY 7 CALENDAR DAYS BY NPDES QUALIFIED INSPECTOR. IF REPAIRS OR REPLACEMENT IS NECESSARY, IT SHALL BE PERFORMED IMMEDIATELY. THE SILT FENCE SHOULD BE TRENCHED IN, BACK-FILLED, AND STAPLED OR STAKED ACCORDING TO THE MANUFACTURER'S SPECIFICATIONS. MAINTENANCE INCLUDES THE REMOVING OF BUILT-UP SEDIMENT. WHEN THE SEDIMENT ACCUMULATES TO 1/3 OF THE HEIGHT OF THE FENCE, CONTRACTOR MAY HAVE TO REMOVE, REPLACE, RETRENCH, OR RE-BACKFILL THE FENCE IF IT FAILS. IT WOULD ALSO BE NECESSARY TO REINSTALL IF ANY PORTION OF THE FENCING WAS DAMAGED BY CONSTRUCTION MACHINERY.
- 5. SEEDING OR RESEEDING MAY BE REQUIRED IMMEDIATELY TO AREAS WHICH HAVE BEEN DAMAGED BY RUNOFF.
- 6. REMOVE ANY VISIBLE SEDIMENT FROM THE POND BOTTOM TO KEEP THE BASIN DESIGNED INFILTRATION PERFORMANCE
- 7. THE CONTRACTOR SHALL CONTINUOUSLY ENSURE THAT THE PERIMETER OF THE SITE, INCLUDING CONSTRUCTION ENTRANCES, IS SECURED FROM ALLOWING DEBRIS TO LEAVE THE SITE DUE TO CONSTRUCTION ACTIVITY OR RAINFALL EVENTS. A WEEKLY LOG SHALL BE UPDATED AND KEPT ON-SITE IN ACCORDANCE WITH THE NPDES PERMIT. BY BIDDING DOCUMENTS CONTRACTOR ACKNOWLEDGES HE/SHE IS AWARE OF NPDES GUIDELINES AND POLICIES AS WELL AS BEST MANAGEMENT PRACTICES AND ASSUMES SOLE RESPONSIBILITY FOR FINES IMPOSED BY GOVERNMENTAL AGENCIES DUE TO VIOLATIONS.

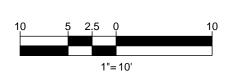

	BOHLER BOHLER	VSULTING ENG SURVEYING ENG MANAGEMEN MANAGEMEN MANAGEMEN ABLE DESIGN ING SERVICES 'ATION SERVIC ING SERVICES 'ATION SERVICES 'ATION SERVICES MALIBRANCE
	F	REVISIONS
	REV DATE	COMMENT DRAWN BY CHECKED BY
:	1      2019-08-23        2      2019-09-10        3      2019-11-22        4      2019-11-22	CITY OF DELRAY BEACH COMMENTS AS SPRAB COMMENTS AS TEAM GFA LJL COMMENTS AS SPRAB COMMENTS AS
	REVIEW AND A	TENDED FOR MUNICIPAL AND/OR AGENCY PROVAL. IT IS NOT INTENDED AS A CUMENT UNLESS INDICATED OTHERWISE.
N		
:	ALV	what's below. Call before you dig. VAYS CALL 811 st. It's free. It's the law.
R F	ISSUED	FOR MUNICIPAL &
	AGENCY F	REVIEW & APPROVAL
	PROJECT No.: DRAWN BY: CHECKED BY: DATE: CAD I.D.:	FLB180120 LJL AS 2019-10-25 FLB180120-OBP-2
	SPRAB SI' (AKA SUN ZYS A R C DE 302 PALM	DELRAY PHASE 1 - TE PLAN PACKAGE TRUST BUILDING) FOR CLIENT COVICH H I T E C T S PROPOSED EVELOPMENT E ATLANTIC AVE I BEACH COUNTY RAY BEACH, FL
	E 2255 GLAE BOCA RA Phone Fax: FLORIDA BUS	<b>DES ROAD, SUITE 305E</b> <b>TON, FLORIDA 33431</b> e: (561) 571-0280 (561) 571-0281 SINESS CERT. OF AUTH. No. 30780 HITECT BUSINESS LIC. No LC26000551
	SEDIN CON P Sheet Numbe	
		C-605

REVISION 4 - 2019-11-22

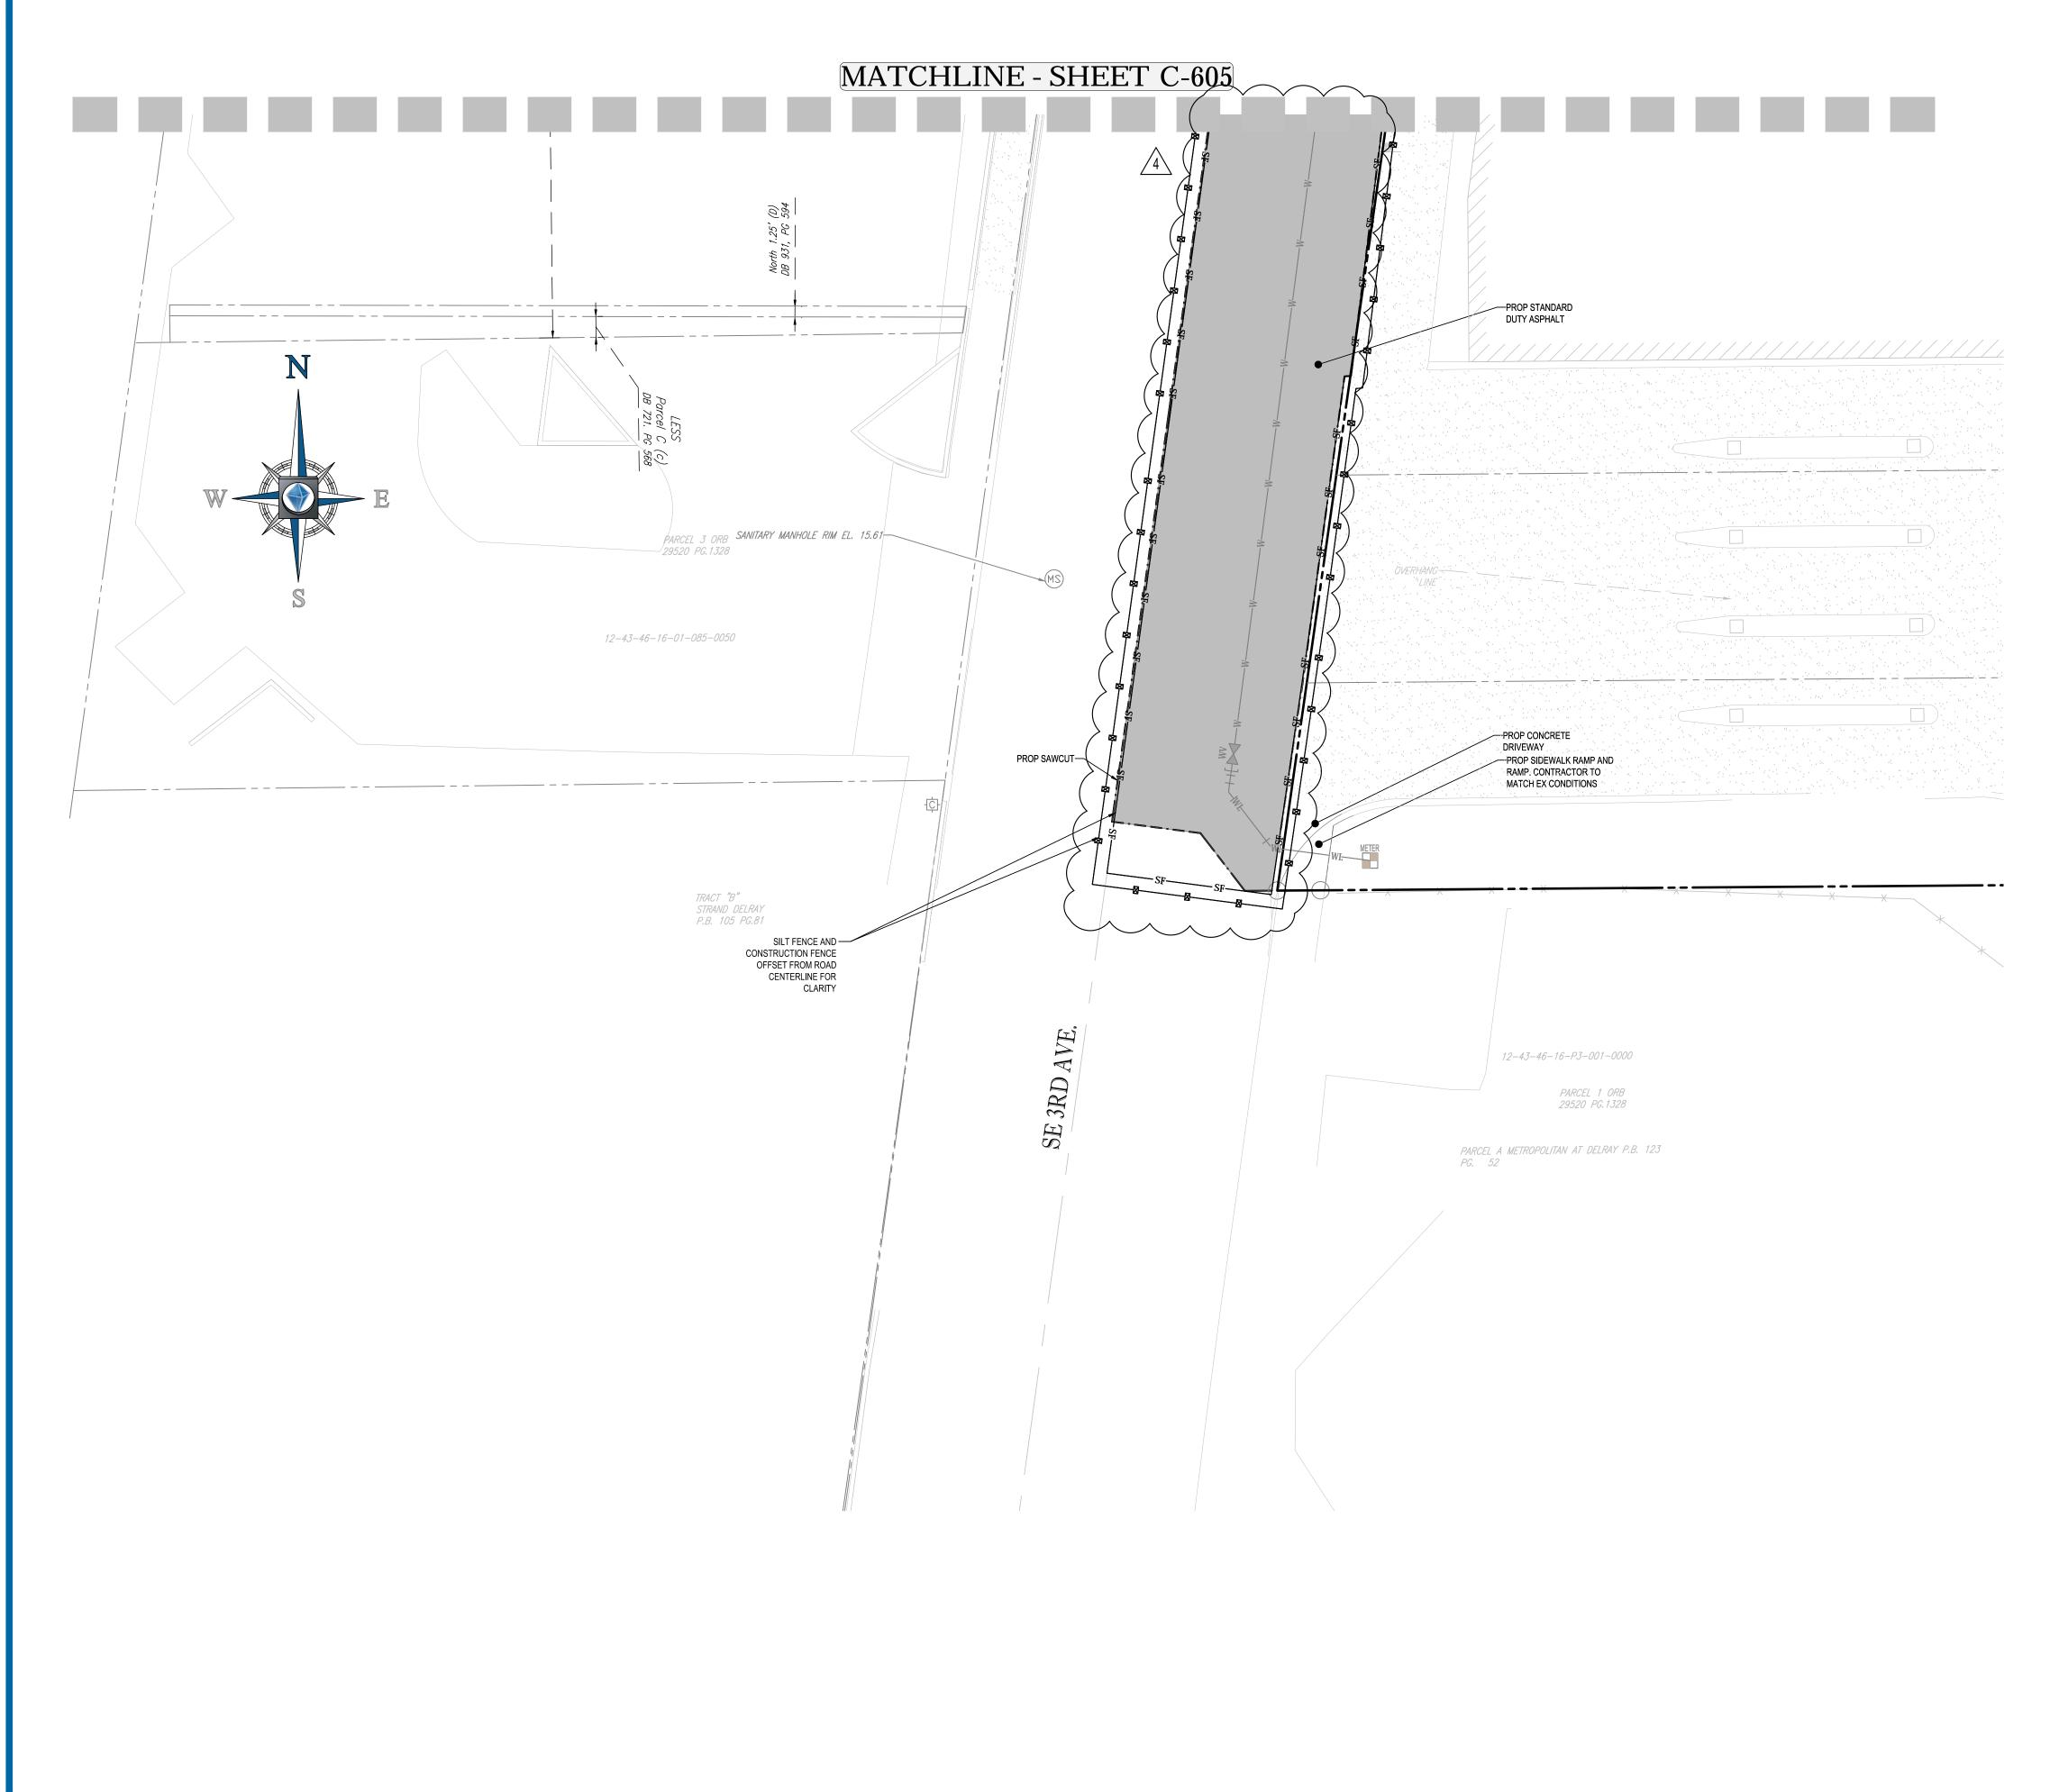

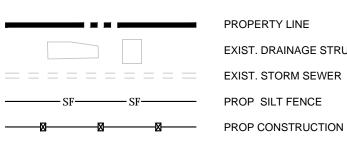

 $\bigcirc$ 

PROPERTY LINE EXIST. DRAINAGE STRUCTURES PROP SILT FENCE PROP CONSTRUCTION FENCE

PROP SOIL TRACKING PREVENTION MAT

PROP INLET PROTECTION


## POLLUTION PREVENTION NOTES:

- 1. EROSION AND SEDIMENT CONTROL BMP'S IN ADDITION TO THOSE PRESENTED ON THESE PLANS SHALL BE IMPLEMENTED AS NECESSARY TO PREVENT TURBID DISCHARGES FROM FLOWING ONTO ADJACENT PROPERTIES OR ROADWAYS, OFF SITE STORMWATER CONVEYANCES OR RECEIVING WATERS. OR ON SITE WETLANDS AND SURFACE WATERS. BMP'S SHALL BE DESIGNED, INSTALLED, AND MAINTAINED BY THE SITE OPERATOR TO ENSURE THAT OFF SITE SURFACE WATER QUALITY REMAINS CONSISTENT WITH STATE AND LOCAL REGULATIONS. [THE OPERATOR IS THE ENTITY THAT OWNS OR OPERATES THE CONSTRUCTION ACTIVITY AND HAS AUTHORITY TO CONTROL THOSE ACTIVITIES AT THE PROJECT NECESSARY TO ENSURE COMPLIANCE.]
- 2. OFF SITE SURFACE WATER DISCHARGES, OR DISCHARGES TO ONSITE WETLANDS OR SURFACE WATERS WITH TURBIDITY IN EXCESS OF 29 NEPHELOMETRIC TURBIDITY UNITS (NTU'S) ABOVE BACKGROUND LEVEL SHALL BE IMMEDIATELY CORRECTED. SUCH INCIDENTS SHALL BE REPORTED TO WATER RESOURCES WITHIN 24 HOURS OF THE OCCURRENCE. THE REPORT SHALL INCLUDE THE CAUSE OF THE DISCHARGE AND CORRECTIVE ACTIONS TAKEN.
- 3. THE OPERATOR SHALL ENSURE THAT ADJACENT PROPERTIES ARE NOT IMPACTED BY WIND EROSION, OR EMISSIONS OF UNCONFINED PARTICULATE MATTER IN ACCORDANCE WITH RULE 62-296.320(4)(C)1, F.A.C., BY TAKING APPROPRIATE MEASURES TO STABILIZE AFFECTED AREAS.
- 4. FUEL AND OTHER PETROLEUM PRODUCT SPILLS THAT ENTER STORMWATER DRAINS OR WATERBODIES, OR FUEL AND OTHER PETROLEUM PRODUCT SPILLS THAT ARE IN EXCESS OF 25 GALLONS SHALL BE CONTAINED, CLEANED UP, AND IMMEDIATELY REPORTED TO WATER RESOURCES. SMALLER GROUND SURFACE SPILLS SHALL BE CLEANED UP AS SOON AS PRACTICAL.
- 5. IF CONTAMINATED SOIL AND/OR GROUNDWATER IS DISCOVERED DURING DEVELOPMENT OF THE SITE, ALL ACTIVITY IN THE VICINITY OF THE CONTAMINATION SHALL IMMEDIATELY CEASE, AND WATER RESOURCES SHALL BE CONTACTED.
- 6. PRIOR TO DEMOLITION OF EXISTING ON SITE STRUCTURES AN ASBESTOS SURVEY AND/OR ASBESTOS NOTIFICATION MAY BE REQUIRED.
- 7. NATIONAL POLLUTANT DISCHARGE ELIMINATION SYSTEM: A. NPDES CONSTRUCTION GENERIC PERMIT COVERAGE SHALL BE OBTAINED AT LEAST 48 HOURS IN ADVANCE OF CONSTRUCTION COMMENCEMENT IN ACCORDANCE WITH RULE 62-621.300(4)(a), F.A.C.
- B. A COPY OF THE CERTIFIED NPDES NOI, OR A COPY OF THE FDEP COVERAGE CONFIRMATION LETTER SHALL BE POSTED AT THE SITE IN ACCORDANCE WITH RULE 62-621.300(4)(A) PART III.C.2,
- F.A.C. C. A COPY OF THE CERTIFIED NPDES NOI, OR A COPY OF THE FDEP COVERAGE CONFIRMATION LETTER SHALL BE PROVIDED TO WATER RESOURCES IN ACCORDANCE WITH RULE 62-621.300(4)(a)PART III.D.1, F.A.C.
- D. THE SWPPP SHALL BE CERTIFIED IN ACCORDANCE WITH RULE 62-621.300(4)(a)PART V.D.6, F.A.C. E. A COPY OF THE SWPPP, AND COPIES OF THE INSPECTION AND MAINTENANCE RECORDS SHALL BE MAINTAINED AT THE PROJECT SITE, AND SHALL BE READILY AVAILABLE TO COUNTY OR STATE INSPECTORS.
- 8. THE DISCHARGE OF GROUNDWATER PRODUCED THROUGH DEWATERING, TO SURFACE WATERS, OR ANY PORTION OF THE MS4 WILL REQUIRE SEPARATE PERMITTING FROM THE FLORIDA DEPARTMENT OF ENVIRONMENTAL PROTECTION (DEP). PERMIT(S) SHALL BE OBTAINED PRIOR TO THE COMMENCEMENT OF DEWATERING.

#### MAINTENANCE NOTES:

N.P.D.E.S. PERMIT COMPLIANCE REQUIRES INSPECTIONS EVERY 7 CALENDAR DAYS BY A NPDES QUALIFIED INSPECTOR AND PERIODIC INSPECTIONS WITHIN 24 HOURS OF ANY RAINFALL EVENT OF 0.5 INCHES OR GREATER. THESE INSPECTIONS MAY RESULT IN RECOMMENDATIONS FOR ROUTINE MAINTENANCE OF THE SOIL EROSION CONTROL DEVICES, AS WELL AS FURTHER MAINTENANCE AS OUTLINED BELOW.

- 1. THROUGHOUT THE CONSTRUCTION PERIOD, ALL MUD/SILT TRACKED ONTO EXISTING FDOT ROADS FROM THE SITE DUE TO CONSTRUCTION SHALL BE IMMEDIATELY REMOVED BY THE CONTRACTOR.
- 2. CATCH BASIN INLET AND CONCRETE FLUME FILTERS SHALL BE MAINTAINED CLEAN AT ALL TIMES THROUGHOUT THE CONSTRUCTION PERIOD. WEEKLY INSPECTIONS WILL BE PERFORMED EVERY 7 CALENDAR DAYS. IF A FILTER HAS HOLES OR IS INUNDATED WITH SEDIMENT, THE FILTER WILL REQUIRE REPLACEMENT.
- 3. CONSTRUCTION ACCESS AND TRACKING MAT MUST BE MAINTAINED AS NECESSARY. REPLENISH CRUSHED AGGREGATE IF PRESENT LAYER IS FILLED WITH SEDIMENT, POOLING WATER OR HAS RUTS. A NEW LAYER MAY BE ADDED IF OLD LAYERS BECOME COMPACTED.
- 4. SILT FENCE IS TO BE INSPECTED DAILY BY CONTRACTOR AND EVERY 7 CALENDAR DAYS BY NPDES QUALIFIED INSPECTOR. IF REPAIRS OR REPLACEMENT IS NECESSARY, IT SHALL BE PERFORMED IMMEDIATELY. THE SILT FENCE SHOULD BE TRENCHED IN, BACK-FILLED, AND STAPLED OR STAKED ACCORDING TO THE MANUFACTURER'S SPECIFICATIONS. MAINTENANCE INCLUDES THE REMOVING OF BUILT-UP SEDIMENT. WHEN THE SEDIMENT ACCUMULATES TO 1/3 OF THE HEIGHT OF THE FENCE, CONTRACTOR MAY HAVE TO REMOVE, REPLACE, RETRENCH, OR RE-BACKFILL THE FENCE IF IT FAILS. IT WOULD ALSO BE NECESSARY TO REINSTALL IF ANY PORTION OF THE FENCING WAS DAMAGED BY CONSTRUCTION MACHINERY.
- 5. SEEDING OR RESEEDING MAY BE REQUIRED IMMEDIATELY TO AREAS WHICH HAVE BEEN DAMAGED BY RUNOFF.
- 6. REMOVE ANY VISIBLE SEDIMENT FROM THE POND BOTTOM TO KEEP THE BASIN DESIGNED INFILTRATION PERFORMANCE
- 7. THE CONTRACTOR SHALL CONTINUOUSLY ENSURE THAT THE PERIMETER OF THE SITE, INCLUDING CONSTRUCTION ENTRANCES, IS SECURED FROM ALLOWING DEBRIS TO LEAVE THE SITE DUE TO CONSTRUCTION ACTIVITY OR RAINFALL EVENTS. A WEEKLY LOG SHALL BE UPDATED AND KEPT ON-SITE IN ACCORDANCE WITH THE NPDES PERMIT. BY BIDDING DOCUMENTS CONTRACTOR ACKNOWLEDGES HE/SHE IS AWARE OF NPDES GUIDELINES AND POLICIES AS WELL AS BEST MANAGEMENT PRACTICES AND ASSUMES SOLE RESPONSIBILITY FOR FINES IMPOSED BY GOVERNMENTAL AGENCIES DUE TO VIOLATIONS.

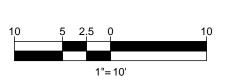

<image/> Image: Non-State State    Image: Non-State    Image: Non-State
REVISIONS
REV  DATE  COMMENT  DRAWN BY CHECKED BY    1  2019-08-23  CITY OF DELRAY BEACH COMMENTS  LJL    2  2019-09-10  SPRAB COMMENTS  AS    3  2019-11-22  TEAM GFA COMMENTS  LJL    4  2019-11-22  SPRAB COMMENTS  AS    4  2019-11-22  SPRAB COMMENTS  AS    4  2019-11-22  SPRAB COMMENTS  AS
THIS DRAWING IS INTENDED FOR MUNICIPAL AND/OR AGENCY REVIEW AND APPROVAL. IT IS NOT INTENDED AS A
CONSTRUCTION DOCUMENT UNLESS INDICATED OTHERWISE.
Know what's below. Call before you dig. ALWAYS CALL 811 It's fast. It's free. It's the law.
ISSUED FOR MUNICIPAL &
AGENCY REVIEW & APPROVAL
PROJECT No.:      FLB180120        DRAWN BY:      LJL        CHECKED BY:      AS        DATE:      2019-10-25        CAD I.D.:      FLB180120-OBP-2
PROJECT: PIERRE DELRAY PHASE 1 - SPRAB SITE PLAN PACKAGE (AKA SUNTRUST BUILDING) FOR
CLIENT ZYSCOVICH A R C H I T E C T S PROPOSED DEVELOPMENT 302 E ATLANTIC AVE
PALM BEACH COUNTY DELRAY BEACH, FL
<b>BOHLER</b>
ENGINEERING 2255 GLADES ROAD, SUITE 305E BOCA RATON, FLORIDA 33431 Phone: (561) 571-0280
Fax: (561) 571-0281 FLORIDA BUSINESS CERT. OF AUTH. No. 30780 LANDSCAPE ARCHITECT BUSINESS LIC. No LC26000551
SHEET TITLE: EROSION AND SEDIMENTATION CONTROL PLANS PHASE II
sheet NUMBER: C-606

REVISION 4 - 2019-11-22