A PRIVATE RESIDENTIAL PROJECT: HPB DESIGN SUBMITAL THE ROBIN MARINO RESIDENCE: A BANKER'S ROW SINGLE FAMILY HOME

223 NE 1ST AVENUE DELRAY BEACH, FLORIDA 33444

INDEX **GENERAL NOTES** CODES VICINITY MAP

ARCHITECTURAL:

- THE CONTRACTOR SHALL PERFORM ANY AND ALL CUTTING AND PATCHING NECESSARY TO COMPLETE THE WORK.
- 2. THE CONTRACTOR SHALL NOT DISRUPT EXISTING SERVICES, OPERATIONS, OR UTILITIES WITHOUT OBTAINING OWNER'S PRIOR APPROVAL AND INSTRUCTIONS IN EACH CASE.
- 3. ALL CONSTRUCTION AND WORKMANSHIP SHALL CONFORM TO THE REQUIREMENTS OF LOCAL CODES.
- 4. THE CONTRACTOR SHALL VISIT THE JOB SITE AND BE RESPONSIBLE FOR THE VERIFICATION OF ALL ELEVATIONS, CONDITIONS, AND DIMENSIONS PRIOR TO COMMENCING CONSTRUCTION.
- 5. ANY CONFLICTS OR OMISSIONS BETWEEN THE VARIOUS ELEMENTS OF THE WORKING DRAWINGS AND/OR GENERAL NOTES SHALL BE BROUGHT TO THE ATTENTION OF THE ARCHITECT IMMEDIATELY AND BEFORE PROCEEDING WITH ANY WORK SO INVOLVED. DO NOT SCALE DRAWINGS.
- 6. THE GENERAL CONTRACTOR SHALL COORDINATE AND VERIFY WITH ALL SUBCONTRACTORS THE SIZE AND LOCATION OF ALL PIPING, DUCTWORK, TRENCHES, SLEEVES, SPECIAL BOLTING FOR EQUIPMENT CONDUITS,
- 1. THE GENERAL CONTRACTOR SHALL BE SOLELY RESPONSIBLE FOR ALL MEANS AND METHODS OF CONSTRUCTION.
- THE CONTRACTOR SHALL BE RESPONSIBLE FOR LEAVING ALL FINISH SURFACES CLEAN AT COMPLETION OF THE WORK AND SHALL REMOVE ALL EXCESS MATERIAL AND DEBRIS FROM THE JOB REGULARLY.
- JOB SITE MEASUREMENTS ARE THE FULL RESPONSIBILITY OF THE CONTRACTOR AND/OR SUBCONTRACTOR AND MUST BE TAKEN FOR ALL ITEMS BY ALL SUBCONTRACTORS PRIOR TO FABRICATION.
- 10. THE GENERAL CONTRACTOR SHALL BE RESPONSIBLE FOR INSTALLING SOLID P.T. BLOCKING BEHIND ALL SHELVING, CABINETS, ETC., OR EQUIPMENT REQUIRING BACKING.
- FINAL INSPECTIONS ARE REQUIRED FOR ALL PERMITS

- FLORIDA BUILDING CODE, 2017 EDITION
- NFPA 7-101 LIFE SAFETY CODE

DETAIL REFERENCE:

ELEVATION REFERENCE:

SECTION REFERENCE:

INTERIOR ELEVATION

ROOM REFERENCE:

DOOR REFERENCE:

WINDOW REFERENCE:

NOTE REFERENCE:

REVISION REFERENCE:

REFERENCE

- FLORIDA FIRE PREVENTION CODE, 2017 EDITION NATIONAL ELECTRICAL CODE, 2017 EDITION
- FLORIDA MECHANICAL CODE, 2017 EDITION
- FLORIDA PLUMBING CODE, 2017 EDITION FLORIDA ACCESSIBILITY CODE/ADA-90, 2017 EDITION
- ALL OTHER RULES, REGULATIONS AND CODES HAVING JURISDICTION INCLUDING BUT NOT NECESSARILY LIMITED TO:
- CITY OF DELRAY BEACH, PALM BEACH COUNTY THE STATE OF FLORIDA
- CITY OF DELRAY BEACH ZONING REGULATIONS CITY OF DELRAY BEACH ADOPTED ORDINANCES

BLDG. DESIGN DATA

OCCUPANCY CLASSIFICATION: SINGLE FAMILY RESIDENTIAL BLDG. CONSTRUCTION TYPE: TYPE Y, PROTECTED ZONING DISTRICT: OSSHAD, SINGLE FAMILY RESIDENTIAL DESIGN WIND LOAD: 170 MILES PER HOUR (3 SECOND GUST) BUILDING HEIGHT LIMITATION: 35 FEET

SYMBOLS

--- DETAIL NUMBER

ELEVATION NUMBER

LOS SECTION NUMBER

----- SHEET NUMBER

- WALL NUMBER

- DOOR NUMBER

REFERENCE NUMBER

- REVISION NUMBER

WINDOW NUMBER

- INTERIOR ELEY.

 $102 \leftarrow$ ROOM NUMBER

PROJECT LOCATION

TRUE NORTH

ARCHITECTURAL DOCUMENTS:

- ARCHITECTURAL SPECIFICATIONS
- SURVEY AS PROVIDED BY OWNER
- ARCHITECTURAL SITE PLAN
- ARCHITECTURAL SITE PLAN DETAILS
- EXISTING ARCHITECTURAL MAIN COTTAGE FLOOR PLAN
- EXISTING ARCHITECTURAL REAR COTTAGE FLOOR PLAN
- PROPOSED ARCHITECTURAL MAIN COTTAGE FLOOR PLAN
- PROPOSED ARCHITECTURAL REAR COTTAGE FLOOR PLAN
- PROPOSED ARCHITECTURAL MAIN COTTAGE REFLECTED CEILING PLAN **A42**
- **A43** PROPOSED COMBINATION FLOOR PLAN: MAIN & REAR COTTAGE
- EXISTING ARCHITECTURAL MAIN COTTAGE ELEVATIONS
- PROPOSED ARCHITECTURAL MAIN COTTAGE ELEVATIONS
- EXISTING ARCHITECTURAL MAIN COTTAGE ELEVATIONS PROPOSED ARCHITECTURAL MAIN COTTAGE ELEVATIONS
- EXISTING & PROPOSED ARCHITECTURAL REAR COTTAGE ELEVATIONS
 - DOOR & WINDOW SCHEDULE

ABBREVIATIONS

BOARD BUILDING BLOCK BLOCKING BEAM BOTTOM

ACOUSTICAL ADJUSTABLE ALUMINUM APPROXIMAT

CABINET
CEMENT
CERAMIC
CAST IRON
CLEAR
COLUMN
CONCRETE
CONNECTION
CONTINUOUS
COUNTERSUN DECORATIVE

DETAIL
DETAIL
DOUGLAS FIR
DIAMETER
DIMENSION
DOWN
DOWN SPOUT
DRAWING

INGIDE DIAMETER INCANDESCENT INCULATION INTERIOR

LAMINATE LAVATORY LOCATION

MAXIMUM MECHANICAL

METAL MANUFACTURER

EGUAL EXHAUST EXPANSION EXTERIOR EXISTING

FORCE AIR UNIT FIRE HOSE CABINET FINISH FLOOR FLASHING FLUORESCENT FACE OF FINISH FACE OF STUD FACE OF STUD HOSE BIBB HOLLOW CORE HARDWOOD HARDWARE HEIGHT HOLLOW METAL HORIZONTAL

NOT IN CONTRACT NUMBER NOT TO SCALE OVERALL OBSCURE ON CENTER ON CENTER OUNER FURNISH/ CONTRACTOR INSTALL OFFICE OPENING OPPOSITE

PLATE
PLASTER
PLYWOOD
PAIR
PRECAST
PRESSURE TREATED
DOUGLAG FIR QUARRY TILE RISER
RADIUS
REINFORCE
REGUIRED
ROOM
ROUGH OPENING
REDWOOD
RAIN WATER LEADER

SOLID CORE
SCHEDULE
SHEET
SIMILAR
SQUARE
STAINLESS STEEL
STANDARD
STEEL
STORAGE
STRUCTURAL
SUSPENDED
SYMMETRICAL

TREAD
TOP OF CURB
TELEPHONE
TONGUE AND GROOVE
THICK
TOP OF CHIMNEY
TOP OF FRAMING
TOP OF PRAPET
TOP OF PLATE
TYPICAL UNLESS OTHERWISE NOTED

VERTICAL VESTIBULE VERTICAL GRAIN DOUGLAS FIR WITH
WITHOUT
WATER CLOSET
WOOD
WINDOW
WATER HEATER
WANSCOT
WEIGHT SYMBOLS AND ANGLE

CENTER LINE

DIAMETER OR ROUND

ARCHITECT:

COPE ARCHITECTS, INC. 701 SE IST STREET DELRAY BEACH, FLORIDA 33483

cell (561) 789-3791 email copearchitectsinc@gmail.com

MECHANICAL/ELECTRICAL/PLUMBING ENGINEER

PROJECT TEAM

BEACON CONSULTING ENGINEERS 1640 NW 2ND AVENUE BOYNTON BEACH, FLORIDA 33432

PHO (561) 391-9292 FAX (561) 391-9898

STRUCTURAL ENGINEER

601 NORTH CONGRESS AVENUE, SUITE *106-A DELRAY BEACH, FLORIDA 33445

PHO (561) 265-6864 FAX (561) 265-6866

LANDSCAPE ARCHITECT.

GENERAL LANDSCAPING, CORP. 845 NE TIST STREET BOCA RATON, FLORIDA 33487-2435

PHO (561) 994-3755 FAX (561) 997-8667

© COPE ARCHITECTS, INC., 2020

AND SHALL NOT BE REPRODUCED WITHOUT THE AUTHORIZED WRITTEN
CONSENT OF COPE ARCHITECTS, INC.

0

3

RW COPE Project No. 2018.35MARINO CAD File No. **COVER SHEET**

MARCH 02, 2020

GENERAL NOTES

ARCHITECTURAL:

- THESE DOCUMENTS INDICATE THE DESIGN INTENT OF THE CONSTRUCTION PROJECT IN ORDER TO ESTABLISH STANDARDS FOR QUALITY AND/OR PERFORMANCE.
- 2. THE CONTRACTOR SHALL INVESTIGATE THE JOBSITE & COMPARE THE CD'S W/ THE EXISTING CONDITIONS. THE CONTRACTOR SHALL INCLUDE IN HIS COST WORK DESCRIBED IN THE CD'S & THAT IS REQUIRED OR REASONABLY IMPLIED TO ACHIEVE THE DESIGN INTENT OF THE CD'S. THE CONTRACTOR SHALL NOTIFY THE ARCHITECT OF ANY CONFLICTS BETWEEN EXISTING CONDITIONS & ANY NEW WORK, OF ANY OMISSIONS IN THE DRAWINGS & ANY RESTRICTIONS RELATED TO THE EXECUTION OF THE WORK INCLUDING THE COORDINATION W/ STRUCTURAL AND MEP RELATED WORK.
- 3. THE CONTRACTOR SHALL BE REQUIRED TO PROVIDE A COMPLETE JOB IN EVERY RESPECT THAT ALLOWS FOR THE FULL USE OF THE COMPLETED FACILITY & CONSISTENT W/ THE DESIGN INTENT OF THE CD'S. THIS SHALL INCLUDE, BUT NOT BE LIMITED TO, COMPLETE UTILITY CONNECTIONS FOR H20, SEWER, RAIN WATER LEADERS, DRAINS, POWER (W/ TRANSFORMING TO ACHIEVE APPROPRIATE & NECESSARY VOLTS & AMPS), GROUNDS, NATURAL OR LP GAS, VENTS, VENTILATION, SMOKE EVACUATION, & BLOCKING, BRIDGING, STRUCTURAL SUPPORTS, ETC. TO ALLOW FOR THE COMPLETE & WORKING OF NOTED OR INFERRED EQUIPMENT.
- REASONABLY INFERRED CONDITIONS NOT OTHERWISE INDICATED IN THESE CD'S SHALL BE INTERPRETED AS HAVING THE SAME MEANING AS THOSE MOST SIMILARLY DETAILED & MORE FULLY DEFINED ELSEWHERE WITHIN THESE DOCUMENTS. CONTRACTOR IS TO NOTIFY THE ARCHITECT IF CLARIFICATIONS ARE REQUIRED. CONTRACTOR SHALL BE LIABLE IF INAPPROPRIATE INTER-PRETATIONS CONFLICT WITH OTHER ELEMENTS OF THE WORK.
- THE CONTRACTOR SHALL FIELD VERIFY CONDITIONS & DIMENSIONS INDICATED W/ THE CD'S & SHALL NOTIFY THE ARCHITECT OF ANY VARIATION PRIOR TO THE THE PURCHASING OF MATERIALS, FABRICATION OR CONSTRUCTION. THE CONTRACTOR SHALL BE LIABLE FOR RESTOCKING CHARGES, REPLACEMENT COSTS & FOR DELAYS IF HE FAILS TO COMPLY W/ THIS PROVISION.
- THE GENERAL CONTRACTOR, UPON AWARDING CONTARCTS TO SUB-CONTRACTORS, SHALL SUBMIT TO THE ARCHITECT & THE OWNER A LIST OF ITEMS & THEIR DELIVERY SCHEDULES. THE CONTRACTOR, PRIOR TO ORDERING AN ITEM, SHALL BE RESPONSIBLE FOR NOTIFYING THE ARCHITECT & OWNER OF ANY ITEM WHICH MAY CAUSE THE PROJECT TO BE DELAYED DUE TO LONG LEAD TIME IN OBTAINING.
- 1. THE CONTRACTOR SHALL BE RESPONSIBLE FOR ACHIEVING SUBSTANTIAL COMPLETION REGARDLESS OF DELIVERY DATES FOR MATERIALS & EQUIP'MT.
- 8. THE ARCHITECT HAS NOT CONDUCTED NOR INTENDS TO CONDUCT ANY INVESTIGATION AS TO THE PRESENCE OF HAZARDOUS MATERIALS, INCLUDING ASPESTOS, WITHIN THE CONFINES OF THIS PROJECT. THE ARCHITECT ACCEPTS NO RESPONSIBILITY FOR THE IDENTIFICATION, THE REMOVAL OR ANY EFFECTS FROM THE PRESENCE OF THESE MATERIALS.
- THE CONTRACTOR SHALL ISSUE COMPLETE SETS OF CD'S TO EACH OF THE SUB-CONTRACTORS FOR COORDINATION OF THEIR WORK AND DESCRIPTION OF SCOPE.
- 10. THE CONTRACTOR SHALL APPLY FOR, OBTAIN & PAY FOR PERMITS, FEES, INSPECTIONS & APPROVALS BY LOCAL AUTHORITIES HAVING JURISDICTION OVER THE PROJECT. CONTRACTOR IS TO PROVIDE COPIES OF TRANSACTIONS TO OWNER. NOTIFY ARCHITECT OF ANY VARIANCE W/ CODES IN FORCE. CONTACTOR SHALL BE RESPONSIBLE FOR COMPLIANCE W/ THE REGULATIONS of any & all public authorities (federal, state & local) having JURISDICTION OVER THE PROJECT.
- 11. PROVIDE & PAY FOR ANY AND ALL MATERIALS, LABOR, EQUIPMENT, TOOLS, CONSTRUCTION EQUIPMENT, WAREHOUSING, TRANSPORTATION & DELIVERY COSTS, HOISTING, REMOVAL OF TRASH & DEBRIG, & OTHER FACILITIES & SERVICES NECESSARY FOR THE EXECUTION & COMPLETION OF THE WORK.
- 12. WORK SHALL BE PERFORMED BY THE GENERAL CONTRACTOR UNLESS OTHER-WISE NOTED. REFERENCES TO THE CONTRACTOR SHALL INCLUDE THE GENERAL CONTRACTOR AND SUB-CONTRACTORS.
- 13. THE CONTRACTOR SHALL BE SOLELY RESPONSIBLE FOR, 4 HAVING CONTROL OVER CONSTRUCTION MEANS, TECHNIQUES, SEQUENCES & PROCEDURES & FOR COORDINATING PORTIONS OF THE WORK REQUIRED BY THE CD'S.
- 14. THE ARCHITECT & OWNER SHALL NOT BE RESPONSIBLE FOR THE ERRORS, OMISSIONS OR DELAYS RESULTING FROM THE CONTRACTOR'S PERFORMANCE.
- 15. THE CONTRACTOR SHALL BE RESPONSIBLE FOR ACTS & OMISSIONS OF THE CONTRACTOR'S EMPLOYEES, SUB-CONTRACTORS & THEIR AGENTS & EMPLOYEES & ANY OTHER PERSONS PERFORMING ANY OF THE WORK UNDER A CONTRACT WITH THE CONTRACTOR.
- 16. OTHER CONTRACTORS & THEIR SUB-CONTRACTORS MAY BE WORKING ON THE PREMISES SIMULTANEOUS WITH THE DURATION OF THIS CONTRACT, NO ACTION SHALL BE TAKEN ON THE PART OF THIS CONTRACTOR OR ANY SUB-CONTRACTOR, TO IMPEDE THE ACCESS OR OPERATION OF ANY OTHER CONTRACTOR ON THE PREMISES, EITHER UNION OR NON-UNION.
- 17. WORK SHALL BE DONE DURING NORMAL WORKING HOURS, CONTRACTOR SHALL SCHEDULE & PERFORM SO AS NOT TO UNREASONABLY DISTURB ANY NEIGHBORS & SHALL BE RESPONSIBLE FOR ANY OVERTIME COSTS INCURRED THEREBY.
- 18. THE CONTRACTOR SHALL COORDINATE & WORK W/ BUILDING OWNER REGARD-ING HEAT, WATER, ELECTRICITY, DELIVERIES, ACCESS, ELEVATOR AVAIL-ABILITY, STAGING, NOISE CONTROL, TRASH & DEBRIS REMOVAL, HOISTING, # ANY OTHER UTILITIES OR OWNER'S RULES # REGULATIONS CONCERNING THE PROJECT SITE. CONTRACTOR SHALL COORDINATE USE OF RESTROOM FACILITIES FOR HIS EMPLOYEES WITH THE OWNER.
- 19. THE CONTRACTOR SHALL PROCURE MATERIALS SO AS NOT TO DELAY SUBSTANTIAL COMPLETION. THE CONTRACTOR SHALL NOTIFY ARCHITECT WITHIN FIVE (5) DAYS OF EXECUTION OF CONTRACT OF ANY MATERIAL DELIVERY WHICH COULD DELAY COMPLETION OF THE CONTRACT.
- 20. COORDINATE SCHEDULING, PROVISIONS FOR INSTALLATION, LOCATIONS, \$ INSTALLATION OF ITEMS FURNISHED BY THE OWNER & BY OTHERS, FOR THE PURPOSES OF THIS CONTRACT. THE FOLLOWING ABBREVIATIONS APPLY: OF-OI = OWNER FURNISHED & OWNER INSTALLED, OF-CI = OWNER FURNISHED & CONTRACTOR INSTALLED, CF-CI = CONTRACTOR FURNISHED & CONTRACTOR INSTALLED, AND CF-01 = CONTRACTOR FURNISHED & OWNER INSTALLED.
- 21. THE CONTRACTOR SHALL COORDINATE & WORK W/ TRADES ON THE PROJECT NOT UNDER CONTRACT W/ THE CONTRACTOR (I.E. TELEPHONE, DATA LINES. FIRE ALARM, ETC.). ANY CHANGES OR DELAYS ARISING FROM CONFLICTS BETWEEN SUCH TRADES SHALL BE THE RESPONSIBILITY OF THE CONTRACTOR AT NO ADDITIONAL EXPENSE TO THE OWNER.

- 22. UNLESS OTHERWISE NOTED, WHEN DRAWINGS ARE IN CONFLICT, ENLARGED PLANS & DETAILS SHALL GOVERN. HOWEVER, THE ARCHITECT SHALL MAKE THE FINAL DETERMINATION IN THESE MATTERS.
- 23. SUBMIT FOR ARCHITECT'S REVIEW ABOVE BUILDING STANDARD SAMPLES \$ LITERATURE. SUBMIT FOR ARCHITECT'S CONSIDERATION SAMPLES & PRODUCT LITERATURE & OTHER PERTINENT DATA OF ANY PROPOSED SUBSTITUTIONS. ANY SUBSTITUTIONS PROPOSED BY THE CONTRACTOR SHALL BE SUBMITTED TO THE ARCHITECT FOR APPROVAL PRIOR TO IMPLEMENTATION. IT IS THE CONTRACTOR'S RESPONSIBILITY TO RESEARCH & QUALIFY THAT THE PERFORMANCE & CONSTRUCTION SPECIFICATIONS MEET THOSE OF THE ORIGINALLY SPECIFIED ITEM PRIOE TO SUBMISSION FOR APPROVAL. CONTRACTOR SHALL BE LIABLE FOR MATERIALS THAT ARE NOT AVAILABLE DUE TO UNTIMELY ORDERING & FOR THE COORDINATION OF SUBSTITUTIONS W/ OTHER TRADES & DISCIPLINES.
- 24. SHOP DRAWINGS (TWO (2) COPIES TO ARCHITECT & TWO (2) COPIES TO ENGINEER), AS REQUIRED, SHALL BE SUBMITTED FOR REVIEW PRIOR TO FABRICATION OR CONSTRUCTION. SUBMIT FOR ARCHITECT'S REVIEW PRIOR TO FABRICATION OR PURCHASE. SHOP DRAWINGS OR SAMPLES FOR MILLWORK, CUSTOM METALWORK CUSTOM CASEGOODS & OTHER ITEMS AS REQUIRED BY ARCHITECT FOR ABOVE BUILDING STANDARDS ITEMS.
- CHANGES IN THE WORK SHALL ONLY BE ALLOWED W/ ONE OF THE FOLLOWING WRITTEN DIRECTIVES: 1.) ARCHITECT'S DIRECTIVE FOR MINOR CHANGES IN WORK, 2.) CONSTRUCTION CHANGE DIRECTIVE FROM THE ARCHITECT, OR 3.) CHANGE ORDER ISSUED BY THE ARCHITECT. CHANGES MUST FOLLOW MODIFICATION PROCEDURES NOTED IN AIA A201 - ARTICLE 7. CHANGES REQUIRING A CHANGE IN COST OR TIME MUST BE EXPLICITLY NOTED AT TIME OF DISCUSSION IN FIELD, NOTIFICATION OR ARCHITECT OR AT JOB PROGRESS MEETING & FOLLOWED UP WITHIN TWO (2) WORKING DAYS BY WRITTEN CONFIRMATION. IF CHANGE IS AGREED TO WITHOUT EXPLICIT REFERENCE TO CHANGE IN COST OR TIME, A SUBSEQUENT CHANGE ORDER MAY BE JUSTIFIABLY REJECTED.
- 26. PERFORM WORK & INSTALL MATERIALS IN STRICT ACCORDANCE W/ MANUFACTURER'S SPECIFICATIONS & INSTRUCTIONS & IN A MANNER CONSISTENT W/ INDUSTRY STANDARDS FOR WORKMANSHIP.
- 27. GYPSUM & METAL STUD CONSTRUCTION SHALL BE DONE IN ACCORDANCE W/ RECOMMENDATIONS & INSTRUCTIONS PUBLISHED BY U.S. GYPSUM COMPANY -GYPSUM CONSTRUCTION HANDBOOK,, LATEST EDITION. CONSTRUCTION JOINTS MUST OCCUR AT A MAXIMUM OF 25 FT. ON UNDERSIDE OF ROOF DECK.
- 28. FINISH CARPENTRY & MILLWORK SHALL BE DONE IN ACCORDANCE W/ THE ARCHITECTURAL WOODWORKS INSTITUTE (AWI) STANDARDS FOR SELECTION OF MATERIALS, HARDWARE, FABRICATION, WORKMANSHIP & FINISHING.
- 29. EXAMINE SURFACES TO DETERMINE THAT THEY ARE SOUND, DRY, CLEAN & READY TO RECEIVE FINISHES OR MILLWORK PRIOR TO INSTALLATION. START OF INSTALLATION SHALL IMPLY ACCEPTANCE OF SUBSTRATE & SHALL NOT BE GROUNDS FOR CLAIMS AGAINST IMPROPER PERFORMANCE OF INSTALLED MATERIAL ADVISE ARCHITECT OF ANY EXISTING CONSTRUCTION NOT LEVEL, SMOOTH \$ PLUMB WITHIN INDUSTRY STANDARDS PRIOR TO START OF CONSTRUCTION.
- 30. INSTALL & MAINTAIN NECESSARY COVERINGS, PROTECTIVE ENCLOSURES, TEMPORARY DOORS & PARTITIONS & DUST BARRIERS TO PROTECT OCCUPANTS & EXISTING WORK & FINISHES TO REMAIN. REPAIR & REPLACE ANY DAMAGES CAUSED BY INPROPER PROTECTION AT NO ADDITIONAL CHARGE TO OWNER. THE CONTRACTOR SHALL BE RESPONSIBLE FOR ANY & ALL DAMAGE WHICH MAY OCCUR DURING EITHER THE DEMOLITION OR CONSTRUCTION PHASE TO THE EXISTING BUILDING. CONTRACTOR SHALL REPAIR SAME IMMEDIATELY TO MATCH ADJACENT SURFACES IN GOOD CONDITION.
- 31. WORK DAMAGED DURING CONSTRUCTION OR NOT CONFORMING TO SPECIFIED STANDARD TOLERANCES OR MANUFACTURER'S INSTRUCTIONS FOR INSTALLATION SHALL BE REPLACED AT NO ADDITIONAL COST TO THE OWNER.
- 32. MAINTAIN EXIT, EXIT LIGHTING, FIRE PROTECTIVE DEVICES & LIFE SAFETY SYSTEMS IN WORKING ORDER.
- 33. EXIT DOORS, EGRESS DOORS & OTHER DOORS REQUIRED FOR MEANS OF EGRESS SHAL BE OPERABLE FROM INSIDE WITHOUT USE OF A KEY OR SPECIAL KNOW-LEDGE OR EFFORT.
- 34. VERIFY KEYING REQUIREMENTS OF ALL NEW LOCKS WITH OWNER.
- 35. 24 HOURS PRIOR TO OCCUPANCY OF ANY PHASE, THOROUGHLY CLEAN SURFACES OF DUST, DEBRI, LOOSE CONSTRUCTION MATERIAL & EQUIPMENT. VACUUM OR MOP FLOORS & CLEAN WINDOWS. THE CONTRACTOR, AT THE COMPLETION OF THE PROJECT, SHALL CLEAN THE ENTIRE BUILDING AND LEAVE IT IN ACCEPTABLE CONDITION.
- 36. SUBSTANTIAL COMPLETION SHALL BE THE DATE ON WHICH THE PREMISES ARE AVAILABLE FOR OCCUPANCY FROM THE CONTRACTOR & SHALL BE AS DEFINED IN AIA DOCUMENT A201. ADDITIONAL TOUCH-UP OR MINOR INSTALLATION WORK MAY BE INCOMPLETE.
- 37. WARRANT TO THE OWNER THAT ALL MATERIALS & EQUIPMENT FURNISHED & INSTALLED UNDER THIS CONTRACT SHALL BE NEW UNLESS OTHERWISE SPECIFIED, # WORK SHALL BE OF GOOD QUALITY, FREE FROM FAULTS # DEFECTS # CONFORMS WITH THE CONTRACT DOCUMENTS.
- 38. FOR A PERIOD OF ONE (1) YEAR BEGINNING AT THE DATE OF SUBSTANTIAL COMPLETION, CONTRACTOR SHALL PROMPLY CORRECT WORK FOUND NOT TO BE IN ACCORDANCE W/ THE CONTRACT DOCUMENTS. CONTRACTOR SHALL BEAR ALL COSTS OF CORRECTIONS.
- 39. UNLESS OTHERWISE NOTED, FASTENERS & ATTACHMENTS SHALL BE FULLY CONCEALED FROM VIEW.
- 40. THE ARCHITECT'S SEAL AFFIXED TO THESE CONTRACT DOCUMENTS, SHALL CERTIFY TO THE BEST OF OUR KNOWLEDGE, THAT THESE DRAWINGS MEET THE APPLICABLE STATE & LOCAL CODES. IF ANY PORTION OF THESE DOCUMENTS IS FOUND TO BE IN CONFLICT W/ STATE OR LOCAL CODES, THE ARCHITECT SHALL BE NOTIFIED IN WRITING BY THE CONTRACTOR.
- 41. CONTRACTOR SHALL BE RESPONSIBLE IN PROVIDING THE OWNER A COMPLETE SET OF "AS-BUILT" OR "RECORD" DOCUMENTS.
- 42. PROVISIONS OF THE AIA A201 GENERAL CONDITIONS, APPLY TO THIS CONTRACT BY REFERENCE UNLESS SPECIFICALLY MODIFIED IN WRITING BY THE OWNER OR ARCHITECT.

BUILDING CODE COMPLIANCE:

- THE CONTRACTOR SHALL PERFORM WORK IN ACCORDANCE W/ APPLICABLE CODES, REGULATONS, LOCAL AUTHORITY REGULATIONS & LOCAL CODE OFFICIAL'S DIRECTIVES.
- 2. THE CONTRACTOR SHALL PROVIDE TERMITE PROTECTION AS PER FBC 1816.1.7

PARTITION NOTES:

- CLEAR DIMENSIONS MUST BE HELD. DIMENSIONS NOTED AS FINISHED FACE.
- 2. DRAWING DIMENSIONS ARE TO THE FACE OF STUD SURFACE UNLESS CLEAR OR CRITICAL SHALL BE MEASURED FROM FINISH FACE TO FINISH FACE.
- 3. MAKE NO MECHANICAL ATTACHMENTS TO EXTERIOR BUILDING SURFACES WITHOU PRIOR NOTIFICATION AND APPROVAL FROM THE ARCHITECT.
- 4. CONSTRUCT CEILINGS & PARTITIONS PER MANUFACTURER'S RECOMMENDATIONS WITH DEFLECTIONS NOT TO EXCEED 1/240 OF THE SPAN. PROVIDE FIRE RATINGS AS REQUIRED BY CODE - SEE FBC AND LOCAL CODE AMMENDMENTS FOR ANY SPECIAL FIRE STOPPING REQUIREMENTS.
- 5. INSTALL WOOD BLOCKING AT ANY PARTITION SCHEDULED TO RECEIVE HANGING CABINETRY AND/OR SHELVING.
- 6. INSTALL MOISTURE RESISTANT SUBSTRATE (WATER RESISTANT TYPE GYPSUM BOARD OR CEMENTITIOUS BOARD) WHERE CERAMIC TILE OR STONEWORK IS INDICATED.
- 7. INSTALL STEEL FRAMING FOR PARTITIONS TO COMPLY WITH ASTM C-754 & THE GYPSUM CONSTRUCTION HANDBOOK BY U.S. GYPSUM, LATEST EDITION.
- 8. INSTALL & FINISH GYPSUM BOARD TO COMPLY W/ ASTM C-840, GA-216 BY GYPSUM ASSOCIATION & GYPSUM CONSTRUCTION HANDBOOK BY U.S. GYPSUM, LATEST EDITION. PREPARE SURFACE AS REQUIRED FOR FINAL SURFACE FINISH AS RECOMMENDED BY GYPSUM CONSTRUCTION HADBOOK.
- 9. PROVIDE FRE RESISTANCE RATED PARTITION ASSEMBLIES IDENTICAL TO U.L. DESIGNATIONS (UNDERWRITERS LABORATORY) SHOWN IN THE FIRE RESISTANCE DIRECTORY OR LISTED BY OTHER TESTING AGENCIES ACCEPTABLE TO AUTHORITIES HAVING JURISDICTION.

MILLWORK NOTES:

- MILLWORK & CASEWORK SHALL COMPLY W/ ARCHITECTURAL WOODWORK QUALITY STANDARDS, GUIDE SPECIFICATIONS & QUALITY CERTIFICATION PROGRAM, LATEST EDITION, CUSTOM GRADE UNLESS OTHERWISE NOTED.
- 2. INSTALL FIRE RETARDANT TREATED WOOD PRODUCTS WHERE REQUIRED TO COMPLY WITH THE BUILDING CODE.
- COORDINATE INSTALLATION OF ALL IN-WALL STEEL ANCHORAGE, GROUNDS, \$ MISCELLANEOUS BLOCKING W/ OTHER TRADES FOR PRECISE LOCATION.
- THE MILLWORK CONTRACTOR SHALL OBTAIN & VERIFY FIELD MEASUREMENTS & CONDITIONS AFFECTING HIS WORK & SHALL BE RESPONSIBLE FOR DETAILS & DIMENSIONS ASSURING PRECISION & PROPER ASSEMBLY OF HIS PRODUCTS.
- 5. COORDINATE ITEMS TO INSURE DELIVERY TO THE PROPER LOCATION & VERIFY PHYSICAL ACCOMMODATION WITHIN THE CONFINES OF THE PROJECT AS REQUIRED.
- 6. SET WORK PLUMB, LEVEL & SQUARE, SCRIBED TIGHTLY & ACCURATELY TO ADJ'T. SURFACES, SECURELY ANCHORED IN POSITION INDICATED ON DRAWINGS TO HIGHEST QUALITY STANDARDS.
- 1. LAMINATE EDGES OF COUNTERTOPS & EDGES OF DOORS PRIOR TO FACING COUNTERTOPS OR DOORS.
- COORDINATE EXACT PLACEMENT OF PLUMBING & ELECTRICAL FIXTURES, SWITCHES & OUTLETS TO BE INSTALLED WITHIN THE MILLWORK.
- 9. REPAIR, REPLACE OR OTHERWISE MAKE GOOD TO SATISFACTION OF ARCHITECT DAMAGE INCURRED TO MILLWORK DURING CONSTRUCTION.
- 10. ADJUST DOORS, DRAWERS & HARDWARE FOR PROPER OPERATION & CLEAN SURFACES, INSIDE & OUT.
- COMPLY W/ MILLWORK MANUFACTURER'S & INSTALLER'S RECOMMENDED OPTIMUM TEMPERATURE & HUMIDITY CONDITIONS FOR STORAGE & INSTALLATION OF WORK.
- 12. COMPLY W/ ARCHITECTURAL WOODWORK QUALITY STANDARDS, GUIDE SPECIFICATIONS & QUALITY CERTIFICATION PROGRAM, SECTION 1500 FACTOR FINISHING SYSTEMS FOR FINISHES NOTED.

FINISH NOTES:

- INSPECT MATERIALS FOR DEFECTS, FLAWS, SHIPPING DAMAGE, CORRECT COLOR & PATTERN, INFORM ARCHITECT OF ANY DEFECTIVE MATERIALS & COORDINATE W/ THE MANUFACTURER FOR ACCURATE SHIPPING DATES FOR THE REPLACEMENT
- 2. FLOOR COVERINGS SHALL BE REPAIRED IN RENOVATION WORK TO MATCH ADJACENT SURFACES. FLOOR COVERINGS IN CLOSETS SHALL MATCH ADJACENT SURFACES. FLOOR COVERING IN CLOSETS SHALL MATCH ADJACENT ROOM UNLESS NOTED OTHERWISE.
- 3. CONTRACTOR WILL BE RESPONSIBLE FOR PROVING AN APPROPRIATELY LEVEL & SMOOTH CONCRETE OR OTHER SUBSTRATE TO MEET THE CARPET (IF CARPET IT USED) MEETING INDUSTRY STANDARDS PRIOR TO INSTALLATION.
- CARPET, IF USED, SHALL BE INSTALLED IN THE SAME DIRECTION. SEAM CARPET AT DOORS AND ON CENTERLINE OF DOORS, TYPICAL

PAINTED SURFACES:

- PAINTED FINISH METAL & WOOD TRIM SHALL BE SEMI-GLOSS ALKYD ENAMEL COLOR TO MATCH ADJACENT WALL UNLESS NOTED OTHERWISE. OTHER SURFACES SHALL BE LATEX, FLAT FINISH. PAINTED FINISHES WITHIN BATHROOMS & KITCHEN/ GALLEYS/PANTRY SHALL BE SEMI-GLOSS ALKYD ENAMEL.
- PREPARE FOR & APPLY PAINT IN ACCORDANCE W/ THE MANUFACTURER'S SPEC'S. FOR THE PARTICULAR SURFACE, ONE (1) COAT PRIME & TWO (2) FINISH COATS MINIMUM APPLICATION. FOLLOW INDUSTRY STANDARDS FOR SURFACE PREPARATION & APPLICATION ENVIRONMENT (TEMPERATURE & HUMIDITY).

WALL COYERING:

- INTERIIOR FINISH MATERIALS SHALL COMPLY WITH LOCAL CODES. WHEN REQUIRED BY BUILDING OFFICIAL(S), APPLY FLAME PROOFING TO FABRIC WALL COVERINGS.
- 2. WALL COVERINGS SHALL BE INSTALLED ACCORDING TO MANUFACTURER'S SPECIFICATIONS FOR THE PARTICULAR SURFACE APPLICATION, INCLUDING TEMPERATURE AND DUST CONTROL. WALL COVERING REQUIRING BACKING SHALL BE SO APPROVED. APPLY WALL PRIMER PRIOR TO APPLYING ADHESIVE FOLLOWING MANUFACTURER'S INSTRUCTION.
- INSTALL SEAMS PLUMB & NOT LESS THAN SIX (6) INCHES FROM CORNERS: HORIZONTAL SEAMS SHALL NOT BE PERMITTED UNDER ANY CIRCUMSTANCES.
- 4. REMOVE EXCESS ADHESIVE PROMPTLY, REPLACE PANELS WHICH CANNOT BE COMPLETELY CLEANED.
- 5. INSTALLATION OF PATTERNED FABRIC WALL COVERINGS SHALL BE MATCH AT EDGE TO ADJACENT FABRIC PANEL.
- REMOVE SWITCH PLATES & SURFACE MOUNTED FIXTURES TO PERMIT WALL COVERING INSTALLATION & RE-INSTALL UPON COMPLETION.
- WALL COVERINGS SHALL BE FROM CONSISTENT DYE LOTS.
- NO SUBSTITUTION OF ANY SPECIFIED WALL COVERINGS OR FINISH MAY BE MADE WITHOUT PRIOR APPROVAL OF ARCHITECT

TILE:

- INSTALL TILE IN ACCORDANCE W/ TILE COUNCIL OF AMERICA HANDBOOK FOR CERAMIC TILE INSTALLATION METHODS.
- 2. CONTRACTOR IS RESPONSIBLE FOR PROVIDING APPROPRIATE SUBSTRATE (I.E. MOISTURE RESISTANT GYPSUM BOARD, "WONDERBOARD", ETC.).

TELEPHONE/DATA/ELECTRICAL NOTES:

- WORK SHALL BE IN ACCORDANCE W/ APPLICABLE NATIONAL, STATE AND LOCAL ELECTRICAL CODES.
- 2. IN M/E/P DESIGN-BUILD PROJECTS, MECHANICAL & ELECTRICAL ENGINEERING DRAWINGS SHALL BE SUBMITTED TO ARCHITECT FOR REVIEW & APPROVAL PRIOR TO START OF CONSTRUCTION. CONTRACTOR SHALL HAVE SOLE RESPONSIBILITY FOR COORDINATING VARIOUS TRADES. CONTRACTOR SHALL CONTROL INSTALL-ATION SEQUENCE OF VARIOUS ITEMS TO ACCOMMODATE DIMENSIONAL REQUIRE-MENTS OF TOTAL ASSEMBLY INCLUDING MECHANICAL, ELECTRICAL, PLUMBING, FIRE ALARM, DATA, TELEPHONE, SPRINKLER PIPING AND ANY & ALL EQUIPMENT.
- 3. ANY DISCREPANCY BETWEEN THE ARCHITECTURAL, MECHANICAL, ELECTRICAL \$ PLUMBING ENGINEER'S OR ANY OTHER CONSULTANT'S DRAWINGS SHALL BE BROUGHT TO THE ATTENTION OF THE ARCHITECT FOR CLARIFICATION. WORK INSTALLED IN CONFLICT W/ THE ARCHITECT'S DRAWINGS OR CREATING CONFLICTS DUE TO INSUFFICIENT COORDINATION OF WORK SHALL BE CORRECTED BY THE CONTRACTOR @ THE CONTRACTOR'S EXPENSE & SHALL NOT IMPACT THE SCHEDULE
- REFER TO ENGINEERING DRAWINGS FOR CIRCUITING & SPECIFICATIONS. MECHANICAL 4 ELECTRICAL ENGINEER'S DRAWINGS DO NOT SPECIFY LOCATIONS OF FIXTURES, OUTLETS, OR EQUIPMENT - REFER TO ARCHITECT'S DRAWINGS.
- 5. SEPARATE JUNCTION BOXES BY AT LEAST ONE (1) STUD WHERE TELEPHONE \$ ELECTRICAL OUTLETS APPEAR BACK-TO-BACK OR SIDE-BY-SIDE.
- 6. OUTLETS, SWITCHES & JUNCTION BOXES LOCATED IN ACOUSTICAL PARTITIONS SHALL RECEIVE EQUIVALENT INSULATION BEHIND BOXES.
- 7. WHERE WALL MOUNTED OIUTLETS ARE INDICATED SIDE-BY-SIDE, THE MAXIMUM

SEPARATION SHALL BE SIX (6) INCHES, CENTERLINE TO CENTERLINE, U.O.N.,

- 8. GANG ELECTRICAL OUTLETS & SWITCHES WHERE POSSIBLE.
- WALL MOUNTED ELECTRICAL TELEPHONE & DATA OUTLETS SHALL BE INSTALLED AT EIGHTEEN (18) INCHES ABOVE FINISHED FLOORS, UNLESS NOTED OTHERWISE.
- 10. INSTALL LIGHT SWITCHES AT FOURTY-EIGHT (48) INCHES A.F.F. & WITHIN EIGHT (8) INCH OF DOOR FRAME, U.N.O.. FOLLOW ADA REGULATIONS IN PUBLIC CIRCUMSTANCES.
- 11. THERMOSTATS SHALL BE INSTALLED AT SIXTY (60) INCHES A.F.F. ADJACENT TO LIGHT SWITCHES, UNLESS NOTED OTHERWISE.
- 12. INCANDESCENT LIGHT FIXTURES ARE TO BE ON DIMMERS, UN.O.,
- 13. WHERE LIGHTS & SWITCHES ARE NOT NOTED W/ A LOWER CASE LETTER DESIGNATION, THE SWITCHES ARE TO BE CONNECTED ONLY TO THOSE LIGHT FIXTURES WITHIN THAT SPECIFIC ROOM.
- 14. FLOOR MOUNTED OUTLETS ARE DIMENSIONED FROM THE CENTERLINE OF THE OUTLET TO THE FINISHED FACE OF THE PARTITION AND/OR COLUMN, UNLESS NOTED OTHERWISE.
- 15. ELECTRICAL ITEMS INDICATED IN OR ON CABINETRY SHALL BE SUPPLIED, INSTALLED & COORDINATED BY THE CONTRACTOR.
- 16. ELECTRICAL SUB-CONTRACTOR SHALL MAKE FINAL CONNECTIONS FOR ALL FLOOR OR WALL OUTLETS TO FURNITURE SYSTEM POWER POLES (WHERE APPLICABLE) FOLLOWING MANUFACTURER'S STANDARDS FOR INSTALLATION AND APPLICABLE
- 17. PHONE & DATA OUTLETS SHALL BE SINGLE OUTLET BOX W/ PULL STRING & RING FOR WIRING. WIRING OR CABLING SHALL BE BY OTHERS UNLESS NOTED OTHERWISE.
- 18. THE SIZE OF NEW TELEPHONE & DATA LINE CONDUITS SHALL BE AS PER
- 19. INSTALL BUILDING STANDARD COVER PLATES FOR OUTLETS & SWITCHES.

SUPPLIER'S SPECIFICATIONS. VERIFY REQUIREMENTS W/ OWNER.


- 20. EXHAUST FANS SHALL BE SILENT RUNNING & SHALL HAVE A MINIMUM EIGHT (8) FOOT LONG DUCT BETWEEN THE RETURN AIR GRILLE & FAN MOTOR. DUCT SHALL BE LINED W/ ONE (1) INCH MIN. THICK FIBERGLASS LINER. DO NOT LOCATE FAN MOTOR ABOVE CEILING OF ROOM SERVED BY FAN - LOCATE MOTOR ABOVE CORRIDOR OR OPEN AREA CEILING. PROVIDE SPARK PROOF MOTORS OR EXPLOSION PROOF MOTORS FOR LOCATIONS INVOLVING FLAMABLE MATERIALS (ONLY IF APPLICABLE)
- 21. ACCESS PANELS AS REQUIRED SHALL BE INSTALLED FLUSH W/ CEILING & FINISHED TO MATCH THE ADJACENT CEING FINISH. LOCATIONS OF ACCESS PANELS ARE TO BE REVIEWED WITH THE ARCHITECT PRIOR TO INSTALLATION.


C COPE ARCHITECTS, INC., 2020 S DOCUMENT IS THE EXCLUSIVE PROPERTY OF COPE ARCHITECTS, INC. AND SHALL NOT BE REPRODUCED WITHOUT THE AUTHORIZED WRITTEN CONSENT OF COPE ARCHITECTS, INC.

4 0

RW COPE Project No. 2018.35MARINO CAD File No.

SPEC SHEET MARCH 02, 2020 Drawing No.

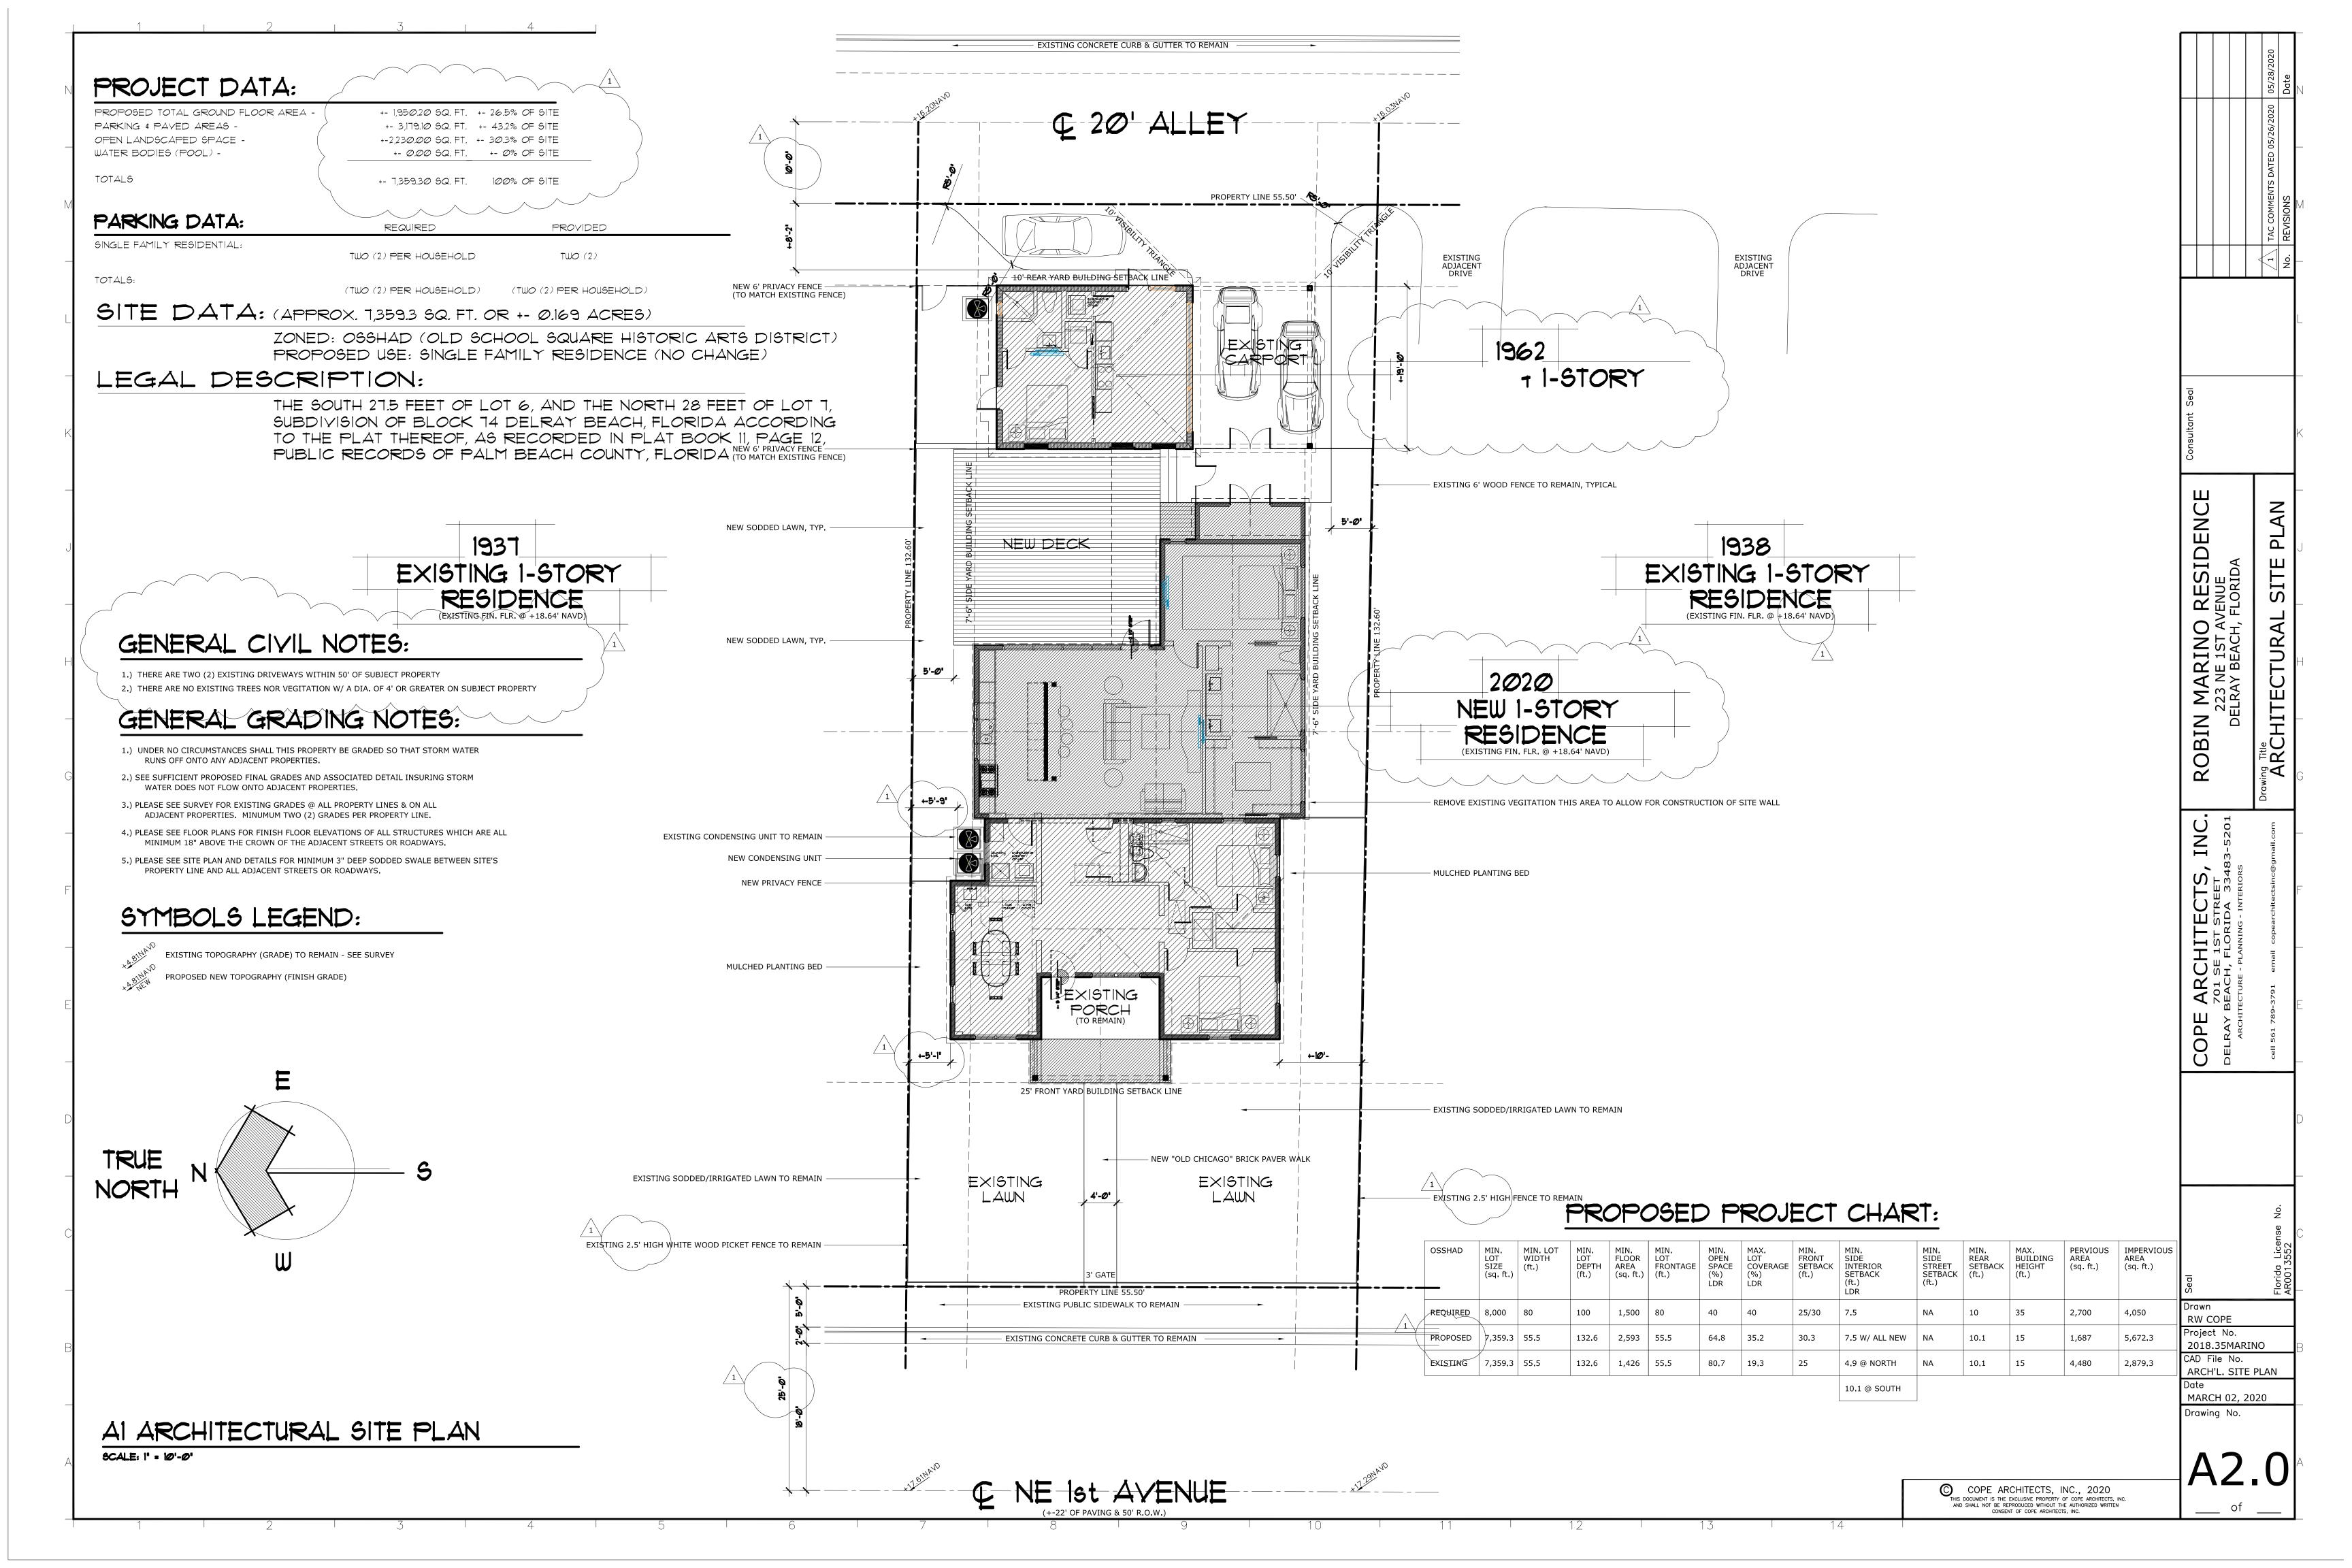

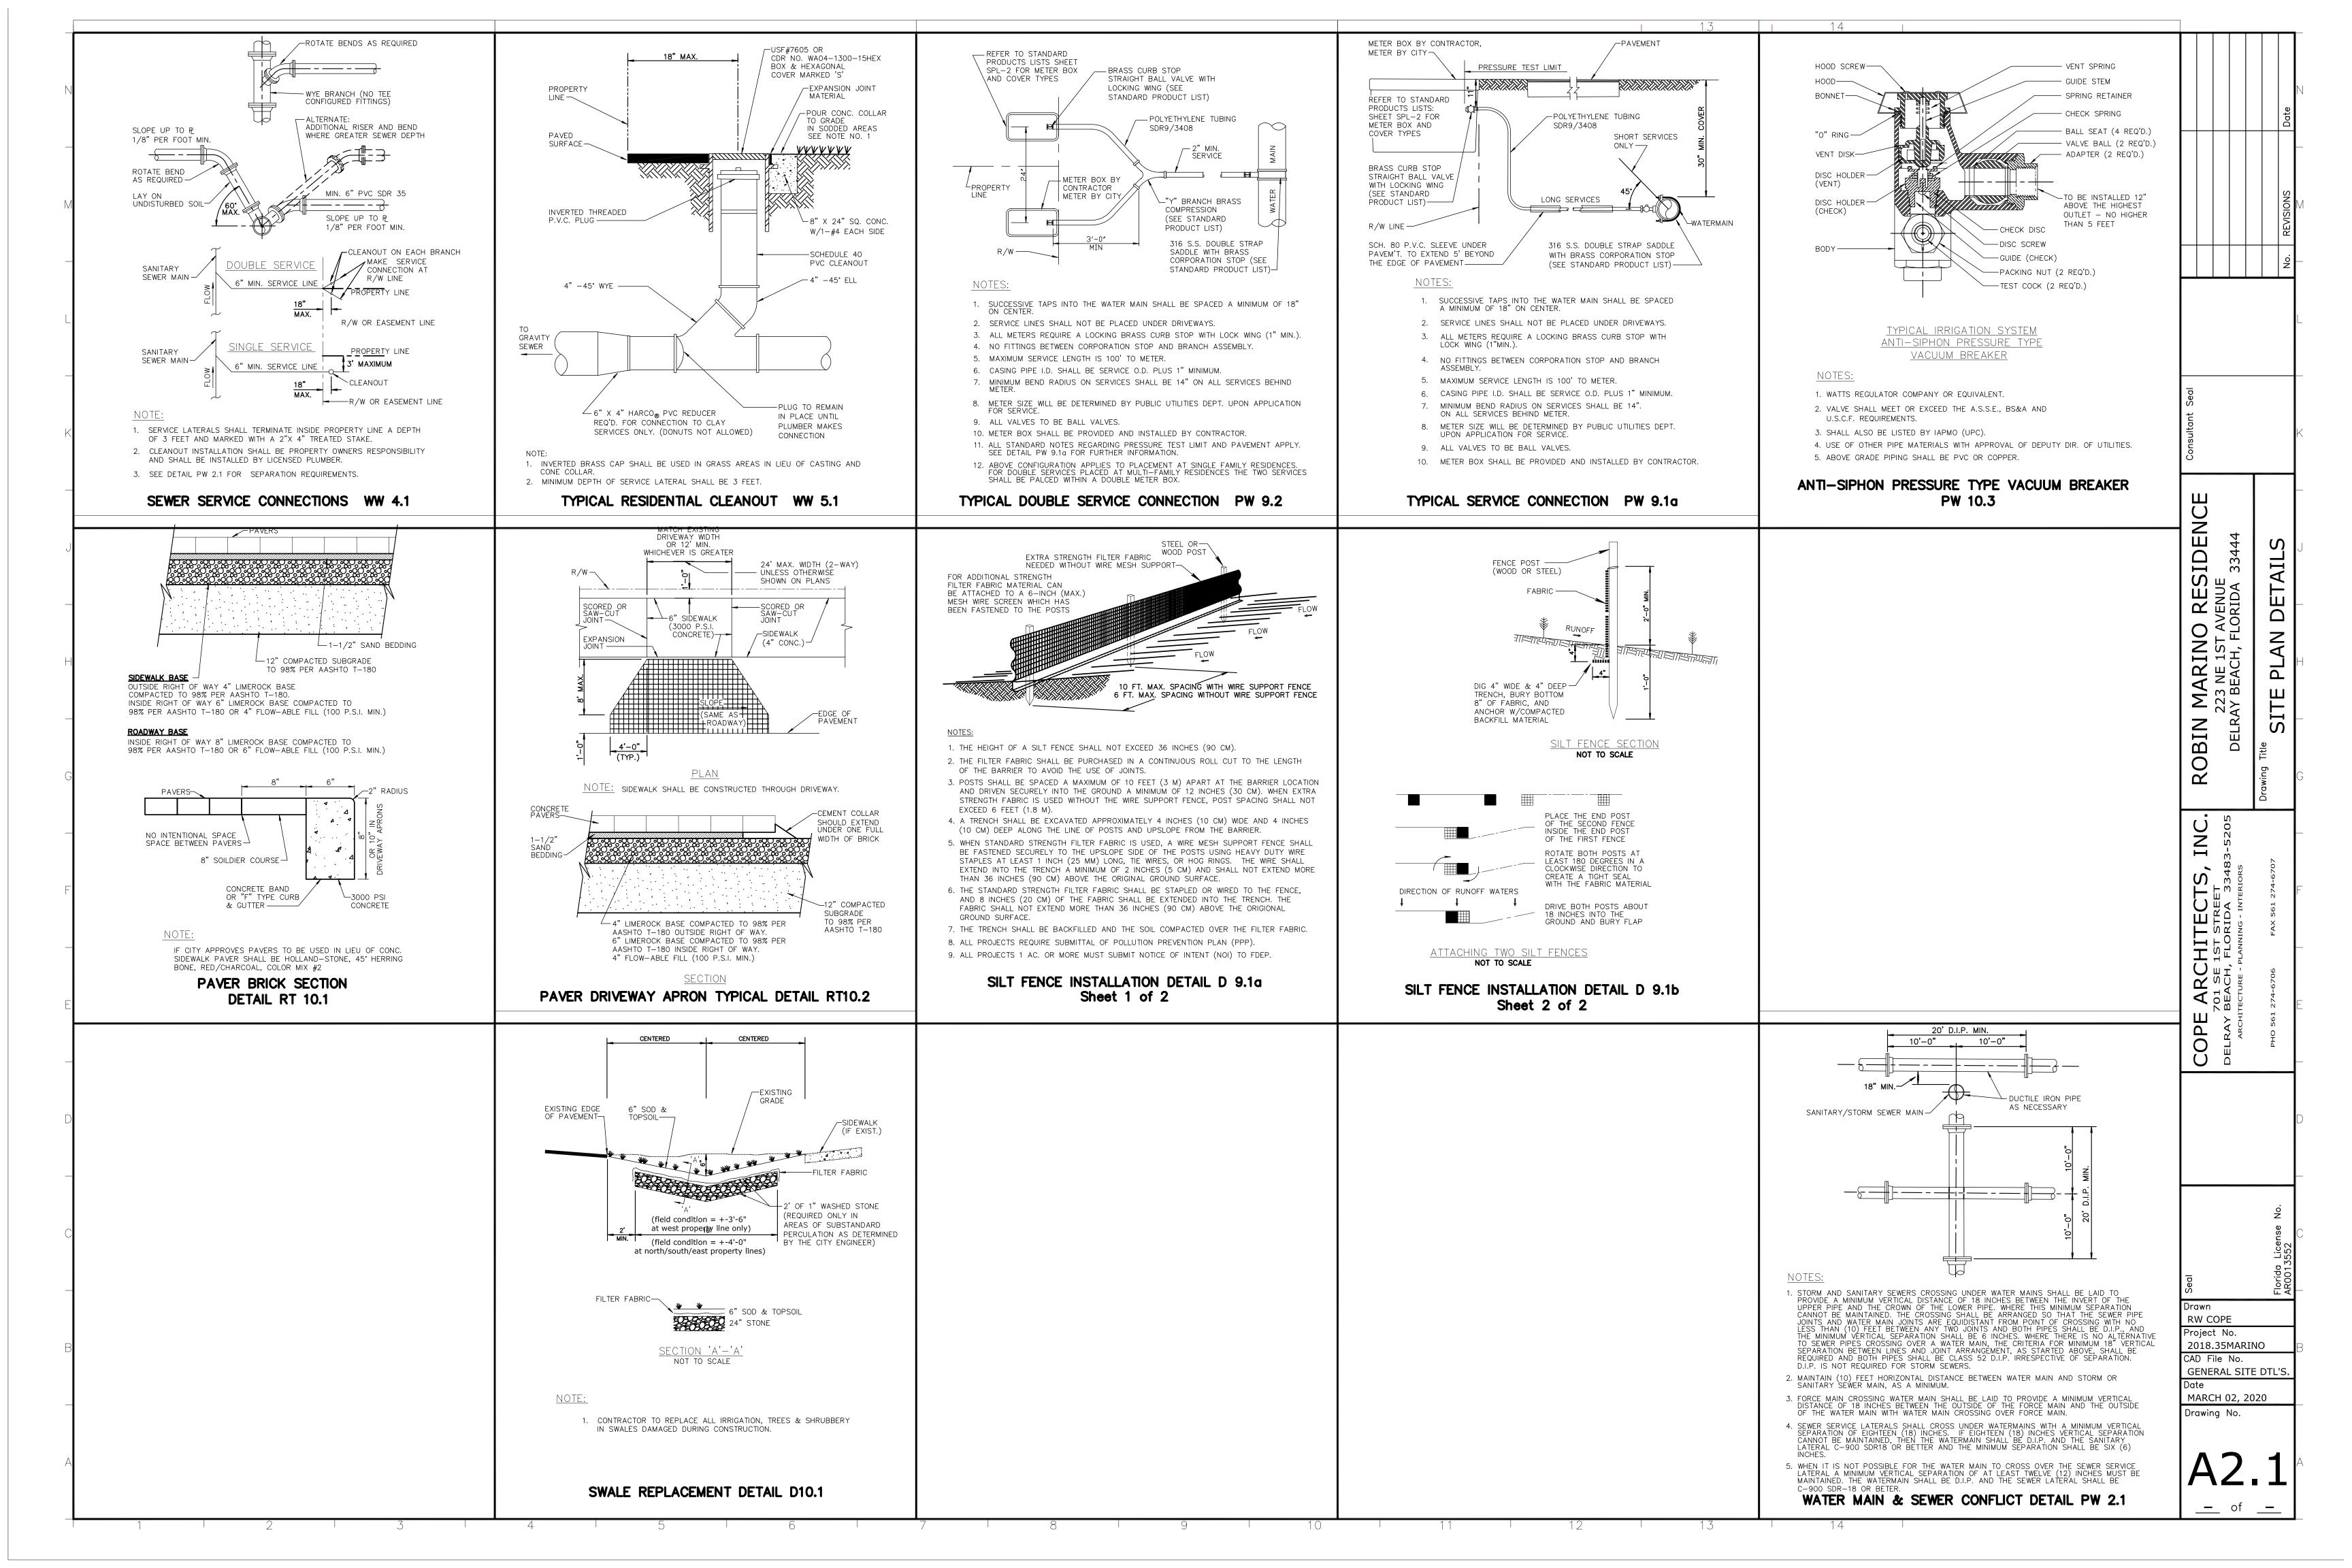



100 NEW INTERIOR DOOR TYPE, SEE SCHEDULE


WALL LEGEND:

---- NEW SOLID P.T. WOOD BLOCKING FOR ATTACHMENT OF MISC. ITEMS

EXISTING EXTERIOR WALL TO REMAIN

EXISTING INTERIOR FULL HEIGHT NON-LOAD BEARING PARTITION TO REMAIN

NEW INTERIOR FULL HEIGHT NON-LOAD BEARING PARTITION TO MATCH EXISTING CONDITIONS (OPTIONAL: WITH SOUND ATTENUATING BATT INSULATION)

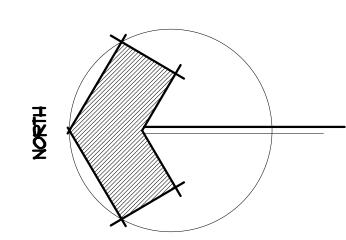

A5
PROPOSED ARCHITECTURAL
DMOE FLOOR PLAN: MAIN COTTAGE

EXIST'G-LAUNDRY


SCALE: 1/4" = 1'-0"


ROBIN MARINO RESIDENCE
223 NE 1ST AVENUE
DELRAY BEACH, FLORIDA **RW COPE** Project No. 2018.35MARINO **DEMO FLOOR PLAN**


© COPE ARCHITECTS, INC., 2020


THIS DOCUMENT IS THE EXCLUSIVE PROPERTY OF COPE ARCHITECTS, INC.
AND SHALL NOT BE REPRODUCED WITHOUT THE AUTHORIZED WRITTEN
CONSENT OF COPE ARCHITECTS, INC.


EXISTING TERRACE EXISTING DINING ROOM EXISTING KITCHEN WC EXIST'G BATHRM EXISTING GUEST BEDROOM 105 EXISTING LIVING ROOM ROD & SHELF ROD & SHELF CLO. 102 EXISTING FAMILY ROOM EXISTING MASTER BEDROOM EXISTING PORCH 25' FRONT YARD BUILDING SETBACK LINE

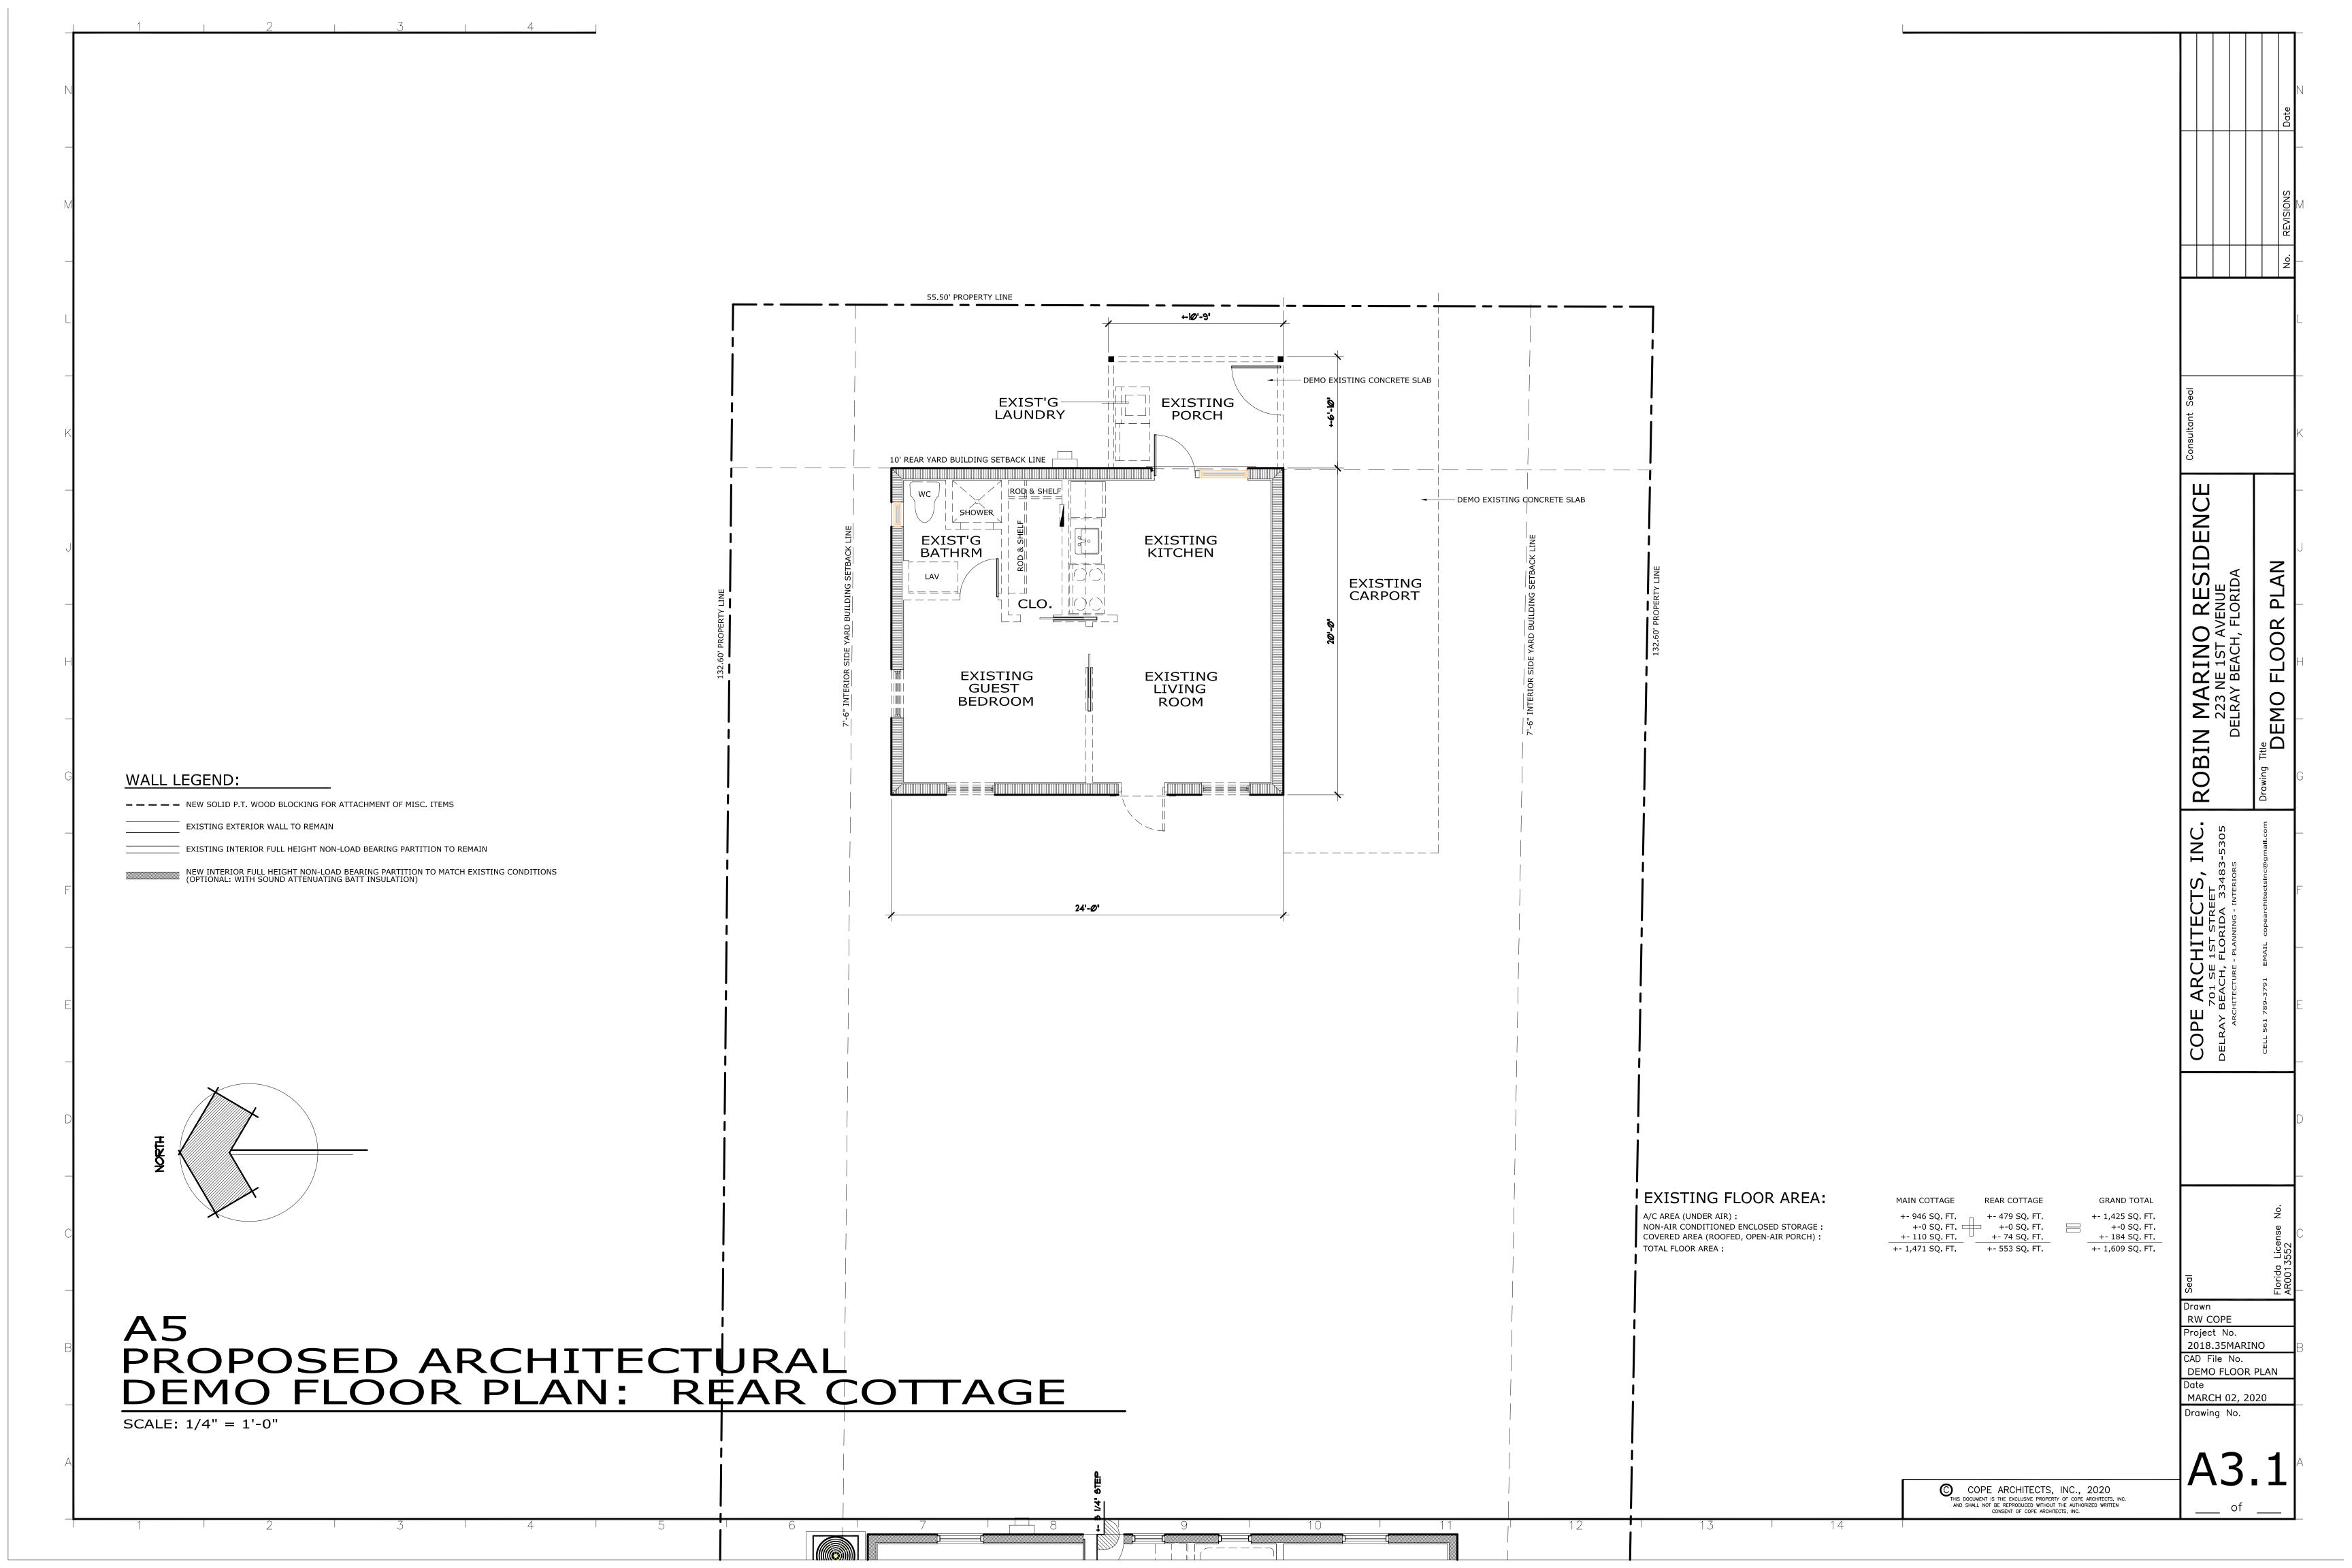


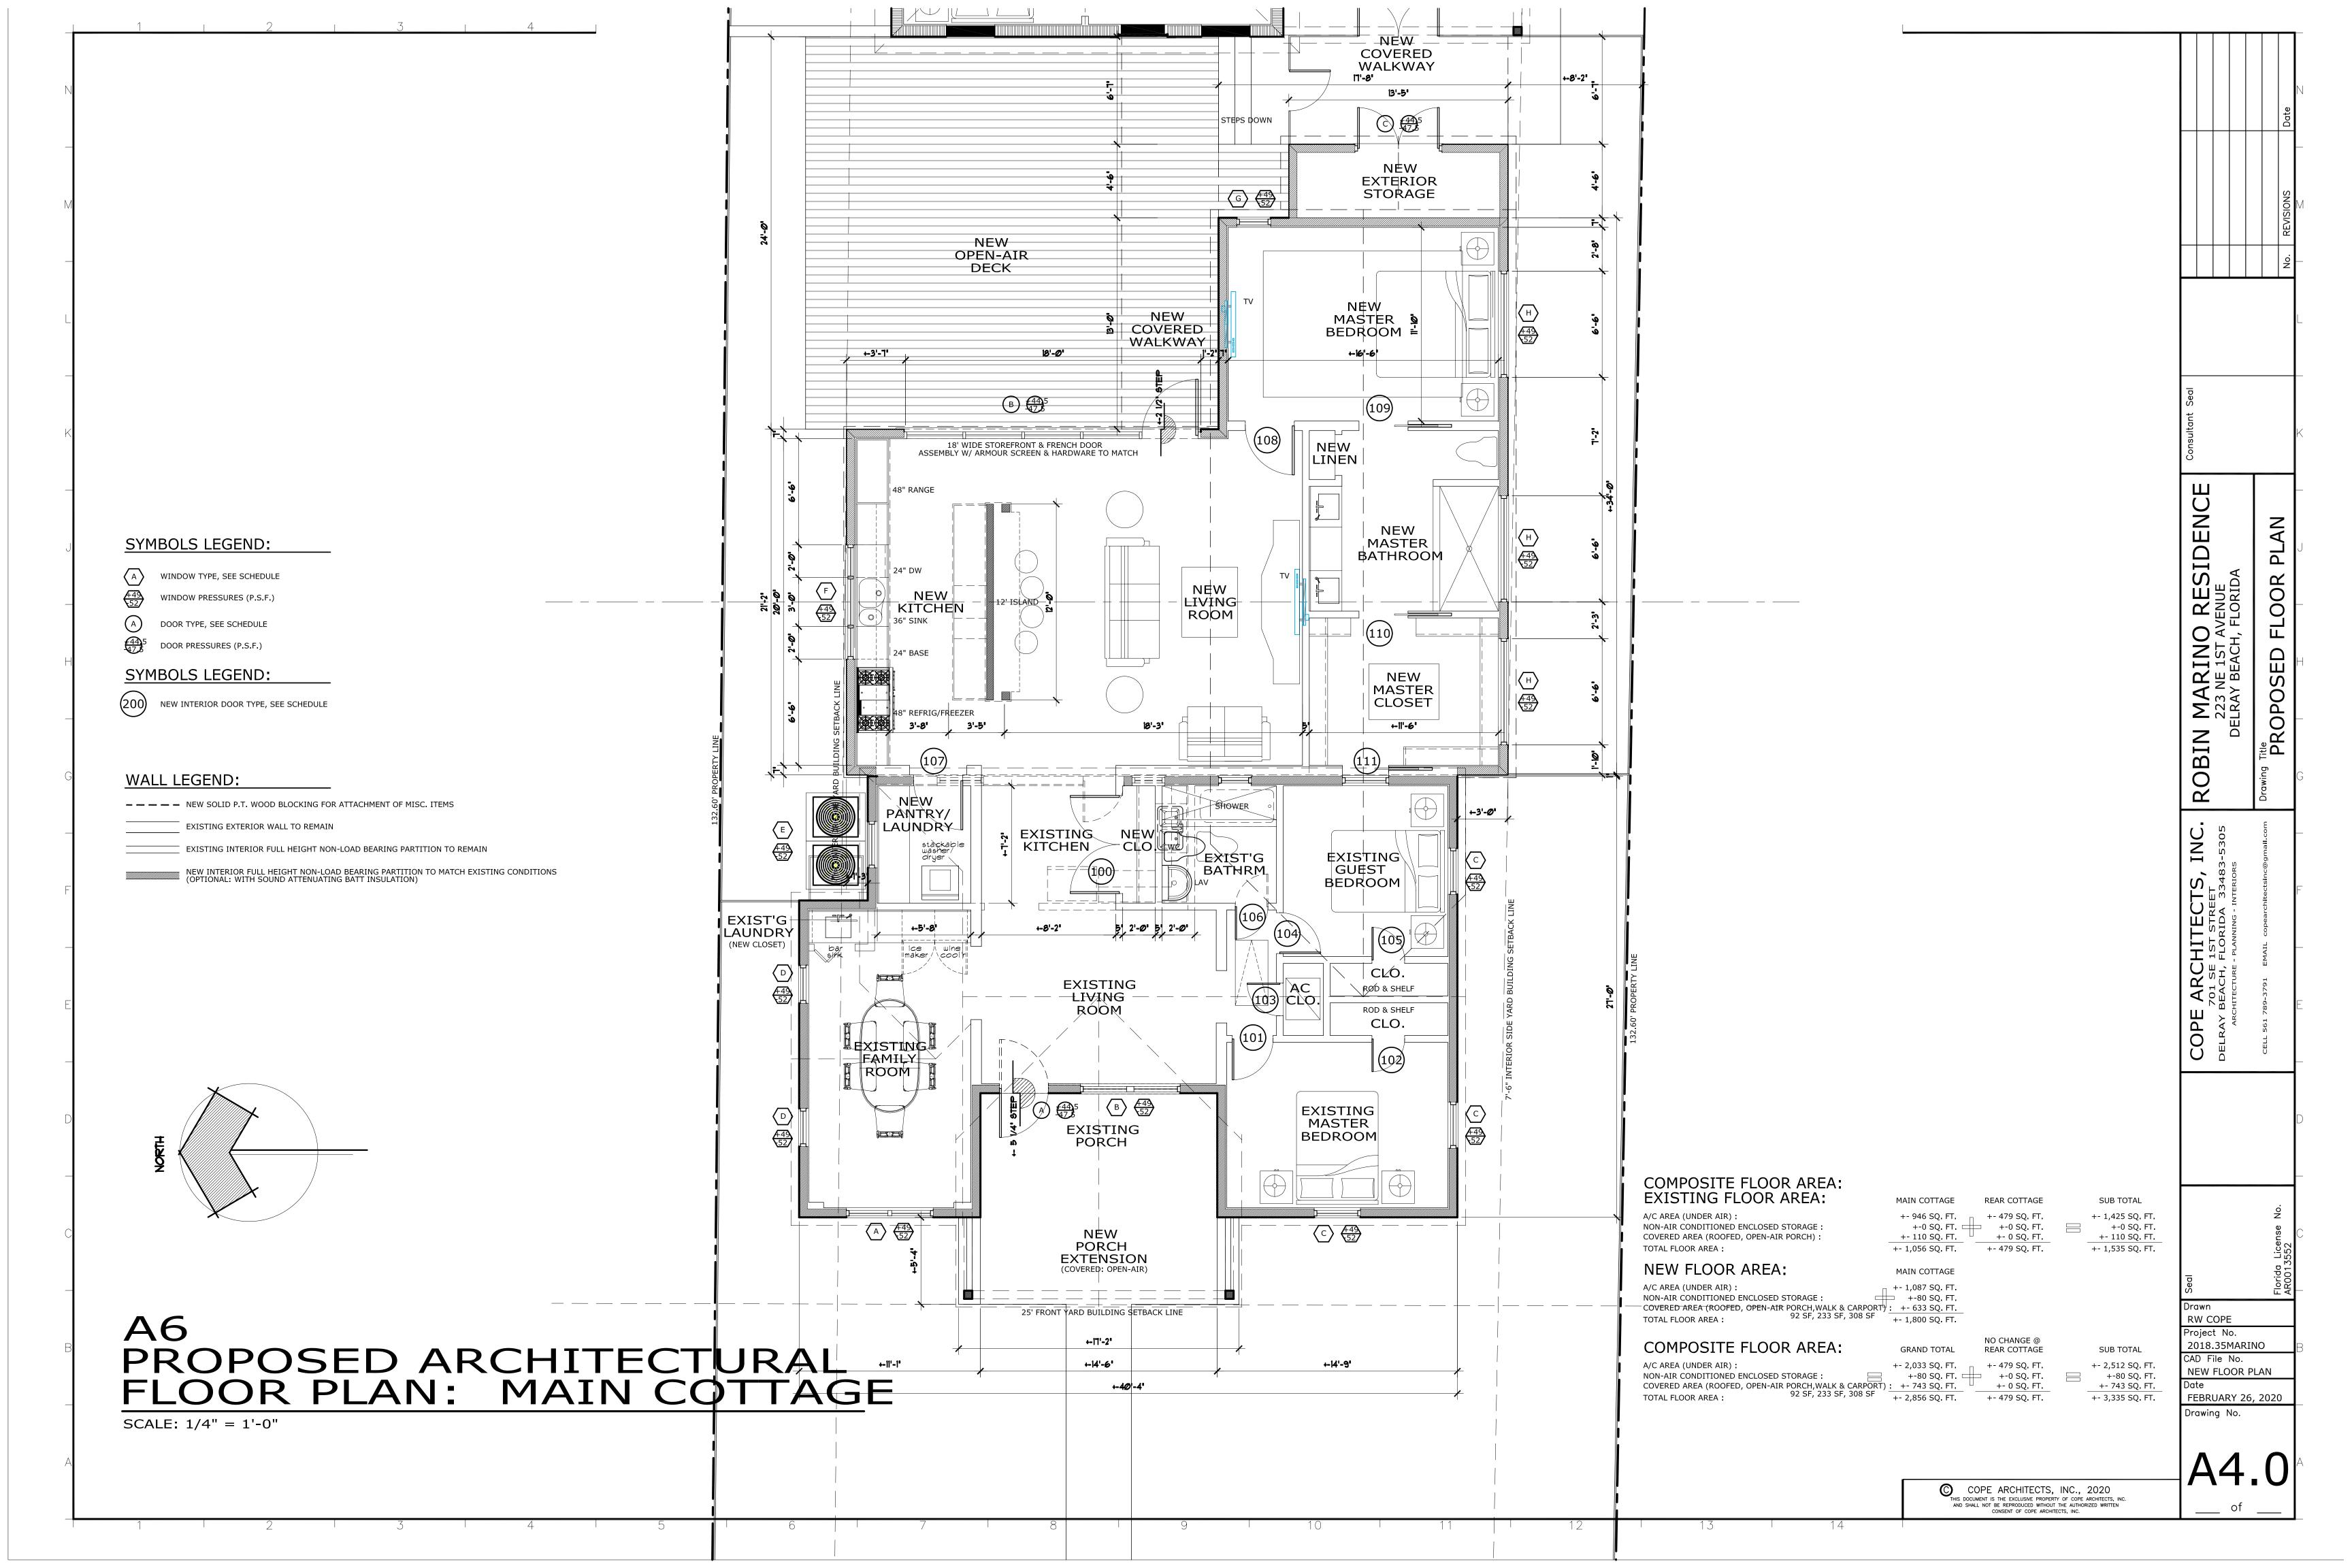

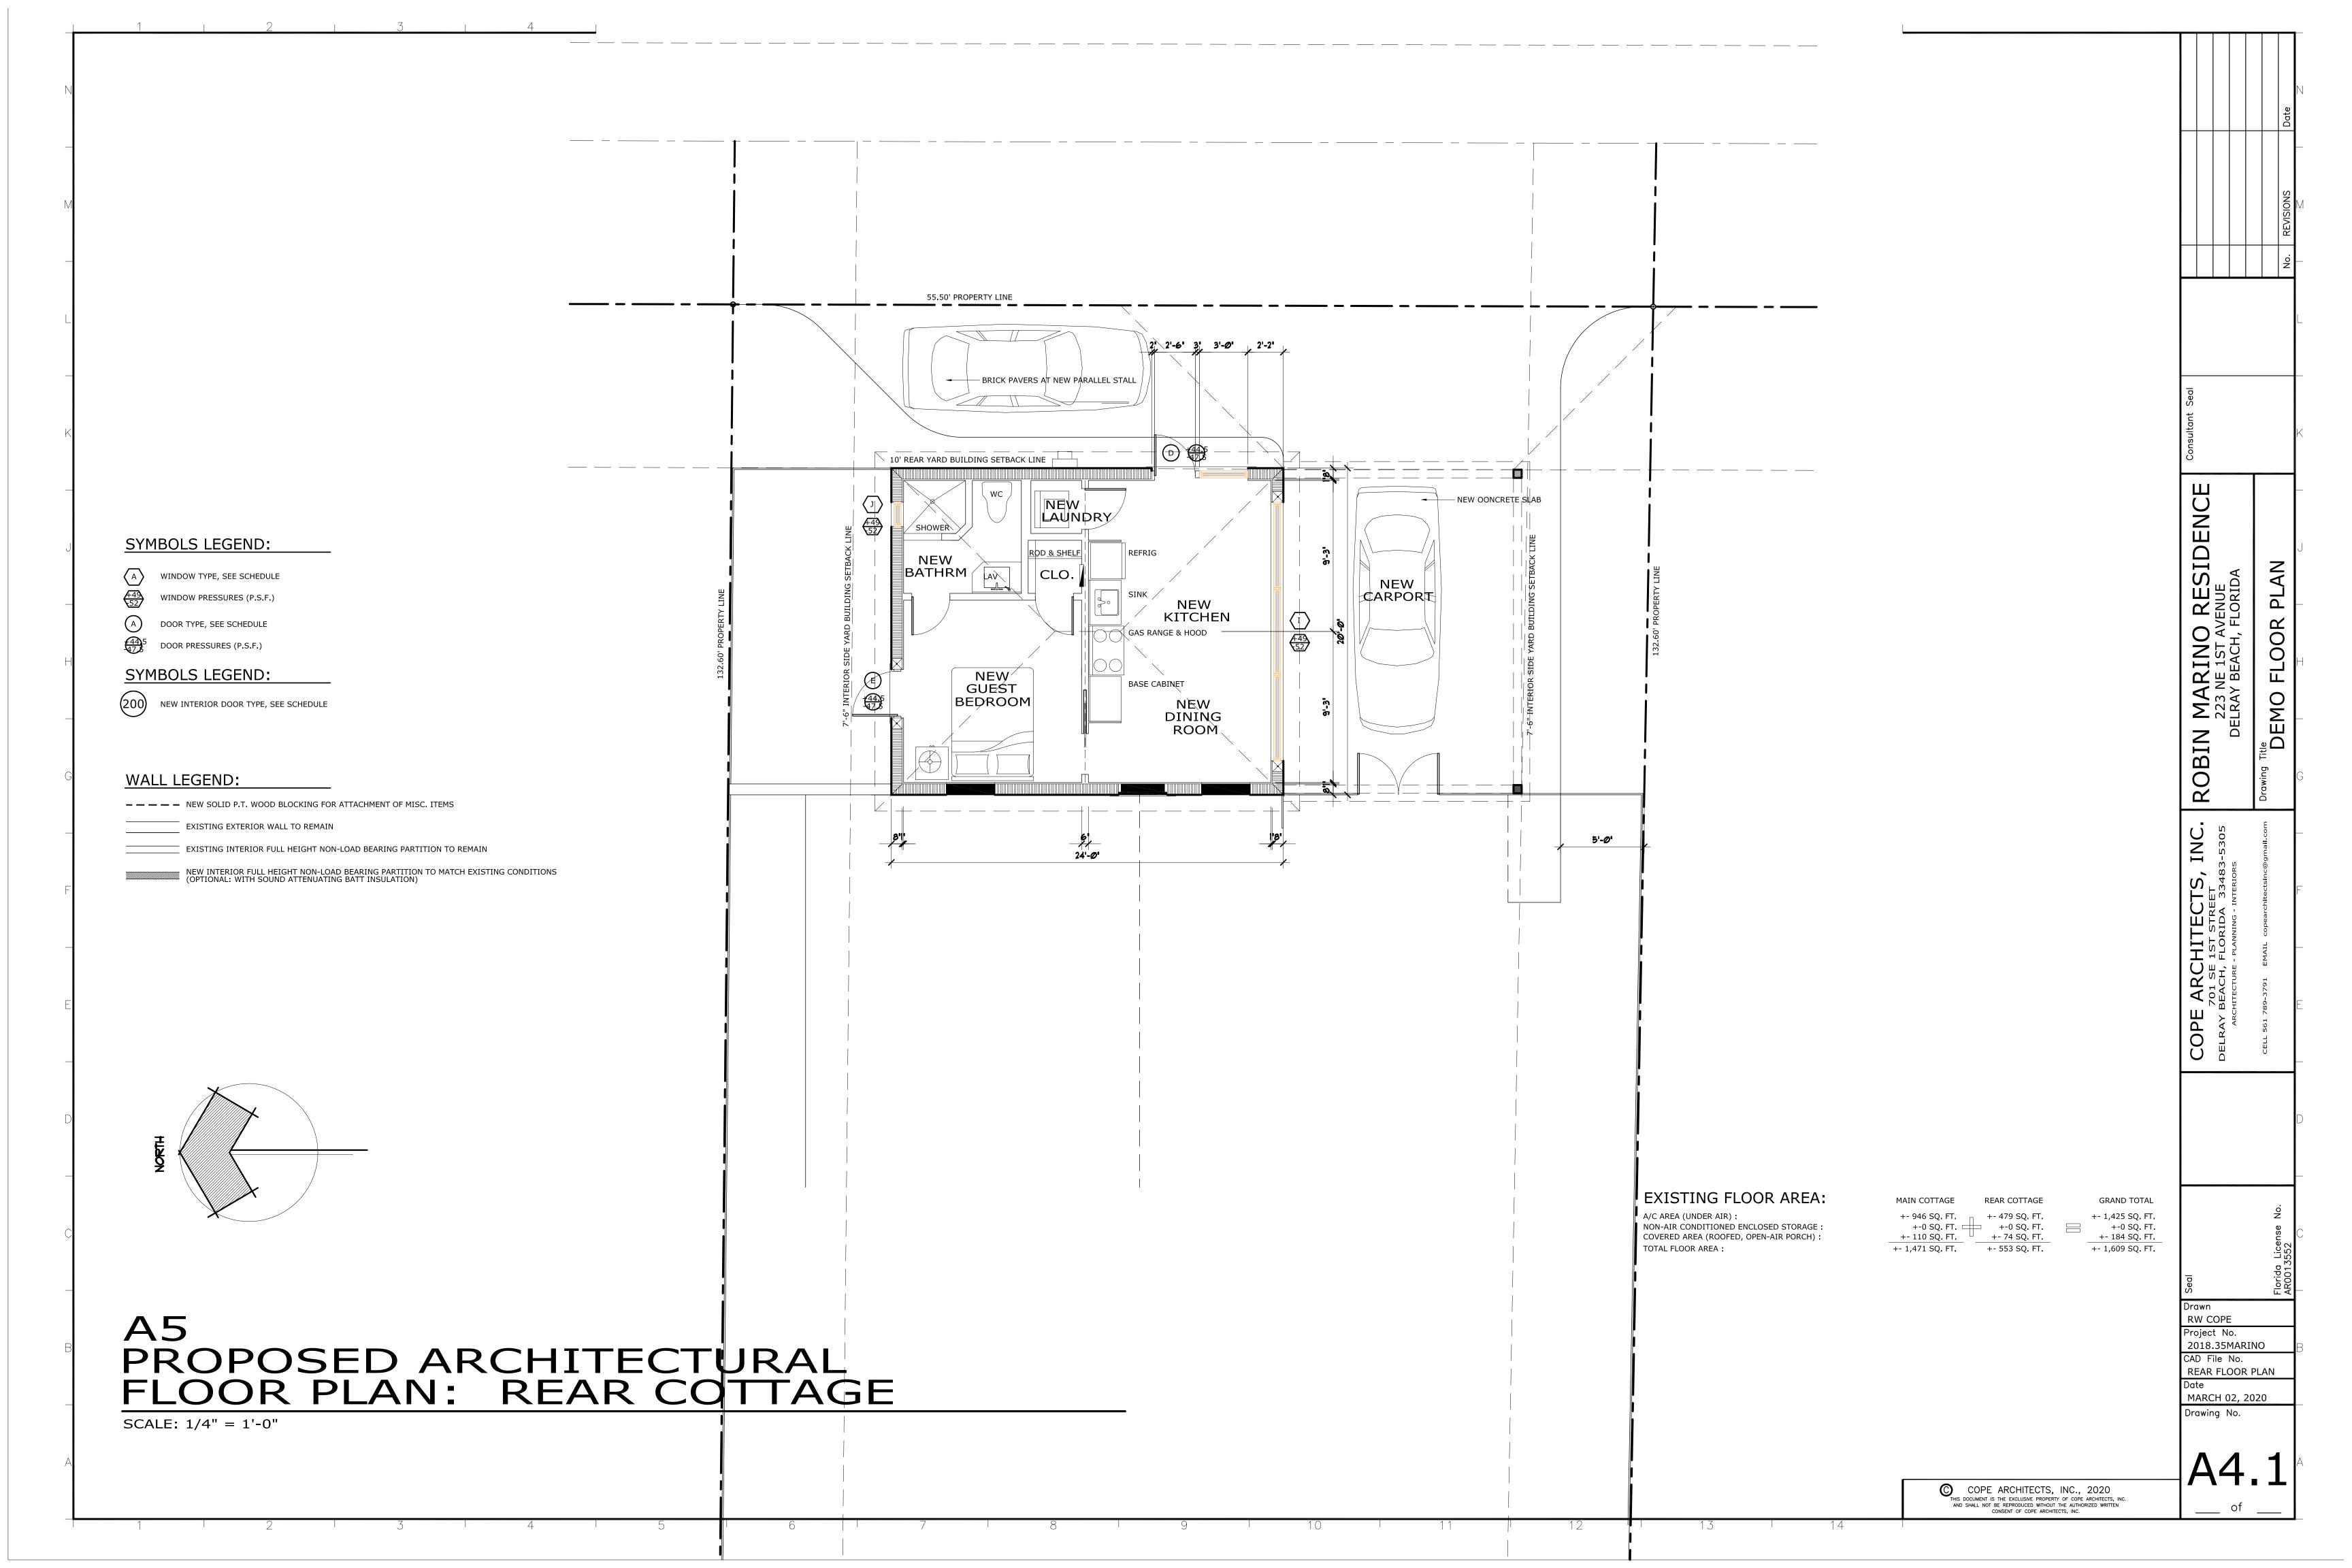

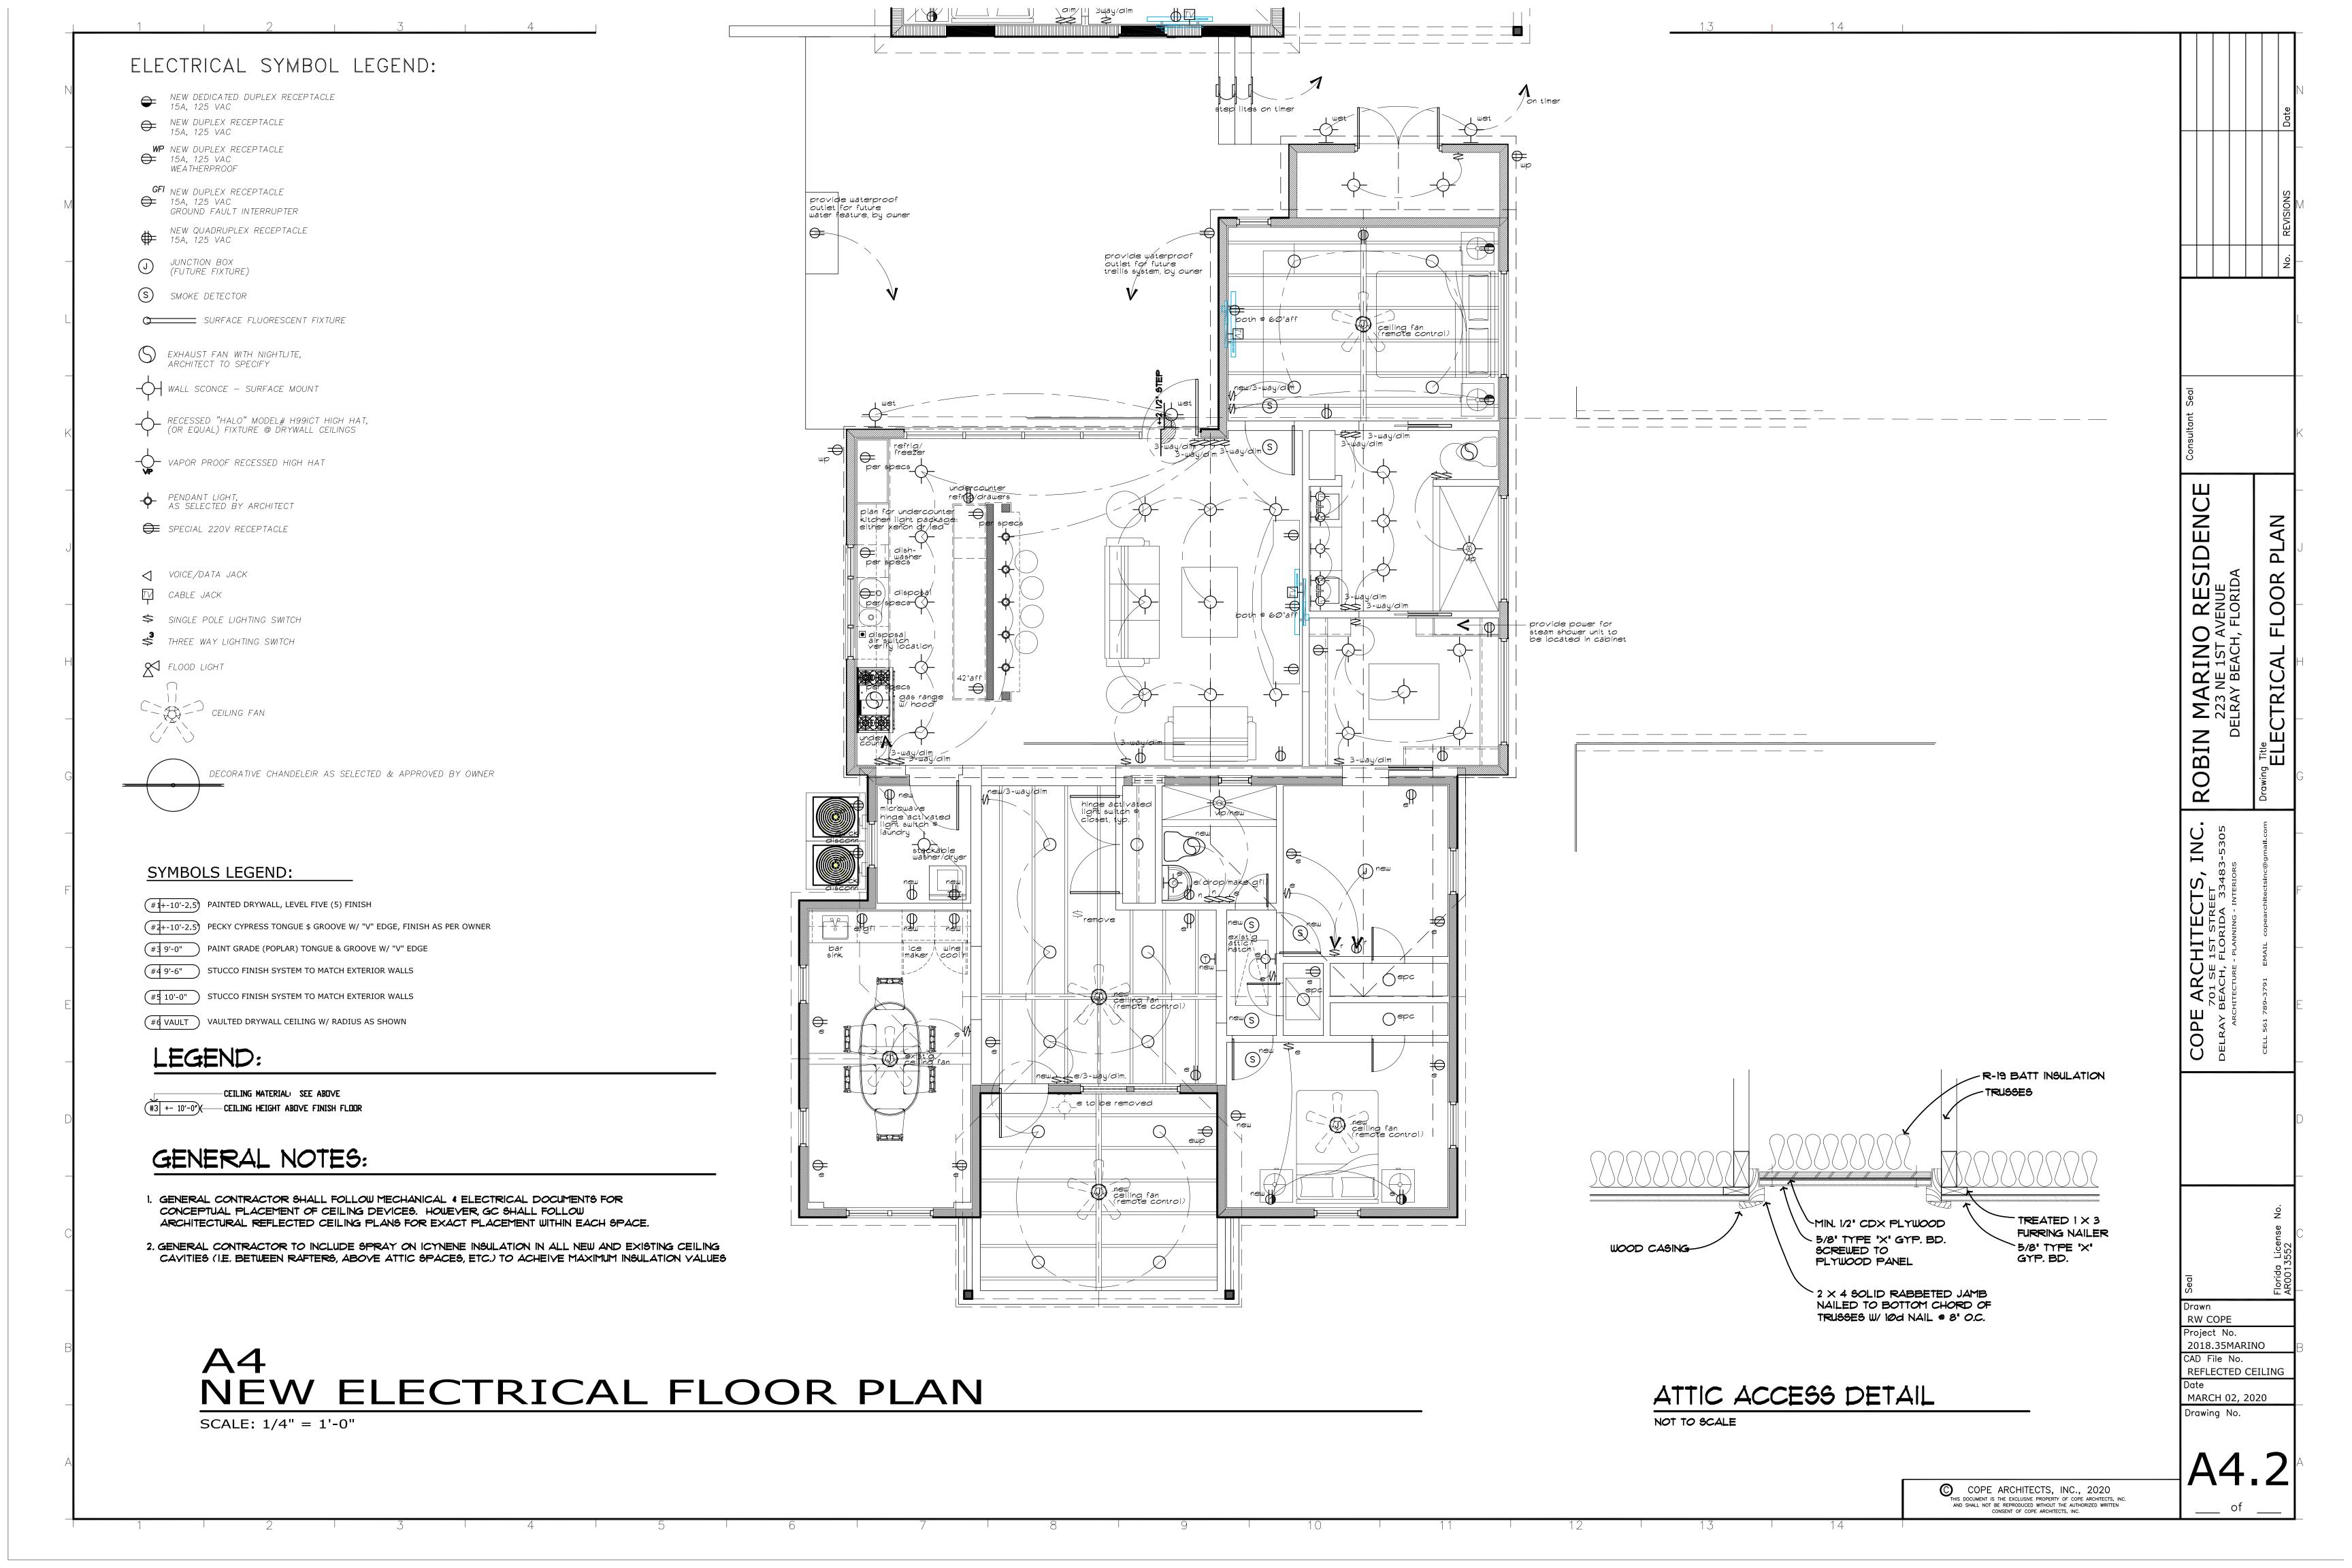

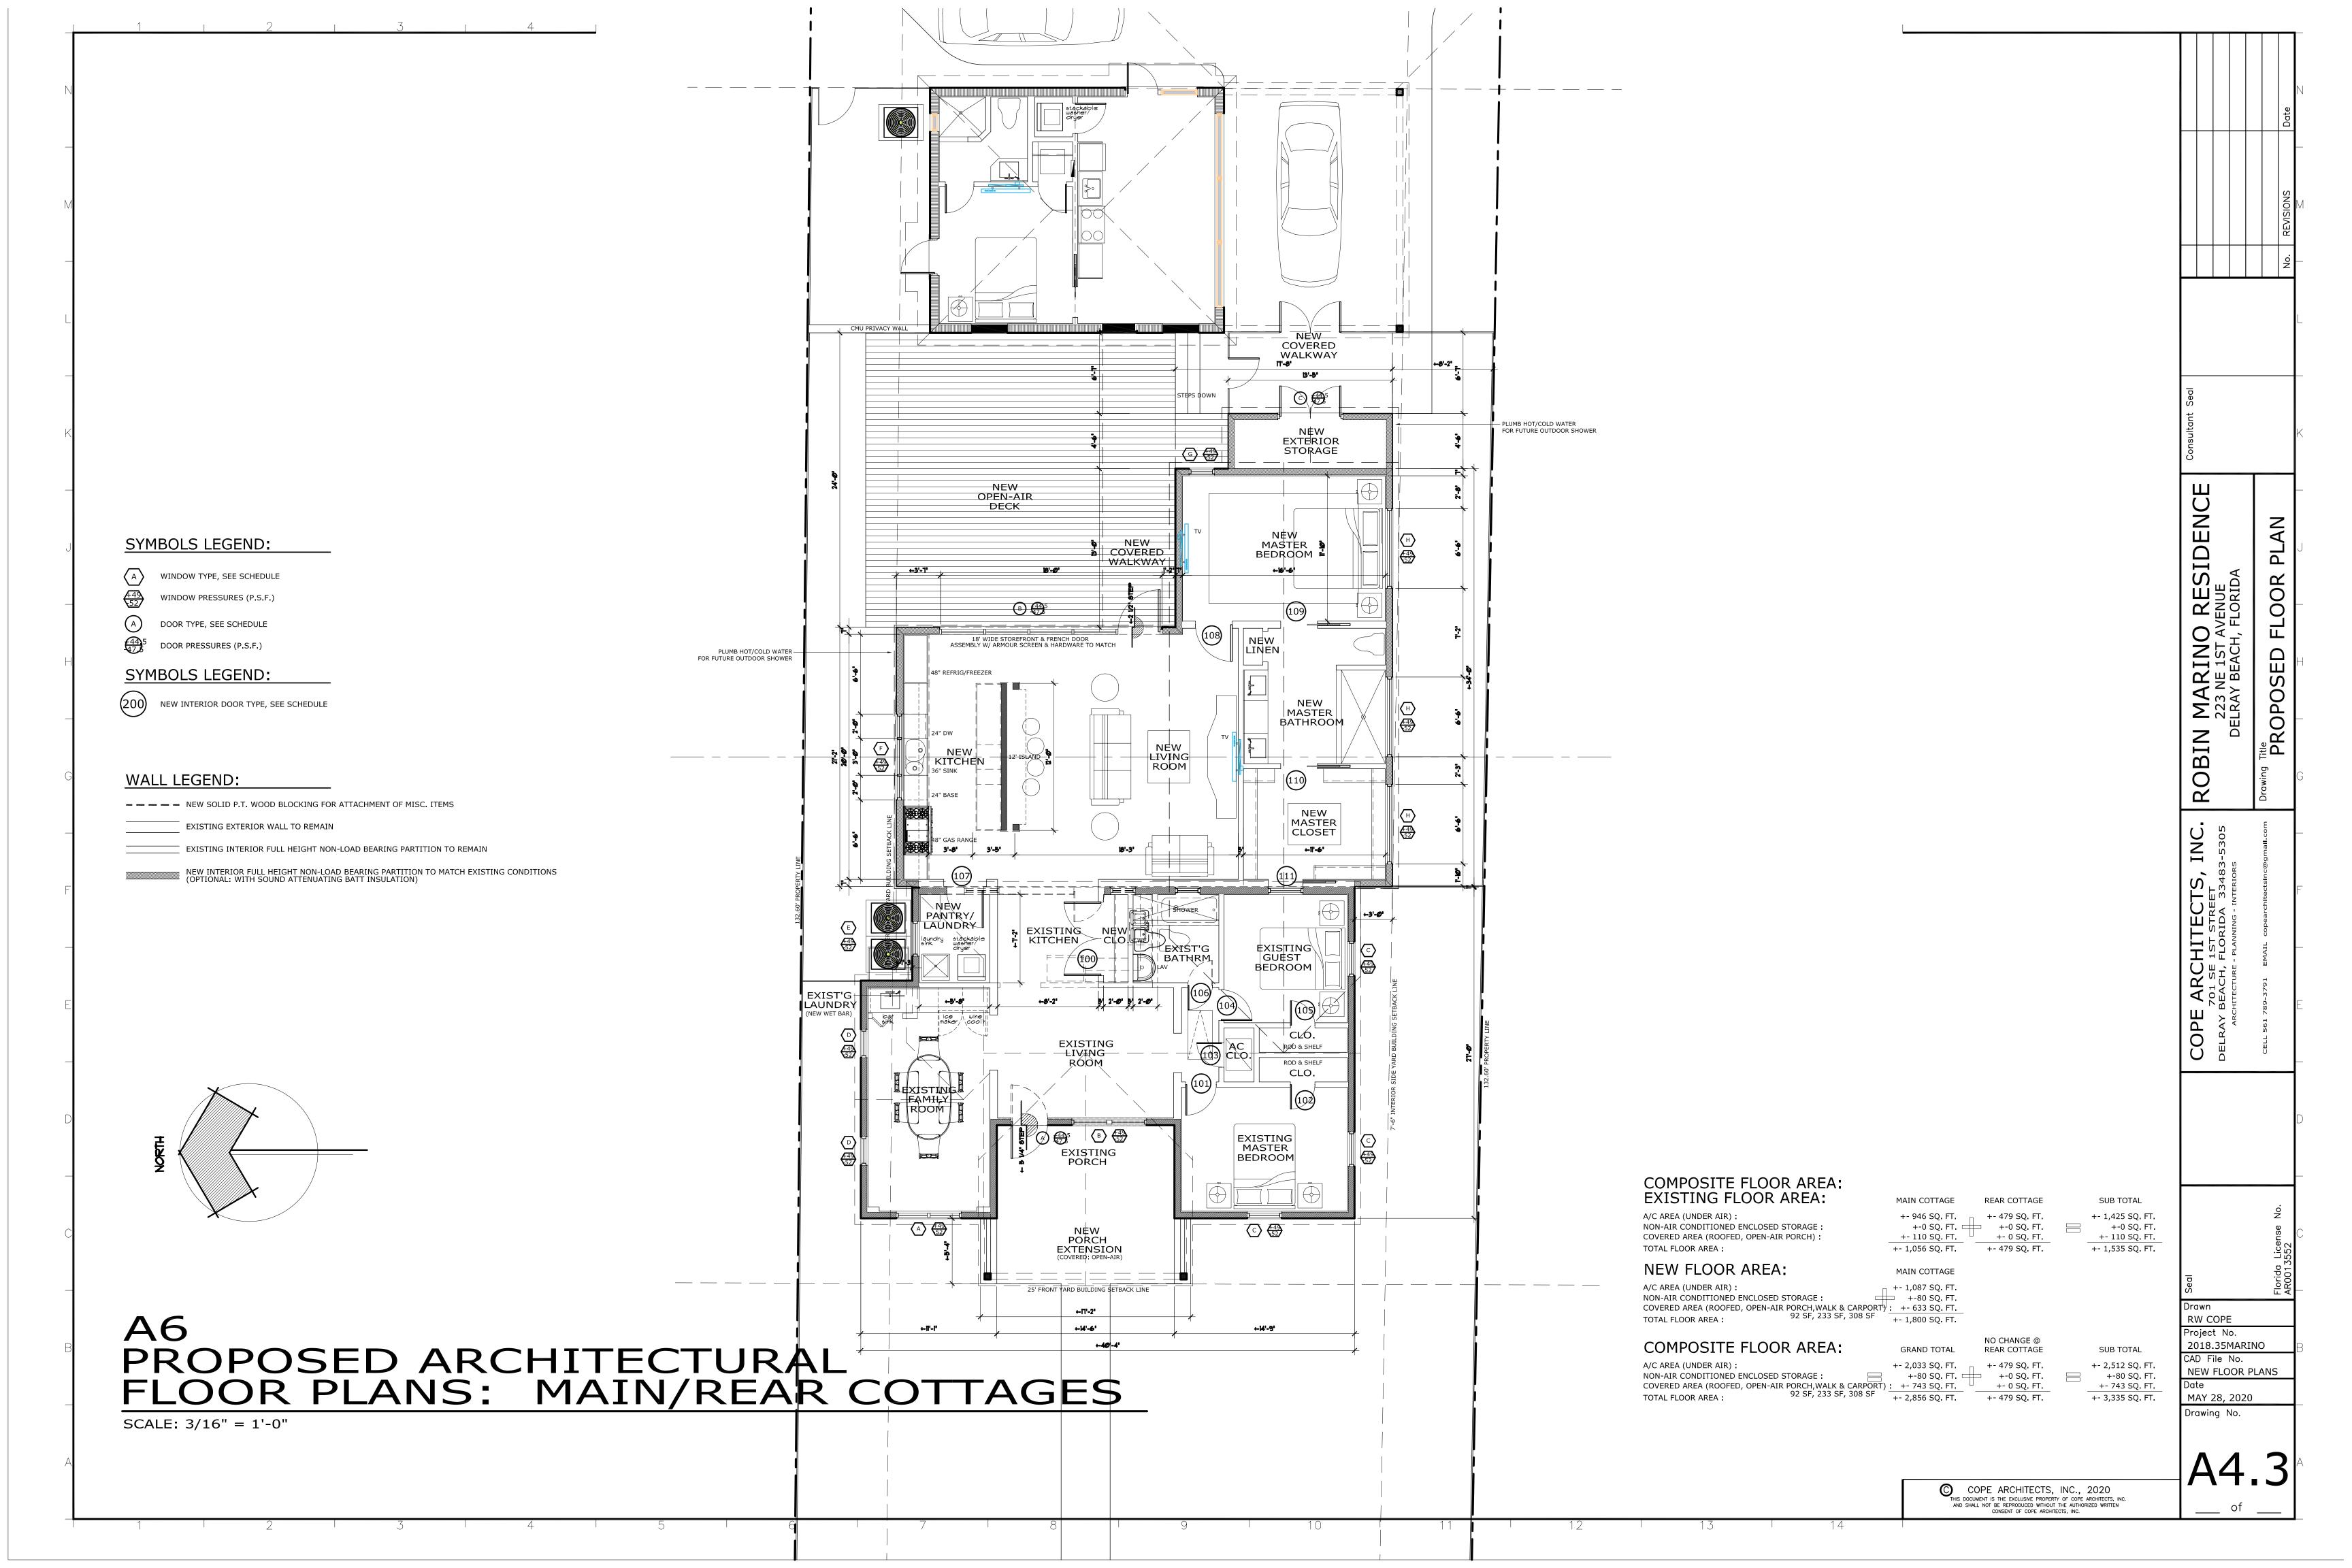

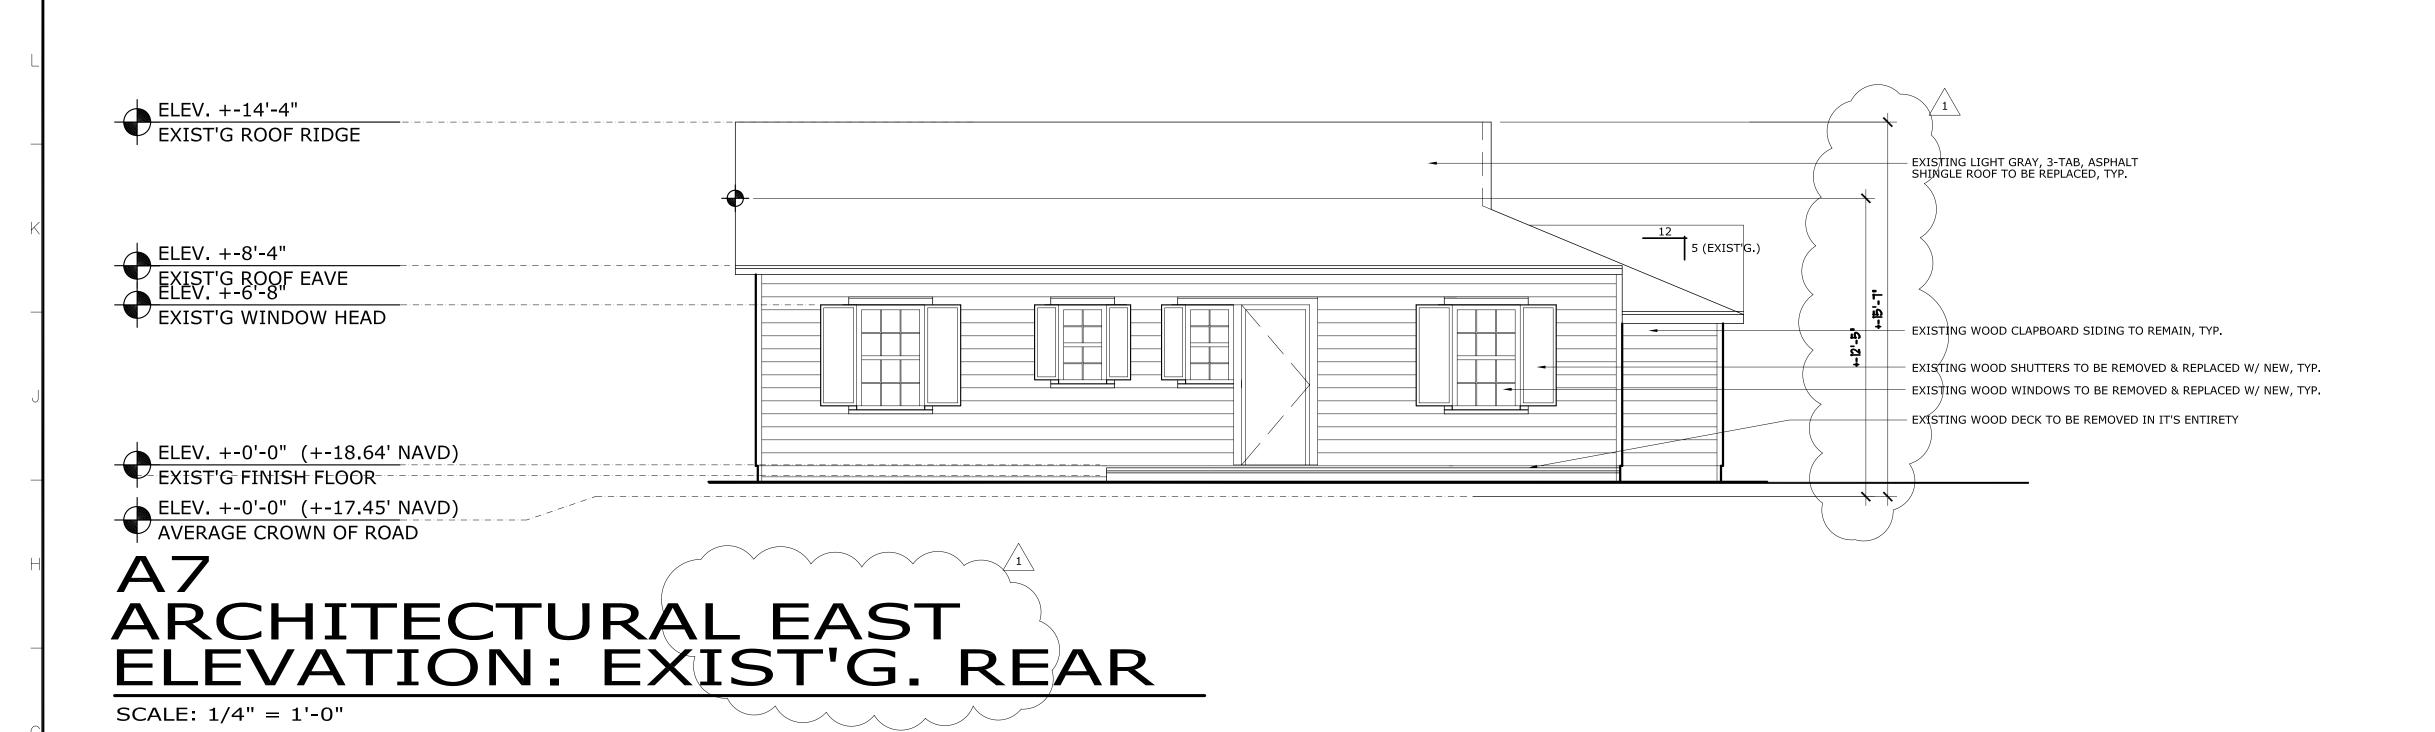



SCALE: 1/4" = 1'-0"

COPE ARCHITECTS, INC., 2020

THIS DOCUMENT IS THE EXCLUSIVE PROPERTY OF COPE ARCHITECTS, INC. AND SHALL NOT BE REPRODUCED WITHOUT THE AUTHORIZED WRITTEN CONSENT OF COPE ARCHITECTS, INC.

___A6.U


Drawing No.


RW COPE Project No.


2018.35MARINO

EXTERIOR ELEVN'S

ROBIN MARINO RESIDENCE
223 NE 1ST AVENUE
DELRAY BEACH, FLORIDA

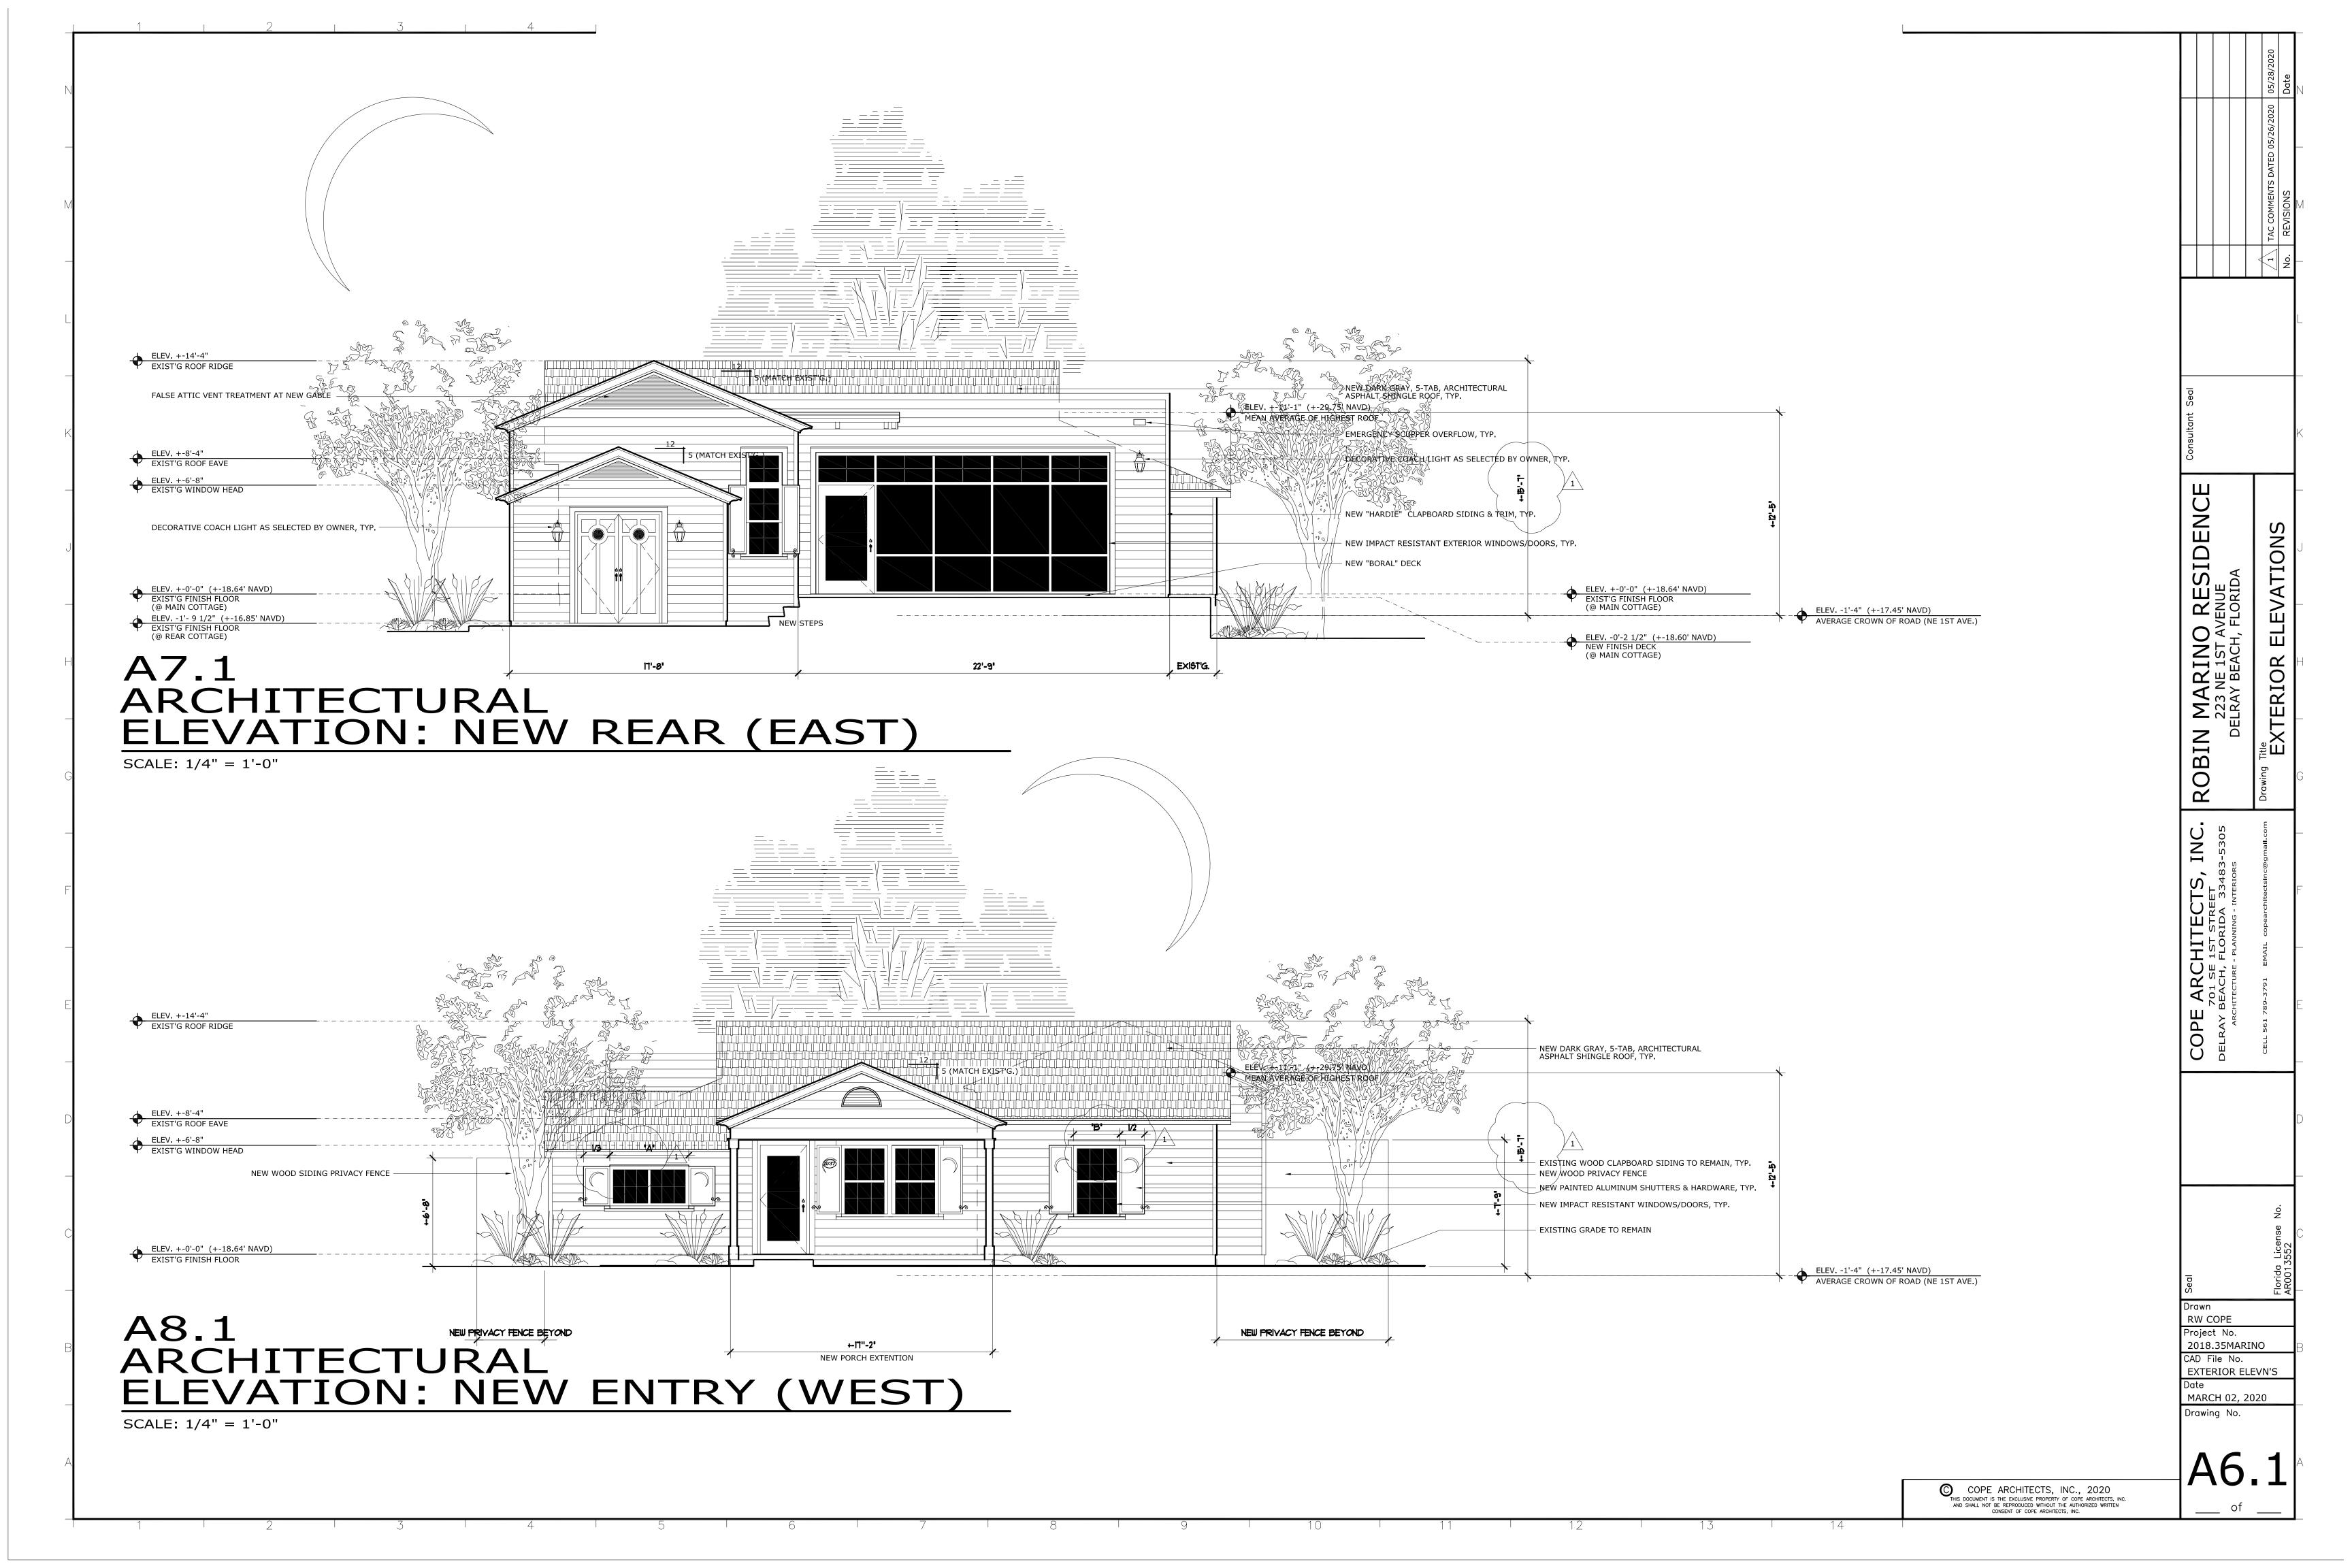

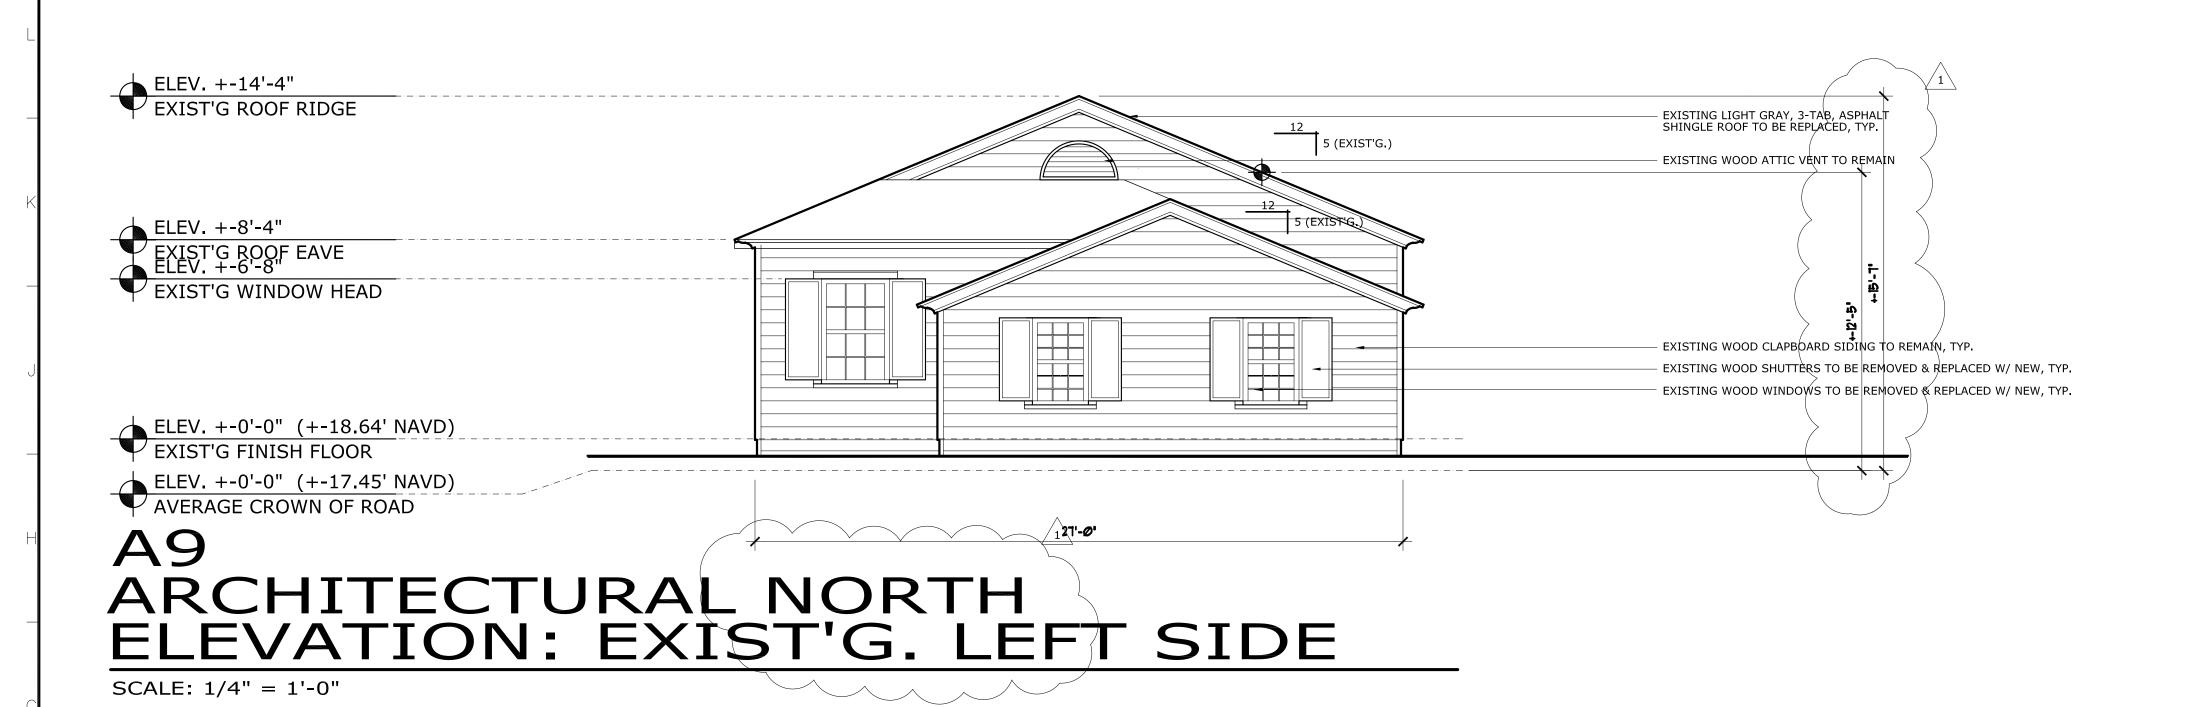

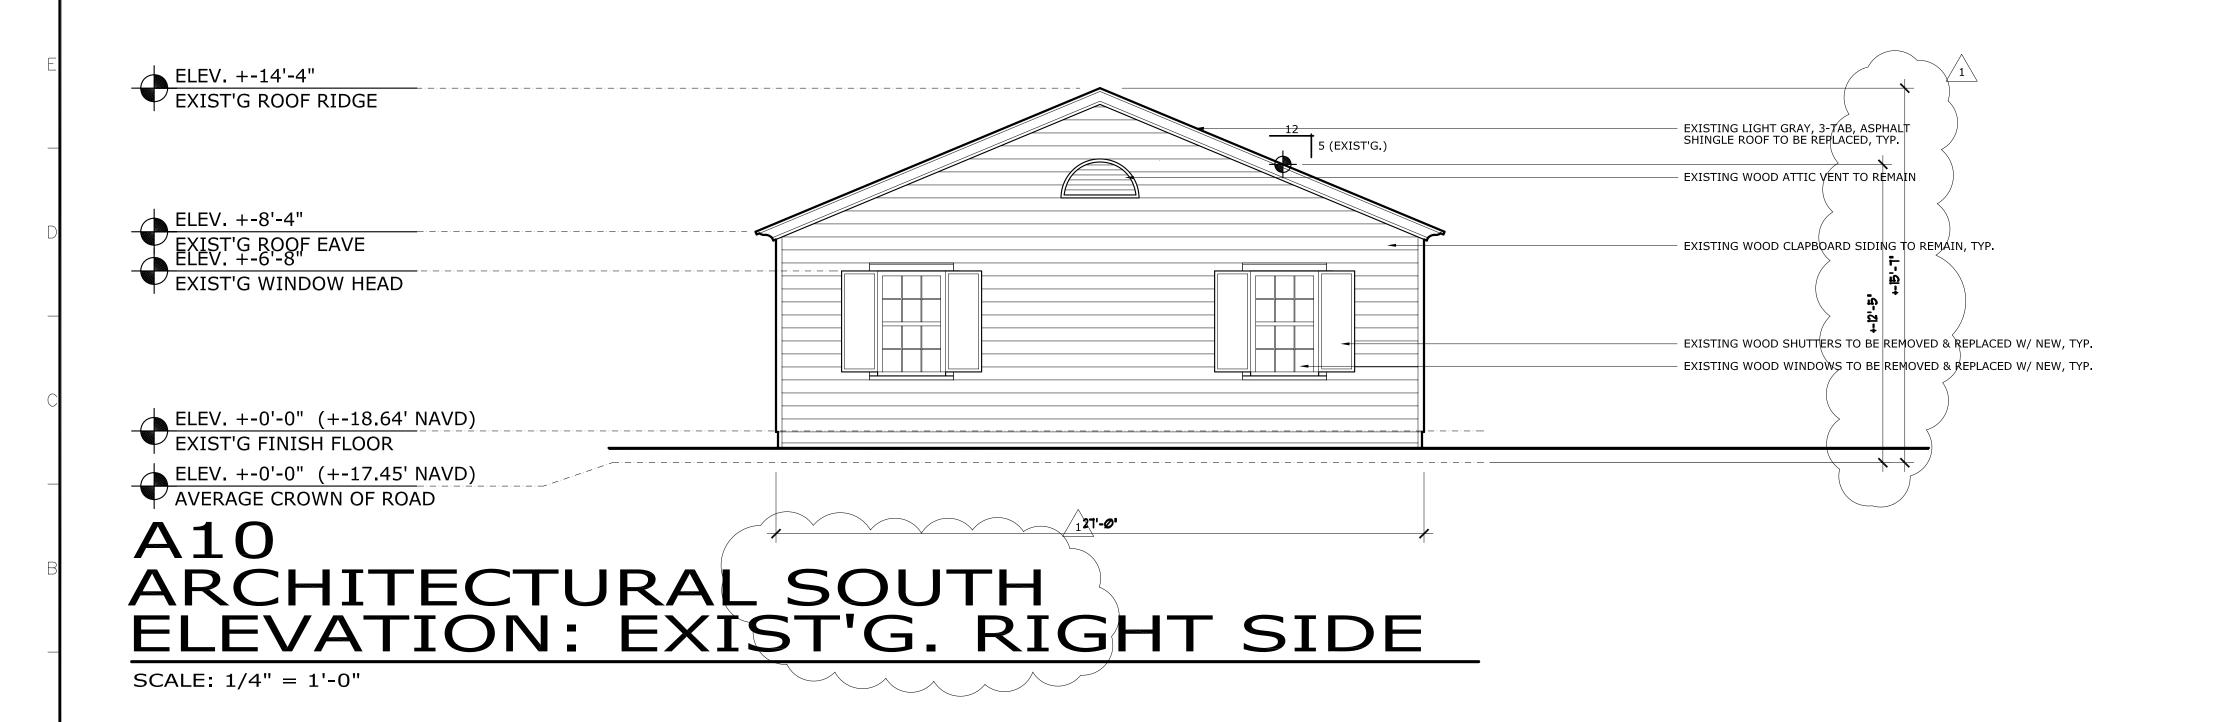



ROBIN MARINO RESIDENCE
223 NE 1ST AVENUE
DELRAY BEACH, FLORIDA **RW COPE** 2018.35MARINO **EXTERIOR ELEVN'S**

© COPE ARCHITECTS, INC., 2020

THIS DOCUMENT IS THE EXCLUSIVE PROPERTY OF COPE ARCHITECTS, INC.
AND SHALL NOT BE REPRODUCED WITHOUT THE AUTHORIZED WRITTEN
CONSENT OF COPE ARCHITECTS, INC.



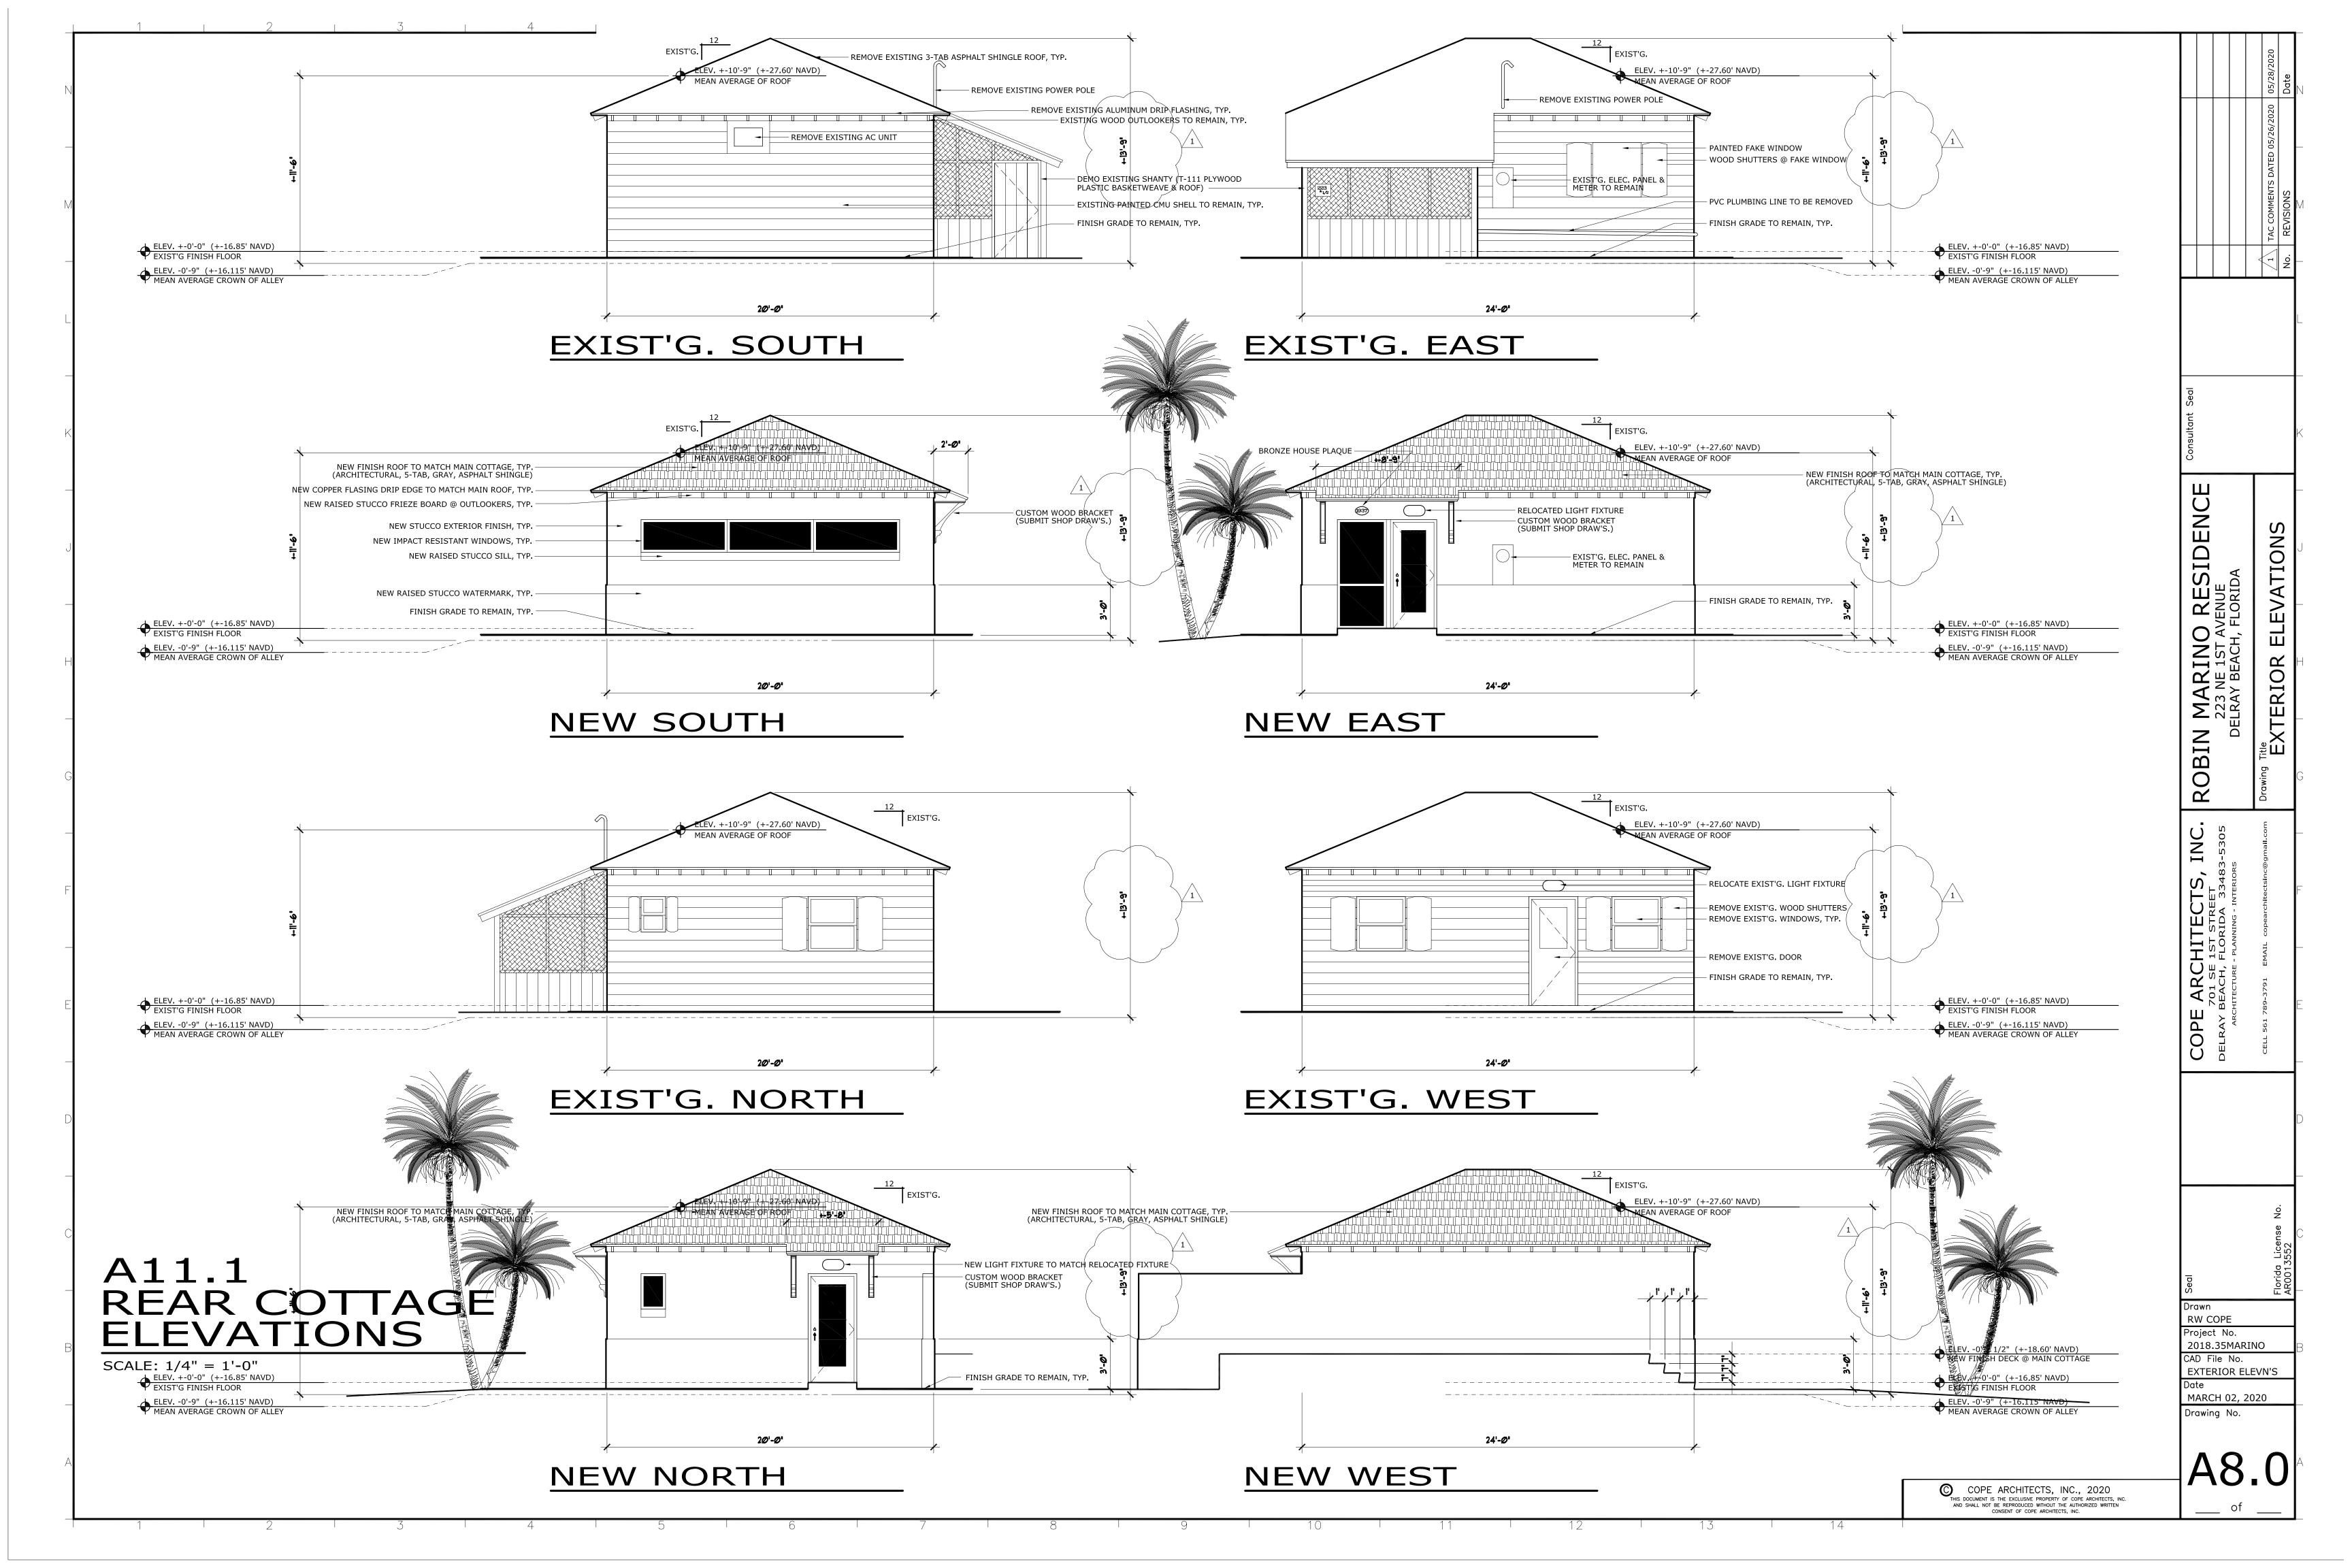

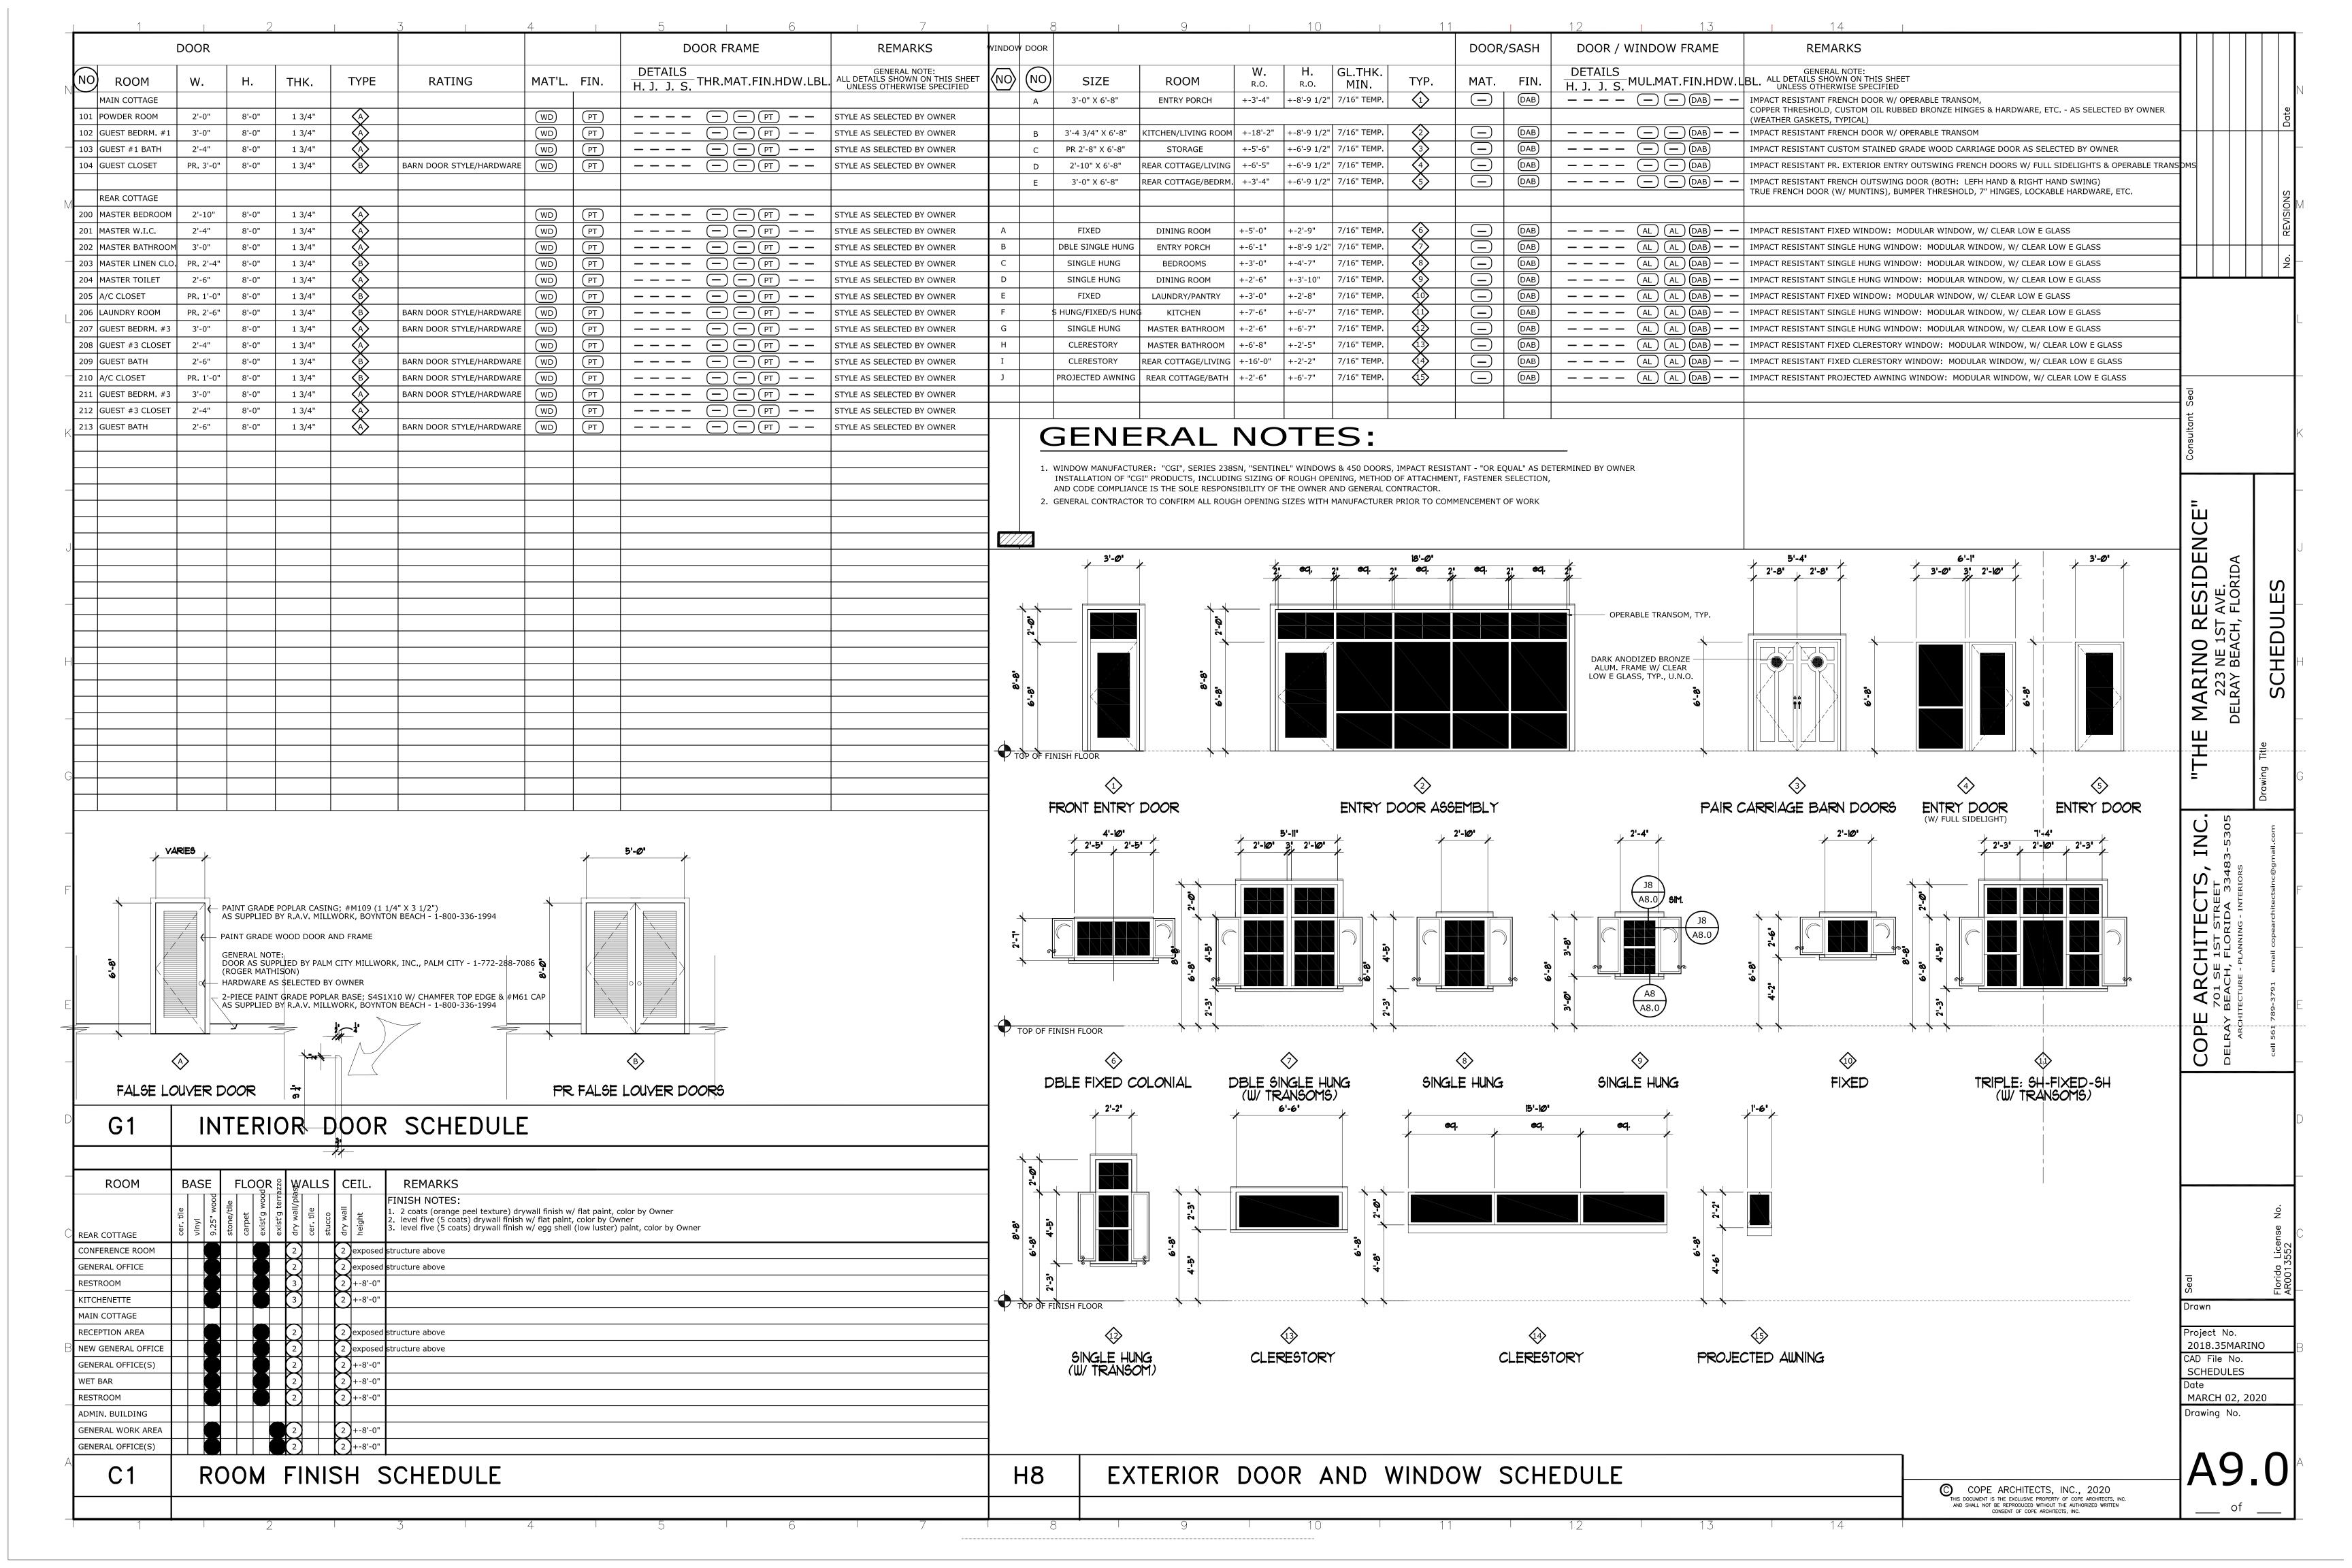

SOUTH LINE OF LOT 7

<u>LEGEND:</u>

 $\varphi = CENTERLINE$

CONC. = CONCRETE

W.M. = WATER METER

----- - OVERHEAD UTILITY LINES

+17.62 = ELEVATION BASED ON NORTH AMERICAN VERTICAL DATUM 1988. SOURCE: PALM BEACH COUNTY BENCH MARK "CHEROKEE BLONDE"

FLOOD ZONE: X COMMUNITY PANEL NO. 125102 0979

EFFECTIVE DATE: OCTOBER 05, 2017

NOTE: ALL BOUNDARY LINES AND ANGULAR DIMENSIONS ARE PLAT AND SURVEY UNLESS STATED OTHERWISE.

ALL DIMENSIONS SHOWN HEREON ARE BASED ON THE STANDARD U.S. FOOT.

THIS SURVEY HAS ACHIEVED A MINIMUM LEVEL
OF CLOSURE OF 1 FOOT IN 10,000 FEET AS
REQUIRED FOR COMMERCIAL/HIGH RISK
PROPERTY CLOSURE WAS ACHIEVED BASED ON
A REDUNDANCY OF MEASUREMENTS FOR VERTICAL,
HORIZONTAL AND ANGULAR DIMENSIONS.

NO TITLE WAS REVIEWED OR SEARCH OF THE PUBLIC RECORDS WAS MADE IN REGARD TO EASEMENTS THAT MAY AFFECT SUBJECT PARCEL

NO SUBSURFACE SEARCH WAS MADE FOR UTILITIES OR UNDERGROUND FOOTERS

DESCRIPTION:

THE SOUTH 27.5 FEET OF OT 6 AND THE NORTH 28 FEET OF LOT 7, IN THE SUBDIVISION OF BLOCK 74, DELRAY BEACH, FLORIDA, ACCORDING TO THE PLAT THEREOF ON FILE IN THE OFFICE OF THE OFFICE OF THE CIRCUIT COURT IN AND FOR PALM BEACH COUNTY, FLORIDA, RECORDED IN PLAT BOOK 11, PAGE 12.

CERTIFIED TO:

ROBIN L. MARINO

INDEPENDENCE TITLE INSURANCE AGENCY, INC. OLD REPUBLIC NATIONAL TITLE INSURANCE COMPANY

PADULA BENNARDO LEVINE, LLP

MAP OF BOUNDARY SURVEY SITE ADDRESS: 223 N.E. 1ST AVENUE

DELRAY BEACH, FLORIDA 33444 I HEREBY CERTIFY THAT THIS SURVEY WAS MADE UNDER MY RESPONSIBLE CHARGE AND MEETS THE STANDARDS OF PRACTICE AS SET FORTH BY THE FLORIDA BOARD OF PROFESSIONAL SURVEYORS AND MAPPERS IN CHAPTER 5J-17, FLORIDA ADMINISTRATIVE CODE, PURSUANT TO SECTION 472.027, FLORIDA STATUTES.

PAUL D. ENGLE

NOT VALID WITHOUT THE SIGNATURE AND THE ORIGINAL RAISED SEAL OF A FLORIDA LICENSED SURVEYOR AND MAPPER.

#5708

O'BRIEN, SUITER & O'BRIEN, INC.

LAND SURVEYORS CERTIFICATE OF AUTHORIZATION #LB353 SURVEYOR AND MAPPER IN RESPONSIBLE CHARGE: PAUL D. ENGLE 955 N.W. 17TH AVENUE, SUITE K-1, DELRAY BEACH, FLORIDA 33445 (561) 276-4501 732-3279 FAX 276-2390

DATE OF SURVEY AUGUST 7, 2018 FIELD BOOK PAGE NO. D.319 18

SCALE: ORDER NO.: 18–42db