

#### Development Services Department

#### **BOARD ACTION REPORT - APPEALABLE ITEM**

Project Name: German Auto World and Tiles By Vali (2018-074)

Project Location: 2165-2175 W. Atlantic Avenue

**Request:** Class III Site Plan Modification **Board:** Site Plan Review and Appearance Board

Meeting Date: November 19, 2020

Vote: Approved; 6-0 vote

#### **Board Action:**

Approved the Class III Site Plan Modification (6-0 vote Price Patton absent) for site plan modifications, landscape plan, and architectural elevation changes by finding that the request is consistent with the Comprehensive Plan and Land Development Regulations with the condition that applicant add Silver Buttonwood in place of Crate Myrtles.

#### **Project Description:**

The subject 1.64 acres site is located on the north side of West Atlantic Avenue, approximately 450 feet west of South Congress Avenue. The property is zoned Mixed Industrial Commercial (MIC) with a Land Use Designation of Commerce (CME). According to the Property Appraiser's Office, the site was developed in 1979. The site includes a 18,700 square feet multi-tenant warehouse building with frontage on West Atlantic Avenue and a 4,848 square feet warehouse building in the rear.

The proposal under consideration by the Board is to address the remaining required improvements associated with the conditional use approval for an auto body, paint and repair shop for German Auto World, along with additional floor plan, site and architectural elevation modifications. The applicant proposes to convert the rear building (4,848 square feet) to storage space; this building was previously utilized as additional area for the auto body, paint and repair shop, but it is no longer needed; therefore, the applicant requests to convert it back to storage of inventory for Tiles by Vali (tiles and flooring material). The proposal also includes floor plan changes to the most recent plans on file, which decreases the amount of area utilized as a vehicle body and repair shop by German Auto World from 7,475 square feet to 6,968 square feet (without including the indoor parking area). Lastly, improvements to the site, such as repaving, new parking areas, new lighting, upgraded landscaping, relocated dumpster, and architectural elevations are proposed.

#### **Board Comments:**

The Board made positive comments regarding the proposed site improvements.

#### **Public Comments:**

There were no public comments.

#### **Associated Actions:**

There are no associated actions following this request.

#### **Next Action**:

The SPRAB action is final unless appealed by the City Commission.



#### **DEVELOPMENT SERVICES DEPARTMENT**

100 NW 1<sup>ST</sup> AVENUE, DELRAY BEACH, FLORIDA 33444
PLANNING & ZONING DIVISION: (561) 243-7200
• BUILDING DIVISION: (561) 243-7200

#### SITE PLAN REVIEW AND APPEARANCE BOARD

Meeting: November 19, 2020 File No.: 2018-074-SPM-SPR-CL3 Application Type: Class III Site Plan Modification

**General Data:** 

Applicant: Tiles by Vali, Inc., Linda Dascalu

Agent: Steven Cohen, Architect

Address: 2165-2175 W. Atlantic Avenue PCN: 12-43-46-61-80-0000-5170 Property Size: 1.64 Acres (71,568 sf.) Land Use Designation: Commerce (CMR) Zoning: Mixed Industrial Commercial (MIC)

**Adjacent Zoning:** 

North: Special Activities District (SAD)

East: MIC

South: Planned Commercial (PC)

o West: MIC

Existing Land Use: Auto Repair/ Office/ Storage Proposed Land Use: Auto Repair/ Office/ Storage



#### Item before the Board:

Consideration of a Class III Site Plan Modification to address pending items associated with an approved Conditional Use, and to accommodate site and architectural changes, pursuant to Land Development Regulations (LDR) Section 2.4.5 (G)(1)(c). The item includes the following:

- Site Plan Modifications
- Landscape Plan
- Architectural Elevations Changes

#### **Optional Board Motions for Action Item:**

- 1. Move to continue with direction.
- 2. Move approval of the Class III Site Plan Modification (2018-074) for site plan modifications, landscape plan, and architectural elevation changes, for **German Auto World**, by finding that the request is consistent with the Comprehensive Plan and Land Development Regulations.
- 3. Move denial of the Class III Site Plan Modification (2018-074) for site plan modifications, landscape plan, and architectural elevation changes for **German Auto World**, by finding that the request is inconsistent with the Comprehensive Plan and does not meet the Land Development Regulations.

#### Notes:

#### The following items shall be addressed accordantly prior to certification of the plans:

- 1. The parking and floor plan on the plans must be revised to match the parking calculation included in the staff report.
- 2. The maneuvering area, adjacent to the parallel parking spaces, on the east end side of the property must be stripped out with a "no parking area" notation on the site plan.
- The landscape and site plans shall be revised to include the width of the landscape area along West Atlantic Avenue.

Project Planner:
Debora Slaski, Senior Planner;
SlaskiD@mydelrybeach.com,
561-243-7348

Review Dates: SPRAB Board: November 19, 2020 Attachments

1. Site Plans

2. Elevations

3. Landscape Plans





#### **Background:**

On September 20, 2010, the Planning & Zoning Board recommended approval of a Conditional Use application to allow German Auto World to establish a 9,075 sq. ft. auto body, paint and repair shop. The Conditional Use was approved by the City Commission on October 5, 2010.

On March 23, 2011, the Site Plan Review and Appearance Board approved a Class III Site Plan Modification associated with the Conditional Use. The proposal was approved with a condition that all improvements associated with the Conditional Use approved be constructed prior to the expiration date of the approval, September 10, 2012, otherwise, the German Auto World establishment would not be considered legally established.

In 2013 the applicant was notified that the required improvements associated with the approvals had not been successfully addressed, and consequently, the German Auto World was not considered legally established.

Currently, there is an active code violation (17-97878) associated with the illegally established use.

#### **Project Description:**

The subject 1.64 acres site is located on the north side of West Atlantic Avenue, approximately 450 feet west of South Congress Avenue. The property is zoned Mixed Industrial Commercial (MIC) with a Land Use Designation of Commerce (CME). According to the Property Appraiser's Office, the site was developed in 1979. The site includes a 18,700 square feet multi-tenant warehouse building with frontage on West Atlantic Avenue and a 4,848 square feet warehouse building in the rear.

The proposal under consideration by the Board is to address the remaining required improvements associated with the conditional use approval for an auto body, paint and repair shop for German Auto World, along with additional floor plan, site and architectural elevation modifications. The applicant proposes to convert the rear building (4,848 square feet) to storage space; this building was previously utilized as additional area for the auto body, paint and repair shop, but it is no longer needed; therefore, the applicant requests to convert it back to storage of inventory for Tiles by Vali (tiles and flooring material). The proposal also includes floor plan changes to the most recent plans on file, which decreases the amount of area utilized as a vehicle body and repair shop by German Auto World from 7,475 square feet to 6,968 square feet (without including the indoor parking area). Lastly, improvements to the site, such as repaving, new parking areas, new lighting, upgraded landscaping, relocated dumpster, and architectural elevations are proposed.

#### Site Plan Analysis:

#### **Compliance with the Land Development Regulations:**

Items identified in the Land Development Regulations shall specifically be addressed by the body taking final action on the site and development application/request.

#### **Establishment of the Proposed Use/ Certificate of Occupancy:**

Per LDR Section 2.4.6(C), a certificate of occupancy is required prior to the establishment of use on any site or occupancy of a structure. Prior to issuance of an occupancy permit, all conditions and requirements associated with this development approval shall be met.

#### LDR Section 4.3.4(K) Development Standards Matrix:

The following table demonstrates applicability and compliance with LDR Section 4.3.4(K) and Section 4.4.19 as it pertains to the MIC Zoning District. The only requirement proposed to be modified is the minimum open space requirement. Currently the site provides 13% of open space (existing conformity), and an increase to 20% is proposed by decreasing the amount of paved areas.

FILE NO.: 2018-074-SPF SPR-CL3 – GERMAN AUTO WORLD/ TILES BY VALI

Page | 2



	Required	Existing	Proposed
Minimum Lot Size	0	71,568 sf.	71,568 sf.
Minimum Lot Width	0	195.57 ft.	195.57 ft.
Minimum Lot Depth	0	371 ft.	371 ft.
Minimum Lot Frontage	0	282 ft.	282 ft.
Minimum Floor Area	0	23,548 sf.	23,548 sf.
Setbacks:			
Min. Front (South / W. Atlantic Ave.)	25 ft.	29.5 ft.	29.5 ft.
Min. Side Interior (East)	10 ft.	23.2 ft.	23.2 ft.
Min. Side Interior (West)	10 ft.	21.7 ft.	21.7 ft.
Min. Rear (North)	10 ft.	16.9 ft.	16.9 ft.
Minimum Open Space	25%	13%*	20%**
Maximum Lot Coverage	50%	23.9%	23.9%
Maximum Floor Area Ratio (FAR)	0.60	0.32	0.32
Maximum Building Height*	48 ft.	18 ft.	18 ft.
*Existing nonconformity			

#### LDR Section 4.6.9, Parking:

Pursuant to Section 4.6.9(C)(5)(a), general industrial uses (manufacturing, assembly, attendant offices) shall provide parking at a rate of 3 spaces per 1,000 sq. ft. of floor area devoted to such uses and 1 space per 1,000 sq. ft. of floor area devoted to storage and warehouse. Vehicle body and repair shops shall provide 4.5 spaces per 1,000 square feet of gross floor area per LDR Section 4.6.9(C)(5)(b). The site consists of a total of 23,548 square feet.

Per the accepted floor plans associated with the conditional use approval, the required parking for the entire site is fifty-two spaces. To accommodate the parking requirement, the conditional use approval included six interior parking spaces in each building. The rear building was approved as part of the auto paint shop; however, as part of this site plan modification, the applicant proposes to convert the rear building (4,848 square feet) into storage space and to decrease in the amount of area utilized as a vehicle body and repair shop for German Auto from 7,475 square feet to 6,968 square feet (without including the indoor parking area). The table below identifies the required number of parking spaces per area and use. A total of 47 spaces are required, and 52 spaces are provided on site (46 outdoor throughout the site and 6 indoor spaces within German Auto World tenant space). The minimum parking requirement is met. As an outstanding requirement to be addressed prior to site plan certification, the site plan must be revised to include the office portion (405 square feet) associated with "Eurostone Imports" establishment, which was calculated as "warehouse" on the plans instead of "office".

Establishment	Use	Proposed Use Area	Parking Requirement	Total	
German Auto World	Vehicle body, paint and repair shop	6,968 sf.	4.5 spaces/1,000 sf (31.35 spaces required)	31.25 spaces	
	Storage of vehicles (indoor parking area)	2,460 sf	N/A	·	
Tiles By Vali	Office	556 sf	3 spaces/ 1,000 sf	5.7 spaces	
		550 81	(1.66 spaces required)		
	Warehouse	/arehouse 4,044 sf	1 space/ 1,000 sf		
	4,044 51		(4.04 spaces required)		
Eurostone Imports	Office	405 sf	3 spaces/ 1,000 sf	F 47 annua	
		400 81	(1.21 spaces required)		
	Warehouse	4,267 sf	1 space/ 1,000 sf	5.47 spaces	
		4,207 51	(4.26 spaces required)		
Warehouse (rear building)	Warehouse	4,848 sf	1 space/ 1,000 sf	4.04.0000	
,			(4.85 required)	4.84 spaces	
TOTAL		23,548		47 (47.26 rounded down)	

<sup>\*\*</sup>Existing nonconformity proposed to be decreased from 13% to 20%.



#### Handicap Parking Spaces:

Per the Americans with Disability Act (ADA), a parking lot with 52 spaces is required to provide a minimum of three accessible parking spaces. The proposal provides three space in front of the main building facing West Atlantic Avenue; thus, this requirement is met.

#### LDR Article 4.6 – Supplemental District Regulations:

#### Refuse Disposal:

Pursuant to LDR Section 4.6.6(C)(1), dumpsters, recycling containers and similar service areas must be enclosed on three sides with vision obscuring gates on the fourth side, unless such areas are not visible from any adjacent public right-of-way. The proposed dumpster is located towards the rear of the property, on the west side. The existing dumpster is enclosed on three sides, screened with landscaping on two sides, and a vision obstructing gate on the fourth side is provided. Therefore, the existing refuse disposal complies with this requirement.

#### Lighting:

On-site lighting must be provided and be consistent with the minimum and maximum foot candle illumination level requirements. The chart below demonstrates compliance with the minimum acceptable standards for lighting pursuant to LDR Section 4.6.8(B)(3)(c):

Photometric Plan	Requirements		Proposed	
Photometric Plan	Min. (fc)	Max. (fc)	Min. (fc)	Max. (fc)
Commercial and Industrial Parking Lot	1.0	12.0	1.0	7.5
Building Entrances	1.0	10.0	1.0	7.5

The maximum height for freestanding light poles is 25' and the proposed light poles measure 20' high from finish grade. The average illumination level at the property line is 0.2 which is below the 0.5 maximum allowed. Therefore, the proposal complies with the applicable lighting requirements.

#### **Dead-end-Parking Bay:**

Pursuant to LDR Section 4.6.9(D)(4)(c), dead-end parking bays are discouraged, but when site conditions dictate that there be dead-end parking bays, they shall be designed so that there is a 24 ft. wide by 6 ft. deep maneuvering area at the end of the bay. The maneuvering area shall not encroach upon the required landscape areas. The applicant is proposing a 13-space dead-end parking bay at the northwest corner of the property and a 6-space parking bay on the east end of the property. The proposed maneuvering area for each parking bay measures 24 ft. wide by 6 ft. deep; thus, this requirement is met. As a requirement to be addressed prior to site plan certification, the maneuvering area, adjacent to the parallel parking spaces, on the east end side of the property must be stripped out with a "no parking area" notation on the site plan prior to certification of the plans.

#### Landscape Analysis:

Pursuant to LDR Section 4.6.16(C)(1)(a) "Prior to the issuance of a building permit for a structure or a paving permit, compliance with the requirements of Section 4.6.16 shall be assured through the review and approval of a landscape plan submitted pursuant to Section 2.4.3(C)." The subject proposal is required to comply with the landscape standards under LDR 4.6.16. A proposed landscape plan has been submitted and evaluated by the Senior Landscape Planner and found to be in compliance.

Per LDR Section 4.3.4(H)(6)(a)3., along West Atlantic Avenue, from I-95 to the Western City Limits, a special landscape area shall be provided on both sides of the ultimate right-of-way. This landscape area shall be the smaller distance of either 30 feet or ten percent of the average depth of the property; however, in no case shall the landscape area be less than ten feet. The depth of the property is approximately 371 feet (10% is 37.1 feet), therefore, the special landscape area is required to be a minimum of 30 feet. The property was subject to a taken action by the Florida Department of Transportation (FDOT) recently (Official Records Book 29223, Page, 1978), which reduced the area along West Atlantic Avenue, from approximately 17 feet to approximately 7.9 feet. The existing area is considered an existing nonconformity and is allowed to remain as it; however, no improvements proposed by the applicant can further increase this nonconformity. The site improvements proposed as part of this request do not affect this area. To maintain a record of this nonconformity, the landscape and site plan shall be revised prior to certification of the application to include the width of the landscape area throughout the front of the property.

The proposed landscape plan provides parking area, perimeter, and foundation landscaping. The proposed landscaping consists of a variety of trees, shrubs, and ground covers including, but not limited to: Dahoon Holly, Crape Myrtle, Glaucous Cassia, Solitaire



Palms, 'Red Tip' Cocoplum, 'Horizontal' Cocoplum, Dwarf Schellings Ilex, Podocarpus, Green Island Ficus, Dwarf Schefflera 'Trinette' and Shore Juniper ground cover. The landscape plan indicates a landscape barrier along West Atlantic Avenue. Existing trees and plants have been preserved along the western property line, including Ficus and Royal Poinciana trees, a Sabal Palm tree and White Birds of Paradise.

#### **Architectural Elevations Analysis:**

Pursuant to LDR Section 4.6.18(E), Criteria for Board Action, the following criteria shall be considered by the Site Plan Review and Appearance Board (SPRAB), in the review of plans for building permits. If the following criteria are not met, the application shall be disapproved:

- 1. The plan or the proposed structure is in conformity with good taste, good design, and in general contributes to the image of the City as a place of beauty, spaciousness, harmony, taste, fitness, broad vistas, and high quality.
- 2. The proposed structure, or project, is in its exterior design and appearance of quality such as not to cause the nature of the local environment or evolving environment to materially depreciate in appearance and value.
- 3. The proposed structure, or project, is in harmony with the proposed developments in the general area, with the Comprehensive Plan, and with the supplemental criteria which may be set forth for the Board from time to time.

Architectural elevation changes to the existing building include the removal of the existing awnings and introduction of a canopy where signage is proposed to be placed on. New windows will be introduced on the south (front) elevation; metal panels will be installed over the windows. The proposed color scheme is light and dark gray.



Page | 5

#### **Required Findings:**

Pursuant to LDR Section 2.4.5(G)(1)(c) Class III Site Plan Modification, a modification to a site plan which represents either a change in intensity of use, or which affects the spatial relationship among improvements on the land, requires partial review of Performance Standards found in LDR Sections 3.1.1, and 3.2.3, as well as required findings of LDR Section 2.4.5(G) (5).

#### LDR Section 2.4.5(G)(5):

Pursuant to LDR Section 2.4.5(G)(5), a finding that the proposed changes do not significantly affect the originally approved plan must be made concurrent with approval of a Class III modification.

The proposal under consideration by the Board is to address the remaining required improvements associated with the conditional use approval for an auto body, paint and repair shop for German Auto World, along with floor plan, site and architectural elevation modifications. The proposed interior and exterior modifications will not disturb the existing building footprint. Along with the interior floor plan modifications, site improvements such as creating additional parking areas, relocating dumpster, and upgrades to the landscaping and lighting are proposed. The proposed site modifications will decrease existing nonconformities.

Pursuant to LDR Section 3.1.1 (Required Findings), prior to the approval of development applications, certain findings must be made in a form which is part of the official record. This may be achieved through information on the application, written materials submitted by the applicant, the staff report, or minutes. Findings shall be made by the body which has the authority to approve or deny the development application. These findings relate to the following areas:

<u>Section 3.1.1 (B) –Land Use:</u> The use or structures must be allowed in the zoning district and the zoning district must be consistent with the land use designation).

The subject property has a Commerce (CMR) Land Use Map designation and is zoned Mixed Industrial and Commercial (MIC). The MIC zoning is consistent with the CMR land use designation. The existing and proposed uses include automotive body, paint and repair shops, storage of goods and associated attendant office. Pursuant to the LDR Section 4.4.19(B)(2) and (3), allow uses that provide an off-site service but maintain inventory, storage and an office at a central location, as described in Section 4.4.20 (B) (5), The applicant has stated that the building designated for warehouse and storage are to be occupied by allowed uses in accordance with Section 4.4.20(B)(5). Pursuant to the LDR Section 4.4.19(D)(1)(c), within the MIC zone district automotive body, paint and repair



shops are listed as a conditional use. The existing Conditional use to allow an automotive body, paint and repair shop for German Auto World, was approved by the City Commission on October 5, 2010. The proposed modifications associated with the conditional use are a decrease in intensity; therefore, it was determined that a Modification to the Conditional Use is not needed.

Based upon the above, a positive finding can be made with respect to consistency with the Future Land Use Map designation. **LDR Section 3.1.1(B) - Concurrency:** Refer to Appendix A, as it relates to water, sewer, streets and traffic, parks and recreation, and solid waste.

**Section 3.1.1 (C) - Consistency (Standards for Site Plan Actions):** A review of the objectives and policies of the Comprehensive Plan was conducted, and the following applicable objective was found.

**Comprehensive Plan Policies:** A review of the objectives and policies of the adopted Comprehensive Plan was conducted, and the following objective is noted:

Policy NDC 2.5.1: Direct auto-related uses that involve the servicing and repair of vehicles, other than as part of a full-service dealership, to land with an Industrial or Commerce land use designation. The proposed auto body, paint and repair shop is located within the Commerce land use designation.

Policy NDC 1.1.14: Property shall be property be developed or redeveloped or accommodated, in a manner so that the use, intensity and density are appropriate in terms of soil, topographic, and other applicable physical considerations; encourage affordable goods and services; are complementary to and compatible with adjacent land uses; and fulfill remaining land use needs.

The following zoning designations and uses are abutting the subject property:

	Zoning Designation:	Use:
North:	Recently zoned to SAD (previously MIC)	Industrial processing: the site is currently under review for a mixed-use development with residential and commercial
		uses.
South:	Planned Commercial (PC)	Congress Square Shopping Plaza – Commercial shopping
South.		center
East:	East: MIC Convenience Store	
West:	MIC	Causeway Lumber / Storage

The proposed modifications will not disturb the existing building footprint. There are no special physical or environmental characteristics of the land that would be negatively impacted by the proposed interior modification and site improvements, and the proposed/existing land use is compatible and with adjacent land uses.

LDR Section 3.1.1(D) - Compliance with the Land Development Regulations: Refer to the Analysis sections of this report, regarding compliance with the LDRs.

#### Review by Others:

#### **Courtesy Notices:**

There are no homeowner's associations within the vicinity.

Letters of objection and/or support, if any, will be presented at the Board meeting.

#### **Utility Providers:**

• Pursuant to 2.4.2 (C)(2)(a), utility providers were notified of the site plan submission and each entity provided a letter with no objections or additional requirements.

FILE NO.: 2018-074-SPF SPR-CL3 – GERMAN AUTO WORLD/ TILES BY VALI



#### Appendix "A" - Concurrency Findings

Pursuant to LDR Section 3.1.1(B), Concurrency, as defined pursuant to Objective B-2 of the Land Use Element of the Comprehensive Plan, must be met and a determination made that the public facility needs of the requested land use and/or development application will not exceed the ability of the City to fund and provide, or to require the provision of, needed capital improvements for the following areas:

#### Water and Sewer:

Since the request does not involve the construction of additional buildings, the existing water and sewer on site which service the buildings adequately supply the development. Pursuant to the City's Comprehensive Plan, treatment capacity is available at the City's Water Treatment Plan and the South County Waste Water Treatment Plan for the City at build-out. Upon staff's review of the plans, positive findings can be made with respect to this level of service standard.

- Water service is existing on site via an existing 12" water main on Atlantic Avenue.
- Sewer service is existing on site via an existing 12" sanitary sewer on Atlantic Avenue.

**Streets and Traffic:** A traffic study submitted indicates that the proposed use conversion will generate 9 AM peak hours trips, and 107 less daily. A positive finding of concurrency has been received from the Palm Beach County Traffic Division.

**Parks and Recreation Facilities**: Park dedication requirements do not apply for non-residential uses. Thus, the proposed development will not have any impact with respect to this standard.

**Solid Waste:** This proposed change of use will reduce will result in a decrease of 9.34 tons of solid waste per year as shown on the table below. The Solid Waste Authority has indicated that its facilities have sufficient capacity to accommodate all development proposals until 2048.

Use		Existing	Proposed	
Vehicle body, paint and	13,923	64.74 tons /year	9,428 sf	43.84 tons /year
repair shop	sf	(13,923 sf. x 9.3 lbs =	(includes area devoted	(9,428 sf. x 9.3 lbs = 87,680 lbs /
		129,483 lbs / 2,000)		
		262.52)	,	, ,
Warehouse and Office 9,675 sf		25.15 tons	14,120 sf	36.71 tons
		$(9,675 \text{ sf. } \times 5.2 \text{ lbs} =$		(14,120 sf. x 5.2 lbs = 73,424 lbs /
		50,310 lbs / 2,000)		2,000)
Total		89.89 tons		80.55 tons

<u>Drainage</u>: Drainage is accommodated on site via an exfiltration trench system. There should be no impact on drainage as it relates to this standard.




	DIX "B" - STANDARDS FOR SITE PLAN ACTIONS Sec. 3.2.3 (A) through (J)  Building design, landscaping and lighting (glare) shall be such that they do not create unwarranted distractions or blockage of visibility as it pertains to traffic circulation.  Not applicable  Meets intent of standard  Does not meet intent
B.	Separation of different forms of transportation shall be encouraged. This includes pedestrians, bicyclists and vehicles in a manner consistent with policies found under Objectives D-1 and D-2 of the Transportation Element.  Not applicable  Meets intent of standard  Does not meet intent
C.	Open space enhancements as described in Policies found under Objective B-1 of the Open Space and Recreation Element are appropriately addressed.  Not applicable  Meets intent of standard  Does not meet intent
D.	The City shall evaluate the effect that any street widening or traffic circulation modification may have upon an existing neighborhood. If it is determined that the widening or modification will be detrimental and result in a degradation of the neighborhood, the project shall not be permitted.  Not applicable  Meets intent of standard  Does not meet intent
E.	Development of vacant land which is zoned for residential purposes shall be planned in a manner which is consistent with adjacent development regardless of zoning designations.  Not applicable  Meets intent of standard  Does not meet intent
F.	Property shall be developed or redeveloped in a manner so that the future use and intensity are appropriate in terms of soil, topographic, and other applicable physical considerations; complementary to adjacent land uses; and fulfills remaining land use needs.  Not applicable  Meets intent of standard  Does not meet intent
G.	Redevelopment and the development of new land shall result in the provision of a variety of housing types which shall continue to accommodate the diverse makeup of the City's demographic profile and meet the housing needs identified in the Housing Element. This shall be accomplished through the implementation of policies under Objective B-2 of the Housing Element.  Not applicable  Meets intent of standard  Does not meet intent
H.	The City shall consider the effect that the proposal will have on the stability of nearby neighborhoods. Factors such as noise, odors, dust, traffic volumes and circulation patterns shall be reviewed in terms of their potential to negatively impact the safety, habitability and stability of residential areas. If it is determined that a proposed development will result in a degradation of any neighborhood, the project shall be modified accordingly or denied.  Not applicable  Meets intent of standard  Does not meet intent


FILE NO.: 2018-074-SPF SPR-CL3 – GERMAN AUTO WORLD/ TILES BY VALI




I.	Development shall not be approved if traffic associated with such development would create a new high accident
	location, or exacerbate an existing situation causing it to become a high accident location, without such development
	taking actions to remedy the accident situation.
	Not applicable Not applicable
	Meets intent of standard
	☐ Does not meet intent
J.	Tot lots and recreational areas, serving children from toddler to teens, shall be a feature of all new housing
	developments as part of the design to accommodate households having a range of ages. This requirement may be
	waived or modified for residential developments located in the downtown area, and for infill projects having fewer than
	25 units.
	Not applicable     Not
	Meets intent of standard
	Does not meet intent


Page | 9

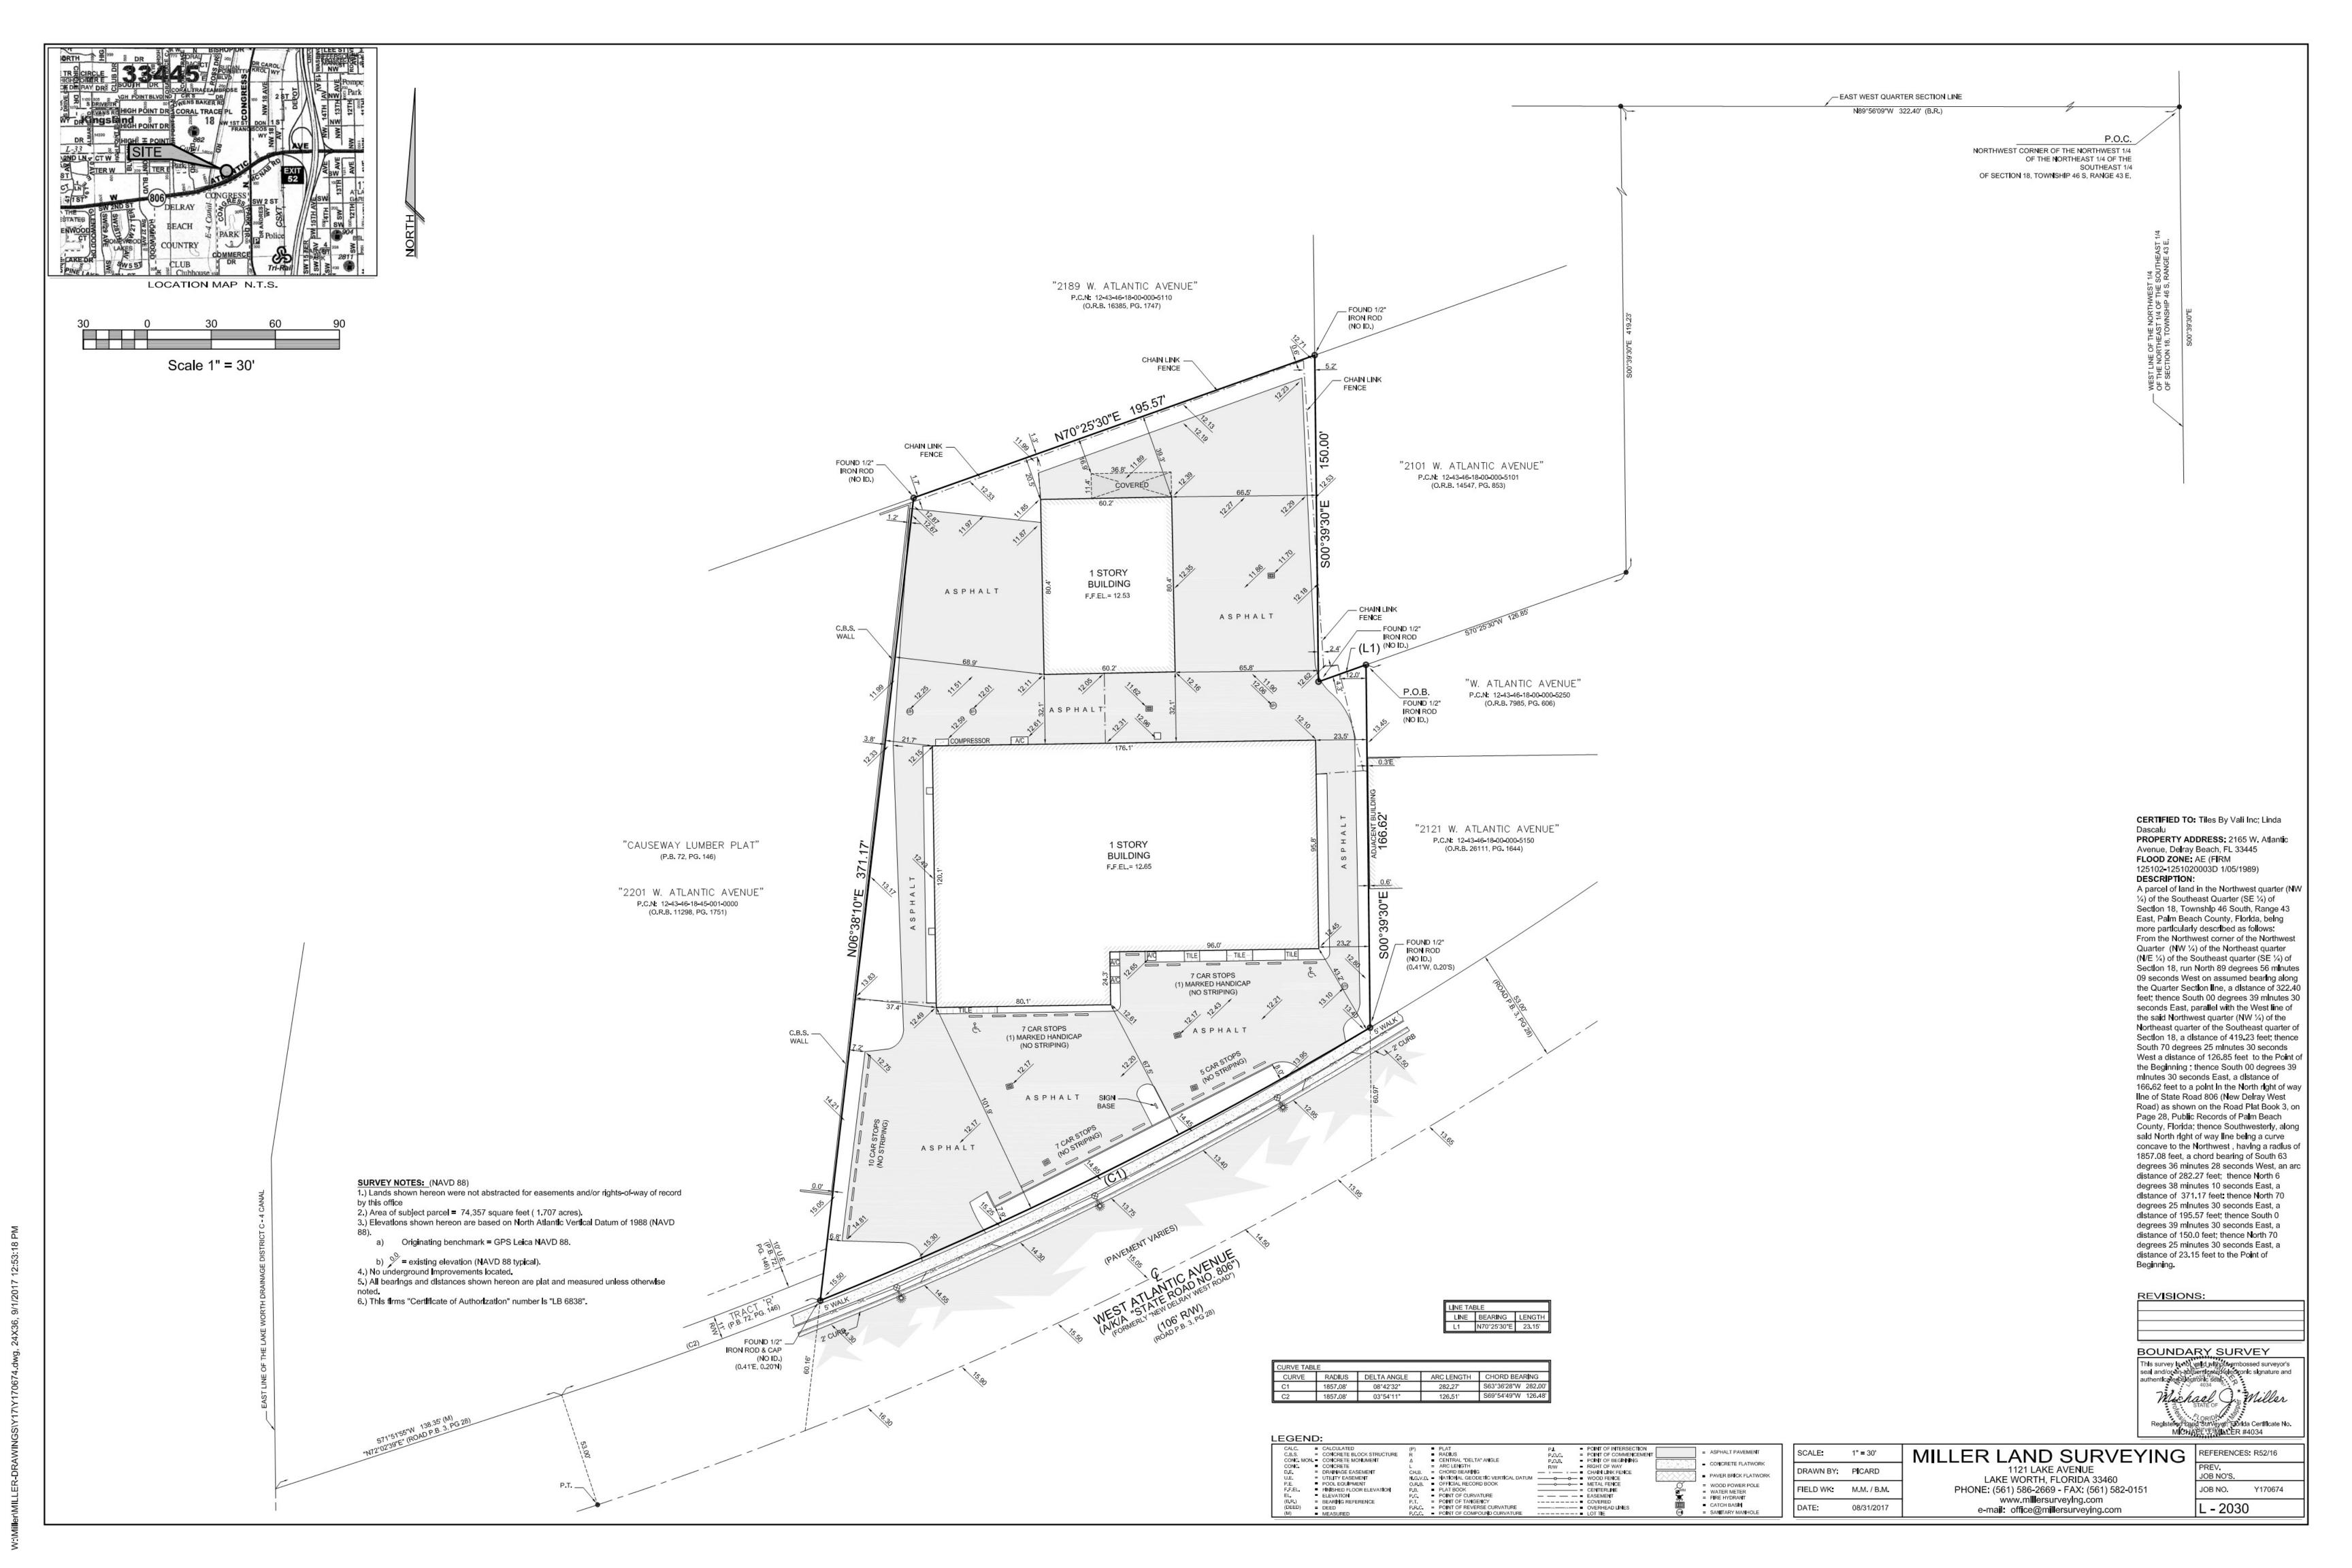

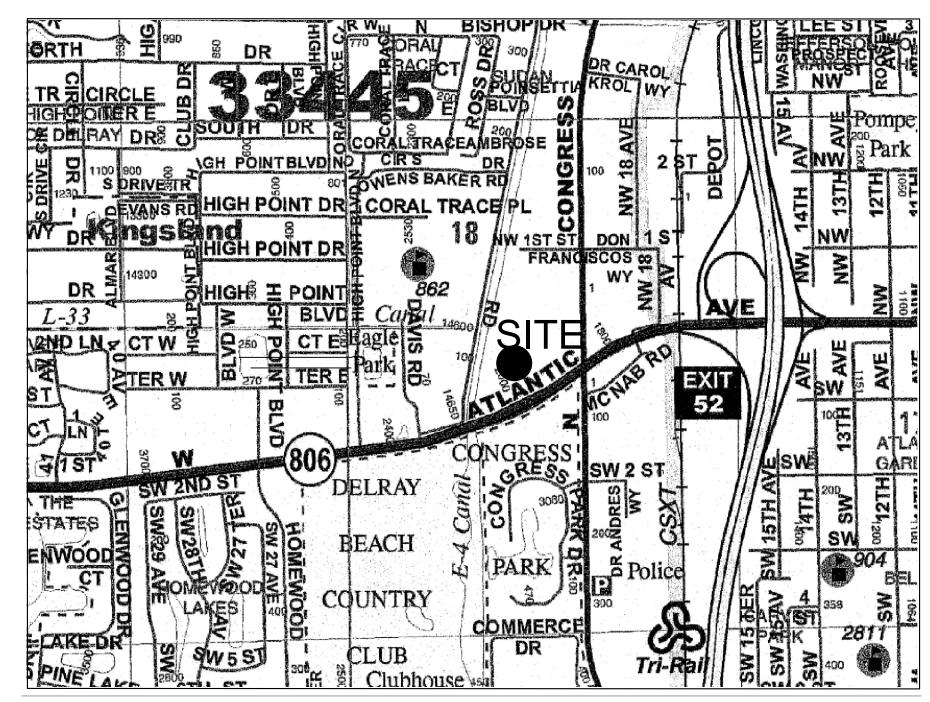

LOCATION MAP N.T.S.

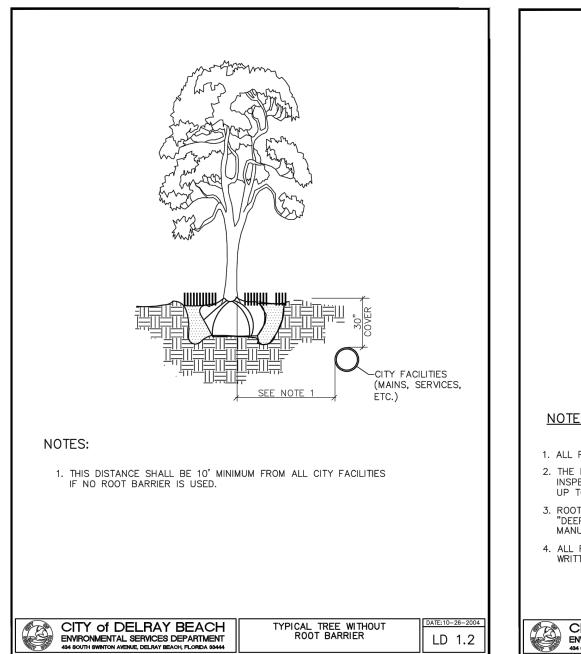

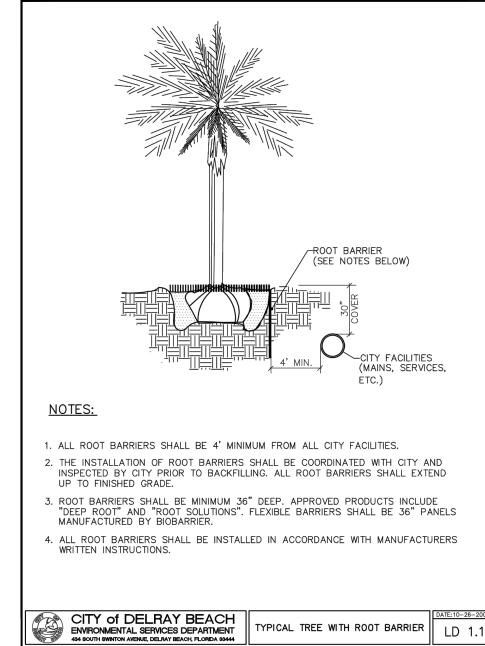

ANY TREES OR SHRUBS PLACED WITHIN WATER, SEWER OR DRAINAGE EASEMENTS SHALL CONFORM TO THE CITY OF DELRAY BEACH STANDARD DETAILS; LO 1.1 & LO 1.2.


### SITE DATA

	EXISTING		PROPOSED		NET CHANGE	
	AREA (S.F.)	EXISTING	AREA (S.F.)	PROPOSED	(S.F.)	
BUILDINGS (A & B)	23,548	33.32%	23,548	33.32%	0	
OPEN SPACE (PERVIOUS)	9,777	13.83%	14,472	20.48%	4,695	
PARKING / PAVED	40,800	57.73%	33,548	47.47%	-7,252	
TOTAL SITE AREA	74,125	104.88%	71,568	101.27%	-2,557	

THE OVERALL SITE IMPROVEMENTS WILL RESULT IN ADDITIONAL PERVIOUS AREA AND REDUCTION IN THE IMPERVIOUS AREA

NO DRAINAGE CALCULATIONS ARE REQUIRED, SINCCE THE ADDED PERVIOUS AREA WILL REDUCE THE TOTAL STORM WATER RUNOFF

SITE AREA BEFORE F.D.O.T. DEDICATION = 74.125 S.F. SITE AREA AFTER F.D.O.T. DEDICATION = 71,568 S.F.

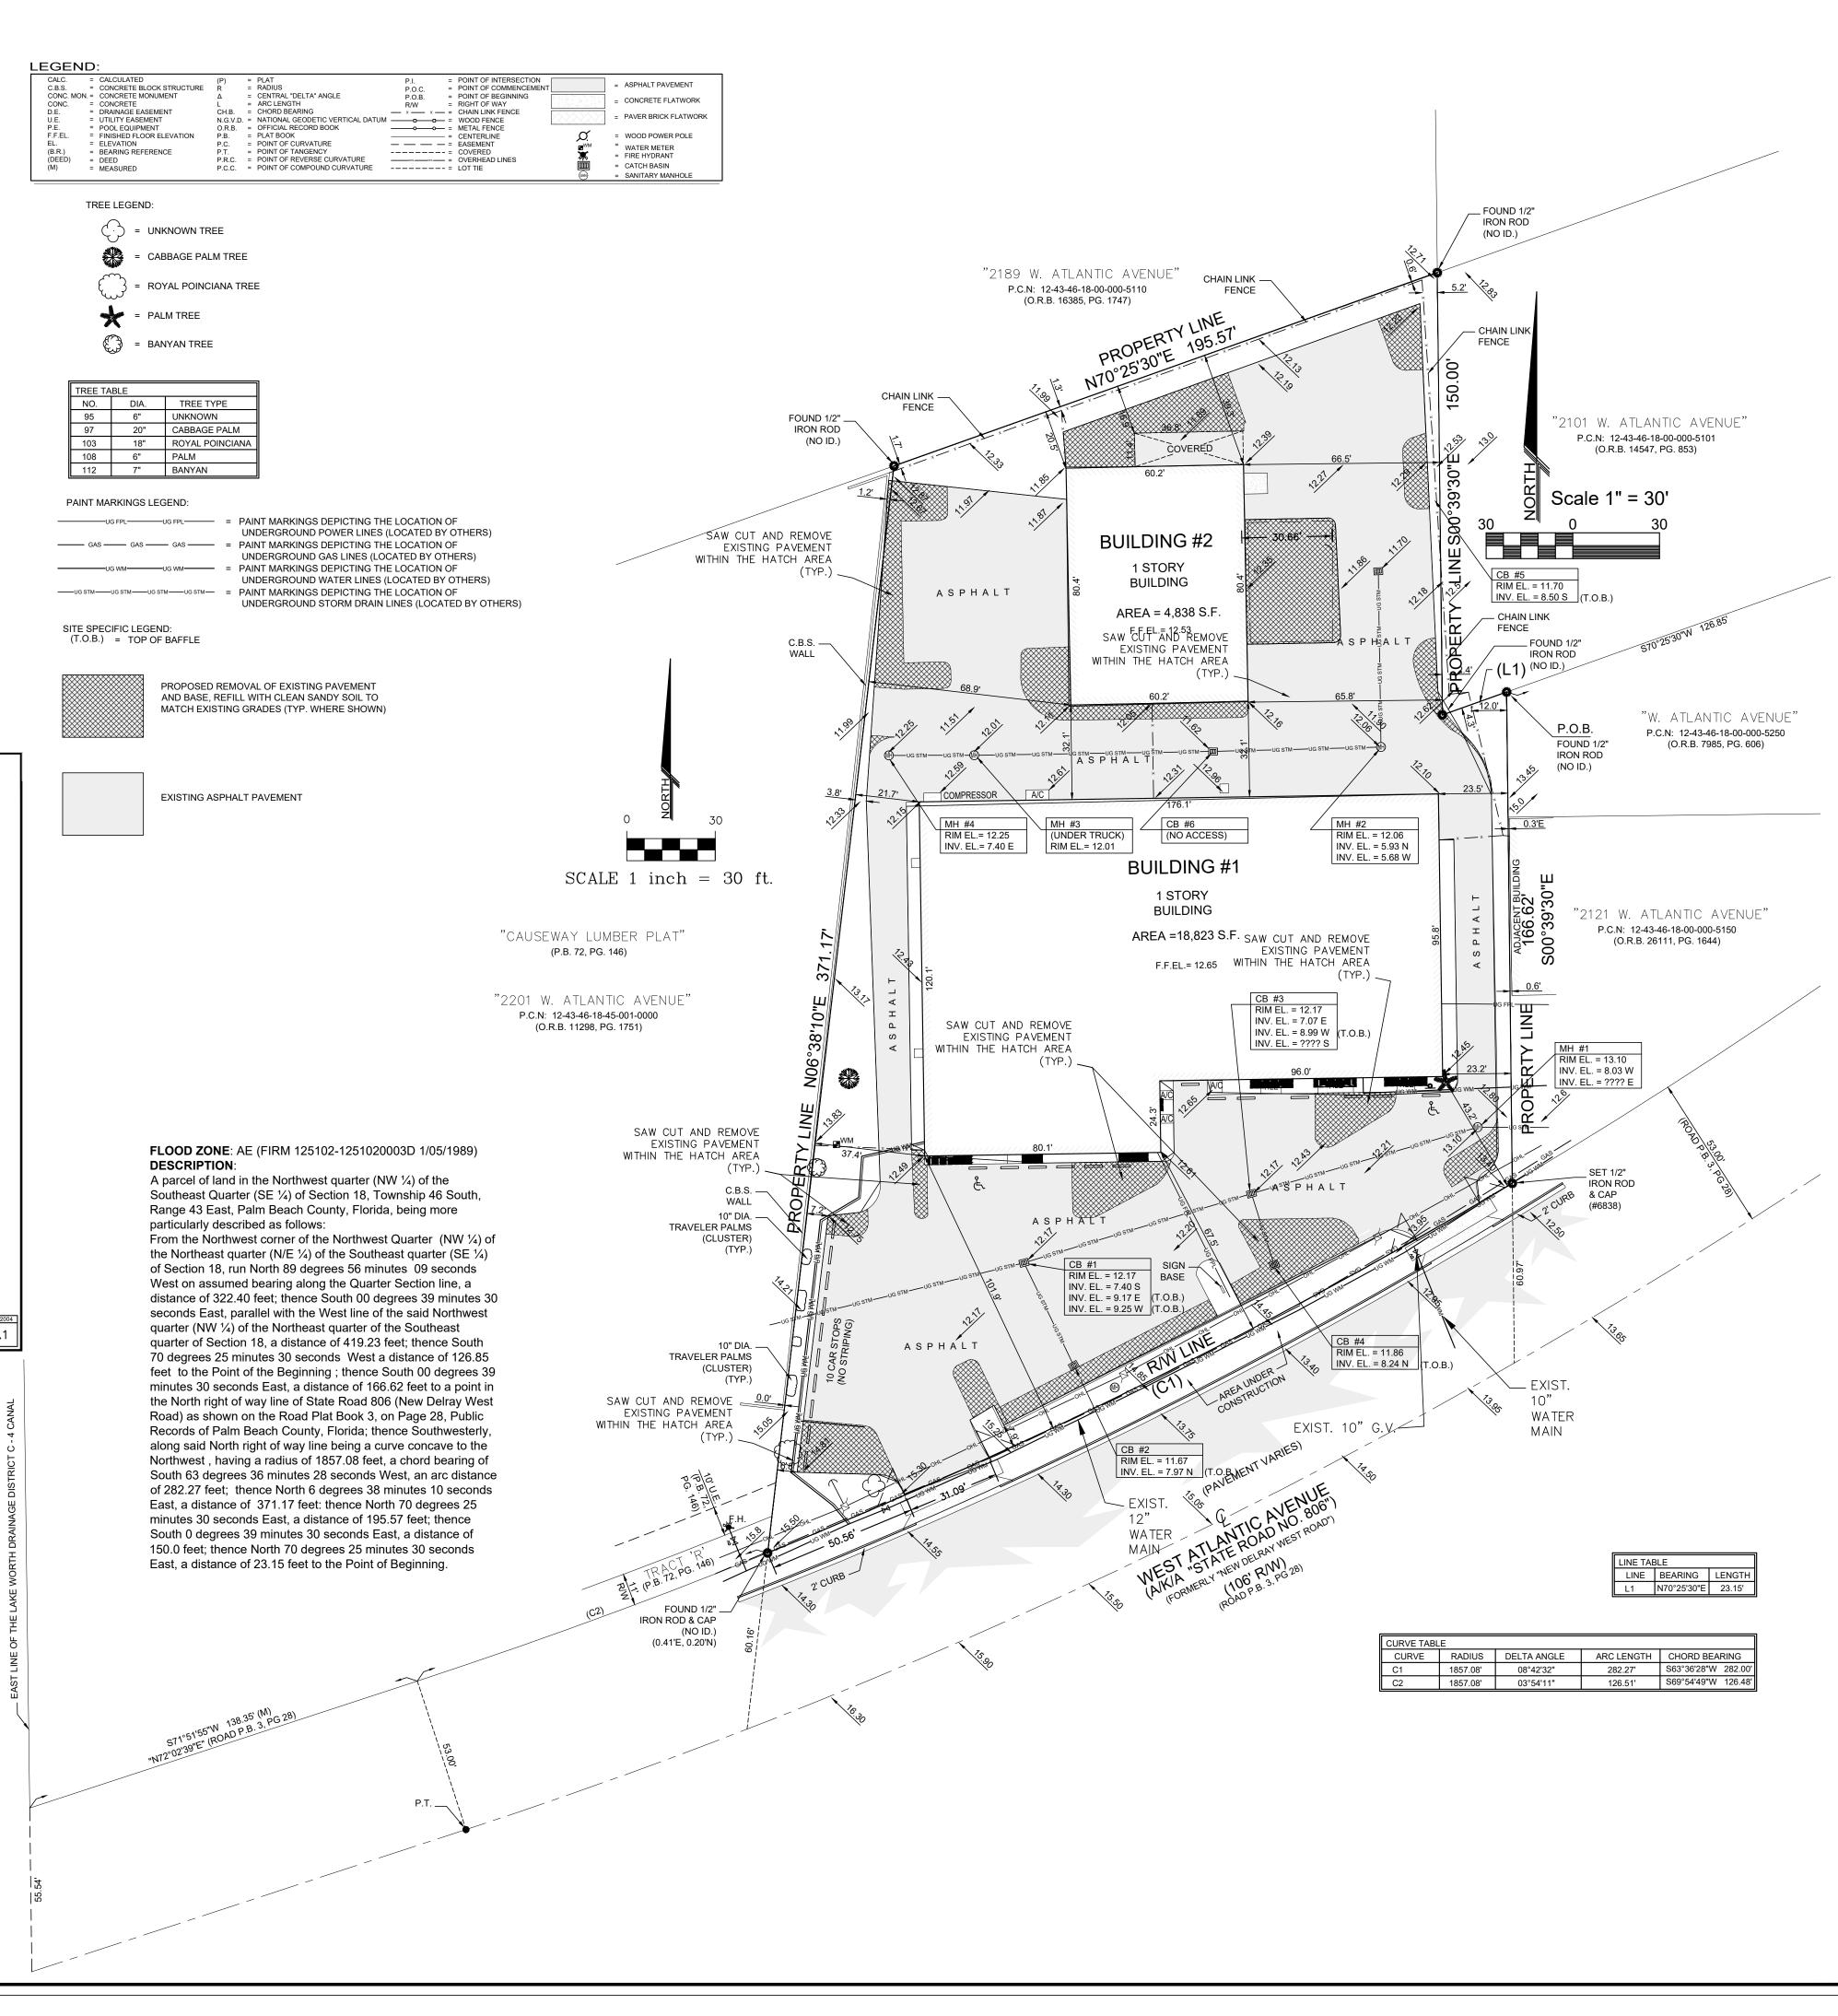

# Florida Consulting Engineers,



Certificate of Authorization No. 5810


134 N.W. 16TH STREET, SUITE 1
BOCA RATON , FLORIDA 33432

PHONE: (561) 353-1152
E-MAIL:
ZJ@FLCENGINEERS.COM

DATE REVISIONS

1-22-20 REVISED SITE PLAN

6-17-20 3RD REVIEW COMMENTS

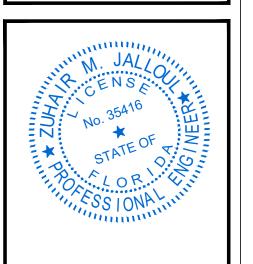

Zuhair M. Jalloul, P.E. Fl. License. No.: 35416

DATE JUNE 28. 2019

SCALE AS SHOWN

DWNG. BY P.E.S.

CHECKED BY Z. JALLOUL

PROJECT NO. 190502


DRAWING FILE ----

German Auto World Class III 2165 W. Atlantic Avenue Delray Beach, Florida

EXISTING SITE CONDITIONS, DEMOLITION PLAN AND EXISTING UTILITIES

SHEET NUMBER



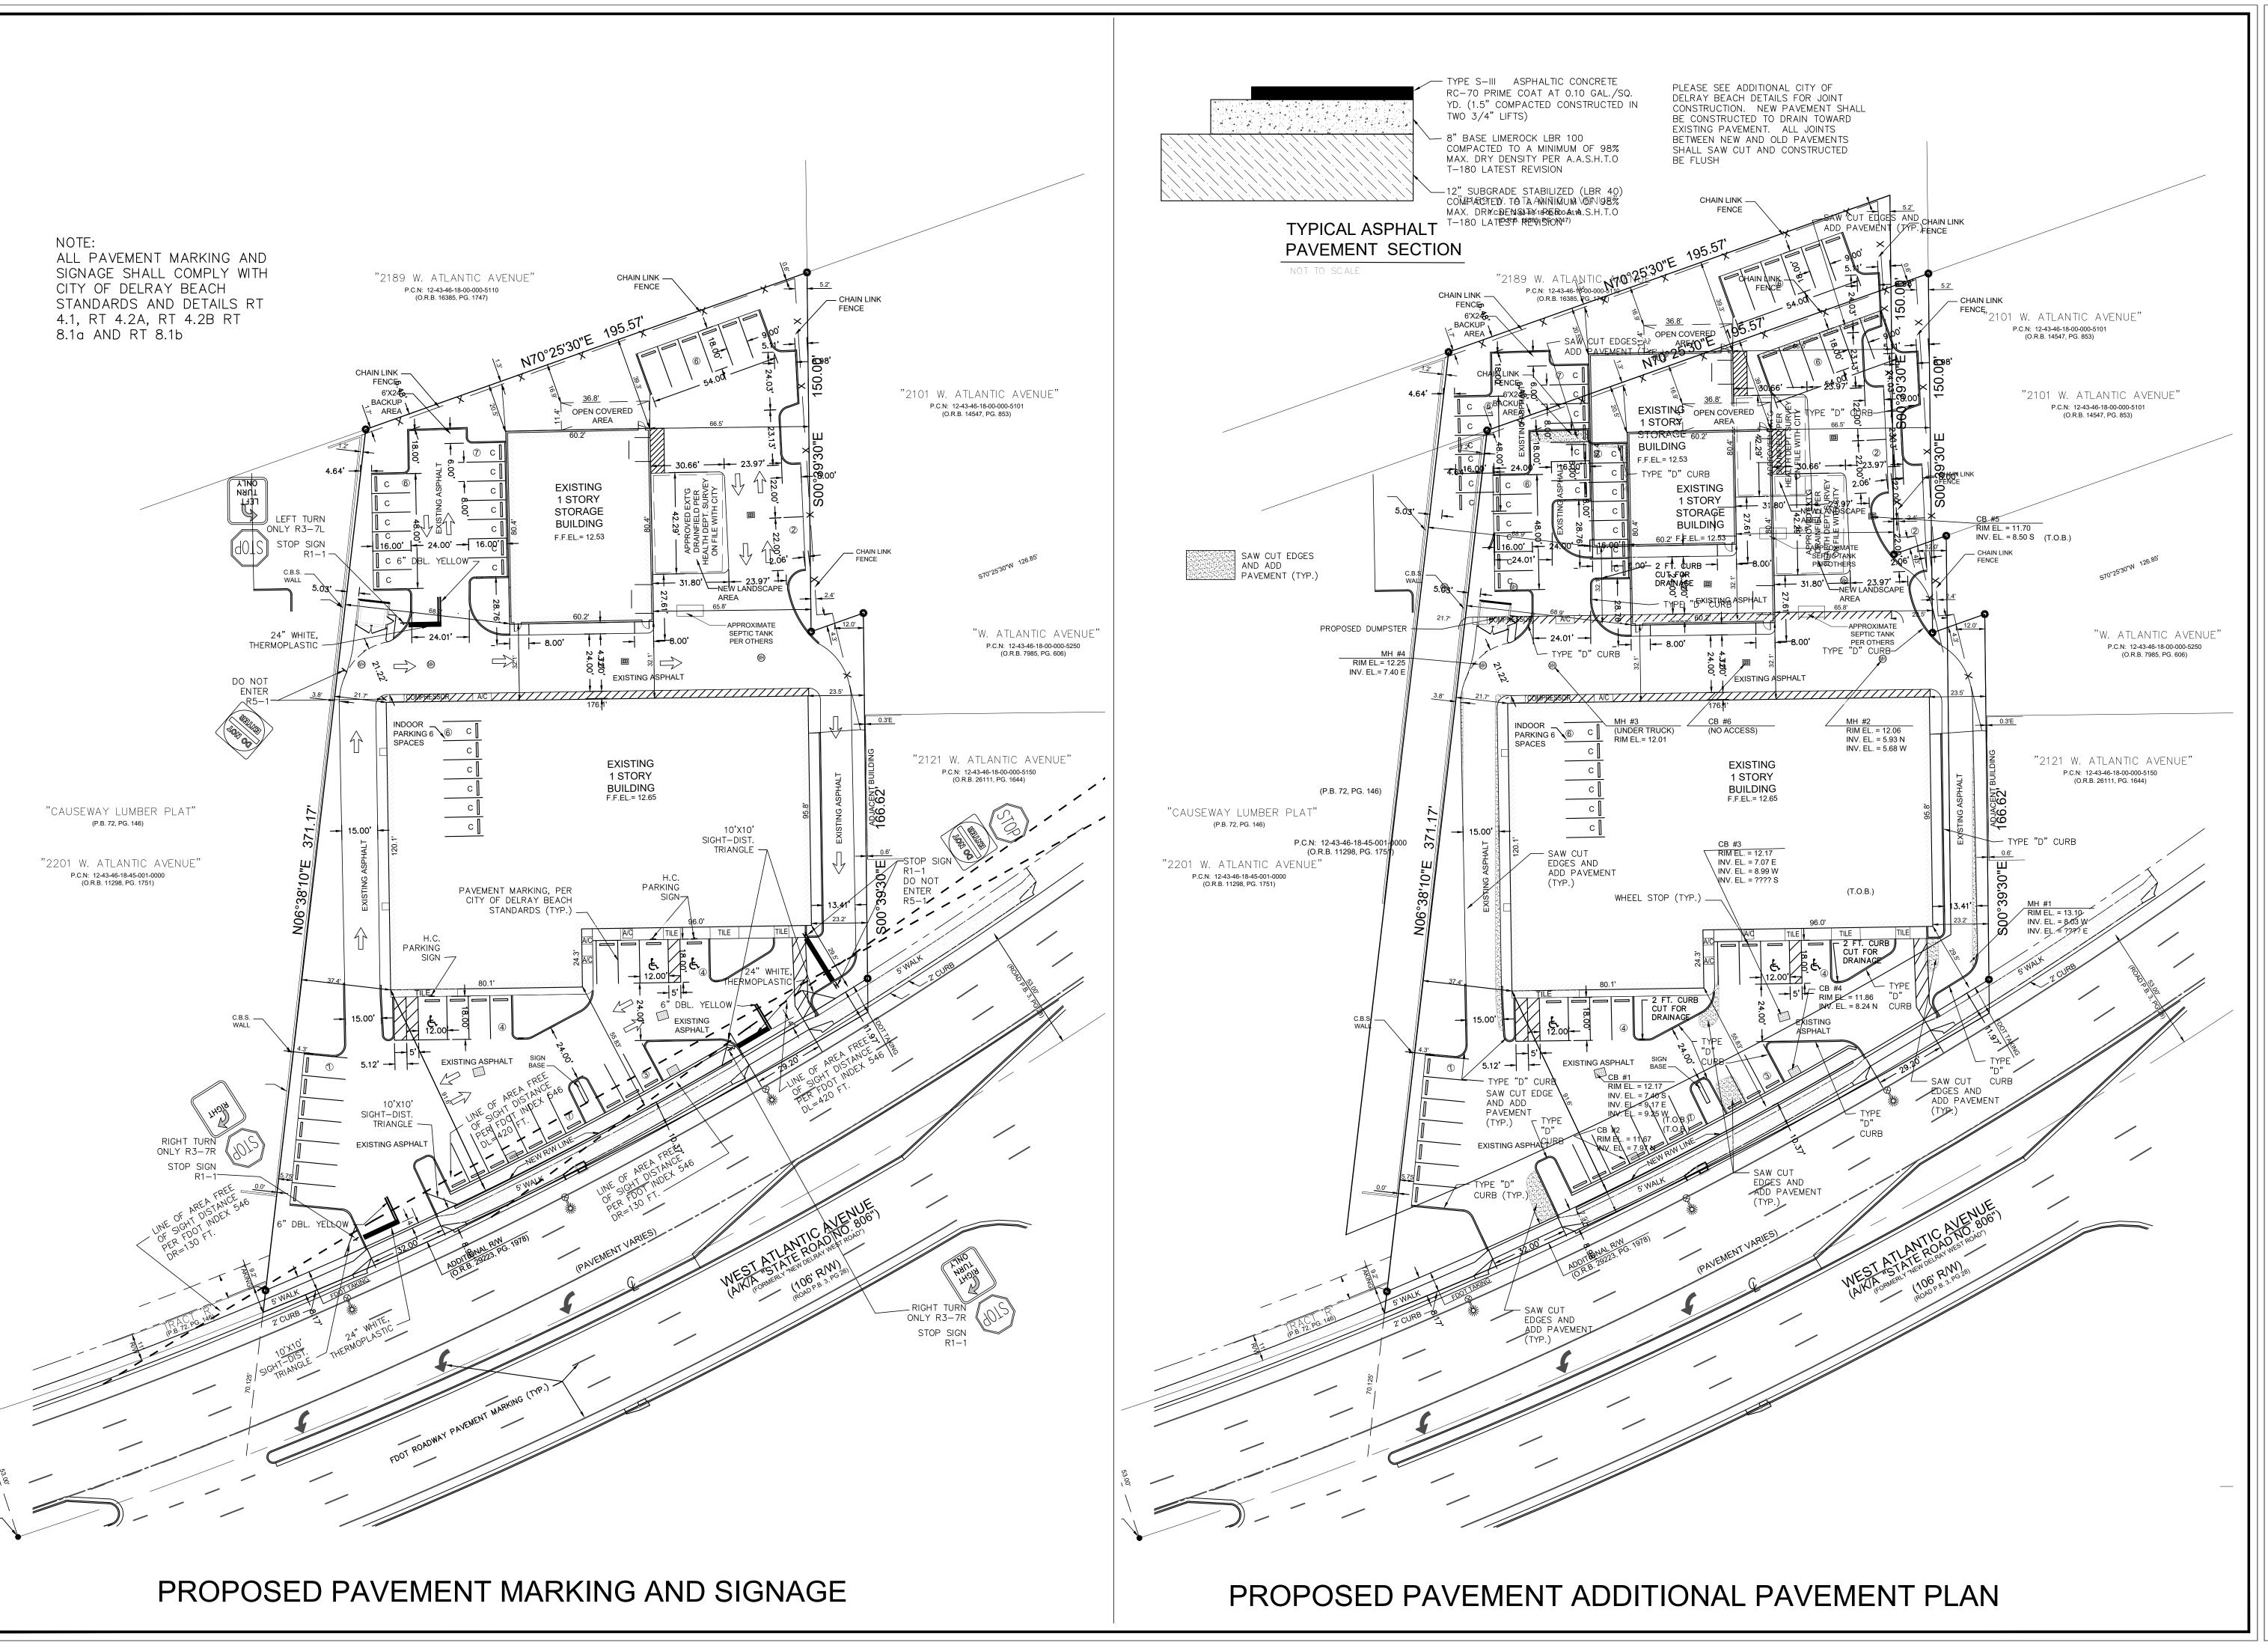

Florida
Consulting
Engineers,



Certificate of Authorization No. 5810

134 N.W. 16TH STREET, SUITE 1

BOCA RATON , FLORIDA 33432


PHONE: (561) 353-1152 E-MAIL: ZJ@FLCENGINEERS.COM

DATE REVISIONS

1-22-20 REVISED SITE PLAN

6-17-20 3RD REVIEW COMMENTS

6-17-20 4th Rev. Dumpster

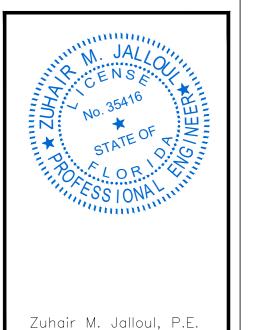

DATE JUNE 28. 2019

SCALE AS SHOWN

DWNG. BY P.E.S.

CHECKED BY Z. JALLOUL

PROJECT NO. 190502

DRAWING FILE ----


Fl. License. No.: 35416

German Auto World Class III 2165 W. Atlantic Avenue Delray Beach, Florida

PAVEMENT PLAN, PAVEMENT MARKING AND SIGNAGE

SHEET NUMBER

C-2

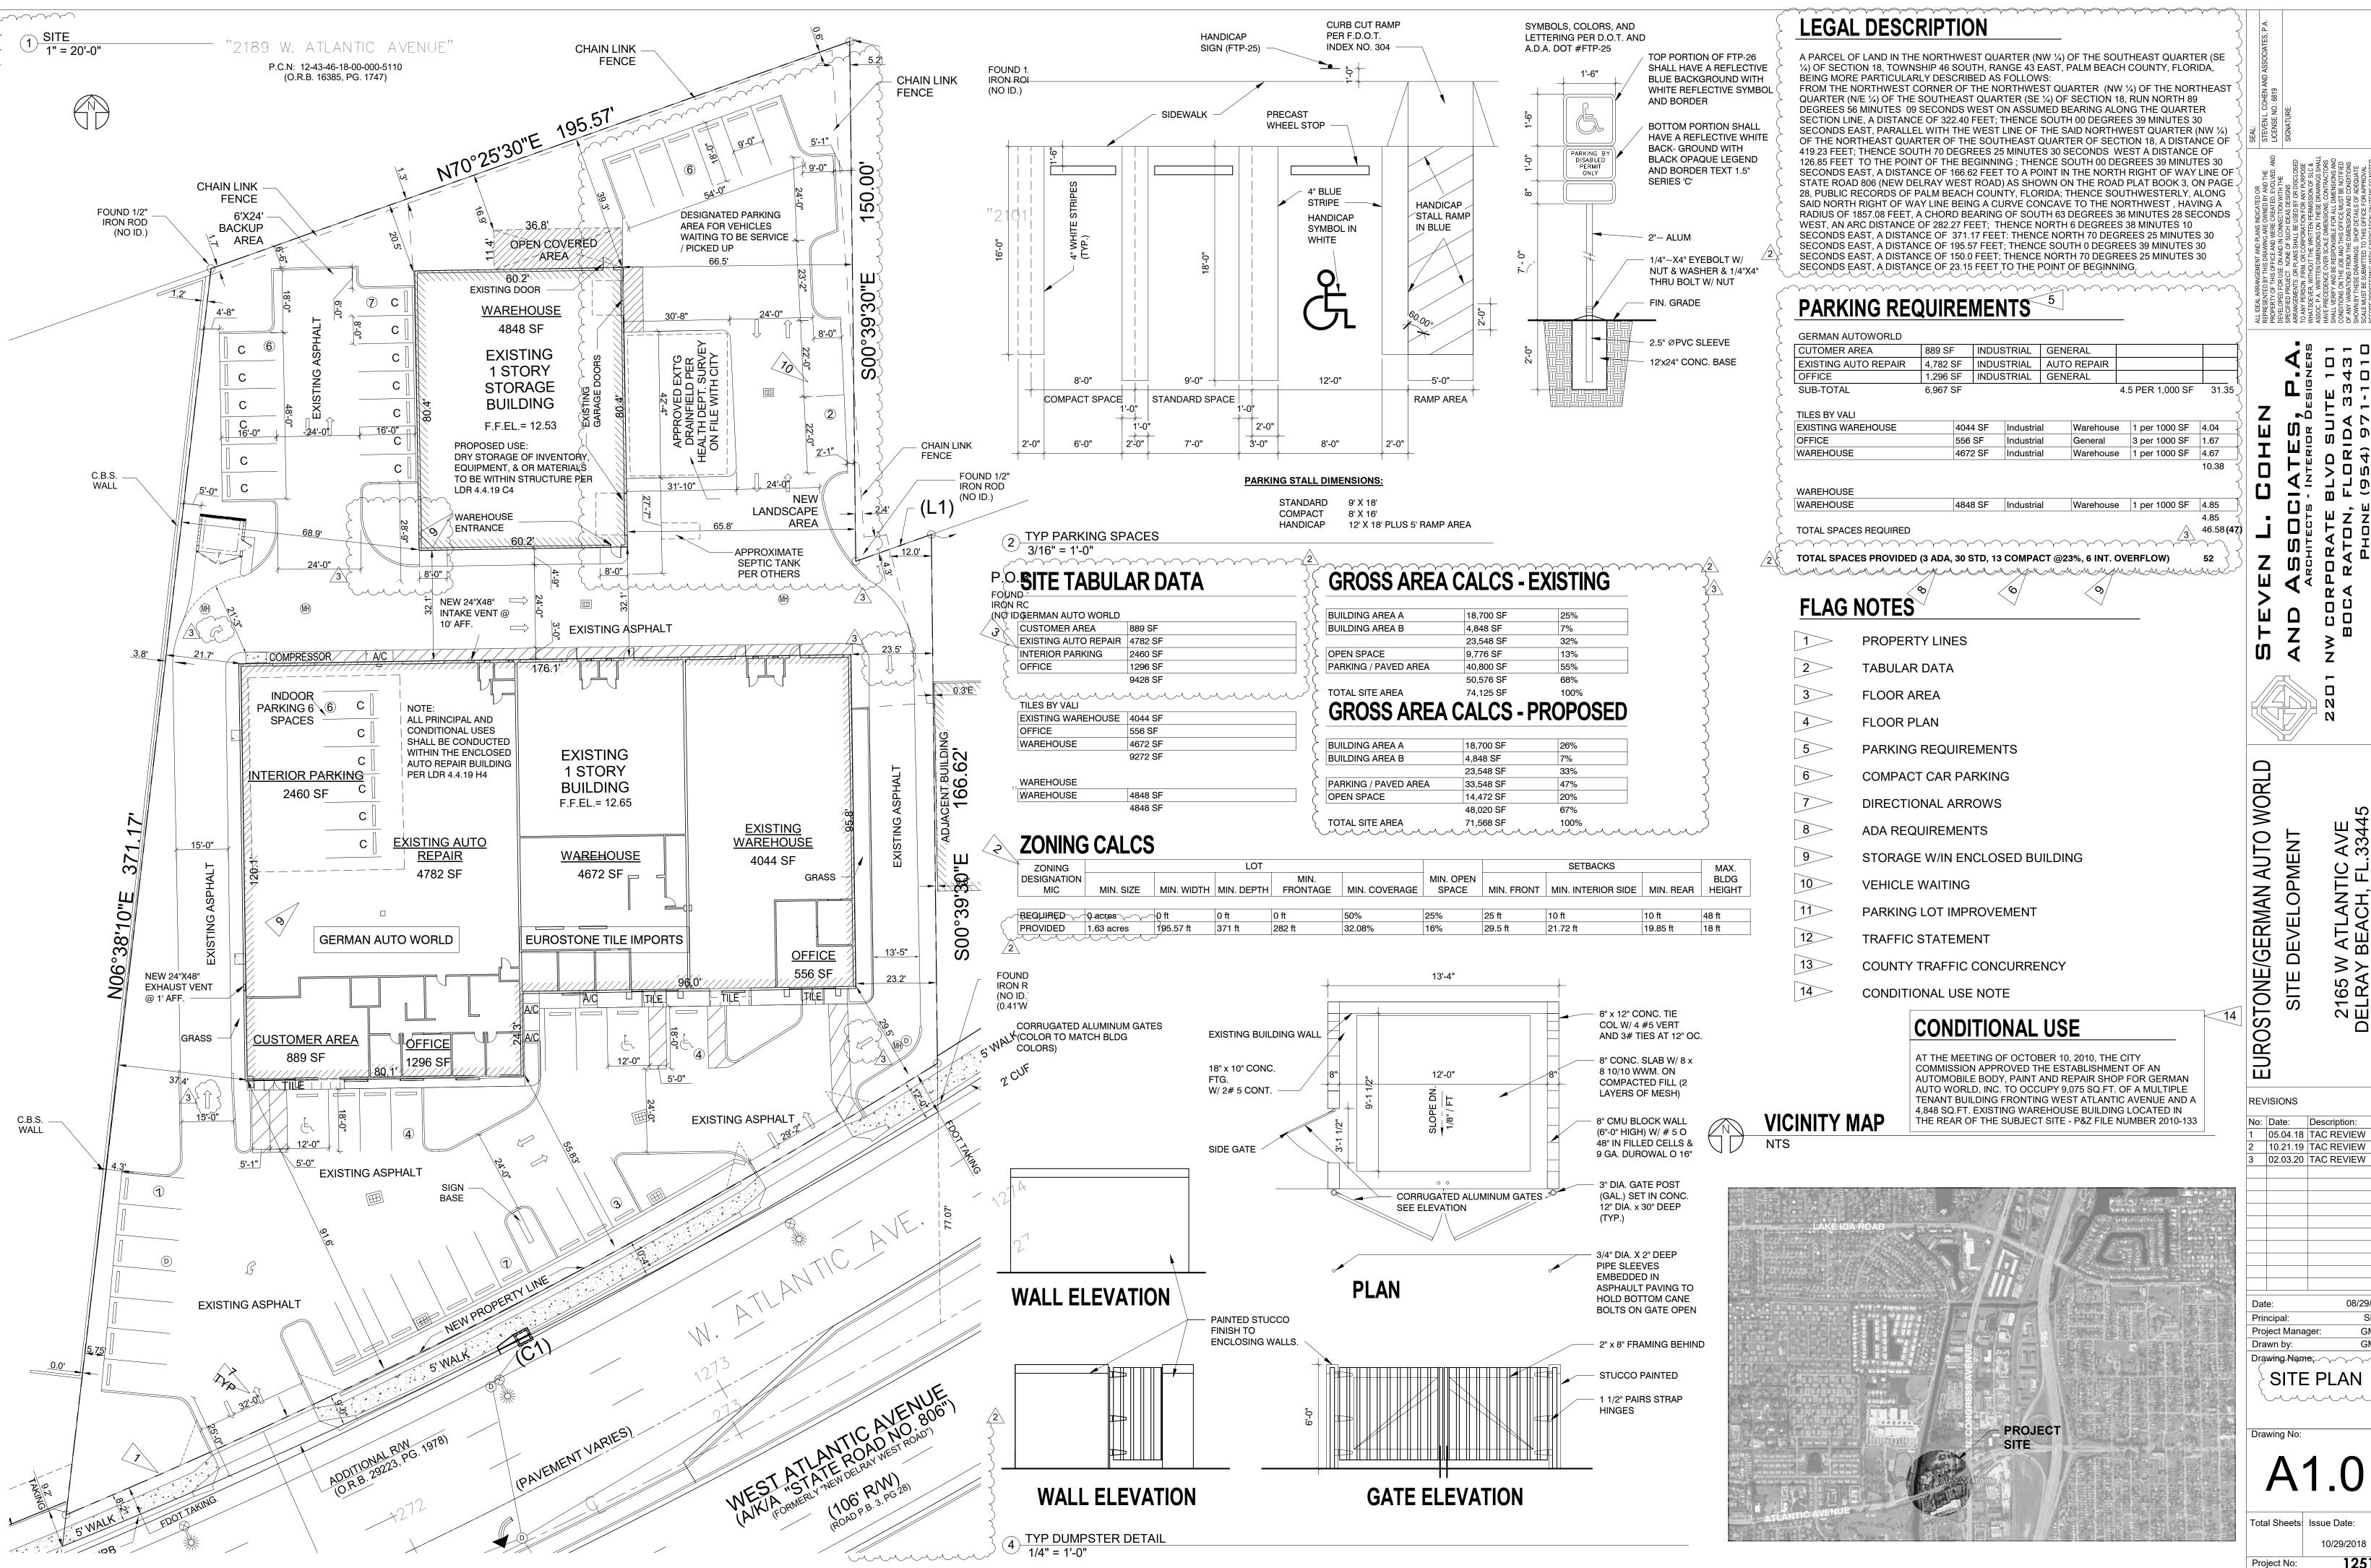

08/29/18 Principal: Project Manager: Drawn by: Drawing Name; /// SITE PLAN 

\_ m \_

/ ATLANTIC , BEACH, FL.

2165 W DELRAY I

Total Sheets: Issue Date: 10/29/2018

12518



6) NORTH ENTRY FRONTAGE



3) REAR ACCESS DRIVEWAY



1) SOUTH CORNER - ENTRY ONE



2) ATLANTIC AVE FRONTAGE - SIGNAGE ISLAND



4) SOUTH CORNER - ENTRY / REAR ACCESS DRIVE 1" = 30'-0"





7) GERMAN AUTO WORLD LANDSCAPING STIIP



8) EUROSTONE TILE LANDSCAPING STRIP

EUROSTONE/GERMAN AUTO N SITE DEVELOPMENT 2165 W ATLANTIC DELRAY BEACH, FL

REVISIONS: No: Date: Description:


01/21/19 Project Manager: Drawn by:

Drawing Name: SITE PHOTOS

Total Sheets: Issue Date:

Project No:

12518

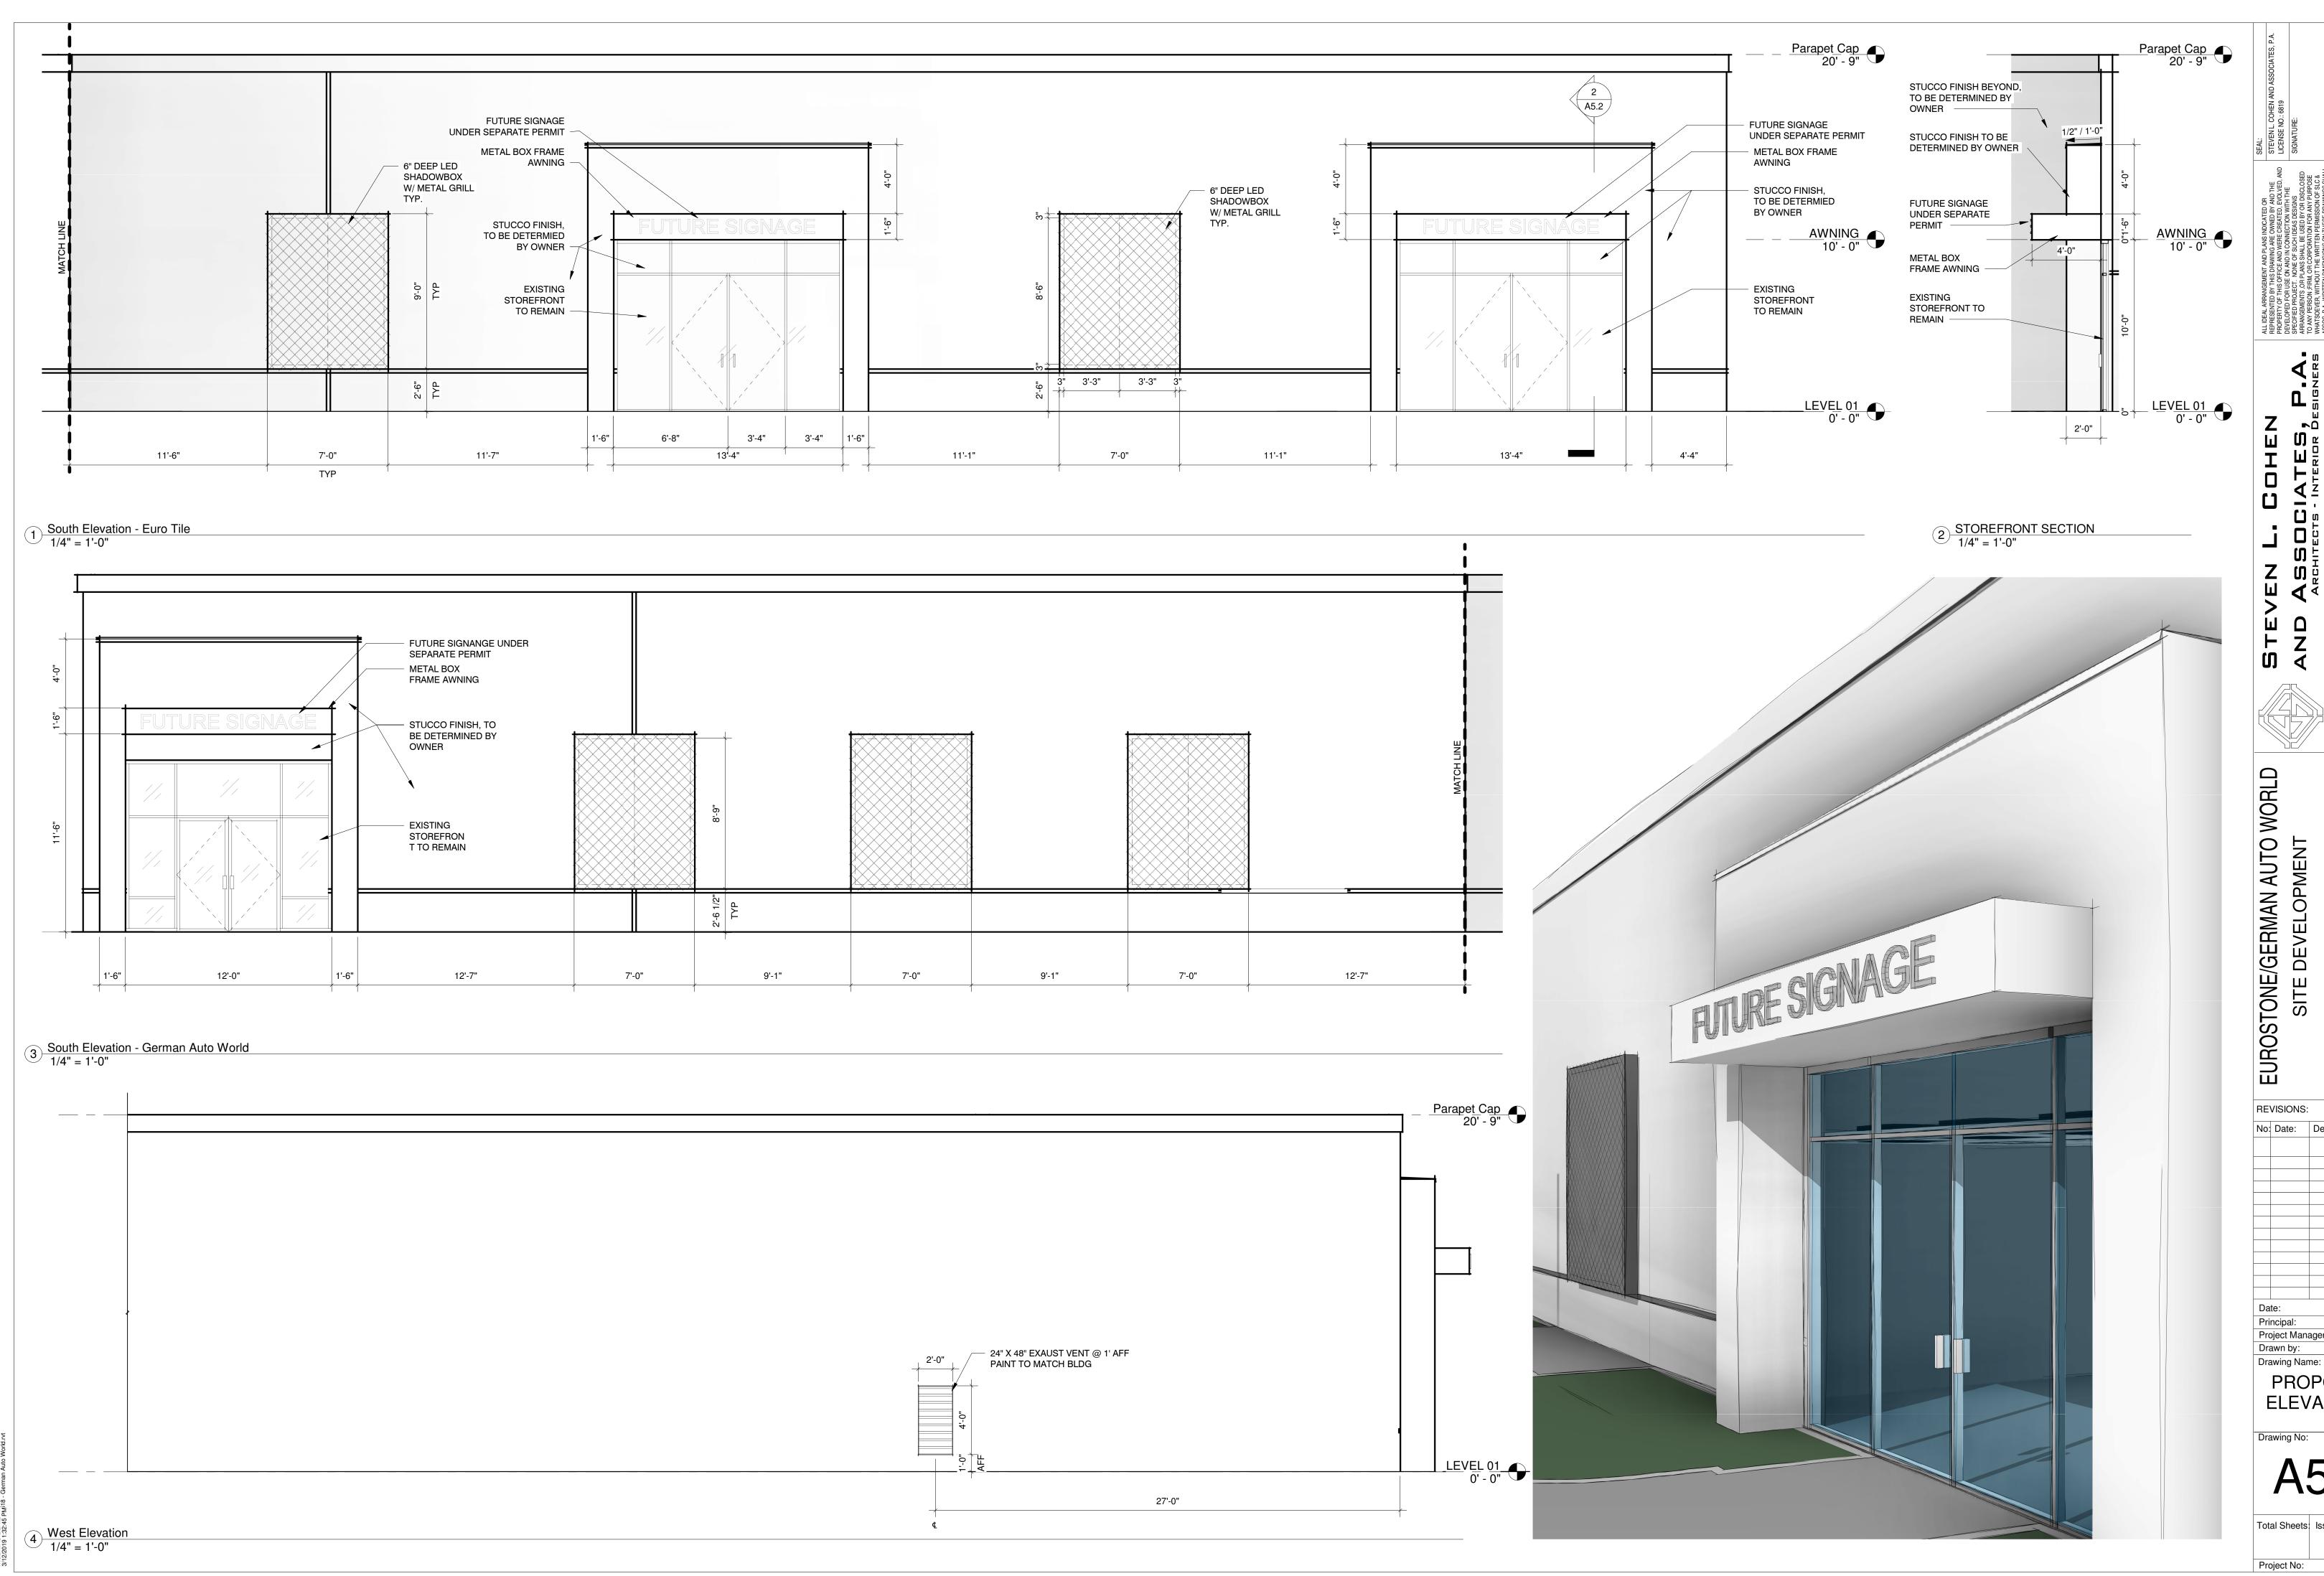

T E

2165 W ATLANTIC DELRAY BEACH, FL

No: Date: Description:

07/10/2018 GMB Project Manager:

PROPOSED **ELEVATIONS** 

Total Sheets: Issue Date: 10/29/2018

12518



South Elevation - German Auto World

1/4" = 1'-0"



3 West Elevation 1/4" = 1'-0"



EUROSTONE/GERMAN AUTO WORLD SITE DEVELOPMENT 2165 W ATLANTIC AVE DELRAY BEACH, FL.33445

REVISIONS:

No: Date: Description: 01/17/19 Principal:

SLC GMB GMB Project Manager:
Drawn by:
Drawing Name:


COLORED ELEVATIONS


Drawing No:


A5.3

Total Sheets: Issue Date: 10/29/2018

12518 Project No:

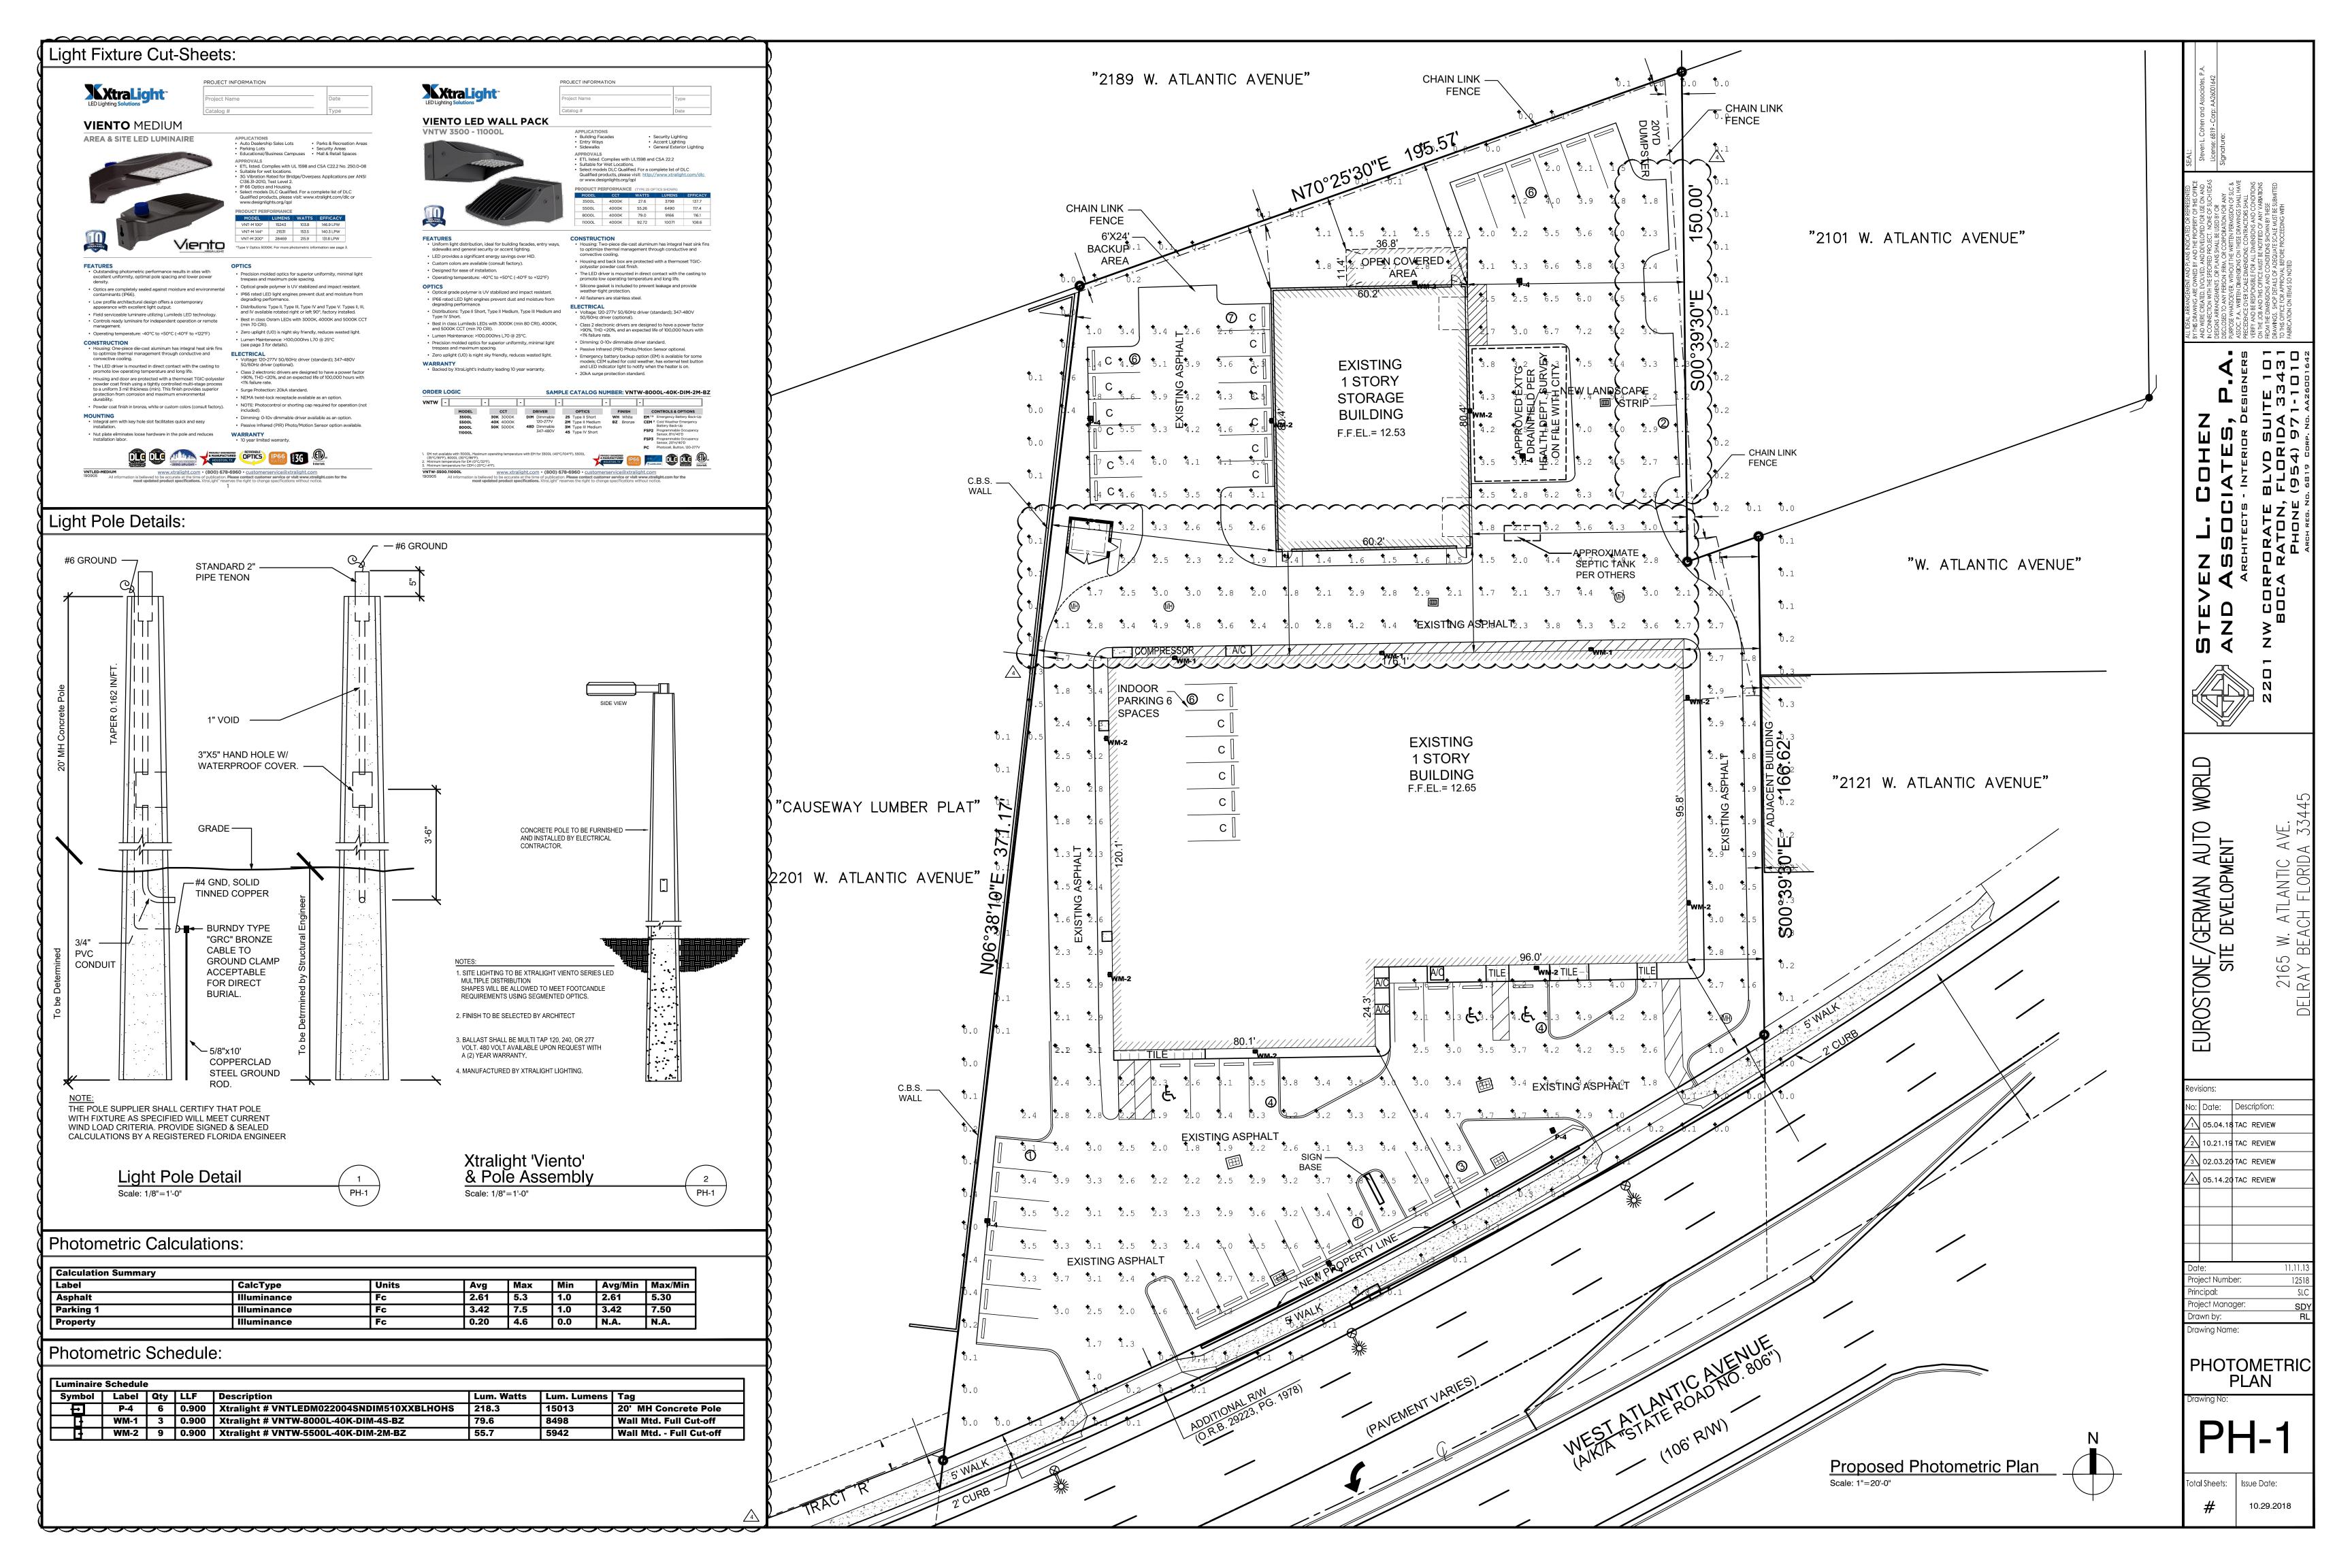

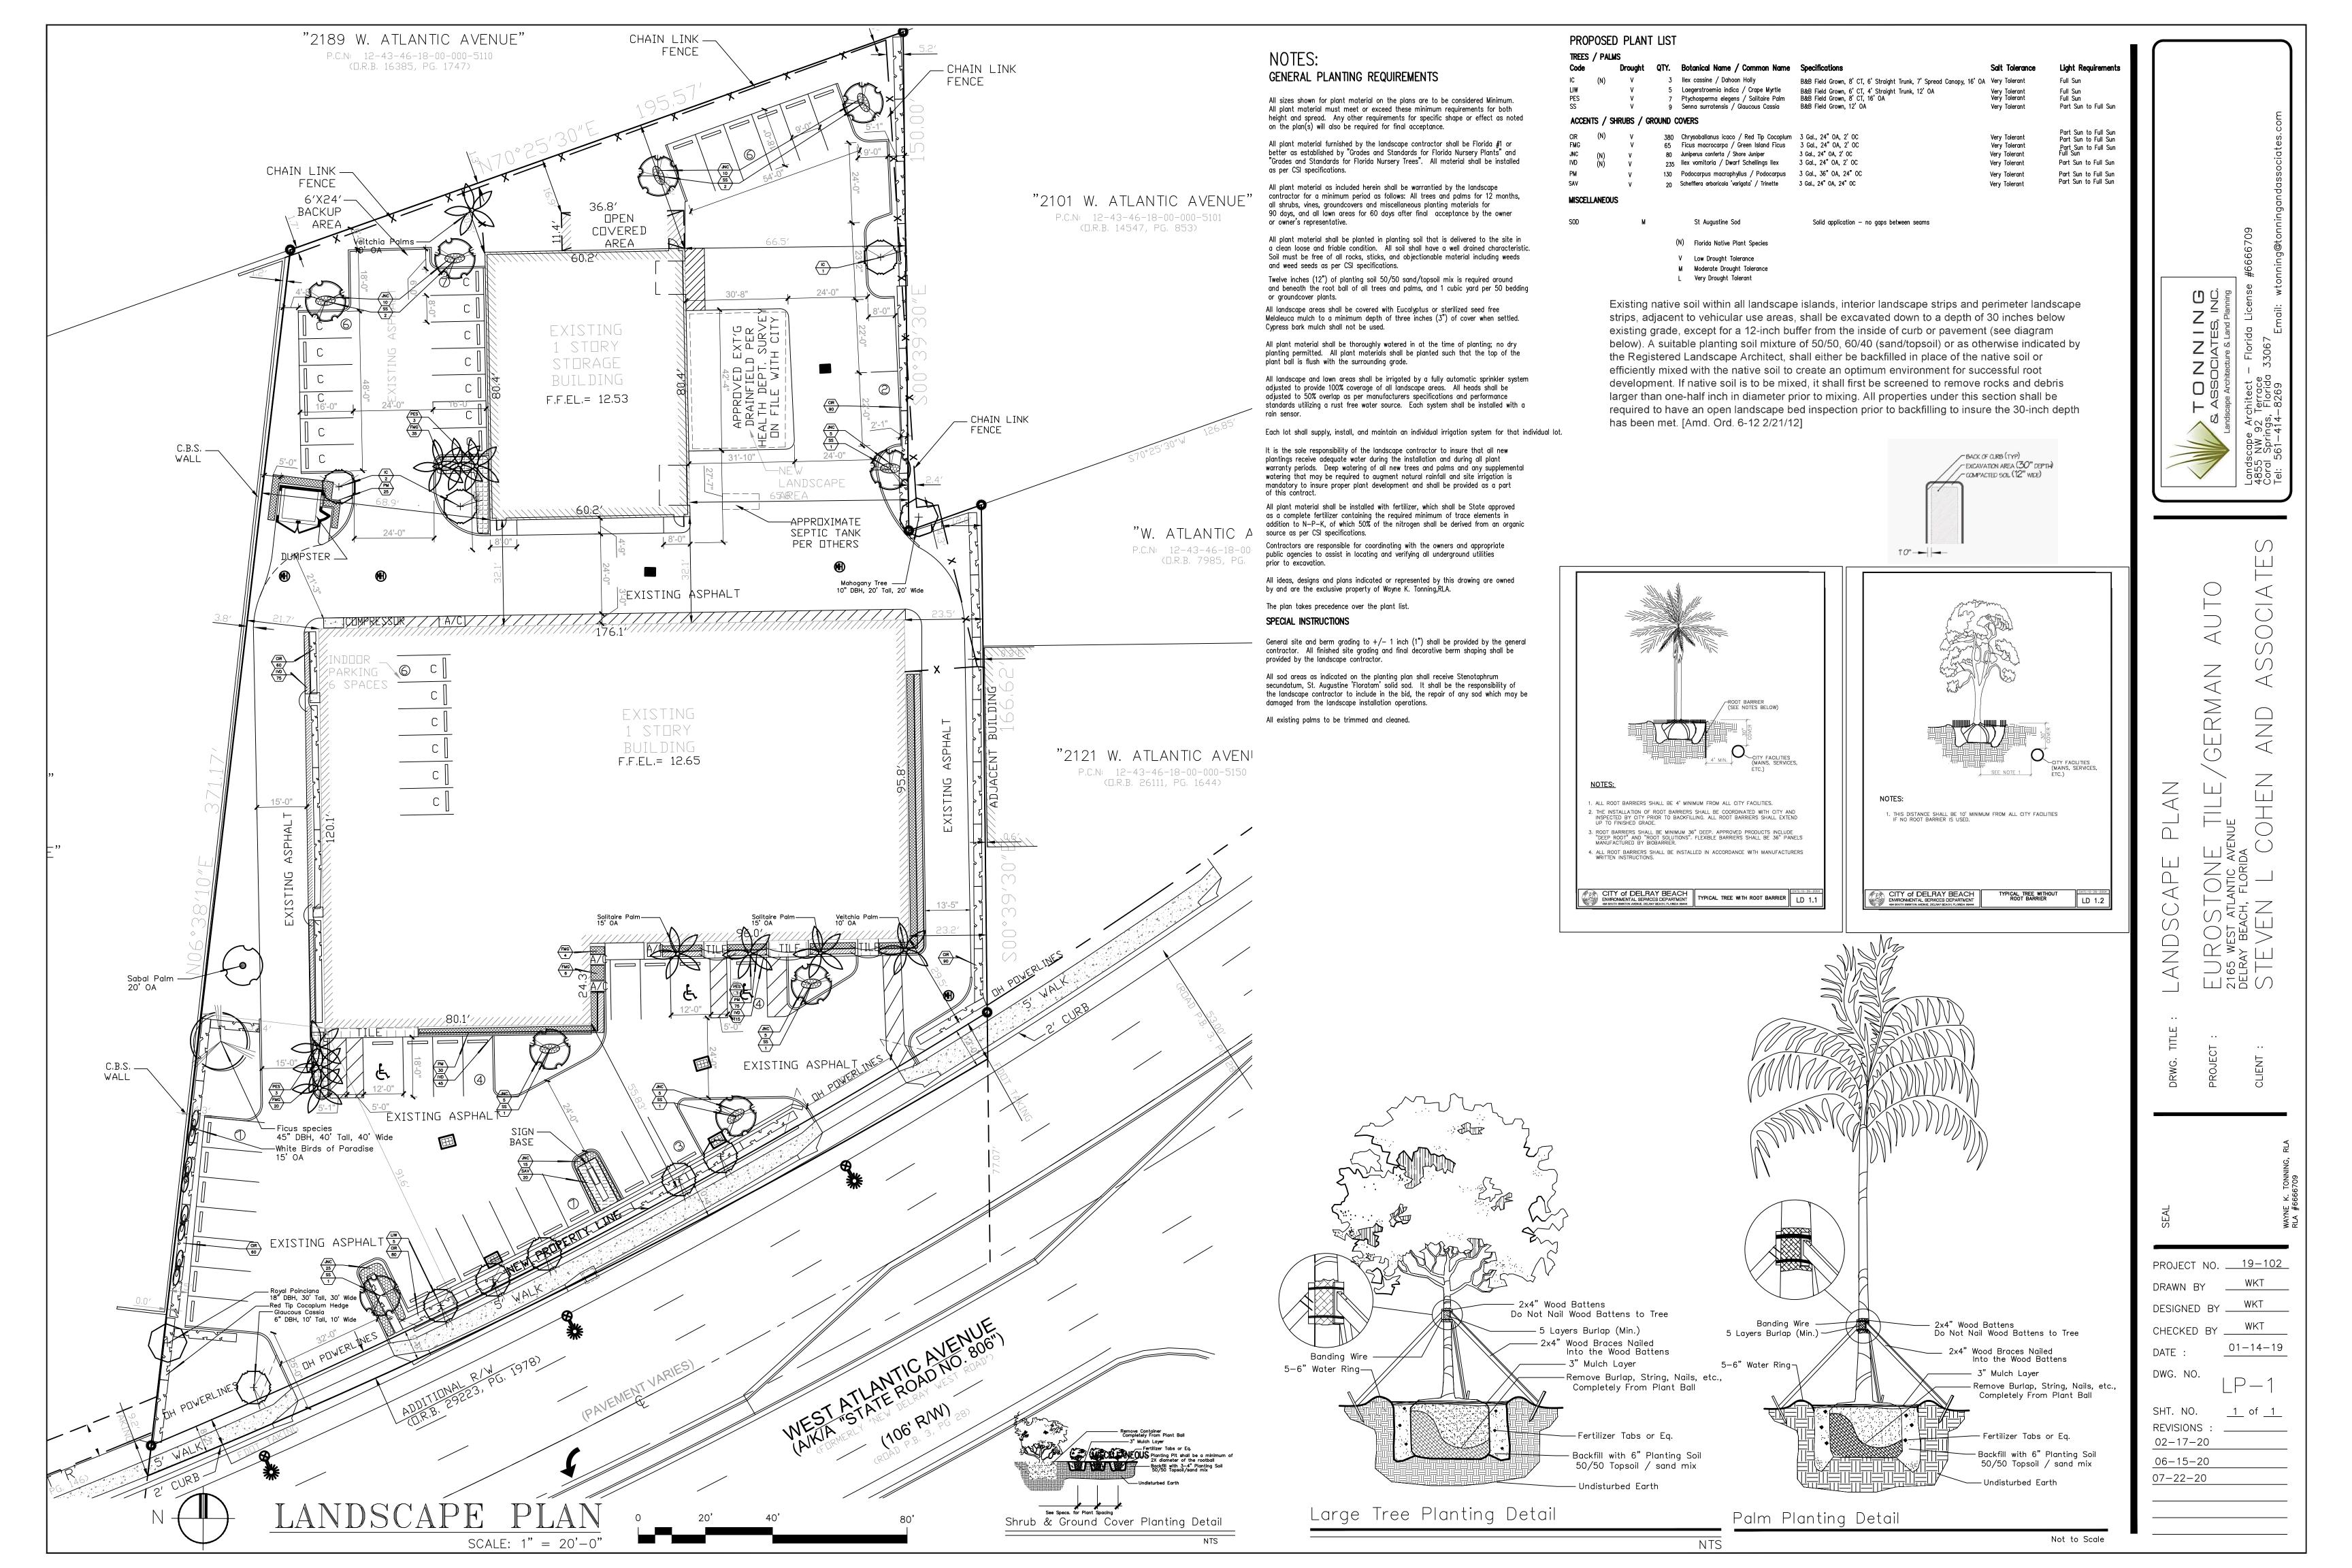

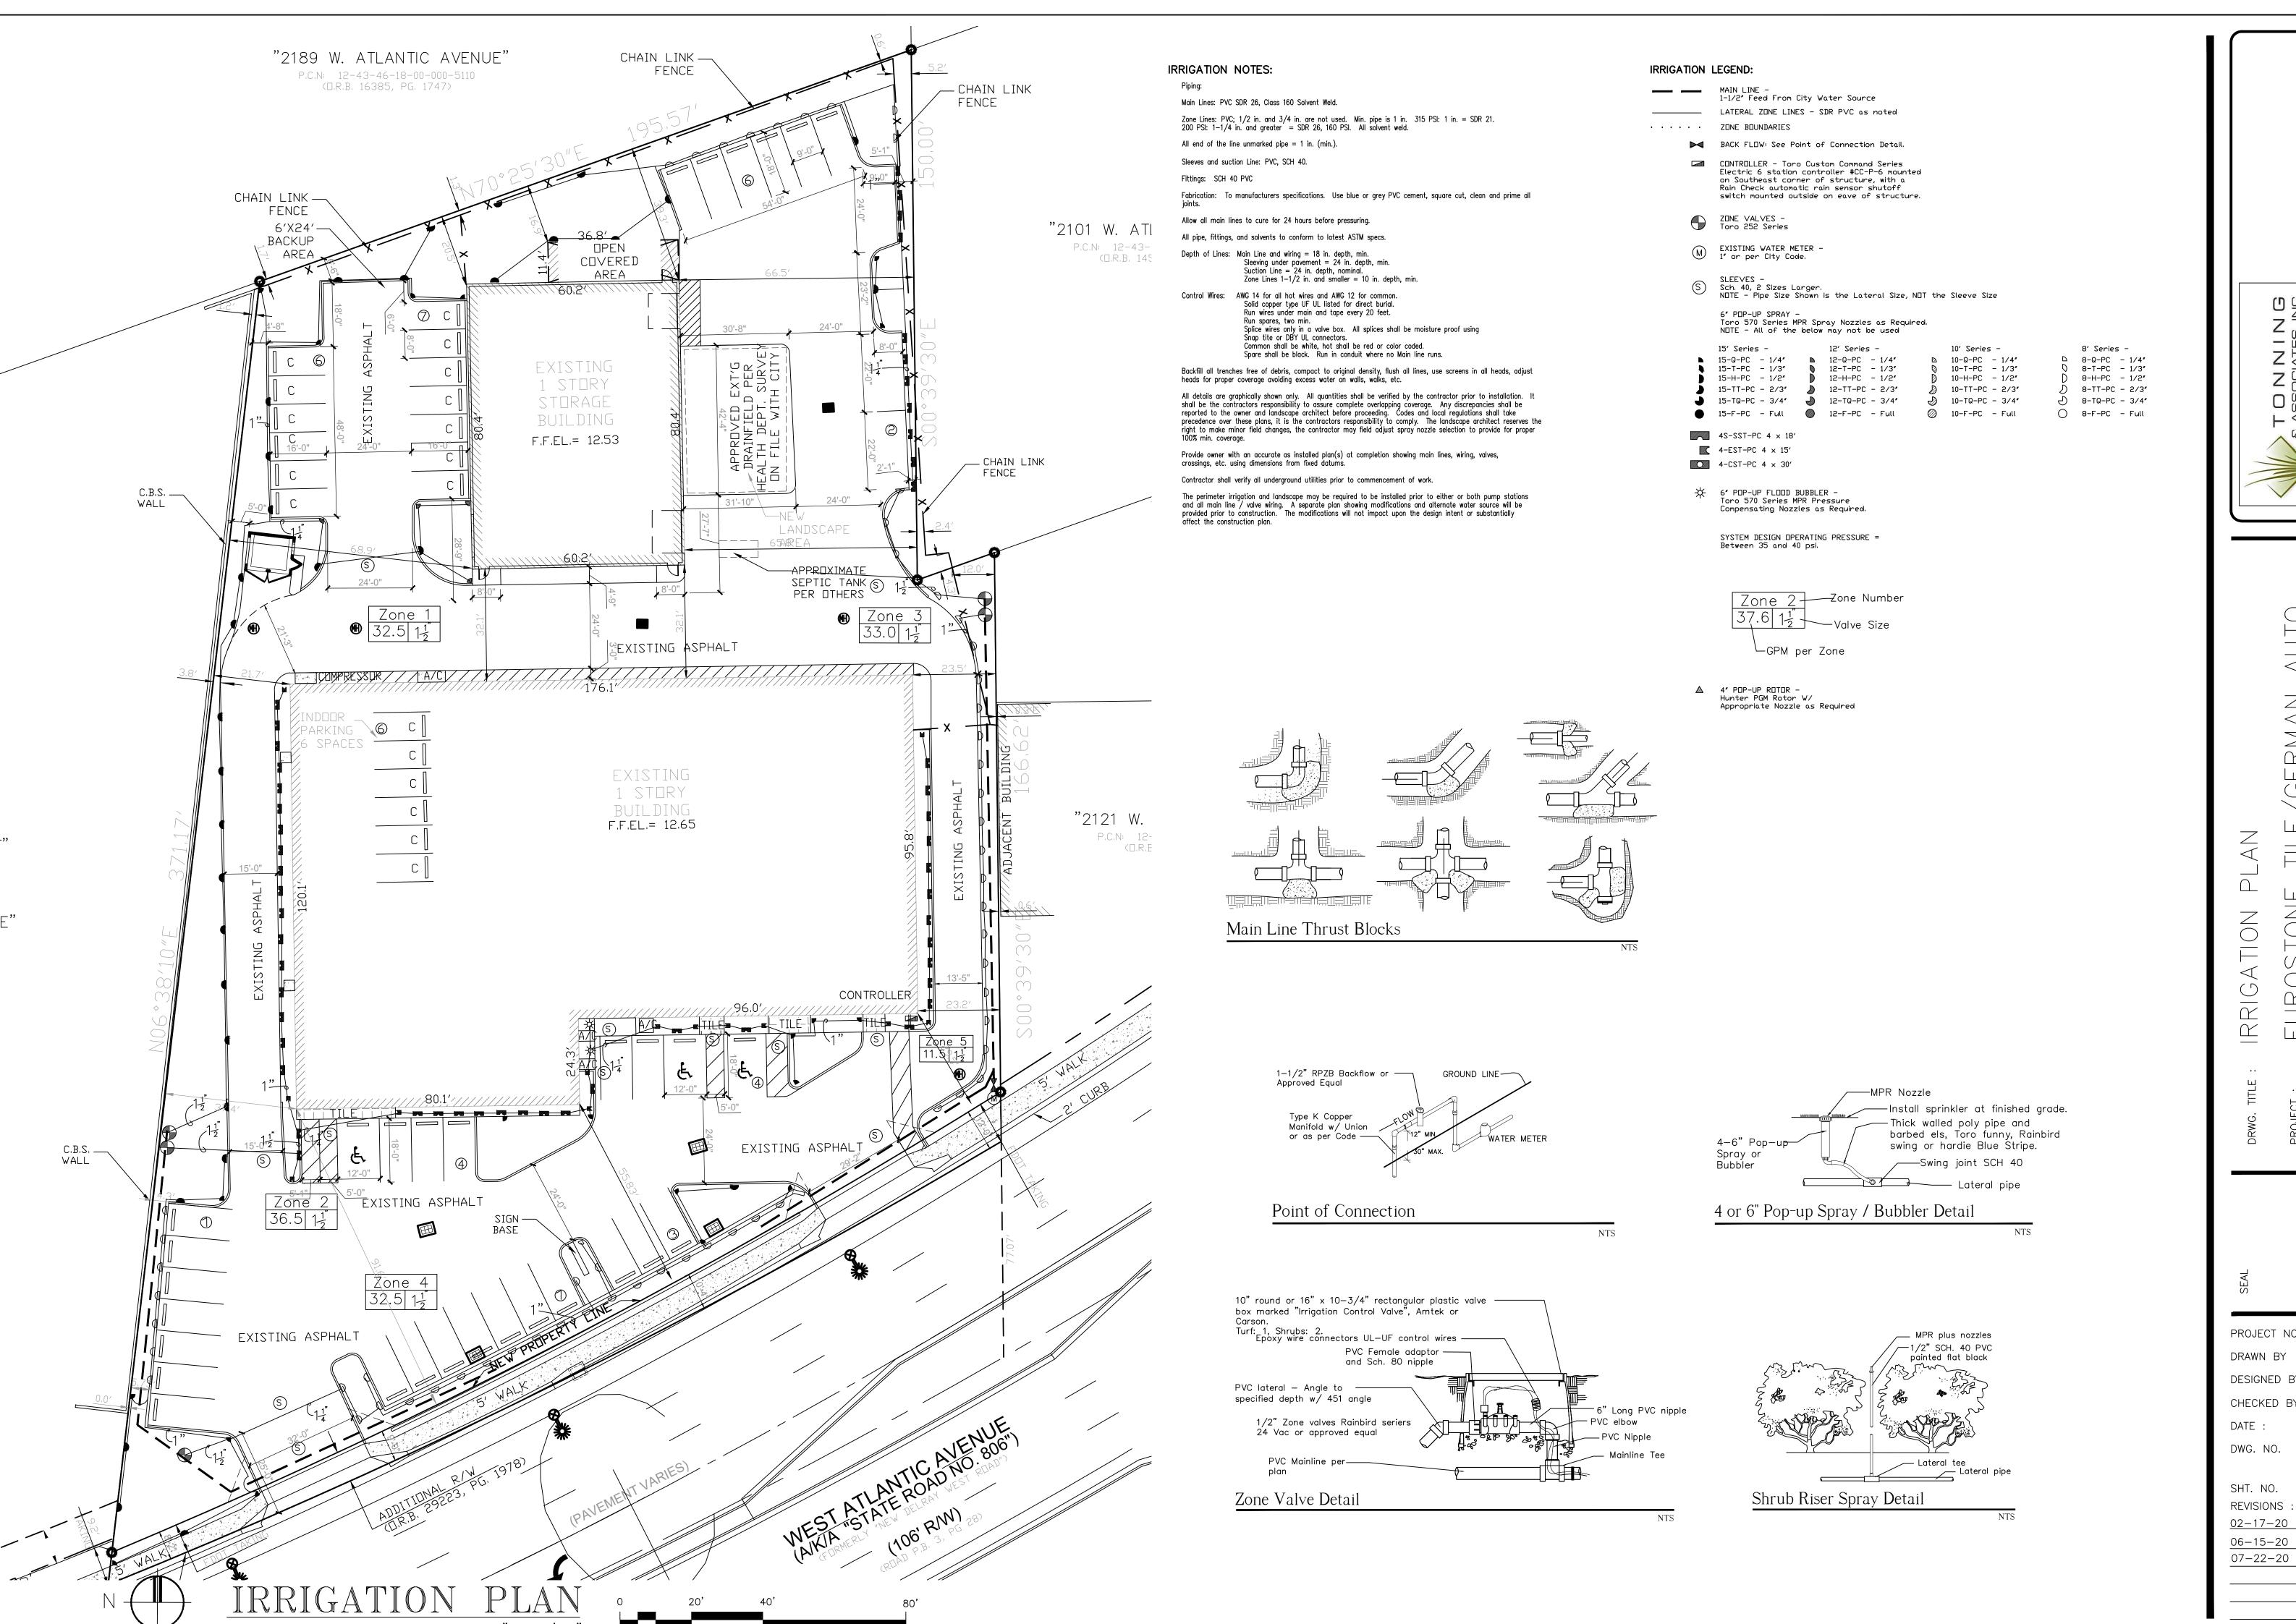

 $\triangleleft$ () $\bigcirc$ N B21 C

PROJECT NO. <u>19-102</u> DESIGNED BY

01-14-19 DATE DWG. NO.

REVISIONS 02-17-20