

GENERAL NOTES:

CONTRACTOR IS RESPONSIBLE FOR COMPLIANCE WITH THE NOTES AND SPECIFICATIONS CONTAINED HEREIN. CONTRACTOR IS RESPONSIBLE TO ENSURE THAT ALL SUBCONTRACTORS FULLY AND COMPLETELY CONFORM TO AND COMPLY WITH THESE REQUIREMENTS.

1. THE FOLLOWING DOCUMENTS ARE INCORPORATED BY REFERENCE AS PART OF THIS SITE PLAN:

SURVEY - SKETCH OF BOUNDARY SURVEY, 302 ATLANTIC AVENUE, PREPARED BY BROWN & PHILLIPS, INC. DATED SEPTEMBER 2018

PRIOR TO THE START OF CONSTRUCTION, THE CONTRACTOR MUST VERIFY THAT HE/SHE HAS THE LATEST EDITION OF THE DOCUMENTS REFERENCED ABOVE. THIS IS CONTRACTOR'S RESPONSIBILITY.

2. PRIOR TO STARTING CONSTRUCTION, THE CONTRACTOR IS RESPONSIBLE TO ENSURE THAT ALL REQUIRED PERMITS AND APPROVALS HAVE BEEN OBTAINED. NO CONSTRUCTION OR FABRICATION SHALL BEGIN UNTIL THE CONTRACTOR HAS RECEIVED AND THOROUGHLY REVIEWED THE COMMENTS TO ALL PLANS AND OTHER DOCUMENTS REVIEWED AND APPROVED BY THE PERMITTING AUTHORITIES AND CONFIRMED THAT ALL NECESSARY OR REQUIRED PERMITS HAVE BEEN OBTAINED. CONTRACTOR MUST HAVE COPIES OF ALL PERMITS AND APPROVALS ON SITE AT ALL TIMES.

3. THE CONTRACTOR MUST BE FAMILIAR WITH AND RESPONSIBLE FOR THE PROCUREMENT OF ANY AND ALL CERTIFICATIONS REQUIRED FOR THE ISSUANCE OF A CERTIFICATE OF OCCUPANCY.

4. ALL WORK MUST BE PERFORMED IN ACCORDANCE WITH THESE PLANS, SPECIFICATIONS, AND CONDITIONS OF APPROVAL, AND ALL APPLICABLE REQUIREMENTS, RULES, REGULATIONS, STATUTORY REQUIREMENTS, CODES, LAWS AND STANDARDS OF ALL GOVERNMENTAL ENTITIES WITH JURISDICTION OVER THIS PROJECT.

5. THE GEOTECHNICAL REPORT, TECHNICAL SPECIFICATIONS, AND RECOMMENDATIONS SET FORTH HEREIN ARE A PART OF THE REQUIRED CONSTRUCTION DOCUMENTS. CONTRACTOR IS RESPONSIBLE FOR THE ISSUANCE OF A CERTIFICATE OF OCCUPANCY. THE MORE STRINGENT REQUIREMENTS CONTAINED IN THE PLANS, SPECIFICATIONS, AND CONDITIONS OF APPROVAL, AND RECOMMENDATIONS SHALL TAKE PRIORITY UNLESS SPECIFICALLY NOTED. OTHERWISE, ON THE PLANS, THE CONTRACTOR MUST NOTIFY THE ENGINEER, IN WRITING, OF ANY SUCH CONFLICT, DISCREPANCY OR AMBIGUITY BETWEEN THE GEOTECHNICAL REPORTS, TECHNICAL SPECIFICATIONS AND PLANS PRIOR TO PROCEEDING WITH ANY FURTHER WORK.

6. THESE PLANS ARE BASED ON INFORMATION PROVIDED TO BOHLER ENGINEERING BY THE OWNER AND OTHERS PRIOR TO THE TIME OF PLAN PREPARATION. CONTRACTOR MUST FIELD VERIFY EXISTING CONDITIONS AND NOTIFY BOHLER ENGINEERING, IN WRITING, IMMEDIATELY IF ACTUAL SITE CONDITIONS DIFFER FROM THOSE SHOWN ON THE PLAN, OR IF THE PROPOSED WORK CONFLICTS WITH ANY OTHER SITE FEATURES.

7. ALL DIMENSIONS SHOWN ON THE PLANS MUST BE FIELD VERIFIED BY THE CONTRACTOR PRIOR TO THE START OF CONSTRUCTION. CONTRACTOR IS RESPONSIBLE FOR PAYING FOR ANY DIMENSION VERIFICATION IF NO DIMENSION VERIFICATIONS OR PAYMENTS EXIST PRIOR TO PROCEEDING WITH CONSTRUCTION. NO EXTRA COMPENSATION WILL BE PAID TO THE CONTRACTOR FOR WORK WHICH HAS TO BE REDONE OR REPAID DUE TO DIMENSIONS OR GRADES SHOWN INCORRECTLY ON THESE PLANS PRIOR TO CONTRACTOR GIVING ENGINEER WRITTEN NOTIFICATION OF SAME AND ENGINEER, THEREAFTER, PROVIDING CONTRACTOR WITH WRITTEN AUTHORIZATION TO PROCEED WITH SUCH ADDITIONAL WORK.

8. CONTRACTOR MUST REFER TO THE ARCHITECTURAL/BUILDING PLANS 'OF RECORD' FOR EXACT LOCATIONS AND DIMENSIONS OF ENTRY/EXIT POINTS, ELEVATIONS, PRECISE BUILDING DIMENSIONS, AND EXACT BUILDING UTILITY LOCATIONS.

9. PRIOR TO THE START OF CONSTRUCTION, THE CONTRACTOR MUST COORDINATE THE BUILDING LAYOUT TO CAREFULLY REVIEW THE PLANS AND THE LATEST ARCHITECTURAL PLANS, BUILDING, BURGLAR, LIGHTING, TO STRUCTURAL, MECHANICAL, ELECTRICAL, PUBLISHING, FIRE SUPPRESSION PLAN, WHERE APPLICABLE. CONTRACTOR MUST IMMEDIATELY NOTIFY OWNER, ARCHITECT AND SITE ENGINEER, IN WRITING, OF ANY CONFLICTS, DISCREPANCIES OR AMBIGUITIES WHICH EXIST.

10. DEBRIS MUST NOT BE BURIED ON THE SUBJECT SITE AND ALL UNSUITABLE EXCAVATED MATERIAL AND DEBRIS (SOLID WASTE) MUST BE DISPOSED OF IN ACCORDANCE WITH THE REQUIREMENTS OF ANY AND ALL GOVERNMENTAL AUTHORITIES WHICH HAVE JURISDICTION OVER THIS PROJECT OR OVER CONTRACTOR.

11. THE CONTRACTOR IS RESPONSIBLE FOR IDENTIFYING WHEN SHORING AND TRENCHING IS REQUIRED AND FOR INSTALLING ALL SHORING AND TRENCHING REQUIRED DURING EXCAVATION (TO BE PERFORMED IN ACCORDANCE WITH CURRENT OSHA STANDARDS AND FLORIDA STATUTE 553.60 TRENCH SAFETY ACT) AND ANY ADDITIONAL PRECAUTIONS TO BE TAKEN TO ASSURE THE STABILITY OF ADJACENT, NEARBY AND CONTIGUOUS STRUCTURES AND PROPERTIES.

12. THE CONTRACTOR IS TO EXERCISE EXTREME CARE WHEN PERFORMING ANY WORK ACTIVITIES ADJACENT TO PAVEMENT, STRUCTURES, ETC. WHICH ARE TO REMAIN EITHER FOR AN INITIAL PHASE OF THE PROJECT OR AS PART OF THE FINAL CONSTRUCTION. CONTRACTOR IS RESPONSIBLE FOR TAKING ALL APPROPRIATE PRECAUTIONS TO ENSURE THAT THE STRUCTURAL STABILITY OF SIMULATED AND PAVED UTILITIES, BUILDINGS, AND INFRASTRUCTURE WHICH ARE TO REMAIN, AND TO PROVIDE A SAFE WORK AREA FOR THIRD PARTIES, PEDESTRIANS AND ANYONE INVOLVED WITH THE PROJECT.

13. THE CONTRACTOR IS RESPONSIBLE FOR REPAIRING ANY DAMAGE DONE TO ANY NEW OR EXISTING CONSTRUCTION OR PROPERTY DURING THE COURSE OF CONSTRUCTION, INCLUDING BUT NOT LIMITED TO, DRAINAGE, UTILITIES, PAVEMENT, STRIPPING, CURB, ETC. AND SHALL BEAR ALL COSTS ASSOCIATED WITH SAME. THE REPAIR OF ANY SUCH NEW OR EXISTING CONSTRUCTION OR PROPERTY MUST RESTORE SUCH CONSTRUCTION OR PROPERTY TO A CONDITION EQUIVALENT TO OR BETTER THAN THE CONDITION PREVIOUSLY EXISTING. THE REPAIRS MUST BE IN CONFORMANCE WITH APPLICABLE CODES, RULES, REGULATIONS, STATUTORY REQUIREMENTS AND STATUTES. CONTRACTOR MUST BEAR ALL COSTS ASSOCIATED WITH SAME. CONTRACTOR IS RESPONSIBLE TO DOCUMENT ALL EXISTING DAMAGE AND TO NOTIFY THE OWNER AND THE CONSTRUCTION MANAGER PRIOR TO THE START OF CONSTRUCTION. CONTRACTOR IS RESPONSIBLE FOR REPAIRS TO FAAD/DOA CABLES IMMEDIATELY PER FAAD/DOA SPECIFICATIONS IN THE PRESENCE OF A FAAD/DOA REPRESENTATIVE. IF FAAD OR DOA ELECT TO SELF-PERFORM REPAIRS (I.E. SPLICING), CONTRACTOR WILL BE RESPONSIBLE FOR COSTS OF REPAIRS BY OTHERS.

14. ALL CONCRETE MUST BE AIR ENTRAINED AND HAVE THE MINIMUM COMPRESSIVE STRENGTH OF 4,000 PSI AT 28 DAYS UNLESS OTHERWISE NOTED ON THE PLANS, DETAILS AND/OR GEOTECHNICAL REPORT.

15. THE ENGINEER IS NOT RESPONSIBLE FOR CONSTRUCTION METHODS, MEANS, TECHNIQUES OR PROCEDURES, GENERALLY OR FOR THE CONSTRUCTION MEANS, METHODS, TECHNIQUES OR PROCEDURES FOR COMPLETION OF THE WORK DEPICTED BOTH ON THESE PLANS, AND FOR ANY CONFLICTS/SCOPE REVISIONS WHICH RESULT FROM SAME. CONTRACTOR IS RESPONSIBLE FOR DETERMINING THE METHODS/MEANS FOR COMPLETION OF THE WORK PRIOR TO THE COMMENCEMENT OF CONSTRUCTION.

16. THE ENGINEER OF RECORD IS NOT RESPONSIBLE FOR JOB SITE SAFETY. THE ENGINEER OF RECORD HAS NOT BEEN RETAINED TO PERFORM OR BE RESPONSIBLE FOR JOB SITE SAFETY, SAME BEING WHOLLY OUTSIDE OF ENGINEER'S SERVICES AS RELATED TO THE PROJECT. THE ENGINEER OF RECORD IS NOT RESPONSIBLE TO IDENTIFY OR REPORT ANY JOB SITE SAFETY ISSUES, AT ANY TIME.

17. ALL CONTRACTORS MUST CARRY THE SPECIFIED STATUTORY WORKER'S COMPENSATION INSURANCE, EMPLOYER'S LIABILITY INSURANCE AND LIMITS OF COMMERCIAL GENERAL LIABILITY INSURANCE (CGI). ALL CONTRACTORS MUST HAVE THEIR CGI POLICIES ENDORSED NAME BOHLER ENGINEERING, AND ITS PAST, PRESENT AND FUTURE OWNERS, OFFICERS, DIRECTORS, PARTNERS, SHAREHOLDERS, MEMBERS, PRINCIPALS, COMMISSIONERS, AGENTS, SERVANTS, EMPLOYEES, AFFILIATES, SUBSIDIARIES, AND RELATED ENTITIES, AND ITS SUBCONTRACTORS AND SUBCONSULTANTS AS ADDITIONAL INSURED, AND THAT THE CONTRACTOR IS NOT A SUBCONTRACTOR OR SUBCONSULTANT TO ANY OTHER CONTRACTOR. ALL CONTRACTORS MUST FURNISH BOHLER ENGINEERING WITH CERTIFICATIONS OF INSURANCE AS EVIDENCE OF THE REQUIRED INSURANCE PRIOR TO COMMENCING WORK AND UPON RENEWAL OF EACH POLICY DURING THE ENTIRE PERIOD OF CONSTRUCTION AND FOR ONE YEAR AFTER THE COMPLETION OF CONSTRUCTION. IN ADDITION, ALL CONTRACTORS WILL, TO THE FULLEST EXTENT PERMITTED UNDER THE CONTRACT, IDENTIFY AND NOTIFY THE ENGINEER, IN WRITING, OF ALL PAST, PRESENT AND FUTURE OWNERS, OFFICERS, DIRECTORS, PARTNERS, SHAREHOLDERS, MEMBERS, PRINCIPALS, COMMISSIONERS, AGENTS, SERVANTS, EMPLOYEES, AFFILIATES, SUBSIDIARIES, AND RELATED ENTITIES, AND ITS SUBCONTRACTORS AND SUBCONSULTANTS FROM AND AGAINST ANY DAMAGES, INJURIES, CLAIMS, ACTIONS, PENALTIES, EXPENSES, PUNITIVE DAMAGES, TORT DAMAGES, STATUTORY CLAIMS, STATUTORY CAUSES OF ACTION, LOSSES, CAUSES OF ACTION, LIABILITIES OR COSTS, INCLUDING, BUT NOT LIMITED TO, THE REASONABLE ATTORNEYS' FEES AND DEFENSE COSTS, ARISING OUT OF OR IN ANY WAY CONNECTED WITH THE PROJECT. THE CONTRACTOR IS NOT A SUBCONTRACTOR OR SUBCONSULTANT TO ANY OTHER CONTRACTOR. ALL CLAIMS BY THIRD PARTIES AND ALL CLAIMS RELATED TO THE PROJECT, CONTRACTOR MUST NOTIFY ENGINEER, IN WRITING, AT LEAST THIRTY (30) DAYS PRIOR TO ANY TERMINATION, SUSPENSION OR CHANGE OF ITS INSURANCE HEREUNDER.

18. BOHLER ENGINEERING WILL REVIEW OR TAKE OTHER APPROPRIATE ACTION ON THE CONTRACTOR SUBMITTALS, SUCH AS SHOP DRAWINGS, PRODUCT DATA SAMPLES, AND OTHER DATA, WHICH THE CONTRACTOR IS REQUIRED TO SUBMIT, BUT ONLY FOR THE LIMITED PURPOSE OF CHECKING FOR CONFORMANCE WITH THE DESIGN INTENT AND THE INFORMATION SHOWN IN THE CONSTRUCTION CONTRACT DOCUMENTS. CONSTRUCTION MEANS AND/OR METHODS AND/OR TECHNIQUES OR PROCEDURES, COORDINATION OF THE WORK WITH OTHER TRADES, AND CONSTRUCTION SAFETY PRECAUTIONS ARE THE SOLE RESPONSIBILITY OF THE CONTRACTOR. AND BOHLER HAS NO RESPONSIBILITY OR LIABILITY FOR SAME. HEREUNDER, BY 'SUBMITTALS' IT IS MEANT TO INCLUDE ALL DRAWINGS, PLANS, SPECIFICATIONS, AND OTHER DATA WHILE ALLOWING SUFFICIENT TIME TO PERMIT ADEQUATE REVIEW. REVIEW OF A SPECIFIC ITEM MUST NOT INDICATE THAT BOHLER ENGINEERING HAS REVIEWED THE ENTIRE ASSEMBLY OF WHICH THE ITEM IS A COMPONENT. BOHLER ENGINEERING WILL NOT BE RESPONSIBLE FOR ANY DEVIATIONS FROM THE CONSTRUCTION DOCUMENTS NOT PROMPTLY AND IMMEDIATELY BROUGHT TO ITS ATTENTION, IN WRITING, BY THE CONTRACTOR. BOHLER ENGINEERING WILL NOT BE REQUIRED TO REVIEW PARTIAL SUBMISSIONS OR THOSE FOR WHICH SUBMISSIONS OF CORRELATED ITEMS HAVE NOT BEEN RECEIVED. ANY SHOP DRAWINGS THAT RELATE TO CONSTRUCTION OUTSIDE OF THE LEASE AREA SHALL BE REVIEWED BY PCDOA.

19. NEITHER THE PROFESSIONAL ACTIVITIES OF BOHLER ENGINEERING, NOR THE PRESENCE OF BOHLER ENGINEERING AND/OR ITS PAST, PRESENT AND FUTURE OWNERS, OFFICERS, DIRECTORS, PARTNERS, SHAREHOLDERS, MEMBERS, PRINCIPALS, COMMISSIONERS, AGENTS, SERVANTS, EMPLOYEES, AFFILIATES, SUBSIDIARIES, AND RELATED ENTITIES, AND ITS SUBCONTRACTORS AND SUBCONSULTANTS AT A CONSTRUCTION/PROJECT SITE SHALL RELIEVE THE GENERAL CONTRACTOR OF ITS OBLIGATIONS, DUTIES AND RESPONSIBILITIES INCLUDING, BUT NOT LIMITED TO, CONSTRUCTION, SUPERINTENDING AND COORDINATING THE WORK IN ACCORDANCE WITH THE REQUIREMENTS OF THE CONTRACT DOCUMENTS AND COMPLIANCE WITH ANY HEALTH OR SAFETY PRECAUTIONS REQUIRED BY ANY GOVERNMENTAL AGENCY, WHETHER LOCATED OVER THE PROPERTY OWNER'S PROPERTY. BOHLER ENGINEERING AND ITS PERSONNEL HAVE NO AUTHORITY TO ENTER OR TO CONTROL OVER ANY CONSTRUCTION CONTRACTOR OR ITS EMPLOYEES IN CONNECTION WITH THEIR WORK OR ANY HEALTH OR SAFETY PROGRAMS OR PROCEDURES. THE GENERAL CONTRACTOR IS SOLELY RESPONSIBLE FOR JOB SITE SAFETY. BOHLER ENGINEERING SHALL BE INDEMNIFIED BY THE GENERAL CONTRACTOR AND MUST BE NAMED AN ADDITIONAL INSURED UNDER THE GENERAL CONTRACTOR'S POLICIES OF GENERAL LIABILITY INSURANCE AS DESCRIBED ABOVE IN NOTE 19 FOR JOB SITE SAFETY.

20. IF THE CONTRACTOR DEVIATES FROM THE PLANS AND SPECIFICATIONS, INCLUDING THE NOTES CONTAINED HEREIN, WITHOUT FIRST OBTAINING THE PRIOR WRITTEN AUTHORIZATION OF THE ENGINEER FOR SUCH DEVIATIONS, THE CONTRACTOR IS SOLELY RESPONSIBLE FOR THE PAYMENT OF ALL COSTS INCURRED IN CORRECTING ANY WORK DONE WHICH DEVIATES FROM THE PLANS. IF PAYMENT OF ALL COSTS INCURRED IN CORRECTING ANY WORK DONE WHICH DEVIATES FROM THE PLANS AND SPECIFICATIONS RESULTING THEREFROM AND THEREAFTER, SHALL INDEMNIFY AND HOLD HARMLESS THE ENGINEER, TO THE FULLEST EXTENT PERMITTED UNDER THE LAW, IN ACCORDANCE WITH PARAGRAPH 19 HEREIN, FOR AND FROM ALL FEES, ATTORNEYS' FEES, DAMAGES, COSTS, JUDGMENTS, PENALTIES AND THE LIKE RELATED TO SAME.

21. CONTRACTOR IS RESPONSIBLE FOR MAINTENANCE AND PROTECTION OF TRAFFIC PLAN FOR ALL WORK THAT AFFECTS PUBLIC TRAVEL, EITHER IN THE R.O.W. OR ON SITE AND SECURITY OF THE AOA. THE COST FOR THIS ITEM MUST BE INCLUDED IN THE CONTRACTOR'S PRICE.

22. ALL SIGNING AND PAVEMENT STRIPING MUST CONFORM TO MANUAL ON UNIFORM TRAFFIC CONTROL DEVICES OR LOCALLY APPROVED.

23. ENGINEER IS NOT RESPONSIBLE FOR ANY INJURY OR DAMAGES RESULTING FROM CONTRACTOR'S FAILURE TO BUILD OR CONSTRUCT IN STRICT ACCORDANCE WITH THE APPROVED PLANS. IF CONTRACTOR AND/OR OWNER FAIL BUILD OR CONSTRUCT IN STRICT ACCORDANCE WITH APPROVED PLANS, THEY AGREE TO JOINTLY AND SEVERALLY INDEMNIFY AND HOLD ENGINEER HARMLESS FOR ALL INJURIES AND DAMAGES THAT ENGINEER SUFFERS AND COSTS THAT ENGINEER INCURS.

24. OWNER MUST MAINTAIN AND PRESERVE ALL PHYSICAL SITE FEATURES AND DESIGN FEATURES DEPICTED ON THE PLANS AND RELATED DOCUMENTS, IN STRICT ACCORDANCE WITH THE APPROVED PLANS) AND DESIGN AND, FURTHER ENGINEER IS NOT RESPONSIBLE FOR ANY FAILURE TO SO MAINTAIN PRESERVE SITE AND/OR DESIGN FEATURES. IF OWNER FAILS TO MAINTAIN AND PRESERVE ALL PHYSICAL SITE FEATURES AND/OR DESIGN FEATURES DEPICTED ON THE PLANS AND RELATED DOCUMENTS, OWNER AGREES TO INDEMNIFY AND HOLD ENGINEER HARMLESS FOR ALL INJURIES AND DAMAGES THAT ENGINEER SUFFERS AND COSTS THAT ENGINEER INCURS AS A RESULT OF SAID FAILURE.

25. ALL DIMENSIONS MUST BE TO FACE OF CURB, EDGE OF PAVEMENT, OR EDGE OF BUILDING, UNLESS NOTED OTHERWISE.

26. ALL CONSTRUCTION AND MATERIALS MUST COMPLY WITH AND CONFORM TO APPLICABLE FEDERAL, STATE AND LOCAL REGULATIONS, LAWS, ORDINANCES, RULES AND CODES, AND ALL APPLICABLE OSHA REQUIREMENTS.

27. CONTRACTOR AND OWNER MUST INSTALL ALL ELEMENTS AND COMPONENTS IN STRICT COMPLIANCE WITH AND ACCORDANCE WITH MANUFACTURER'S STANDARDS AND RECOMMENDED INSTALLATION CRITERIA AND SPECIFICATIONS. IF CONTRACTOR AND/OR OWNER FAIL TO DO SO, THEY AGREE TO JOINTLY AND SEVERALLY INDEMNIFY AND HOLD ENGINEER HARMLESS FOR ALL INJURIES AND DAMAGES THAT ENGINEER SUFFERS AND COSTS THAT ENGINEER INCURS AS A RESULT OF SAID FAILURE.

28. CONTRACTOR IS RESPONSIBLE TO MAINTAIN ON-SITE STORMWATER POLLUTION PREVENTION PLAN (SWPPP) IN COMPLIANCE WITH EPA REQUIREMENTS FOR SITES WHERE ONE OR MORE UNLESS THE LOCAL JURISDICTION PROHIBITS IT. CONTRACTOR IS RESPONSIBLE FOR MAINTAINING THE SWPPP AND SPMM, INCLUDING, BUT NOT LIMITED TO, LOGGING ACTIVITIES (MINIMUM ONCE PER WEEK AND AFTER RAINFALL EVENTS) AND CORRECTIVE MEASURES, AS APPROPRIATE.

29. AS CONTAINED IN THESE DRAWINGS AND ASSOCIATED APPLICATION DOCUMENTS, PREPARED BY THE SIGNATORY PROFESSIONAL ENGINEER, THE USE OF THE WORDS CERTIFY OR CERTIFICATION CONSTITUTES AN EXPRESSION OF 'PROFESSIONAL OPINION' REGARDING THE INFORMATION WHICH IS THE SUBJECT OF THE UNDERSIGNED PROFESSIONAL KNOWLEDGE OR BELIEF AND IN ACCORDANCE WITH COMMON ACCEPTED PROCEDURE CONSISTENT WITH THE APPLICABLE PROFESSIONAL STANDARDS.

30. CONTRACTOR MUST LOCATE AND CLEARLY AND UNAMBIGUOUSLY DEFINE VERTICALLY AND HORIZONTALLY ALL ACTIVE AND INACTIVE UTILITY AND/OR SERVICE SYSTEMS THAT ARE TO BE REMOVED. THE CONTRACTOR IS RESPONSIBLE TO PROTECT AND MAINTAIN ALL ACTIVE AND INACTIVE SYSTEMS THAT ARE NOT BEING REMOVED/RELOCATED DURING SITE ACTIVITY.

31. THE CONTRACTOR MUST FURNISH THE OWNER WITH WRITTEN NOTIFICATION THAT THE EXISTING UTILITIES AND SERVICES HAVE BEEN TERMINATED AND ABANDONED IN ACCORDANCE WITH THE JURISDICTION AND UTILITY COMPANY REQUIREMENTS AND ALL OTHER APPLICABLE REQUIREMENTS, RULES, STATUTES, LAWS, ORDINANCES AND CODES.

32. CONSULTANT IS NEITHER LIABLE NOR RESPONSIBLE FOR ANY SUBSURFACE CONDITIONS AND FURTHER, SHALL HAVE NO LIABILITY FOR ANY HAZARDOUS MATERIALS, HAZARDOUS SUBSTANCES, OR POLLUTANTS ON, ABOUT OR UNDER THE PROPERTY.

33. THE CONTRACTOR MUST INSTALL ALL STORM SEWER AND SANITARY SEWER COMPONENTS WHICH FUNCTION BY GRAVITY PRIOR TO THE INSTALLATION OF ALL OTHER UTILITIES.

34. CONTRACTOR IS RESPONSIBLE FOR COORDINATION OF SITE PLAN DOCUMENTS AND ARCHITECTURAL DESIGN FOR EXACT BUILDING UTILITY CONNECTION LOCATIONS, GREASE TRAP REQUIREMENTS/DETAILS, DOOR ACCESS, AND EXTERIOR GRADING. THE ARCHITECT WILL DETERMINE THE UTILITY SERVICE SIZES. THE CONTRACTOR MUST COORDINATE INSTALLATION OF UTILITIES/SERVICES WITH THE INDIVIDUAL COMPANIES, TO AVOID CONFLICTS AND TO ENSURE THAT PROPOSED DEPTHS ARE ACHIEVED. THE CONTRACTOR RESPONSIBLE FOR ENSURING THAT INSTALLATION OF ALL IMPROVEMENTS COMPLIES WITH ALL APPLICABLE REQUIREMENTS, RULES, STATUTES, LAWS, ORDINANCES AND CODES. CONTRACTOR IS RESPONSIBLE FOR COORDINATING UTILITIES IN-CONNECTIONS PRIOR TO CONNECTING TO THE EXISTING UTILITY(S) WHERE A CONFLICT(S) EXISTS BETWEEN THESE SITE PLANS AND THE ARCHITECTURAL PLANS, OR WHERE ARCHITECTURAL PLAN UTILITY CONNECTION POINTS DIFFER, THE CONTRACTOR MUST IMMEDIATELY NOTIFY THE ENGINEER, IN WRITING, AND PRIOR TO CONSTRUCTION, RESOLVE SAME.

35. WATER SERVICE MATERIALS, BURIAL DEPTH, AND COVER REQUIREMENTS MUST BE SPECIFIED BY THE LOCAL UTILITY COMPANY. CONTRACTOR'S PRICE FOR WATER SERVICE MUST INCLUDE ALL FEES, COSTS AND APPURTENANCES REQUIRED BY THE UTILITY TO PROVIDE FULL AND COMPLETE WORKING SERVICE. CONTRACTOR MUST CONTACT THE APPLICABLE MUNICIPALITY TO CONFIRM THE PROPER WATER METER AND VAULT, PRIOR TO COMMENCING CONSTRUCTION.

36. ALL NEW UTILITIES/SERVICES, INCLUDING ELECTRIC, TELEPHONE, CABLE TV, ETC. ARE TO BE INSTALLED UNDERGROUND. ALL NEW UTILITIES/SERVICES MUST BE INSTALLED IN ACCORDANCE WITH THE UTILITY/SERVICE PROVIDER INSTALLATION SPECIFICATIONS AND STANDARDS.

37. SITE GRADING MUST BE PERFORMED IN ACCORDANCE WITH THESE PLANS AND SPECIFICATIONS AND THE RECOMMENDATIONS SET FORTH IN THE GEOTECHNICAL REPORT REFERENCED IN THIS SET. THE CONTRACTOR IS RESPONSIBLE FOR REMOVING ALL EXCAVATED MATERIALS AND BACKFILLING ALL SUBBASE AREAS IN ACCORDANCE WITH THE GEOTECHNICAL REPORT. ALL EXCAVATED OR FILLED AREAS MUST BE COMPACTION AS OUTLINED IN THE GEOTECHNICAL REPORT. MOISTURE CONTENT AT TIME OF PLACEMENT MUST BE SUBMITTED IN A COMPACTION REPORT PREPARED BY A QUALIFIED GEOTECHNICAL ENGINEER, REGISTERED WITH THE STATE WHERE THE WORK IS PERFORMED, VERIFYING THAT ALL FILLED AREAS AND SUBGRADE AREAS WITHIN THE BUILDING PAD AREA AND AREAS TO BE PAVED HAVE BEEN COMPACTED IN ACCORDANCE WITH THESE PLANS, SPECIFICATIONS AND THE RECOMMENDATIONS SET FORTH IN THE GEOTECHNICAL REPORT AND ALL APPLICABLE REQUIREMENTS, RULES, STATUTES, LAWS, ORDINANCES AND CODES. CONTRACTOR IS RESPONSIBLE FOR COORDINATING UTILITIES IN-CONNECTIONS PRIOR TO CONNECTING TO THE EXISTING UTILITY(S) WHERE A CONFLICT(S) EXISTS BETWEEN THESE SITE PLANS AND THE ARCHITECTURAL PLANS, OR WHERE ARCHITECTURAL PLAN UTILITY CONNECTION POINTS DIFFER, THE CONTRACTOR MUST IMMEDIATELY NOTIFY THE ENGINEER, IN WRITING, AND PRIOR TO CONSTRUCTION, RESOLVE SAME.

38. ALL FILL, COMPACTION, AND BACKFILL MATERIALS REQUIRED FOR UTILITY INSTALLATION MUST BE AS PER THE RECOMMENDATIONS PROVIDED IN THE GEOTECHNICAL REPORT AND MUST BE COORDINATED WITH THE APPLICABLE UTILITY COMPANY. CONTRACTOR'S PRICE FOR UTILITY INSTALLATION MUST BE AS PER THE RECOMMENDATIONS PROVIDED IN THE GEOTECHNICAL REPORT. THE PROJECT DOES NOT HAVE GEOTECHNICAL REQUIREMENTS, RULES, STATUTES, LAWS, ORDINANCES AND CODES. CONTRACTOR MUST FULLY COMPLY WITH THE STATE DOT REQUIREMENTS AND SPECIFICATIONS AND CONSULTANT SHALL HAVE NO LIABILITY OR RESPONSIBILITY FOR OR AS RELATED TO THE FILL, COMPACTION AND BACKFILL. FURTHER, CONTRACTOR IS FULLY RESPONSIBLE FOR EARTHWORK BALANCE.

39. THE CONTRACTOR MUST COMPLY, TO THE FULLEST EXTENT, WITH THE LATEST OSHA STANDARDS AND REGULATIONS, AND/OR ANY OTHER AGENCY WITH JURISDICTION FOR EXCAVATION AND TRENCHING PROCEDURES. THE CONTRACTOR IS RESPONSIBLE FOR DETERMINING THE 'MEANS AND METHODS' REQUIRED TO MEET THE INTENT AND PERFORMANCE CRITERIA OF OSHA, AS WELL AS ANY OTHER ENTITY THAT HAS JURISDICTION FOR EXCAVATION AND/OR TRENCHING PROCEDURES AND CONSULTANT SHALL HAVE NO RESPONSIBILITY FOR OR AS RELATED TO EXCAVATION AND TRENCHING PROCEDURES.

40. PAVING MUST BE SAW CUT IN STRAIGHT LINES, AND EXCEPT FOR EDGE OF BUTT JOINTS, MUST EXTEND TO THE FULL DEPTH OF THE EXISTING PAVEMENT. ALL DEBRIS FROM REMOVAL OPERATIONS MUST BE REMOVED FROM THE SITE AT THE TIME OF EXCAVATION. STOCKPILE OF DEBRIS WILL NOT BE PERMITTED.

41. THE TOPS OF EXISTING MANHOLES, INLET STRUCTURES, AND SANITARY CLEANOUT TOPS MUST BE ADJUSTED, AS NECESSARY, TO MATCH PROPOSED UTILITIES IN ACCORDANCE WITH ALL APPLICABLE STANDARDS, REQUIREMENTS, RULES, STATUTES, LAWS, ORDINANCES AND CODES.

42. DURING THE INSTALLATION OF WATER LINES, SERVICE LATERALS, SANITARY SEWER, STORM SEWER, AND ALL UTILITIES, THE CONTRACTOR MUST MAINTAIN A CONTEMPORANEOUS AND THOROUGH RECORD OF CONSTRUCTION TO IDENTIFY THE AS-INSTALLED LOCATIONS OF ALL UNDERGROUND INFRASTRUCTURE. THE CONTRACTOR MUST CAREFULLY NOTE ANY INSTALLATIONS THAT DEVIATE FROM THE INFORMATION CONTAINED IN THE UTILITY PLAN. THIS RECORD MUST BE KEPT ON A CLEAN COPY OF THE SITE PLAN, WHICH CONTRACTOR MUST PROMPTLY PROVIDE TO THE OWNER AT THE COMPLETION OF WORK.

43. WHEN THE SITE IMPROVEMENT PLANS INVOLVE MULTIPLE BUILDINGS, SOME OF WHICH MAY BE BUILT AT A LATER DATE, THE CONTRACTOR MUST EXTEND ALL LINES, INCLUDING, BUT NOT LIMITED TO STORM SEWER, SANITARY SEWER, UTILITIES, AND ETC. TO A POINT AT LEAST 10' (30' DEPENDS ON THE SITE) FROM THE CONSTRUCTION. CONTRACTOR IS RESPONSIBLE FOR COORDINATING UTILITIES IN-CONNECTIONS WITH THE EXISTING UTILITIES. CONTRACTOR MUST CAP ENDS AS APPROPRIATE, MARK LOCATIONS WITH A ZONE, AND MUST NOTE THE LOCATION OF ALL OF THE ABOVE ON A CLEAN COPY OF THE SITE PLAN, WHICH CONTRACTOR MUST PROMPTLY PROVIDE TO THE OWNER UPON COMPLETION OF THE WORK.



44. THE CONTRACTOR IS FULLY RESPONSIBLE FOR VERIFICATION OF EXISTING TOPOGRAPHIC INFORMATION AND UTILITY ELEVATIONS PRIOR TO COMMENCING ANY CONSTRUCTION. CONTRACTOR MUST CONFIRM AND ENSURE 0.75% MINIMUM SLOPES AGAINST ALL ISLANDS, GUTTERS, AND CURBS. 1.0% ON ALL CONCRETE SURFACES, AND 1.5% MINIMUM ON ASPHALT, EXCEPT WHERE ADA REQUIREMENTS LIMIT GRADES. TO PREVENT PONDING, CONTRACTOR MUST IMMEDIATELY IDENTIFY, IN WRITING TO THE ENGINEER, ANY DISCREPANCIES THAT MAY OR COULD AFFECT THE PUBLIC SAFETY, HEALTH OR GENERAL WELFARE, OR PROJECT COST. IF CONTRACTOR PROCEEDS WITH CONSTRUCTION WITHOUT PROVIDING PROPER NOTIFICATION, MUST BE AT THE CONTRACTOR'S OWN RISK AND, FURTHER, CONTRACTOR SHALL INDEMNIFY, DEFEND AND HOLD HARMLESS THE DESIGN ENGINEER FOR ANY DAMAGES, COSTS, INJURIES, ATTORNEY'S FEES AND THE LIKE WHICH RESULT FROM SAME.

45. PROPOSED TOP OF CURB ELEVATIONS ARE GENERALLY 6" ABOVE EXISTING LOCAL ASPHALT GRADE UNLESS OTHERWISE NOTED. FLOOR ADJUST TO CREATE A MINIMUM OF 0.75% GUTTER GRADE ALONG CURB FACE. IT IS CONTRACTOR'S OBLIGATION TO ENSURE THAT DESIGN ENGINEER APPROVES FINAL CURBING CUT SHEETS PRIOR TO INSTALLATION OF SAME.

46. REFER TO SITE PLAN FOR ADDITIONAL NOTES.

47. IN THE EVENT OF DISCREPANCIES AND/OR CONFLICTS BETWEEN PLANS OR RELATIVE TO OTHER PLANS, THE SITE PLAN WILL TAKE PRECEDENCE AND CONTROL. CONTRACTOR MUST IMMEDIATELY NOTIFY THE DESIGN ENGINEER, IN WRITING, OF ANY DISCREPANCIES AND/OR CONFLICTS.

48. CONTRACTOR IS REQUIRED TO SECURE ALL NECESSARY AND/OR REQUIRED PERMITS AND APPROVALS FOR ALL OFF-SITE MATERIAL SOURCES AND DISPOSAL FACILITIES. CONTRACTOR MUST SUPPLY A COPY OF APPROVALS TO ENGINEER AND OWNER PRIOR TO INITIATING WORK.

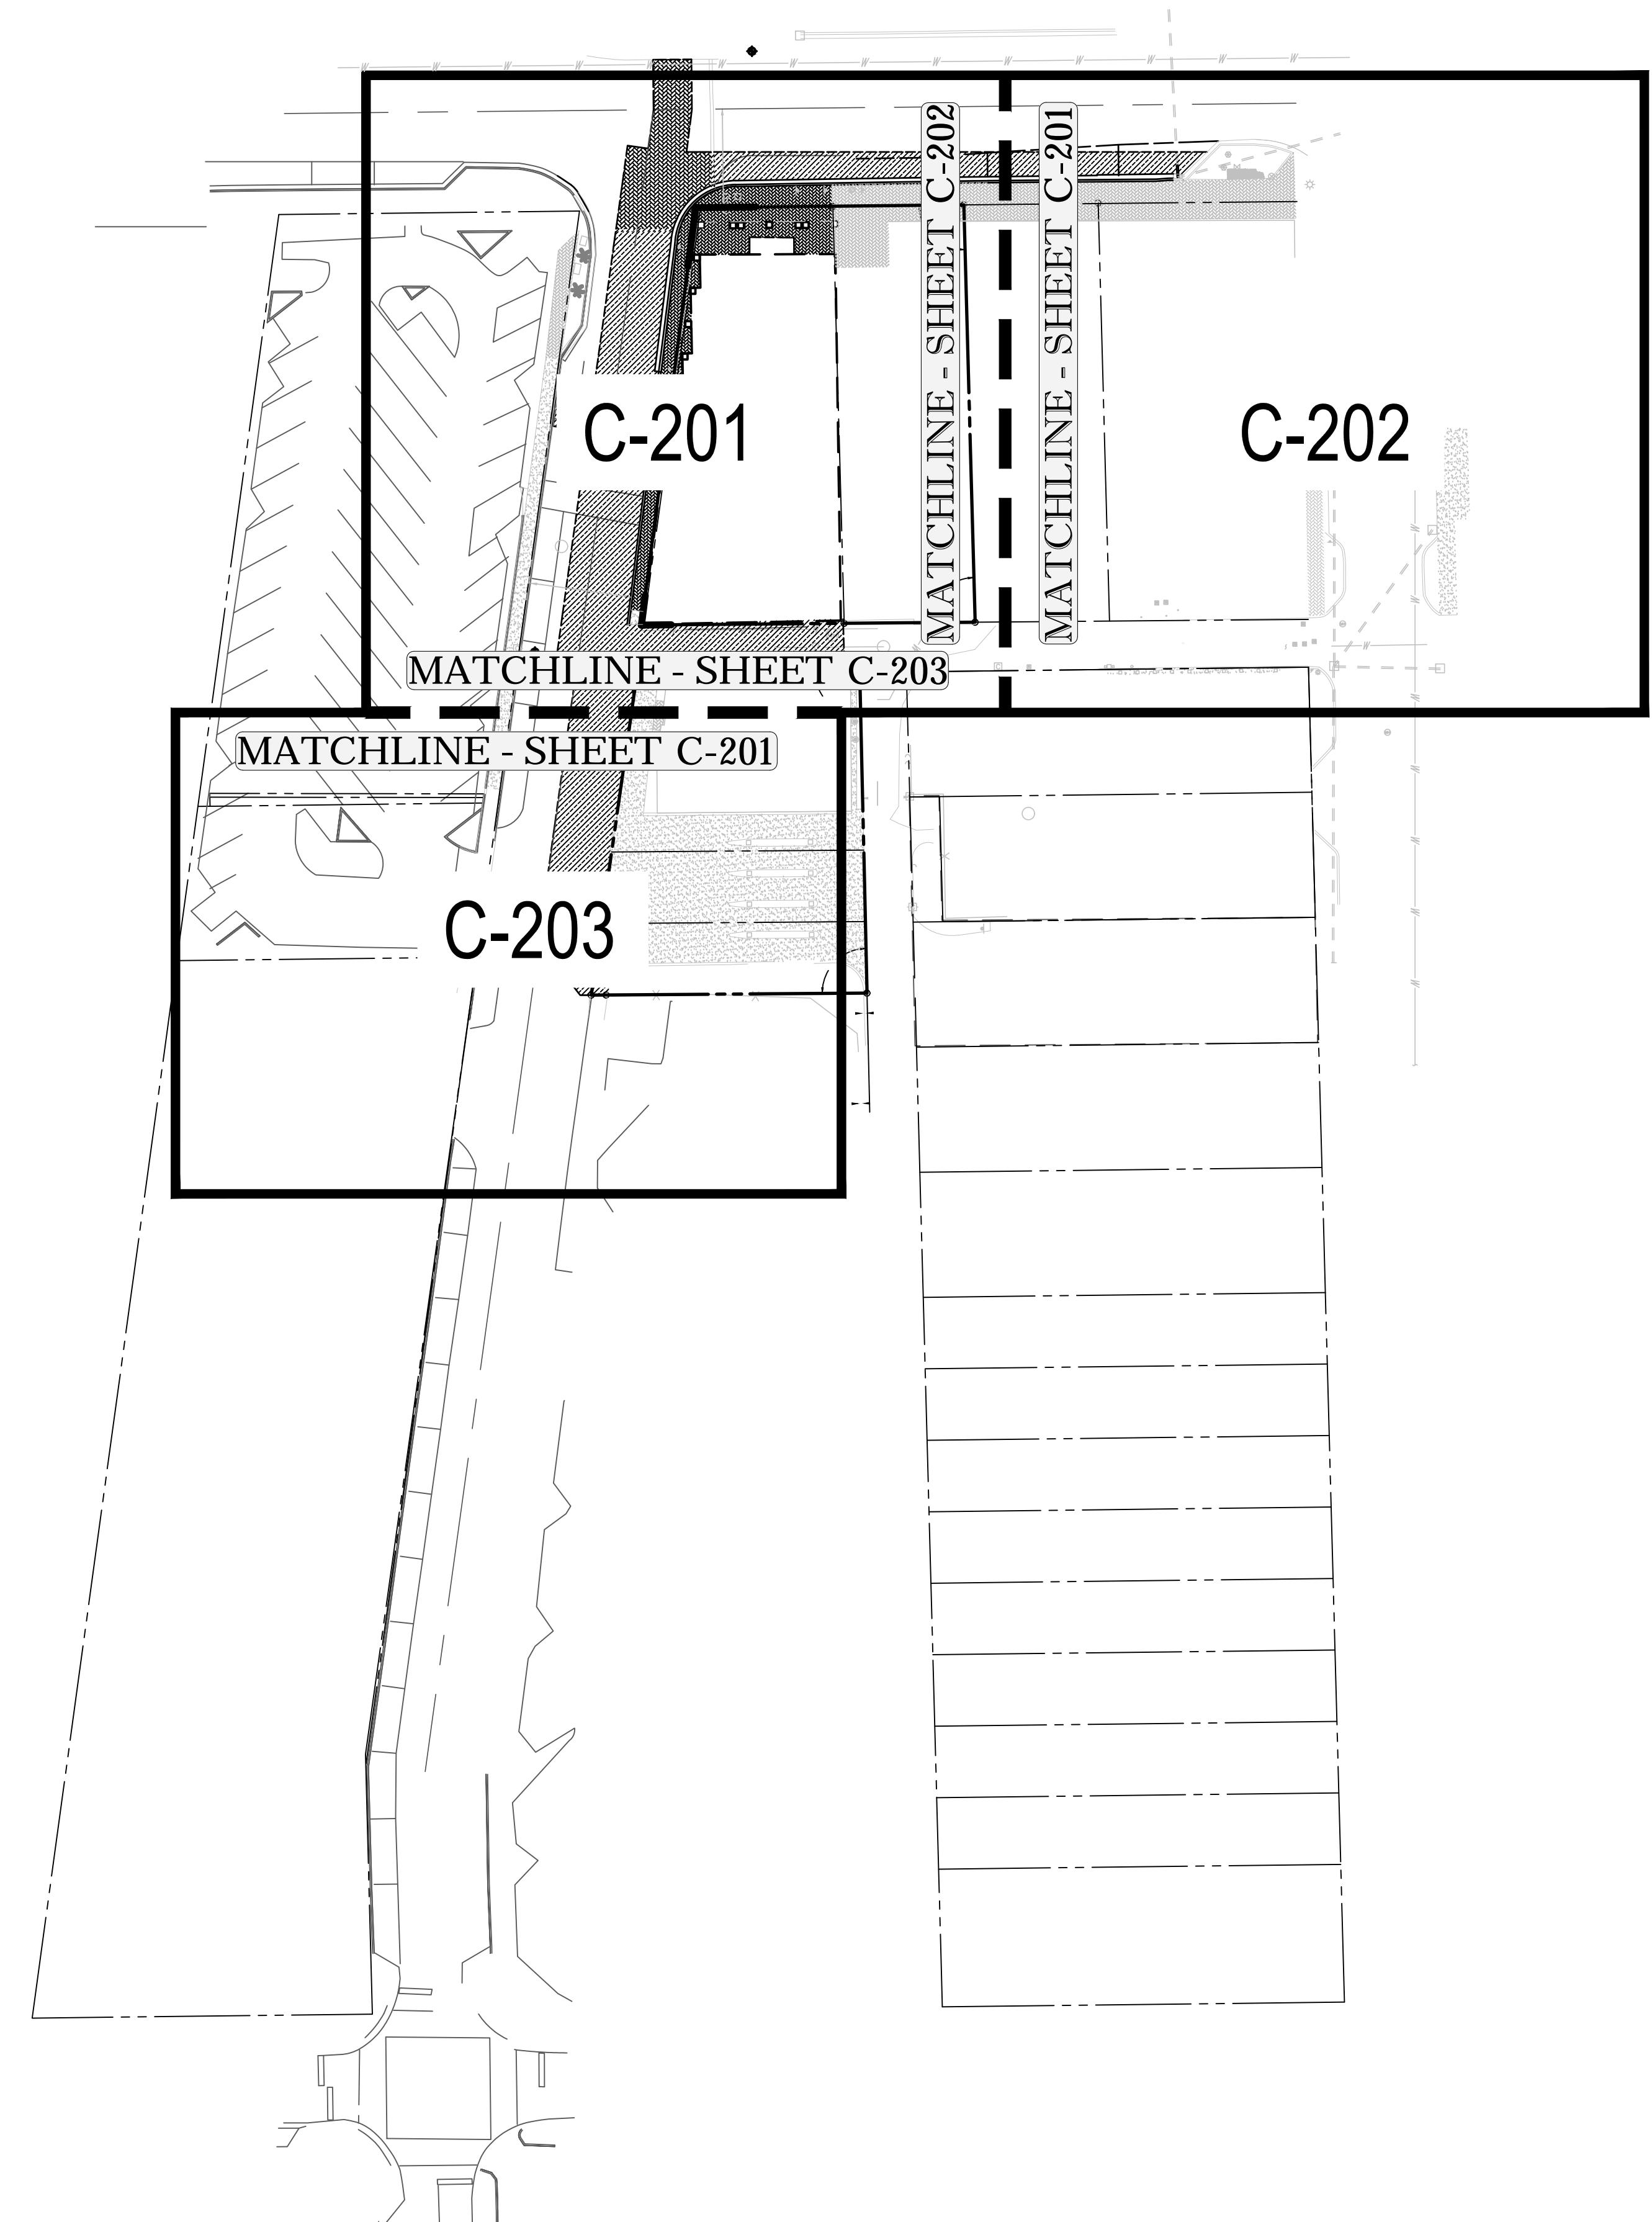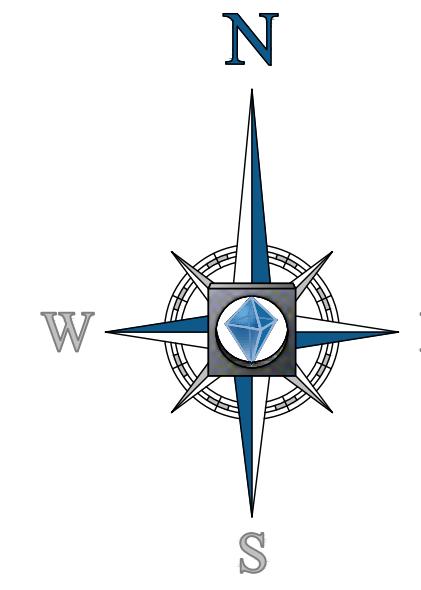


SHEET TITLE:
DEMOLITION
PLAN KEY
SHEET

SHEET NUMBER:
C-200

REVISION 2 - 2019-09-10



2255 GLADES ROAD, SUITE 305E
BOCA RATON, FLORIDA 33431
Phone: (561) 571-0280
Fax: (561) 571-0281
FLORIDA BUSINESS CERT. OF AUTH. No. 30780
LANDSCAPE ARCHITECTURE LLC, No. C26000501

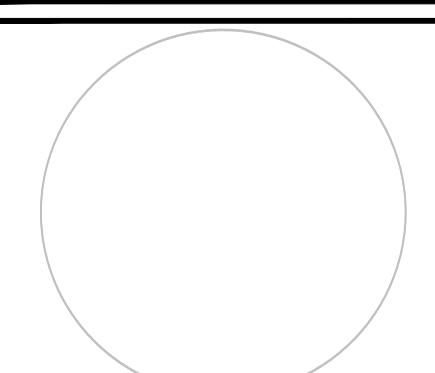

SHEET TITLE:


DEMOLITION
PLAN KEY
SHEET

SHEET NUMBER:
C-200

REVISION 2 - 2019-09-10



REVISIONS			
REV	DATE	COMMENT	DRAWN BY
1	2019-08-23	CITY OF DELRAY BEACH COMMENTS	LJL AS
2	2019-09-10	SPRAB COMMENTS	LJL AS

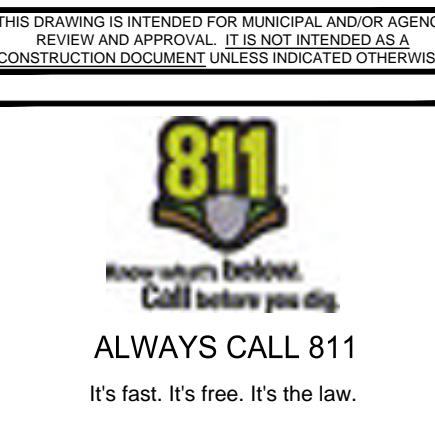

ISSUED FOR MUNICIPAL &
AGENCY REVIEW & APPROVAL


PROJECT No.: FLB180120
DRAWN BY: LJL
CHECKED BY: AS
DATE: 2019-10-25
CAD I.D.: FLB180120-DMP-1

PROJECT:
PIERRE DELRAY PHASE 1 -
SPRAB SITE PLAN PACKAGE
(AKA SUNTRUST BUILDING)

FOR
CLIENT
ZYSCOVICH
ARCHITECTS
PROPOSED
DEVELOPMENT
302 E ATLANTIC AVE
PALM BEACH COUNTY
DELRAY BEACH, FL



2255 GLADES ROAD, SUITE 305E
BOCA RATON, FLORIDA 33431
Phone: (561) 571-0280
Fax: (561) 571-0281
FLORIDA BUSINESS CERT. OF AUTH. No. 30780
LANDSCAPE ARCHITECTURE LLC, No. C26000501

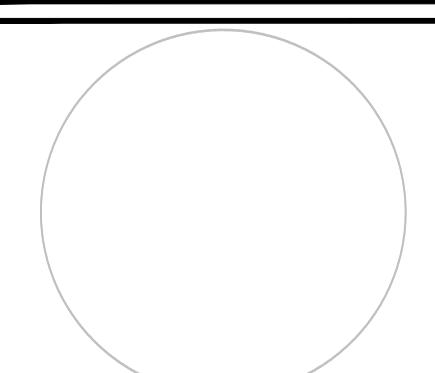

REVISIONS		
REV	DATE	COMMENT
1	2019-08-23	CITY OF DELRAY BEACH COMMENTS LJL AS
2	2019-09-10	SPRAB COMMENTS LJL AS




ISSUED FOR MUNICIPAL & AGENCY REVIEW & APPROVAL

PROJECT No.: FLB180120
DRAWN BY: LJL
CHECKED BY: AS
DATE: 2019-10-25
CAD I.D.: FLB180120-DMP-1

PROJECT: PIERRE DELRAY PHASE I - SPRAB SITE PLAN PACKAGE (AKA SUNTRUST BUILDING)

CLIENT
ZYSCOVICH
ARCHITECTS
PROPOSED DEVELOPMENT
302 E ATLANTIC AVE
PALM BEACH COUNTY
DELRAY BEACH, FL

BOHLER
ENGINEERING
2255 GLADES ROAD, SUITE 305E
BOCA RATON, FLORIDA 33431
Phone: (561) 571-0280
Fax: (561) 571-0281
FLORIDA BUSINESS CERT OF AUTH. No. 30780
LANDSCAPE ARCHITECT BUSINESS LIC. No. C26000531

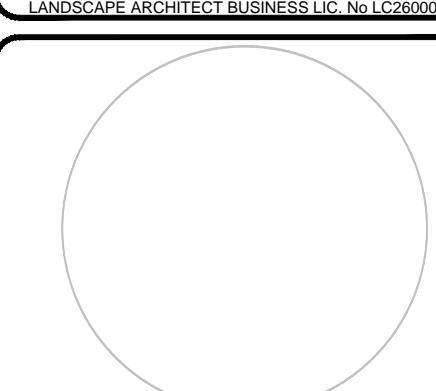

SHEET TITLE:
DEMOLITION PLAN

SHEET NUMBER:
C-201

REVISION 2 - 2019-09-10

LEGEND:


	EX PROPERTY BOUNDARY LINES
	PROP PROPERTY BOUNDARY LINES
	EX STORM STRUCTURES TO BE REMOVED
	TO BE REMOVED
	EX PAVERS TO BE REMOVED
	EX SURFACE TO BE REMOVED
	EX STORM PIPE TO BE REMOVED
	EX SPOT GRADE
	EX POLE TO BE REMOVED
	EX POLE TO REMAIN
	EX SANITARY MANHOLE
	EX SANITARY LINE
	EX STORM SEWER PIPE
	EX WATER LINE
	EX OVERHEAD WIRE
	EX SANITARY LINE TO BE REMOVED
	EX WATER LINE TO BE REMOVED
	EX OVERHEAD WIRE TO BE REMOVED
	EX LIGHT POLE TO BE REMOVED
	EX LIGHT POLE TO REMAIN
	EX CATCH BASIN TO REMAIN
	EX CLEAN OUT TO BE REMOVED
	EX TREES TO BE REMOVED

DEMOLITION NOTES:

1. BOHLER ENGINEERING FL, LLC IS NOT RESPONSIBLE FOR JOB SITE SAFETY OR SUPERVISION. CONTRACTOR IS TO PROCEED WITH THE DEMOLITION IN A SYSTEMATIC AND SAFE MANNER, FOLLOWING ALL THE OSHA REQUIREMENTS, TO ENSURE PUBLIC AND CONTRACTOR SAFETY.
2. ALL DEMOLITION ACTIVITIES ARE TO BE PERFORMED IN ACCORDANCE WITH THESE PLANS AND SPECIFICATIONS AS WELL AS ALL FEDERAL, STATE AND LOCAL REGULATIONS. ANY DISCREPANCIES OR DEVIATIONS SHALL BE IDENTIFIED BY THE CONTRACTOR TO BOHLER ENGINEERING, FL, LLC IN WRITING FOR RESOLUTION PRIOR TO INITIATION OF SITE ACTIVITY.
3. PRIOR TO STARTING ANY DEMOLITION CONTRACTOR IS RESPONSIBLE FOR:
 - A. THE CONTRACTOR SHALL OBTAIN A SUNSHINE STATE ONE CALL LOCATION CERTIFICATION PRIOR TO ANY EXCAVATION OR DEMOLITION. THE NUMBER IS 1-800-432-4770.
 - B. ENSURING COPIES OF ALL PERMITS AND APPROVALS MUST BE MAINTAINED ON SITE AND AVAILABLE FOR REVIEW.
 - C. INSTALLING THE REQUIRED SOIL EROSION AND SEDIMENT CONTROL MEASURES PRIOR TO SITE DISTURBANCE.
 - D. LOCATE/CAP ALL UTILITIES AND SERVICES, INCLUDING BUT NOT LIMITED TO GAS, WATER, ELECTRIC, SANITARY AND STORM SEWER, TELEPHONE, CABLE, FIBER OPTIC CABLE, ETC. WITHIN THE LIMITS OF DISTURBANCE.
 - E. PRIOR TO COMMENCING DEMOLITION IN OPERATION, ALL ACTIVE SYSTEM THAT ARE NOT BEING REMOVED ARE TO BE TURNED OFF.
 - F. FAMILIARIZING THEMSELVES WITH THE APPLICABLE UTILITY SERVICE PROVIDER AND IS RESPONSIBLE FOR ALL COORDINATION REGARDING UTILITY DEMOLITION REQUIRED FOR THE PROJECT. THE CONTRACTOR SHALL PROVIDE THE OWNER WRITTEN NOTIFICATION THAT THE EXISTING UTILITIES AND SERVICES HAVE BEEN TERMINATED OR ABANDONED IN ACCORDANCE WITH THE JURISDICTIONAL UTILITY COMPANY REQUIREMENTS.
 - G. COORDINATION WITH UTILITY COMPANIES REGARDING WORK IN OFF-PEAK HOURS OR ON WEEKENDS AS MAY BE REQUIRED TO MINIMIZE THE IMPACT ON THE AFFECTED PARTIES.
 - H. A COMPLETE INSPECTION OF CONTAMINANTS BY A LICENSED ENVIRONMENTAL TESTING AGENCY, OF ALL BUILDINGS AND/OR STRUCTURES TO BE REMOVED. SAMPLING SHALL BE PERFORMED IN ACCORDANCE WITH ALL APPLICABLE LOCAL, STATE, AND FEDERAL ENVIRONMENTAL REGULATIONS. ANY CONTAMINANTS SHALL BE REMOVED AND DISPOSED OF BY A FEDERALLY LICENSED CONTRACTOR IN ACCORDANCE WITH FEDERAL, STATE, AND LOCAL REGULATIONS. ALL ENVIRONMENTAL WORK INCLUDING HAZARDOUS MATERIAL, SOILS, ASBESTOS, OR OTHER REFERENCED OR IMPLIED HEREIN IS THE SOLE RESPONSIBILITY OF THE OWNER'S ENVIRONMENTAL CONSULTANT.
4. THE CONTRACTOR SHALL PROVIDE ALL THE "MEANS AND METHODS" NECESSARY TO PREVENT MOVEMENT, SETTLEMENT, OR COLLAPSE OF EXISTING STRUCTURES, AND ANY OTHER IMPROVEMENTS THAT ARE REMAINING ON OR OFF SITE. THE DEMOLITION CONTRACTOR IS RESPONSIBLE FOR ALL REPAIRS OF DAMAGE TO ALL ITEMS THAT ARE TO REMAIN AS A RESULT OF HIS ACTIVITIES. ALL REPAIRS SHALL USE NEW MATERIAL. THE REPAIRS SHALL RESTORE THE ITEM TO THE PRE-DEMOLITION CONDITION.
5. IN THE ABSENCE OF SPECIFICATIONS, THE CONTRACTOR SHALL PERFORM EARTH MOVEMENT ACTIVITIES, DEMOLITION AND REMOVAL OF ALL FOUNDATION WALLS, FOOTINGS, AND OTHER MATERIALS WITHIN THE LIMITS OF DISTURBANCE IN ACCORDANCE WITH DIRECTION BY OWNER'S STRUCTURAL OR GEOTECHNICAL ENGINEER.
6. EXPLOSIVES SHALL NOT BE USED WITHOUT PRIOR WRITTEN CONSENT OF BOTH THE OWNER AND APPLICABLE GOVERNMENTAL ORGANIZATION. EXPLOSIVES SHALL NOT BE USED WITHOUT PRIOR WRITTEN CONSENT AS REQUIRED BY THE FEDERAL, STATE, AND LOCAL GOVERNMENTS. SHALL BE IN PLACE PRIOR TO STARTING AN EXPLOSIVE PROGRAM. THE CONTRACTOR IS ALSO RESPONSIBLE FOR ALL INSPECTION AND SEISMIC VIBRATION TESTING THAT IS REQUIRED TO MONITOR THE EFFECTS ON ALL LOCAL STRUCTURES.
7. CONTRACTOR SHALL PROVIDE TRAFFIC CONTROL AND GENERALLY ACCEPTED SAFE PRACTICES IN CONFORMANCE WITH THE "MANUAL ON UNIFORM TRAFFIC CONTROL", AS WELL AS FEDERAL, STATE, AND LOCAL REGULATIONS WHEN DEMOLITION RELATED ACTIVITIES IMPACT ROADWAYS OR ROADWAY RIGHTS-OF-WAY.
8. CONDUCT DEMOLITION ACTIVITIES IN SUCH A MANNER TO ENSURE MINIMUM INTERFERENCE WITH ROADS, STREETS, SIDEWALKS, WALKWAYS, AND OTHER ADJACENT FACILITIES. STREET CLOSURE PERMITS MUST BE RECEIVED FROM THE APPROPRIATE GOVERNMENTAL AUTHORITY.
9. DEMOLITION ACTIVITIES AND EQUIPMENT SHALL NOT USE AREAS OUTSIDE THE DEFINED PROPERTY LINE WITHOUT WRITTEN PERMISSION OF THE OWNER, AND/OR APPROPRIATE GOVERNMENTAL AGENCY.
10. USE DUST CONTROL MEASURES TO LIMIT AIRBORNE DUST AND DIRT RISING, AND SCATTERING IN THE AIR IN ACCORDANCE WITH FEDERAL, STATE, AND/OR LOCAL STANDARDS. AFTER THE DEMOLITION IS COMPLETE, ADJACENT STRUCTURES AND IMPROVEMENTS SHALL BE CLEANED OF ALL DUST AND DEBRIS CAUSED BY THE DEMOLITION OPERATIONS. THE CONTRACTOR IS RESPONSIBLE FOR RETURNING ALL ADJACENT AREAS TO THEIR "PRE-DEMOLITION" CONDITION.
11. CONTRACTOR IS RESPONSIBLE TO SAFEGUARD SITE AS NECESSARY TO PERFORM THE DEMOLITION IN SUCH A MANNER AS TO PREVENT THE ENTRY OF UNAUTHORIZED PERSONS AT ANY TIME.
12. THIS DEMOLITION PLAN IS INTENDED TO IDENTIFY THOSE EXISTING ITEMS/CONDITIONS WHICH ARE TO BE REMOVED. IT IS NOT INTENDED TO PROVIDE DIRECTION OTHER THAN THAT ALL METHODS AND MEANS ARE TO BE IN ACCORDANCE WITH STATE, FEDERAL, LOCAL, AND JURISDICTIONAL REQUIREMENTS. THE CONTRACTOR SHALL BE RESPONSIBLE FOR ALL OSHA AND OTHER SAFETY PRECAUTIONS NECESSARY TO PROVIDE A SAFE WORK SITE.
13. DEBRIS SHALL NOT BE BURIED ON THE SUBJECT SITE. ALL DEMOLITION WASTES AND DEBRIS (SOLID WASTE) SHALL BE DISPOSED OF IN ACCORDANCE WITH ALL TOWN, COUNTY, STATE, AND FEDERAL LAWS AND APPLICABLE CODES.
14. CONTRACTOR IS RESPONSIBLE FOR FIELD VERIFYING ALL EXISTING SITE IMPROVEMENTS AND UTILITIES. ALL DISCREPANCIES SHALL BE IDENTIFIED TO THE ENGINEER IN WRITING.
15. ALL EXISTING UTILITIES BEING REMOVED SHALL BE DONE SO BY THE CONTRACTOR IN ACCORDANCE WITH STATE AND LOCAL REGULATIONS.
16. CONTRACTOR SHALL ENSURE PROPER EROSION CONTROL IS PROVIDED THROUGHOUT THE ENTIRE DURATION OF THE PROJECT.
17. ALL EXISTING FEATURES (I.E. EXISTING BUILDING FOUNDATIONS, UTILITIES) SHALL BE REMOVED FROM AND WILLL NOT BE USED AS SUPPORT FOR BUILDING, DOCUMENT, AND LONG DOME RETAINING WALL.
18. ALL EXISTING UTILITIES TO BE ABANDONED SHALL BE REMOVED IF THE DIAMETER IS GREATER THAN 12 INCHES OR GRILLED FULL IF LEFT IN PLACE. ALL DISCONNECTIONS AND CAPPING OF EXISTING UTILITIES MUST BE PERFORMED PER THE REQUIREMENTS OF THE AUTHORITIES HAVING JURISDICTION.
19. THE CONTRACTOR SHALL BE RESPONSIBLE FOR ALL PHASING OF DEMOLITION WHEN THAT DEMOLITION MAY IMPACT TRAFFIC, ACCESS TO UTILITIES TO NEIGHBORS, OR FACILITIES TO REMAIN AND OTHER SURROUNDING INVESTIGATING OR PROTOTYPING.
20. AND REMAINING SIDEWALK NOT BEING DEMOLISHED SHOULD BE REPAVED TO LIKE NEW CONDITION.

10
5 2.5 0 10
1' = 10'

MATCHLINE - SHEET C-203

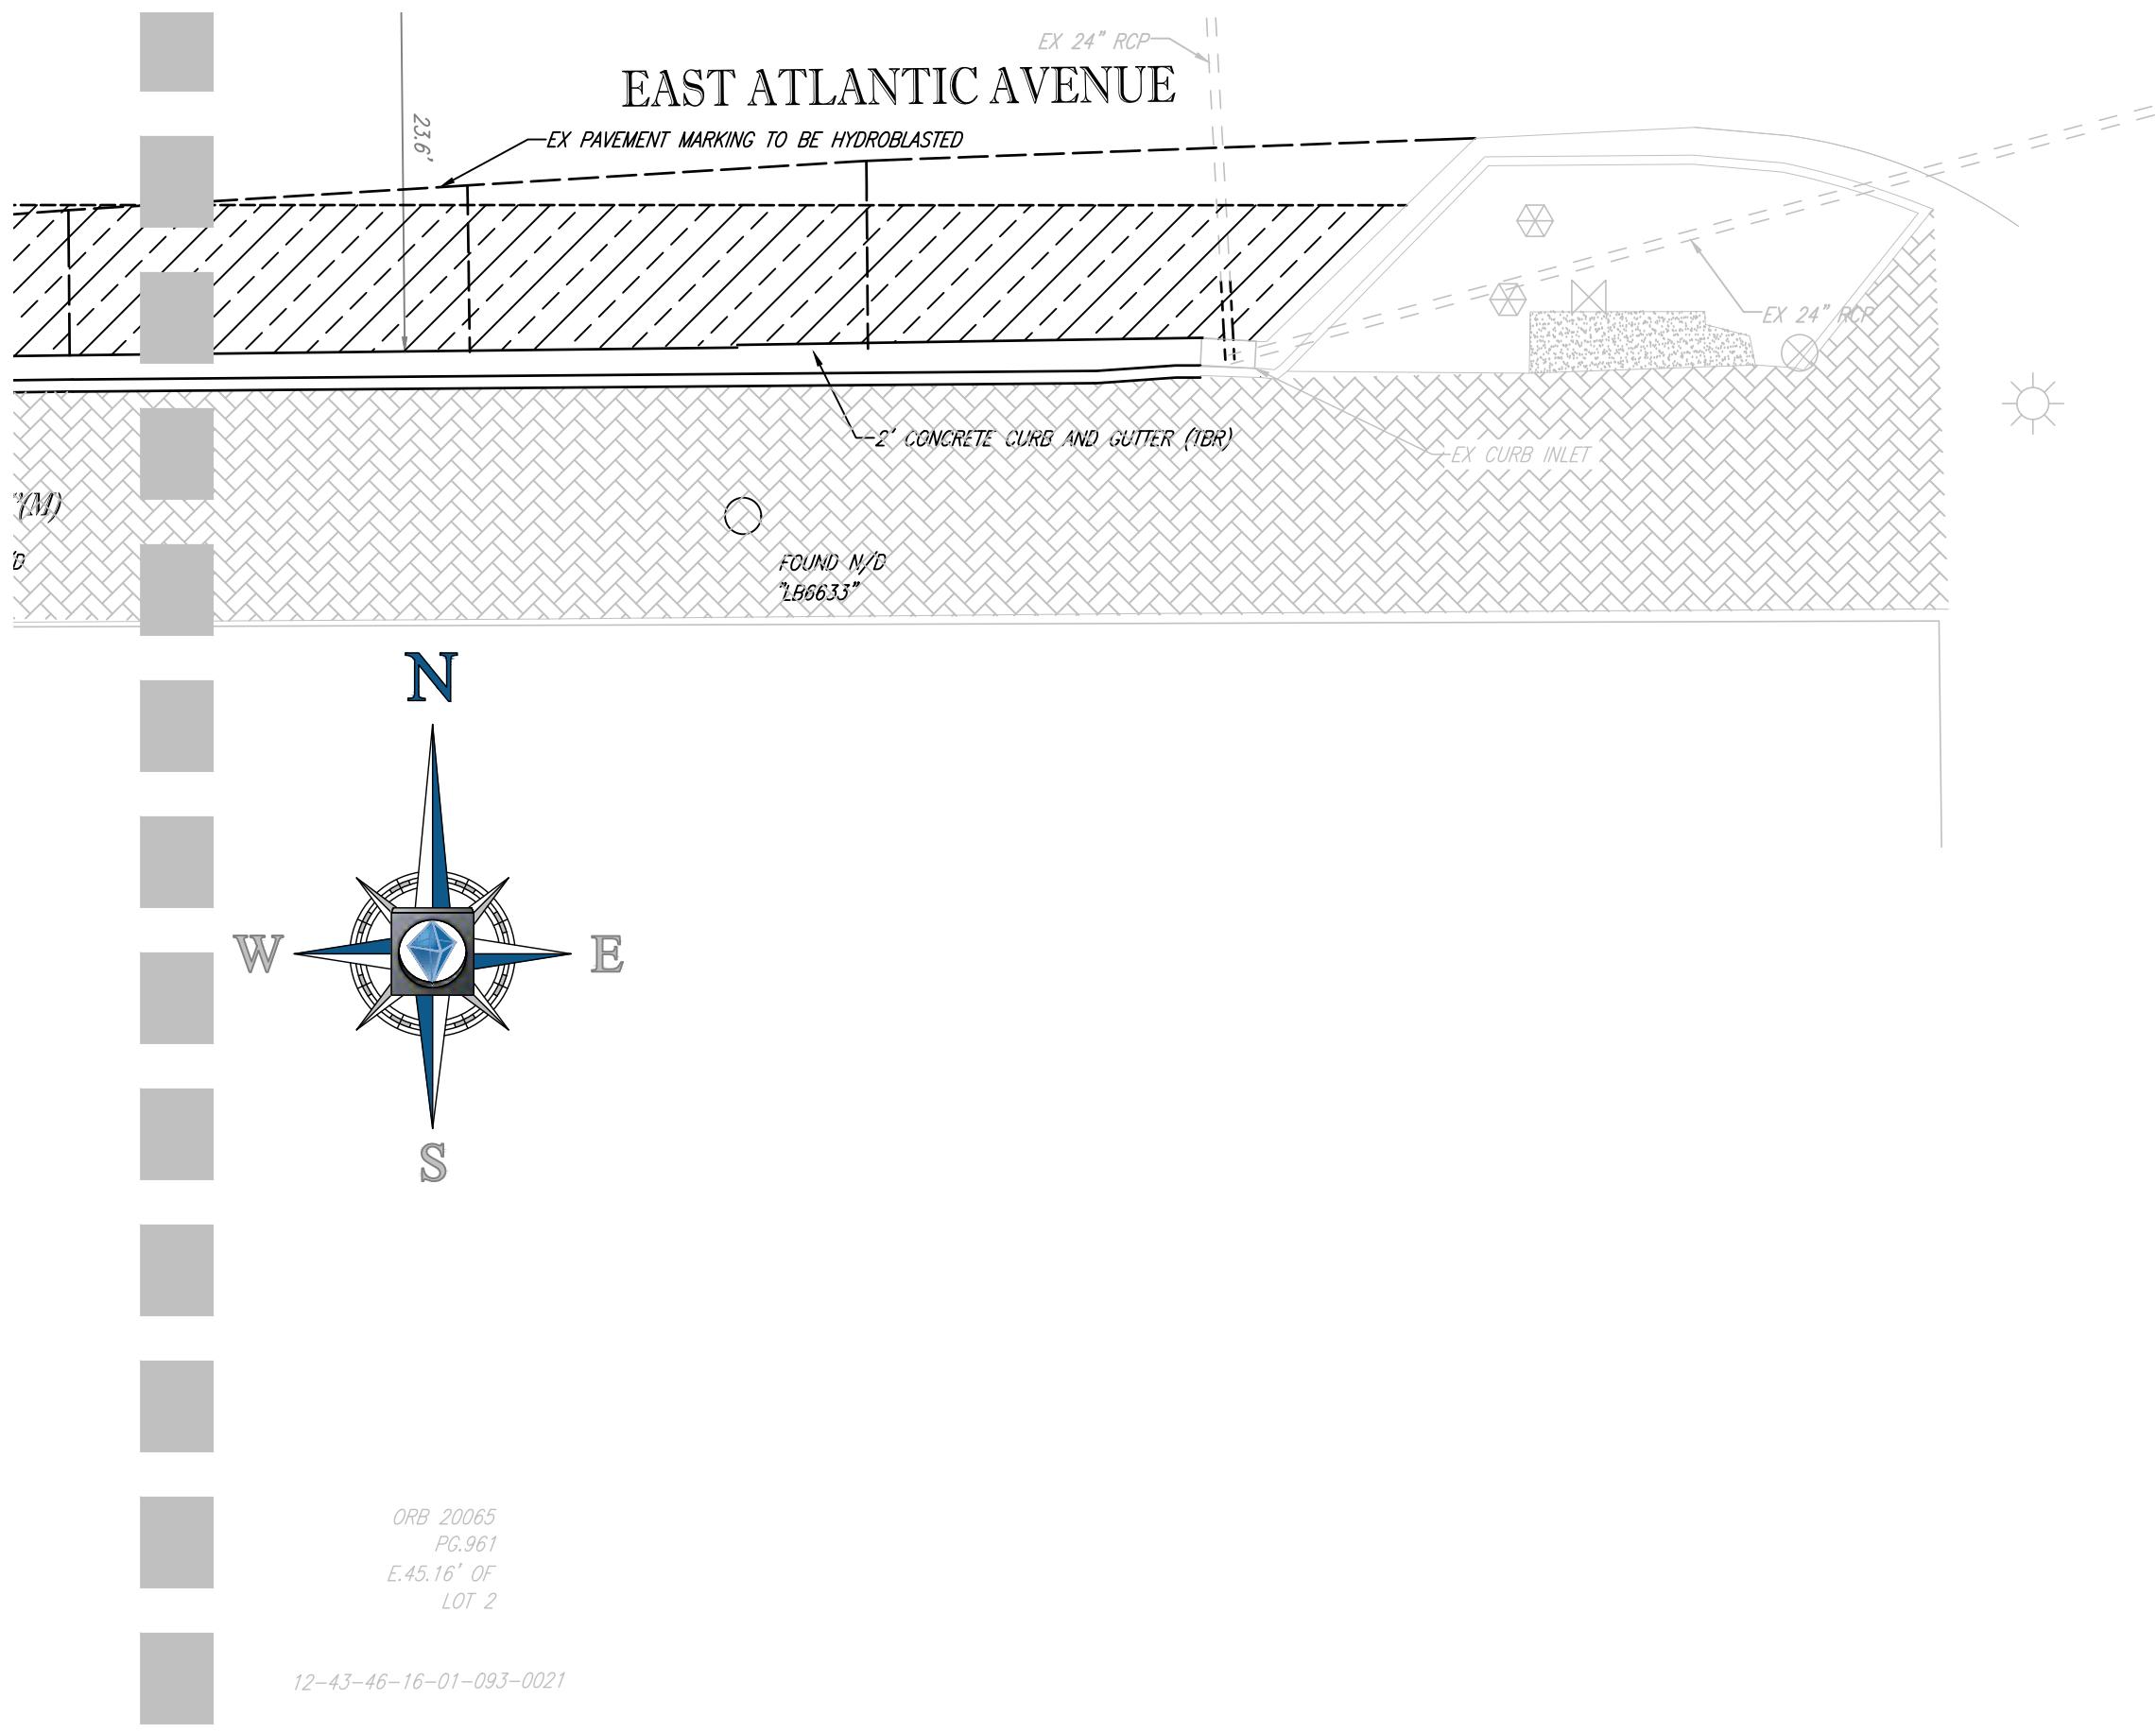

ORB 20065
PG.961
E.45.16' OF
LOT 2



SION

LEGEND:

EX PROPERTY BOUNDARY LINES
PROP PROPERTY BOUNDARY LINES
EX STORM STRUCTURES TO BE REMOVED
(TBD)
TO BE REMOVED
EX PAVERS TO BE REMOVED
EX SURFACE TO BE REMOVED
EX STORM PIPE TO BE REMOVED
EX SPOT GRADE
EX POLE TO BE REMOVED
EX POLE TO REMAIN
EX SANITARY MANHOLE
EX SANITARY LINE
EX STORM SEWER PIPE
EX WATER LINE
EX OVERHEAD WIRE
EX SANITARY LINE TO BE REMOVED
EX WATER LINE TO BE REMOVED
EX OVERHEAD WIRE TO BE REMOVED
EX LIGHT POLE TO BE REMOVED
EX LIGHT POLE TO REMAIN
EX CATCH BASIN TO REMAIN
EX CLEAN OUT TO BE REMOVED
EX TREES TO BE REMOVED

REVISIONS		
REV	DATE	COMMENT
1	2019-08-23	CITY OF DELRAY BEACH COMMENTS L JL AS
2	2019-09-10	SPRAB COMMENTS L JL AS



ISSUED FOR MUNICIPAL & AGENCY REVIEW & APPROVAL


PROJECT No.: FLB180120
DRAWN BY: L JL
CHECKED BY: AS
DATE: 2019-10-25
CAD I.D.: FLB180120-DMP-1

PROJECT:
PIERRE DELRAY PHASE 1 - SPRAB SITE PLAN PACKAGE (AKA SUNTRUST BUILDING)

FOR

ZYSCOVICH
ARCHITECTS
PROPOSED DEVELOPMENT
302 E ATLANTIC AVE
PALM BEACH COUNTY
DELRAY BEACH, FL

BOHLER
ENGINEERING
2255 GLADES ROAD, SUITE 305E
BOCA RATON, FLORIDA 33431
Phone: (561) 571-0280
Fax: (561) 571-0281
FLORIDA BUSINESS CERT. OF AUTH. No. 30780
LANDSCAPE ARCHITECT BUSINESS Lic. No. C26000531

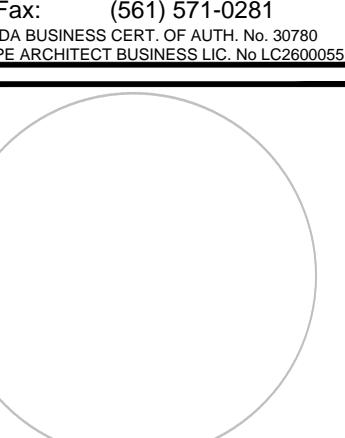

SHEET TITLE:


DEMOLITION PLAN
SHEET NUMBER:
C-202



REVISION 2 - 2019-09-10

DEMOLITION NOTES:

1. BOHLER ENGINEERING FL, LLC IS NOT RESPONSIBLE FOR JOB SITE SAFETY OR SUPERVISION. CONTRACTOR IS TO PROCEED WITH THE DEMOLITION IN A SYSTEMATIC AND SAFE MANNER, FOLLOWING ALL THE OSHA REQUIREMENTS, TO ENSURE PUBLIC AND CONTRACTOR SAFETY.
2. ALL DEMOLITION ACTIVITIES ARE TO BE PERFORMED IN ACCORDANCE WITH THESE PLANS AND SPECIFICATIONS AS WELL AS ALL FEDERAL, STATE AND LOCAL REGULATIONS. ANY DISCREPANCIES OR DEVIATIONS SHALL BE IDENTIFIED BY THE CONTRACTOR TO BOHLER ENGINEERING FL, LLC IN WRITING FOR RESOLUTION PRIOR TO INITIATION OF SITE ACTIVITY.
3. PRIOR TO STARTING ANY DEMOLITION CONTRACTOR IS RESPONSIBLE FOR TO:
 - A. THE CONTRACTOR SHALL OBTAIN A SUNSHINE STATE ONE CALL LOCATION CERTIFICATION PRIOR TO ANY EXCAVATION OR DEMOLITION. THE NUMBER IS 1-800-432-4770.
 - B. ENFORCING COPIES OF ALL PERMITS AND APPROVALS MUST BE MAINTAINED ON SITE AND AVAILABLE FOR REVIEW.
 - C. INSTALLING THE REQUIRED SOIL EROSION AND SEDIMENT CONTROL MEASURES PRIOR TO SITE DISTURBANCE.
 - D. LOCATE/CAP ALL UTILITIES AND SERVICES, INCLUDING BUT NOT LIMITED TO GAS, WATER, ELECTRIC, SANITARY AND STORM SEWER, TELEPHONE, CABLE, FIBER OPTIC CABLE, ETC. WITHIN THE LIMITS OF DISTURBANCE.
 - E. PRIOR TO COMMENCING DEMOLITION IN OPERATION, ALL ACTIVE SYSTEM THAT ARE NOT BEING REMOVED DURING ALL DEMOLITION ACTIVITIES.
 - F. FAMILIARIZING THEMSELVES WITH THE APPLICABLE UTILITY SERVICE PROVIDER AND IS RESPONSIBLE FOR ALL COORDINATION REGARDING UTILITY DEMOLITION REQUIRED FOR THE PROJECT. THE CONTRACTOR SHALL PROVIDE THE OWNER WRITTEN NOTIFICATION THAT THE EXISTING UTILITIES AND SERVICES HAVE BEEN TERMINATED AND ABANDONED IN ACCORDANCE WITH THE JURISDICTIONAL UTILITY COMPANY REQUIREMENTS.
 - G. COORDINATION WITH UTILITY COMPANIES REGARDING WORK IN OFF-PEAK HOURS OR ON WEEKENDS AS MAY BE REQUIRED TO MINIMIZE THE IMPACT ON THE AFFECTED PARTIES.
 - H. A COMPLETE INSPECTION OF CONTAMINANTS BY A LICENSED ENVIRONMENTAL TESTING AGENCY, OF ALL BUILDINGS AND/OR STRUCTURES TO BE REMOVED. SAM SHALL BE PERFORMED IN ACCORDANCE WITH ALL APPLICABLE LOCAL, STATE, AND FEDERAL ENVIRONMENTAL REGULATIONS. ANY CONTAMINANTS SHALL BE REMOVED AND DISPOSED BY A FEDERALLY LICENSED CONTRACTOR IN ACCORDANCE WITH FEDERAL, STATE, AND LOCAL REGULATIONS. ALL ENVIRONMENTAL WORK INCLUDING HAZARDOUS MATERIAL, SOILS, ASBESTOS, OR OTHER REFERENCED OR IMPLIED HEREIN IS THE SOLE RESPONSIBILITY OF THE OWNERS ENVIRONMENTAL CONSULTANT.
4. THE CONTRACTOR SHALL PROVIDE ALL THE "MEANS AND METHODS" NECESSARY TO PREVENT MOVEMENT, SETTLEMENT, OR COLLAPSE OF EXISTING STRUCTURES, AND ANY OTHER IMPROVEMENTS THAT ARE REMAINING ON OR OFF SITE. THE DEMOLITION CONTRACTOR IS RESPONSIBLE FOR ALL REPAIRS OF DAMAGE TO ALL ITEMS THAT ARE TO REMAIN AS A RESULT OF HIS ACTIVITIES. ALL REPAIRS SHALL USE NEW MATERIAL. THE REPAIRS SHALL RESTORE THE ITEM TO THE PRE-DEMOLITION CONDITION.
5. IN THE ABSENCE OF SPECIFICATIONS, THE CONTRACTOR SHALL PERFORM EARTH MOVEMENT ACTIVITIES, DEMOLITION AND REMOVAL OF ALL FOUNDATION WALLS, FOOTINGS, AND OTHER MATERIALS WITHIN THE LIMITS OF DISTURBANCE IN ACCORDANCE WITH DIRECTION BY OWNER'S STRUCTURAL OR GEOTECHNICAL ENGINEER.
6. EXPLOSIVES SHALL NOT BE USED WITHOUT PRIOR WRITTEN CONSENT OF BOTH THE OWNER AND APPLICABLE GOVERNMENTAL AUTHORITY. THE CONTRACTOR SHALL NOT USE EXPLOSIVES FOR DEMOLITION UNLESS REQUIRED BY THE FEDERAL, STATE, AND LOCAL GOVERNMENTS SHALL BE IN PLACE PRIOR TO STARTING AN EXPLOSIVE PROGRAM. THE CONTRACTOR IS ALSO RESPONSIBLE FOR ALL INSPECTION AND SEISMIC VIBRATION TESTING THAT IS REQUIRED TO MONITOR THE EFFECTS ON ALL LOCAL STRUCTURES.
7. CONTRACTOR SHALL PROVIDE TRAFFIC CONTROL AND GENERALLY ACCEPTED SAFE PRACTICES IN CONFORMANCE WITH THE "MANUAL ON UNIFORM TRAFFIC CONTROL", AS WELL AS FEDERAL, STATE, AND LOCAL REGULATIONS WHEN DEMOLITION RELATED ACTIVITIES IMPACT ROADWAYS OR ROADWAY RIGHTS - OF - WAY.
8. CONDUCT DEMOLITION ACTIVITIES IN SUCH A MANNER TO ENSURE MINIMUM INTERFERENCE WITH ROADS, STREETS, SIDEWALKS, WALKWAYS, AND OTHER ADJACENT FACILITIES. STREET CLOSURE PERMITS MUST BE RECEIVED FROM THE APPROPRIATE GOVERNMENTAL AUTHORITY.
9. DEMOLITION ACTIVITIES AND EQUIPMENT SHALL NOT USE AREAS OUTSIDE THE DEFINED PROPERTY LINE WITHOUT WRITTEN PERMISSION OF THE OWNER, AND/OR APPROPRIATE GOVERNMENTAL AGENCY.
10. USE DUST CONTROL MEASURES TO LIMIT AIRBORNE DUST AND DIRT RISING, AND SCATTERING IN THE AIR IN ACCORDANCE WITH FEDERAL, STATE, AND/OR LOCAL STANDARDS. AFTER THE DEMOLITION IS COMPLETE, ADJACENT STRUCTURES AND IMPROVEMENTS SHALL BE CLEANED OF ALL DUST AND DEBRIS CAUSED BY THE DEMOLITION OPERATIONS. THE CONTRACTOR IS RESPONSIBLE FOR RETURNING ALL ADJACENT AREAS TO THEIR "PRE-DEMOLITION" CONDITION.
11. CONTRACTOR IS RESPONSIBLE TO SAFEGUARD SITE AS NECESSARY TO PERFORM THE DEMOLITION IN SUCH A MANNER AS TO PREVENT THE ENTRY OF UNAUTHORIZED PERSONS AT ANY TIME.
12. THIS DEMOLITION PLAN IS INTENDED TO IDENTIFY THOSE EXISTING ITEMS/CONDITIONS WHICH ARE TO BE REMOVED. IT IS NOT INTENDED TO PROVIDE DIRECTION OTHER THAN THAT ALL METHODS AND MEANS ARE TO BE IN ACCORDANCE WITH STATE, FEDERAL, LOCAL, AND JURISDICTIONAL REQUIREMENTS. THE CONTRACTOR SHALL BE RESPONSIBLE FOR ALL OSHA AND OTHER SAFETY PRECAUTIONS NECESSARY TO PROVIDE A SAFE WORK SITE.
13. DEBRIS SHALL NOT BE BURIED ON THE SUBJECT SITE. ALL DEMOLITION WASTES AND DEBRIS (SOLID WASTE) SHALL BE DISPOSED OF IN ACCORDANCE WITH ALL TOWN, COUNTY, STATE, AND FEDERAL LAWS AND APPLICABLE CODES.
14. CONTRACTOR IS RESPONSIBLE FOR FIELD VERIFYING ALL EXISTING SITE IMPROVEMENTS AND UTILITIES. ALL DISCREPANCIES SHALL BE IDENTIFIED TO THE ENGINEER IN WRITING.
15. ALL EXISTING UTILITIES BEING REMOVED SHALL BE DONE SO BY THE CONTRACTOR IN ACCORDANCE WITH STATE AND LOCAL REGULATIONS.
16. CONTRACTOR SHALL ENSURE PROPER EROSION CONTROL IS PROVIDED THROUGHOUT THE ENTIRE DURATION OF THE PROJECT.
17. ALL EXISTING FEATURES (I.E. EXISTING BUILDING FOUNDATIONS, UTILITIES) SHALL BE REMOVED FROM AND WITHEIN 10' OF THE PROPERTY LINE OF THE BUILDING, DOWNTOWN, AND LONGWOOD RETAINING WALL.
18. ALL EXISTING UTILITIES TO BE ABANDONED SHALL BE REMOVED IF THE DIAMETER IS GREATER THAN 12 INCHES OR GROUTED FULL IF LEFT IN PLACE. ALL DISCONNECTIONS AND CAPPING OF EXISTING UTILITIES MUST BE PERFORMED PER THE REQUIREMENTS OF THE AUTHORITIES HAVING JURISDICTION.
19. THE CONTRACTOR SHALL BE RESPONSIBLE FOR ALL PHASING OF DEMOLITION WHEN THAT DEMOLITION MAY IMPACT TRAFFIC, ACCESS TO UTILITIES TO NEIGHBORS, OR FACILITIES TO REMAIN AND OTHER SURROUNDING INVESTIGATIONS ON A PHASING BASIS.
20. AND REMAINING SIDEWALK NOT BEING DEMOLISHED SHOULD BE REPAVED TO LIKE NEW CONDITION.

10 5 2.5 0 10
1'-10"

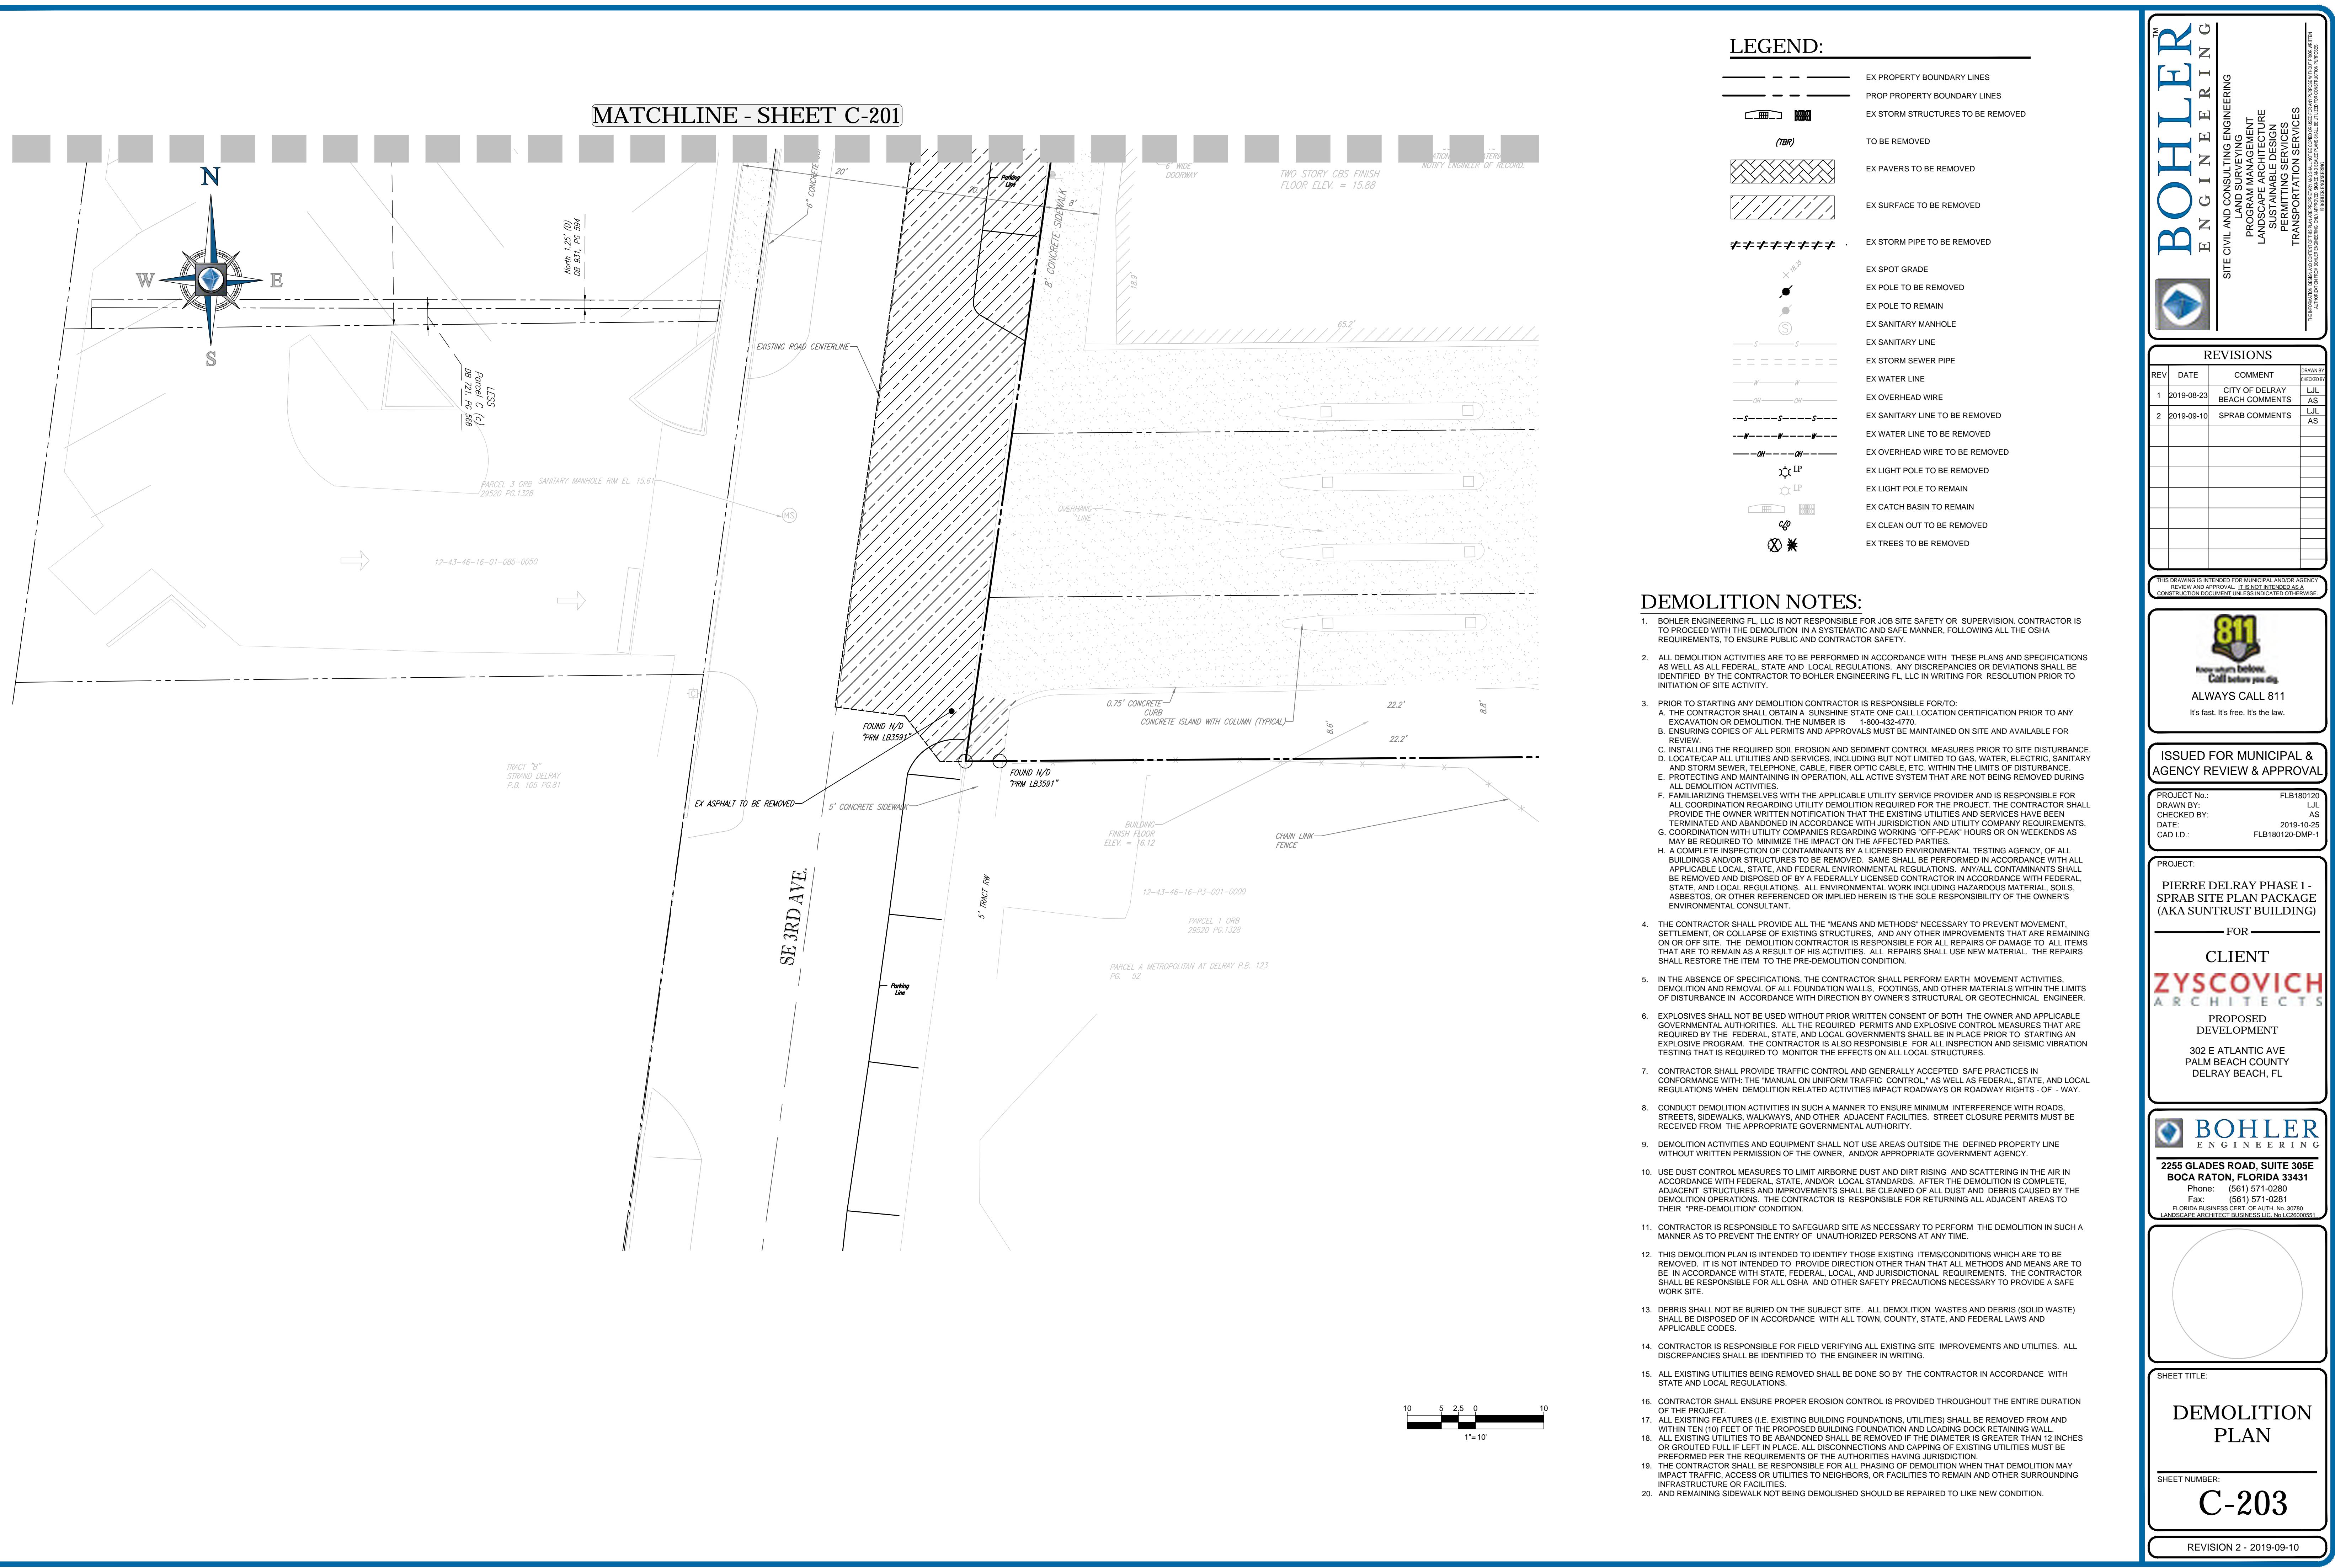

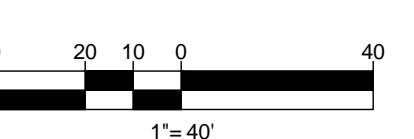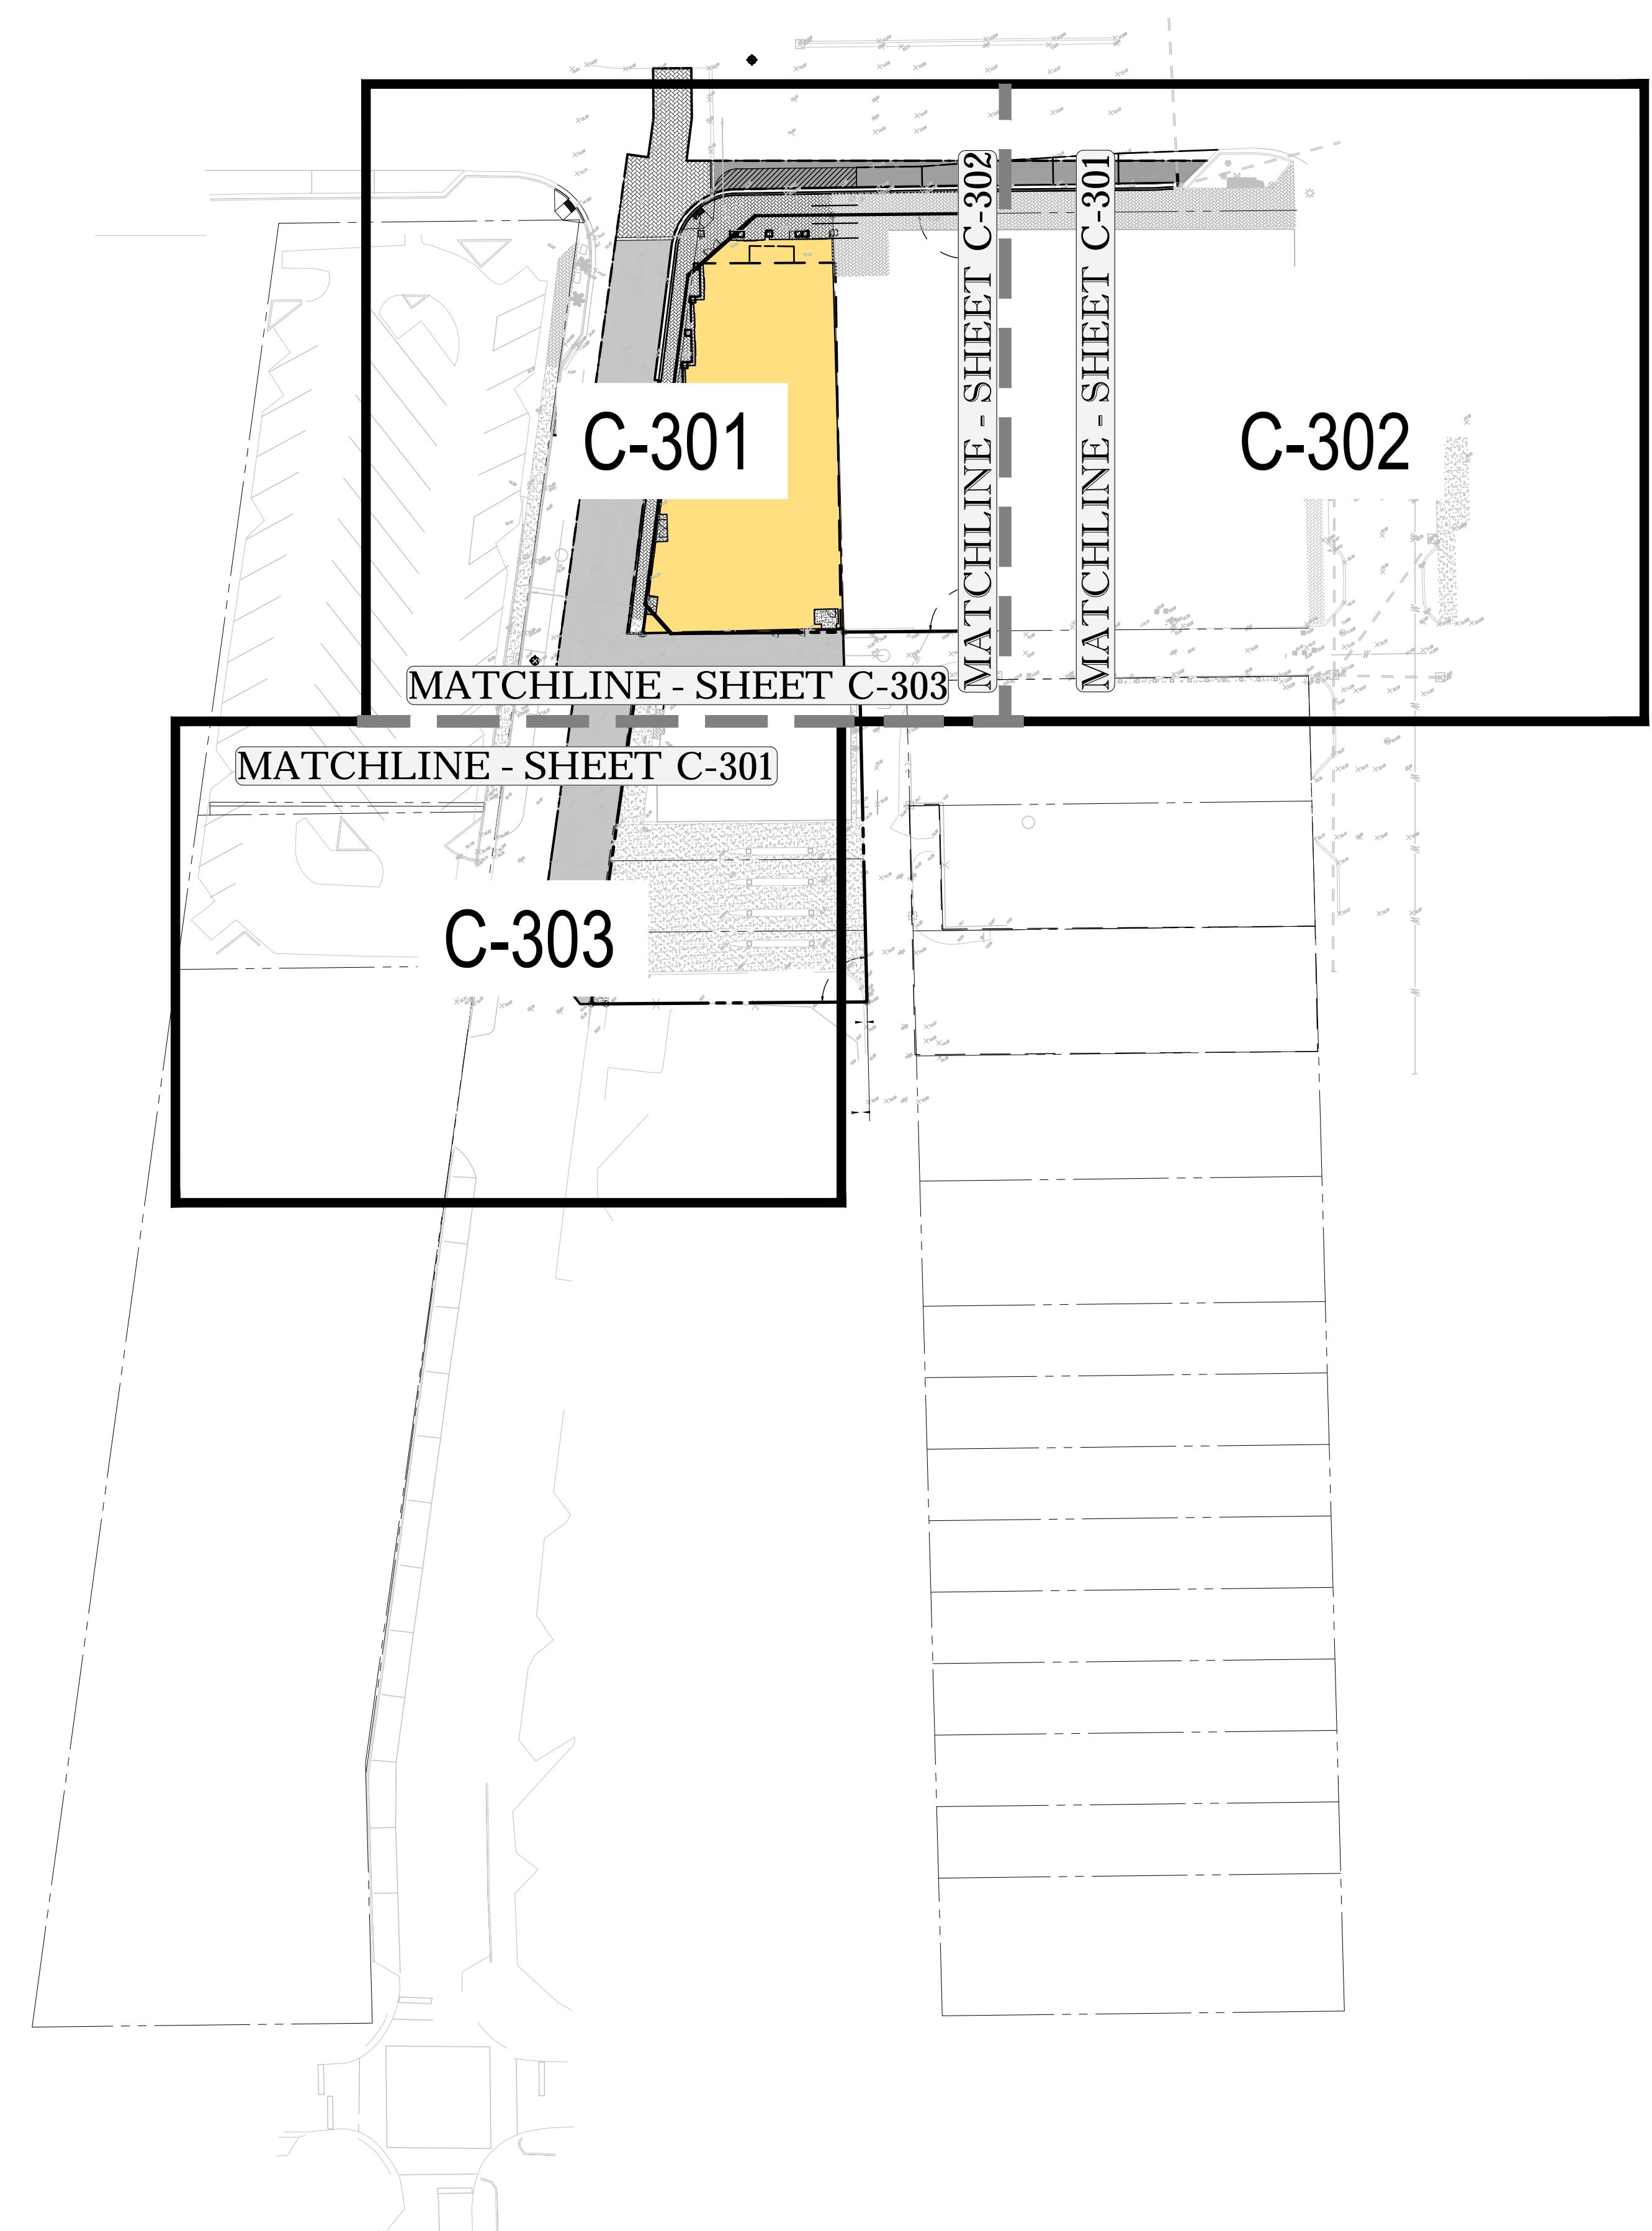

H:\2018\FLB180120\DRAWINGS\PLAN SETS\FLB180120-SSP-1.DWG PRINTED BY: LLUBIN 10.23.19 @ 2:57 PM LAST SAVED BY: LLU

BOHLER
E N G I N E E R I N G

SITE CIVIL AND CONSULTING ENGINEERING

- LAND SURVEYING
- PROGRAM MANAGEMENT
- LANDSCAPE ARCHITECTURE
- SUSTAINABLE DESIGN
- PERMITTING SERVICES
- TRANSPORTATION SERVICES

THE INFORMATION, DESIGN AND CONTENT OF THIS PLAN ARE PROPRIETARY AND SHALL NOT BE COPIED OR USED FOR ANY PURPOSE WITHOUT PRIOR WRITTEN AUTHORIZATION FROM BOHLER ENGINEERING. ONLY APPROVED, SIGNED AND SEALED PLANS SHALL BE UTILIZED FOR CONSTRUCTION PURPOSES.

© BOHLER ENGINEERING

REVISIONS			
REV	DATE	COMMENT	DRAWN BY
1	2019-08-23	CITY OF DELRAY BEACH COMMENTS	LJL AS ..

2	2019-09-10	SPRAB COMMENTS	LJL AS

THIS DRAWING IS INTENDED FOR MUNICIPAL AND/OR AGENCY
REVIEW AND APPROVAL. IT IS NOT INTENDED AS A
CONSTRUCTION DOCUMENT UNLESS INDICATED OTHERWISE.

811

ALWAYS CALL 811
It's fast. It's free. It's the law.

ISSUED FOR MUNICIPAL &
AGENCY REVIEW & APPROVAL

PROJECT No.:	FLB180120
DRAWN BY:	LJL
CHECKED BY:	AS
DATE:	2019-10-25
CAD L.D.:	FLB180120-SSP-1

PROJECT: PIERRE DEL RAY PHASE 1

PIERRE DELRAY PHASE I -
SPRAB SITE PLAN PACKAGE
(AKA SUNTRUST BUILDING)

FOR

CLIENT
ZYSCOVICH
ARCHITECTS
PROPOSED
DEVELOPMENT
302 E ATLANTIC AVE
PALM BEACH COUNTY
DELRAY BEACH, FL

LANDSCAPE ARCHITECT BUSINESS LIC. No LC26000551


SHEET TITLE: _____

SITE PLAN KEY SHEET

SHEET NUMBER: 6 800

C-300

REVISION 2 - 2019-09-10

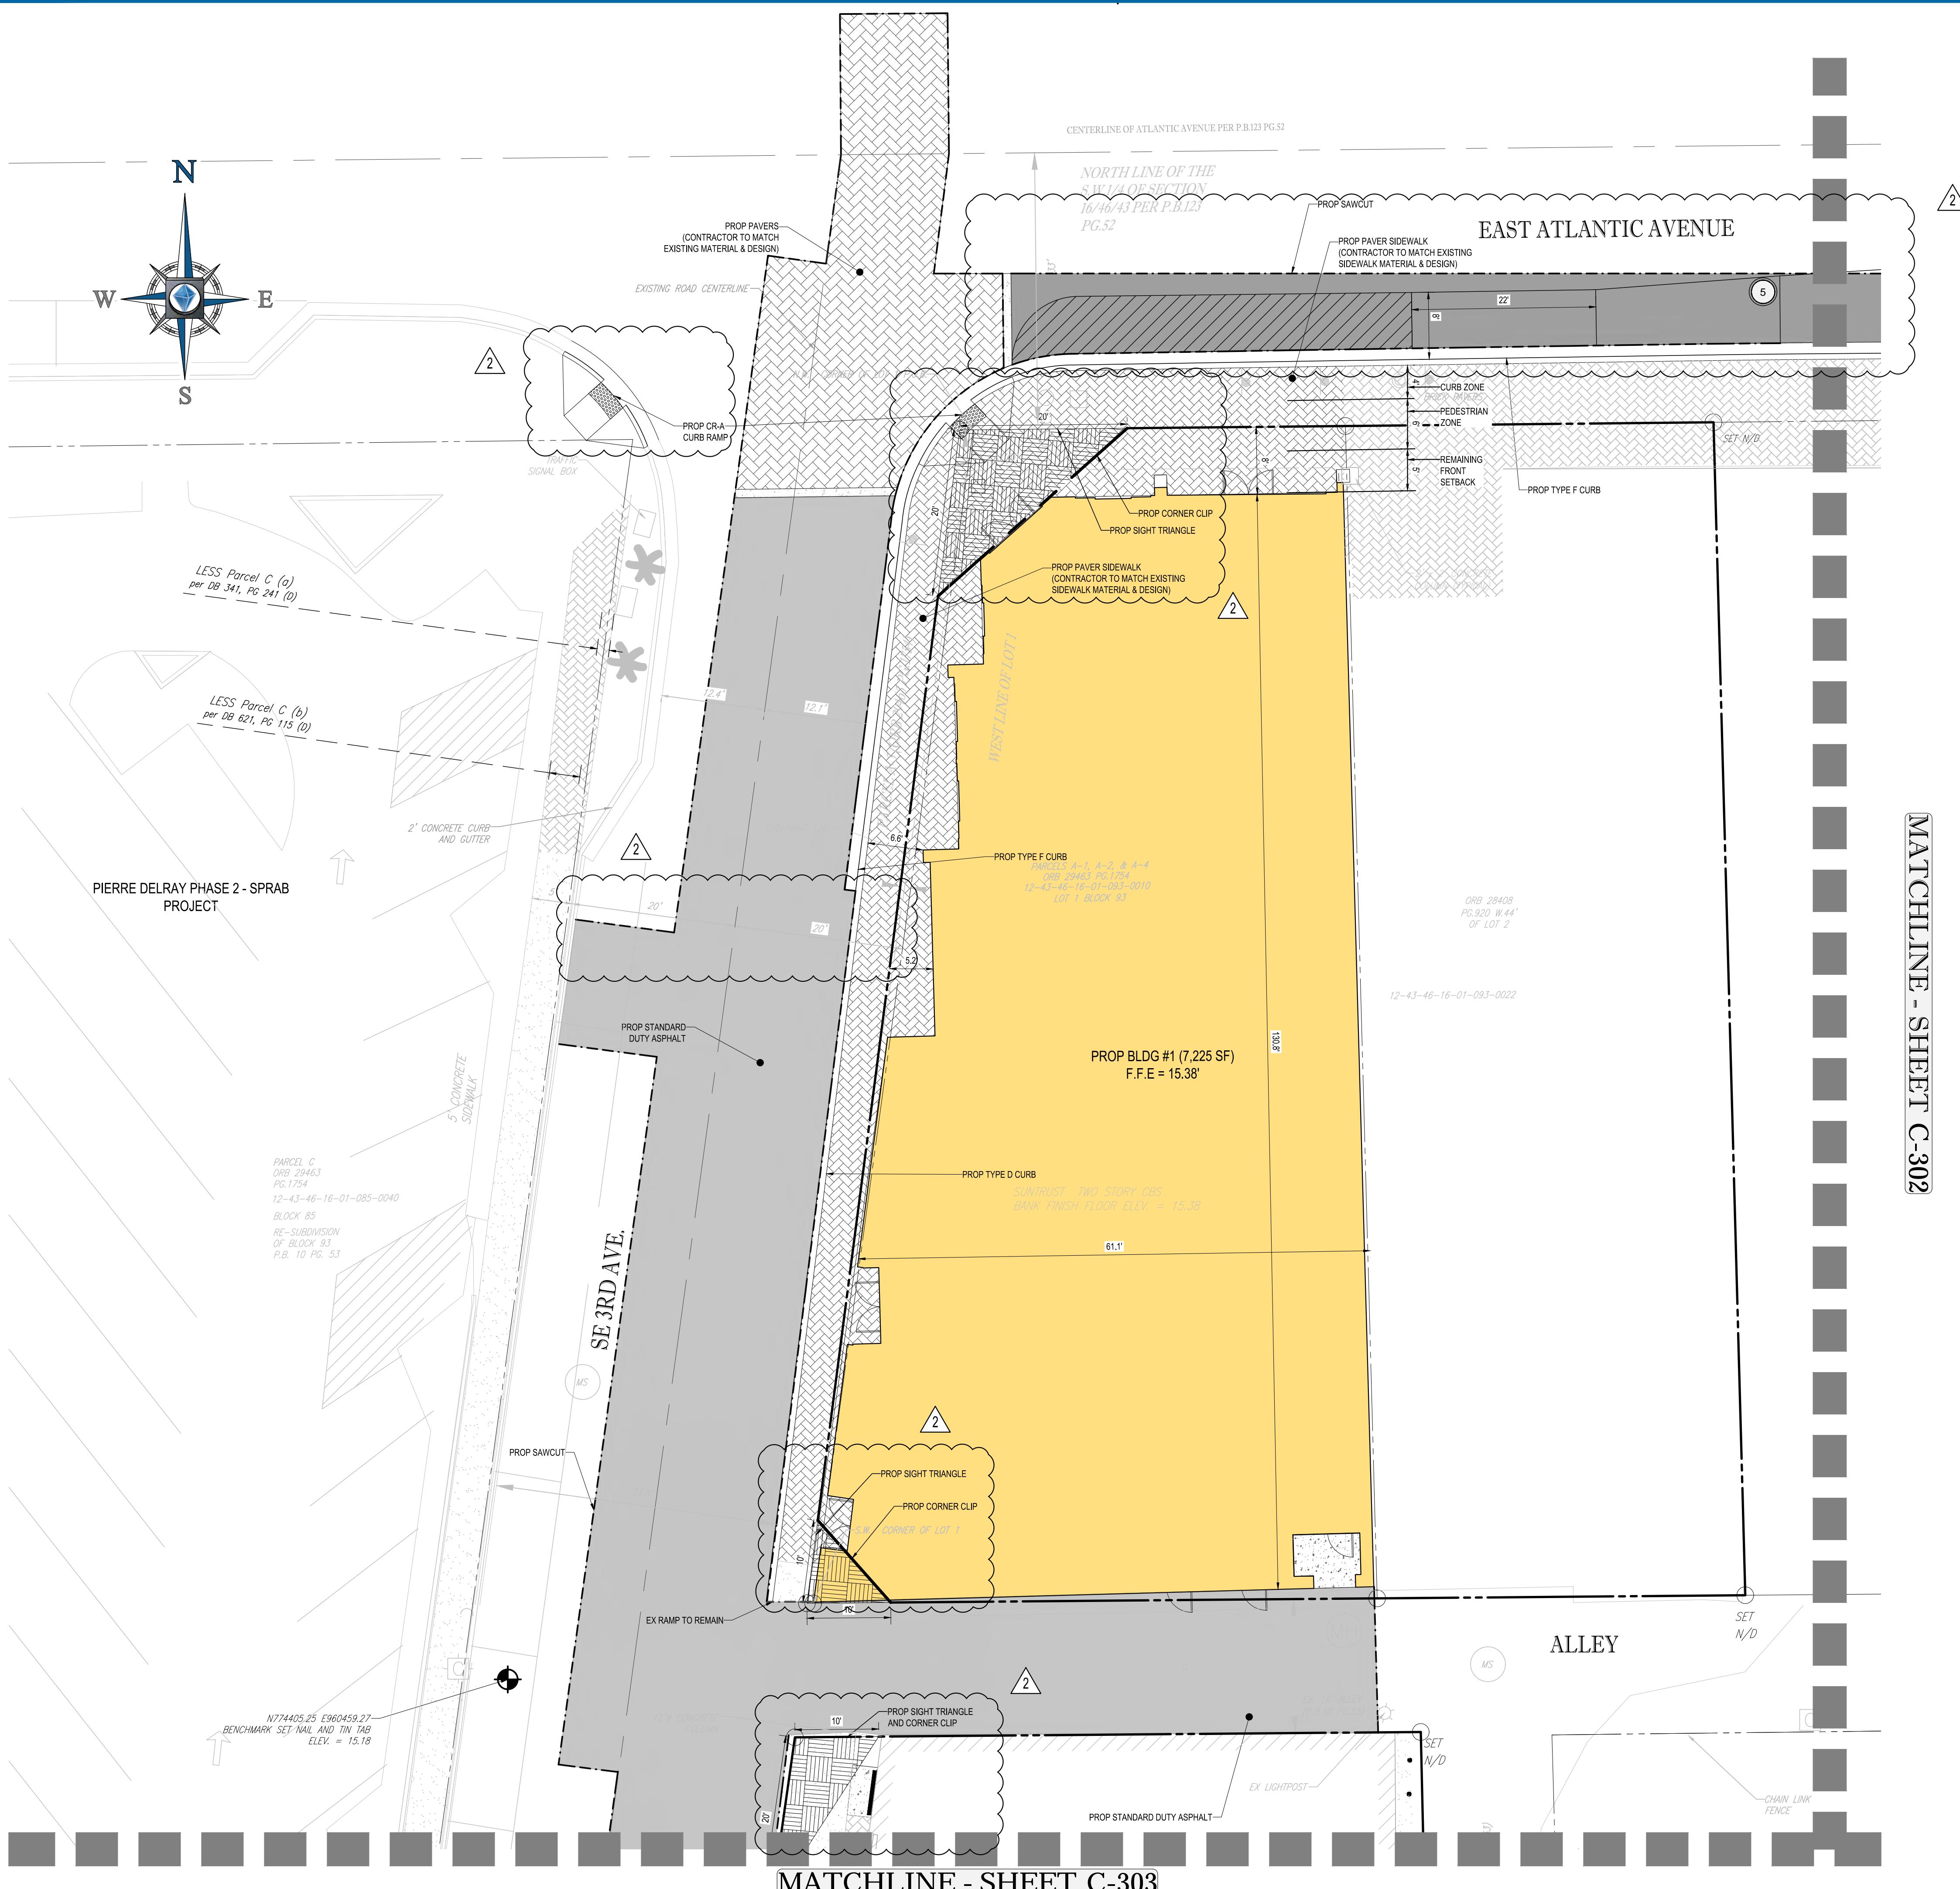

LEGEND:

- EX LEASE LINE
- EX ADJACENT BOUNDARY LINES
- EX EASEMENT LINES
- PROP BUILDING SETBACK
- PROP TYPE "D" CURB
- PROP TYPE "F" CURB
- PROP CONCRETE PAVEMENT
- PROP STANDARD ASPHALT
- PROP BRICK PAVERS
- PROP SIGHT TRIANGLE

REVISIONS			
REV	DATE	COMMENT	DRAWN BY
1	2019-08-23	CITY OF DELRAY BEACH COMMENTS	LJL
2	2019-09-10	SPRAB COMMENTS	LJL

THIS DRAWING IS INTENDED FOR MUNICIPAL AND/OR AGENCY USE. IT IS NOT DRAWN TO AS-RECEIVED CONSTRUCTION DOCUMENT LINEAR DIMENSIONS. IT IS TO BE USED AS A GUIDE ONLY.

SITE DATA TABLE

JURISDICTION	CITY OF DELRAY BEACH
OVERLAY DISTRICT	N/A
FUTURE LAND USE	COMMERCIAL CORE (CC)
SITE AREA	7,988 SF (0.18 AC)
BUILDING AREA	RETAIL: 7,225 SF (0.16 AC)
CURRENT ZONING	TOTAL: 7,225 SF (0.16 AC)
PROPOSED USE	CENTRAL BUSINESS DISTRICT (CBD)
MAX ALLOWED BUILDING HEIGHT	CENTRAL BUSINESS DISTRICT (CBD)
PROVIDED BUILDING HEIGHT	54' 4 STORIES
FRONT SETBACK	29'
SIDE SETBACK	10' MIN
REAR SETBACK	15' MAX
REQUIRED PARKING	0'
PROVIDED PARKING	10'
FEMA FLOOD ZONE	RETAIL: 14.45 SPACES (1 SPACE/500 SF)
	N/A
	FLOOD ZONE: X

SITE NOTES:


- ALL DIMENSIONS SHOWN ARE SHOWN AT FACE OF CURB, UNLESS OTHERWISE NOTED. B/C INDICATES DIMENSION IS TO BACK OF CURB. NAVD = NGVD - 1.5'
- ALL SIGNS SHALL BE REVIEWED AND PERMITTED SEPARATELY.
- THE PROJECT IS LOCATED IN 100 YEAR FLOOD ZONE "X" ACCORDING TO THE FLOOD INSURANCE RATE MAP, PANEL NUMBER 1209900979F OCTOBER 5, 2017, FOR PALM BEACH COUNTY, FLORIDA.
- ALL PAVEMENT MARKINGS, EXCEPT PARKING STALLS, SHALL BE "ALKY THERMOPLASTIC 90 MILS IN THICKNESS".
- SOD TO BE INSTALLED ON THE BACK OF ALL CURBS, PAVEMENT EDGES, SWALES AND DRAINS, AS WELL AS ALL AREAS OUTSIDE OF THE MAIN BUILDING AND HANGERS.
- IN THE EVENT THE PROJECT IS TERMINATED PRIOR TO CONSTRUCTION COMPLETION, THE PROJECT SHALL BE BROUGHT TO GRADE, SEDED, AND ALL DEBRIS AND MATERIALS SHALL BE HAULED OFF-SITE AND DUMPED AT A STATE OF FLORIDA APPROVED FACILITY.
- CONTRACTOR SHALL BE RESPONSIBLE THAT ALL ACCESSIBLE ROUTES MEET THE FLORIDA ACCESSIBILITY CODE PRIOR TO INSTALLING FINAL PAVEMENT AND CONCRETE.
- CONSTRUCTION PLAN APPROVAL DOES NOT EXEMPT THE CONTRACTOR FROM OBTAINING THE REQUIRED BUILDING, ELECTRICAL, PLUMBING AND MECHANICAL PERMITS. THESE INCLUDE BUT ARE NOT LIMITED TO ANY STRUCTURE, SIGN, WALL, ENCLOSURE, OR SCREEN, ETC.
- ALL CONSTRUCTION AND RESTORATION WORK WITHIN BROWARD COUNTY RIGHT OF WAY SHALL COMPLY WITH THE LATEST EDITION OF FDOT DESIGN STANDARDS AND THE FDOT STANDARD SPECIFICATIONS FOR ROAD AND BRIDGE CONSTRUCTION.
- ANY TREES OR SHRUBS PLACED WITHIN WATER, SEWER, OR DRAINAGE EASEMENTS SHALL CONFORM TO THE CITY OF DELRAY BEACH STANDARDS; LO 1.1 & LO 1.2.

ADA ACCESSIBILITY NOTES:

- ALL HANDICAPPED PARKING SPACES AND ACCESS AISLES ADJACENT TO THE HANDICAPPED PARKING SPACES SHALL HAVE A MAXIMUM OF 2% SLOPE IN ALL DIRECTIONS (THIS INCLUDES RUNNING SLOPE AND CROSS SLOPE).
- SLOPES EXCEEDING 5% BUT LESS THAN 8% WILL REQUIRE A RAMP AND MUST CONFORM TO THE REQUIREMENTS FOR RAMP DESIGN (HANDRAILS, CURBS, LANDSCAPE, NO RAMP SHALL EXCEED AN 8% RUNNING SLOPE OR 2% CROSS SLOPE).
- IN THE CASE THAT A NEW SIDEWALK WILL BE CONSTRUCTED IN THE RW OF A SITE THE RUNNING SLOPE OF THE SIDEWALK SHALL NOT EXCEED 5% AND THE CROSS SLOPE SHALL NOT EXCEED 2%. THIS STANDARD APPLIES TO CROSS WALKS IN THE DRIVEWAY AS WELL AND WILL REQUIRE SPECIAL ATTENTION DURING STAKING TO MAKE SURE THE 2% CROSS SLOPE IS MET IN THE CROSS WALK.
- IT WILL BE THE RESPONSIBILITY OF THE GENERAL CONTRACTOR TO ENSURE THAT THE HANDICAPPED PARKING SPACES, ACCESSIBLE ROUTES, AND SIDEWALKS/CROSSWALKS ARE CONSTRUCTED TO MEET ADA REQUIREMENTS.
- ANY SIDEWALKS OR CROSSWALKS THAT DO NOT CONFORM TO THE STANDARDS Brought to the Engineer's Attention IMMEDIATELY. ANYTHING NOT BUILT TO THE ABOVE STANDARDS WILL REQUIRE REMOVAL AND REPLACEMENT OF THE NON COMPLIANT AREAS AT THE GENERAL CONTRACTOR'S COST.
- ALL CONSTRUCTION TO COMPLY WITH THE AMERICANS WITH DISABILITIES ACT AND THE FLORIDA ACCESSIBILITY CODE.

BOHLER
ENGINEERING

2255 GLADES ROAD, SUITE 305E
BOCA RATON, FLORIDA 33431
Phone: (561) 571-0280
Fax: (561) 571-0281
FLORIDA BUSINESS CERT. OF AUTH. No. 30780
LANDSCAPE ARCHITECT BUSINESS LIC. No. C26000531

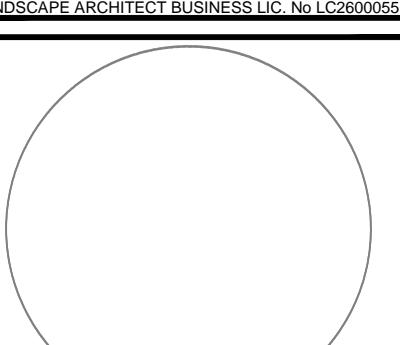


SHEET TITLE:


SITE
PLAN

SHEET NUMBER:
C-301

REVISION 2 - 2019-09-10

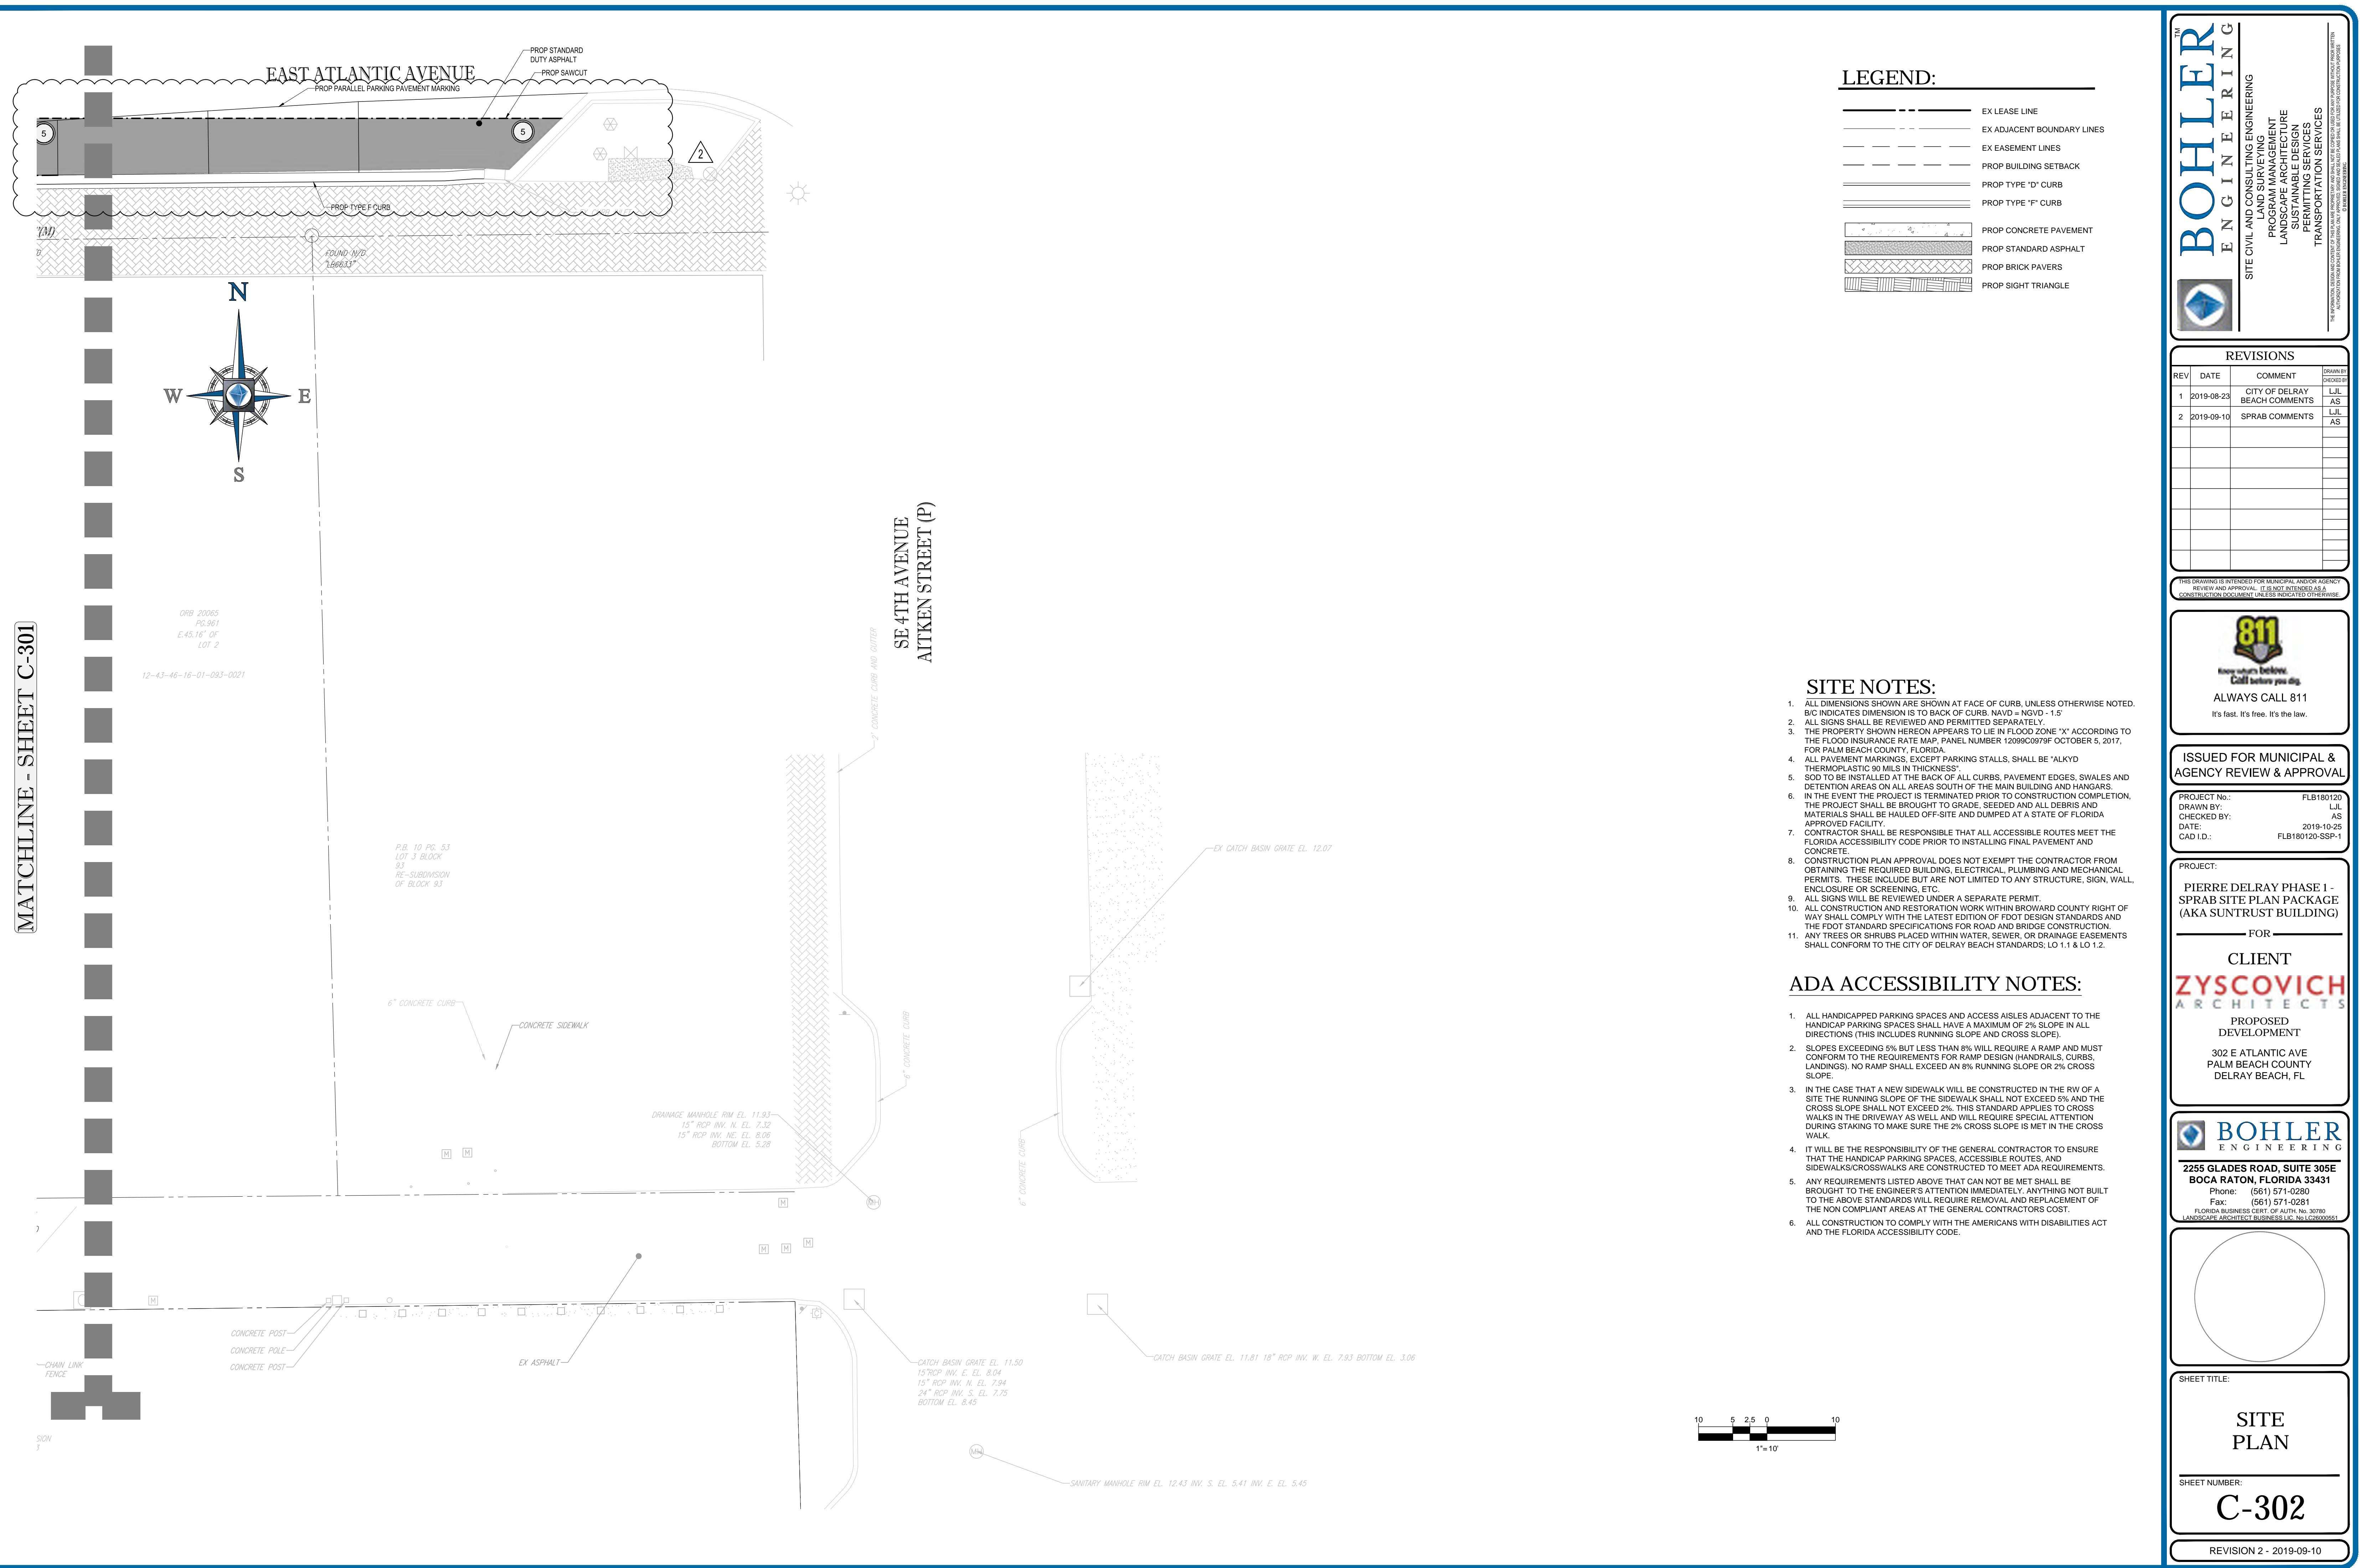


MATCHLINE - SHEET C-301

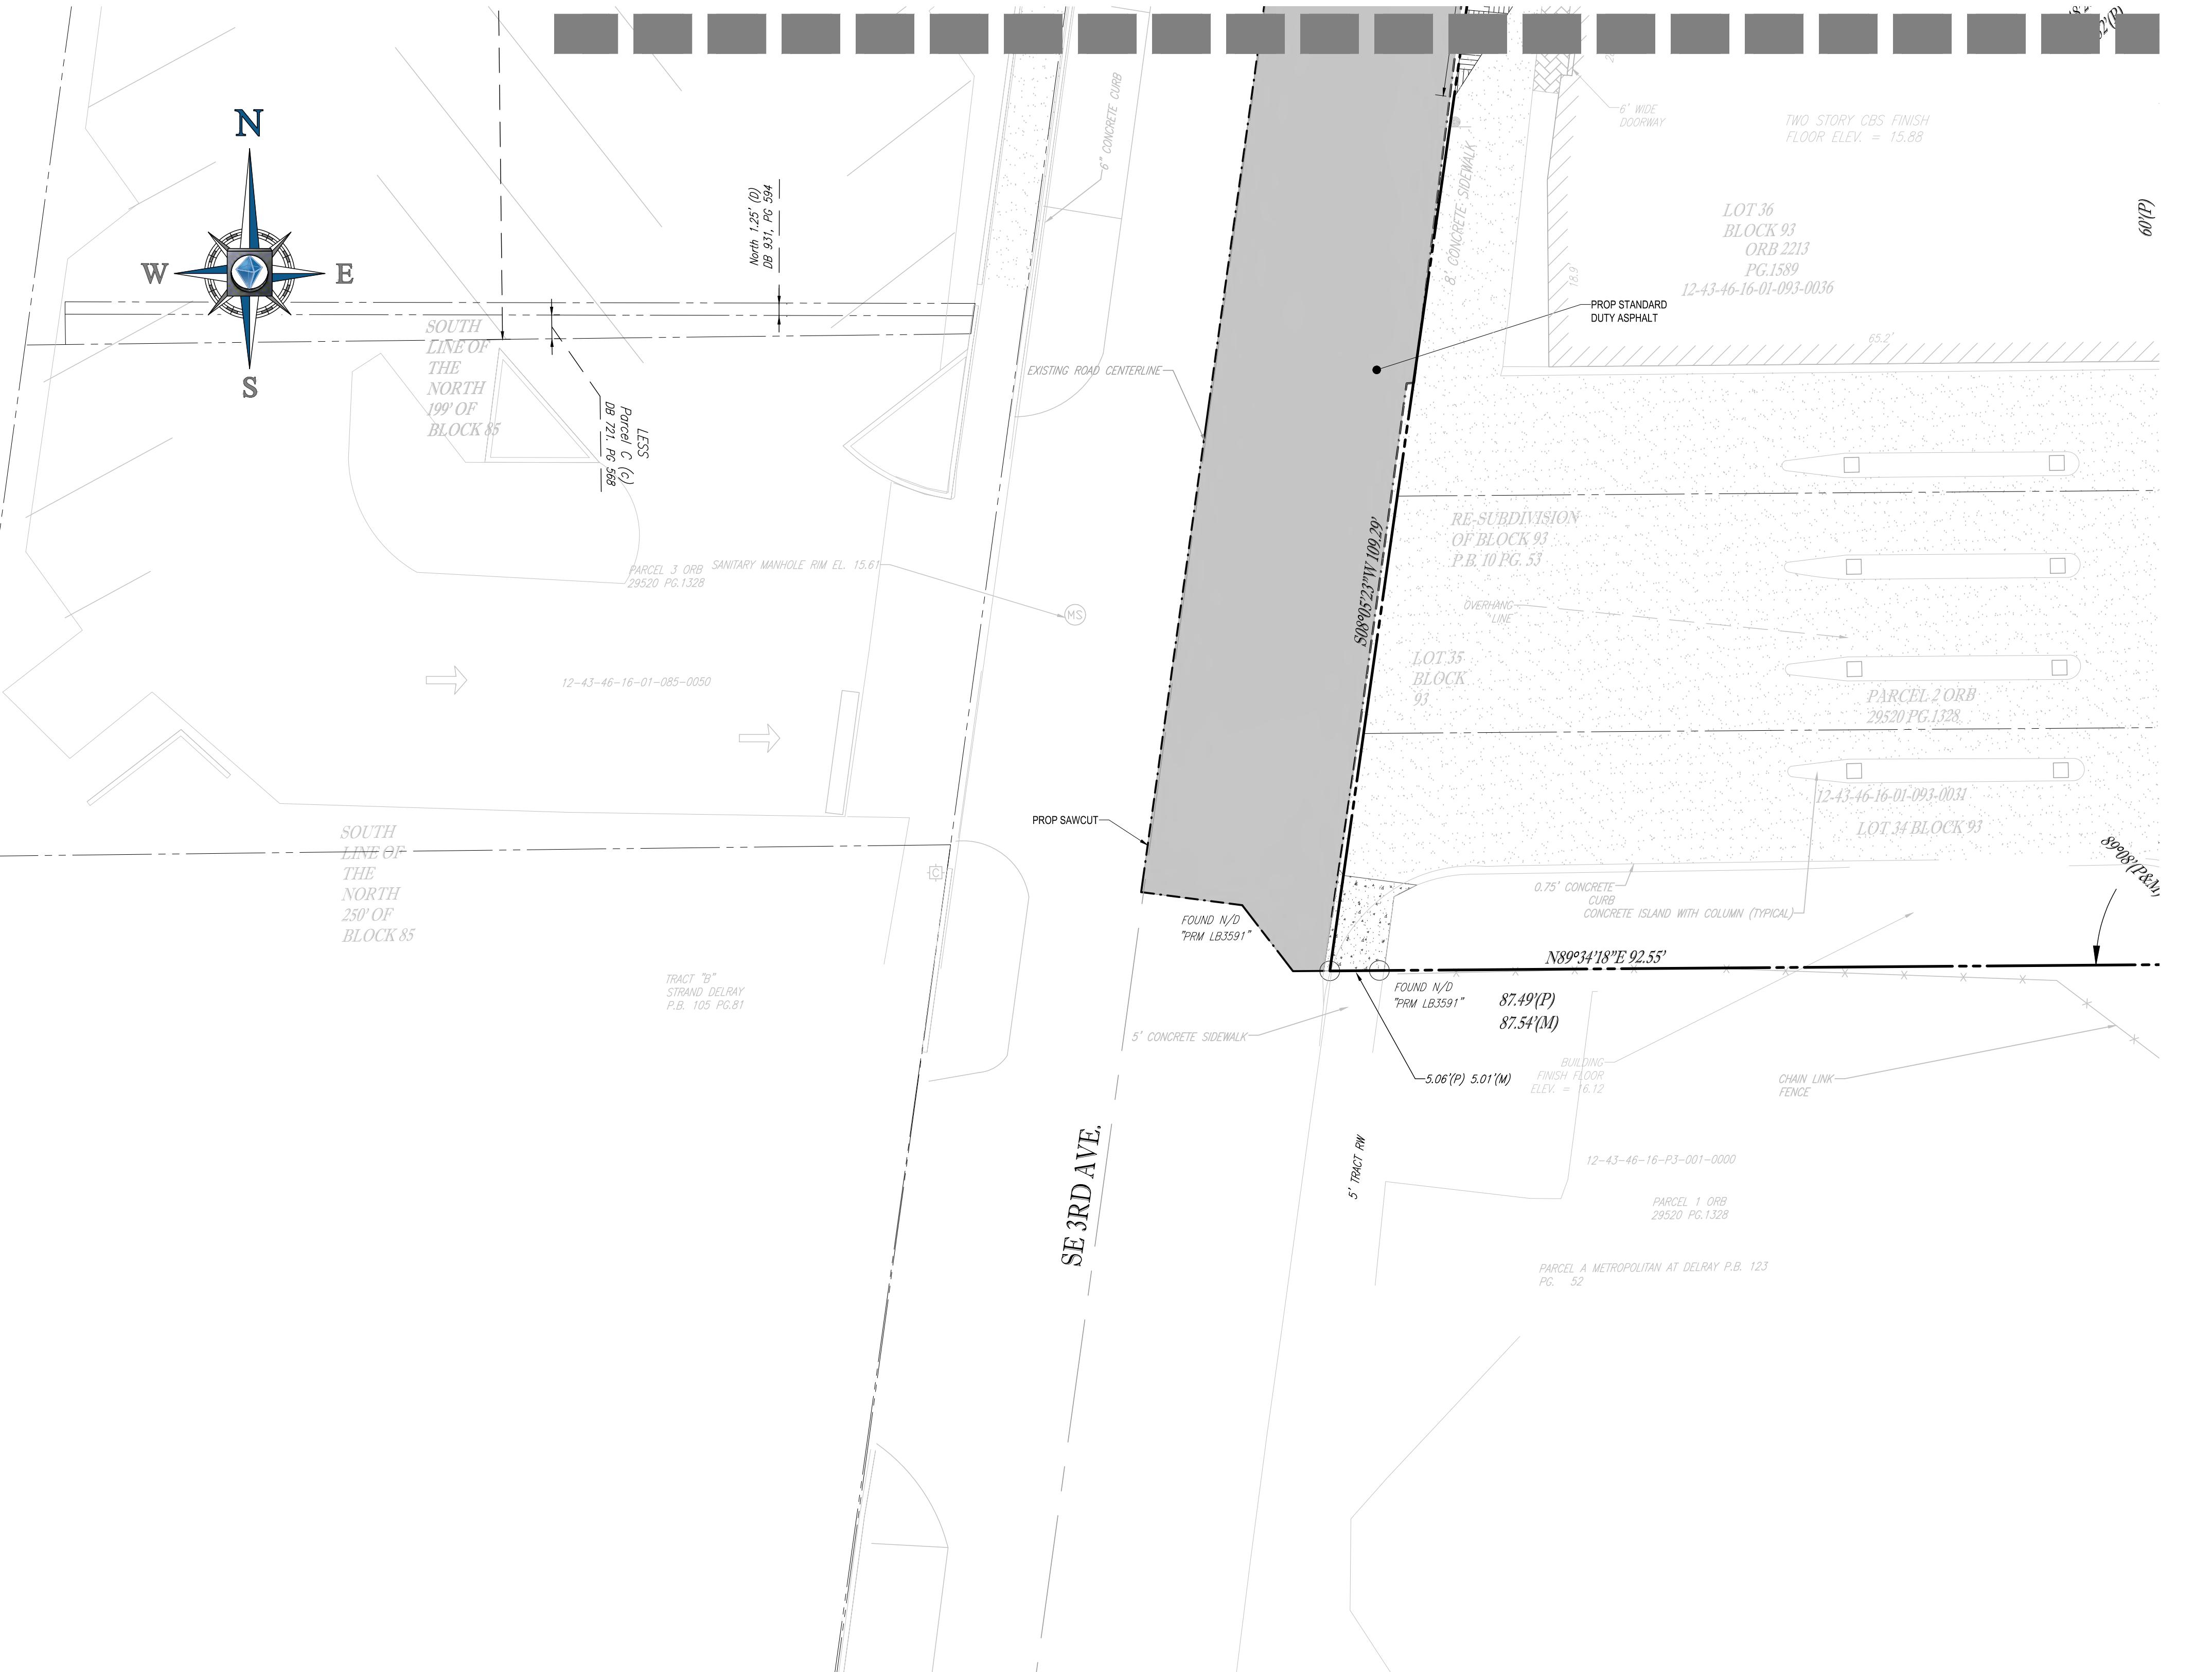

LEGEND:

	EX LEASE LINE
	EX ADJACENT BOUNDARY LINES
	EX EASEMENT LINES
	PROP BUILDING SETBACK
	PROP TYPE "D" CURB
	PROP CONCRETE PAVEMENT
	PROP STANDARD ASPHALT
	PROP BRICK PAVERS
	PROP SIGHT TRIANGLE

REVISIONS			
REV	DATE	COMMENT	DRAWN BY CHECKED BY
1	2019-08-23	CITY OF DELRAY BEACH COMMENTS	LJL AS
2	2019-09-10	SPRAB COMMENTS	LJL AS

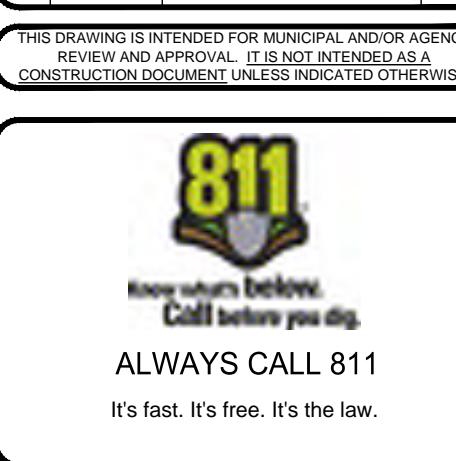


ISSUED FOR MUNICIPAL & AGENCY REVIEW & APPROVAL

PROJECT No.: FLB180120
DRAWN BY: LJL
CHECKED BY: AS
DATE: 2019-10-25
CAD I.D.: FLB180120-SSP-1

PROJECT:
PIERRE DELRAY PHASE 1 - SPRAB SITE PLAN PACKAGE (AKA SUNTRUST BUILDING)



CLIENT
ZYSCOVICH
ARCHITECTS
PROPOSED
DEVELOPMENT
302 E ATLANTIC AVE
PALM BEACH COUNTY
DELRAY BEACH, FL

BOHLER
ENGINEERING
2255 GLADES ROAD, SUITE 3305
BOCA RATON, FLORIDA 33431
Phone: (561) 571-0280
Fax: (561) 571-0281
FLORIDA BUSINESS CERT. OF AUTH. No. 30780
LANDSCAPE ARCHITECT BUSINESS LIC. No. C26000531

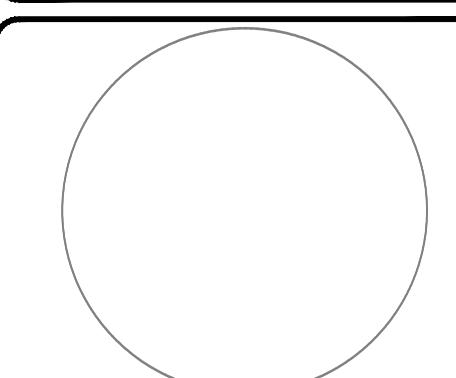


SHEET TITLE:
SITE PLAN
SHEET NUMBER:
C-303
REVISION 2 - 2019-09-10

10
5
2.5
0
10
1' = 10'

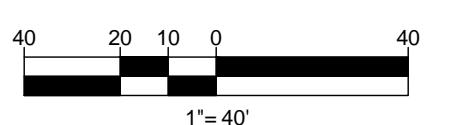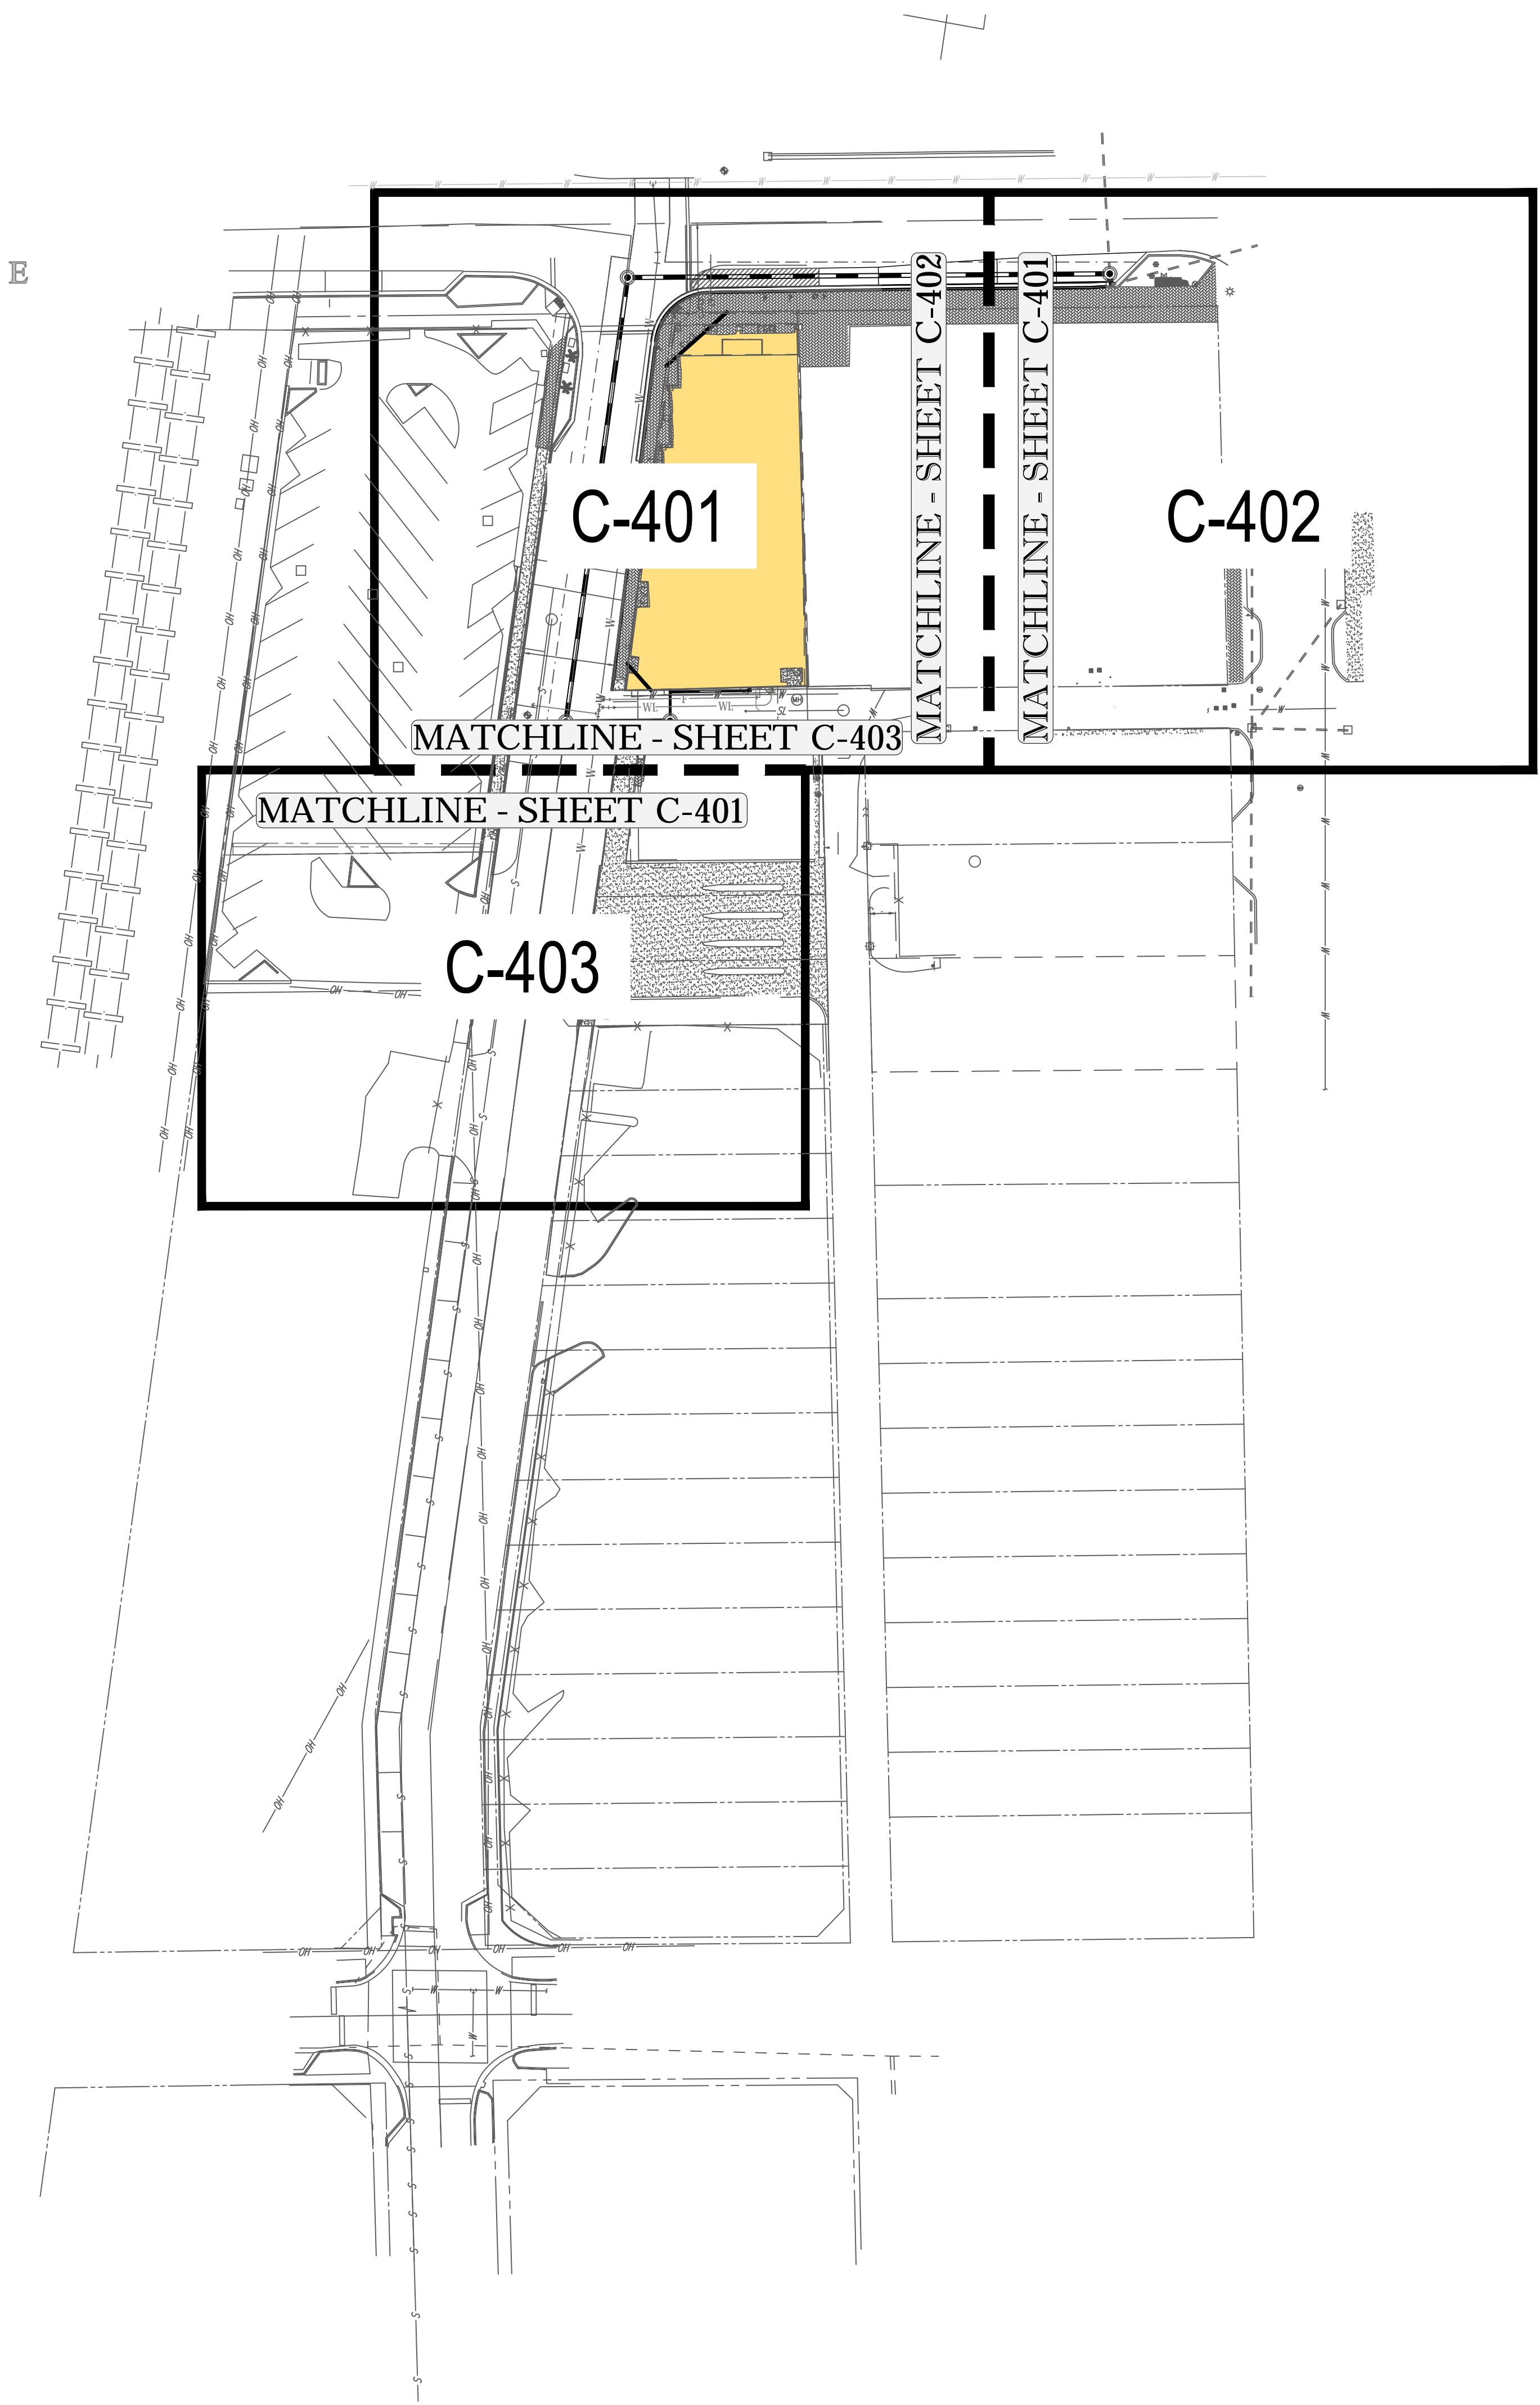

REVISIONS			
REV	DATE	COMMENT	DRAWN BY
1	2019-08-23	CITY OF DELRAY BEACH COMMENTS	LJL AS
2	2019-09-10	SPRAB COMMENTS	LJL AS

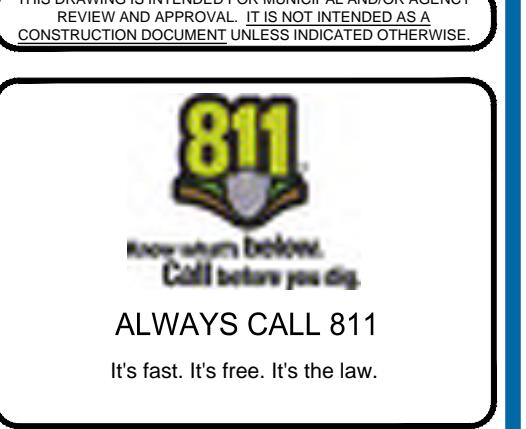

ISSUED FOR MUNICIPAL & AGENCY REVIEW & APPROVAL


PROJECT No.: FLB180120
DRAWN BY: LJL
CHECKED BY: AS
DATE: 2019-10-25
CAD I.D.: FLB180120-GDP-1

PROJECT: PIERRE DELRAY PHASE 1 - SPRAB SITE PLAN PACKAGE (AKA SUNTRUST BUILDING)

FOR

CLIENT
ZYSCOVICH
ARCHITECTS
PROPOSED DEVELOPMENT
302 E ATLANTIC AVE
PALM BEACH COUNTY
DELRAY BEACH, FL

BOHLER
ENGINEERING
2255 GLADES ROAD, SUITE 305E
BOCA RATON, FLORIDA 33431
Phone: (561) 571-0280
Fax: (561) 571-0281
FLORIDA BUSINESS CERT. OF AUTH. No. 30780
LANDSCAPE ARCHITECT BUSINESS LIC. No. C28000501

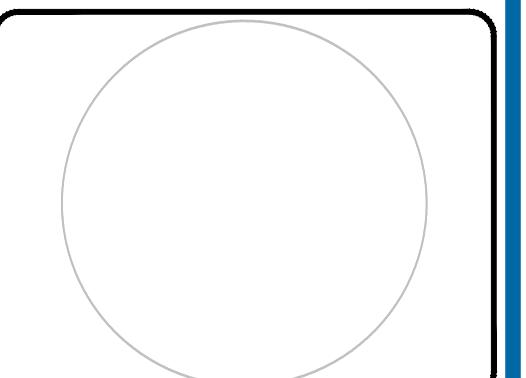


SHEET TITLE:
PGD PLAN KEY SHEET

SHEET NUMBER:
C-400

REVISION 2 - 2019-09-10

REVISION	DATE	COMMENT
1	2019-08-23	CITY OF DELRAY BEACH COMMENTS LJL AS
2	2019-09-10	SPRAB COMMENTS LJL AS

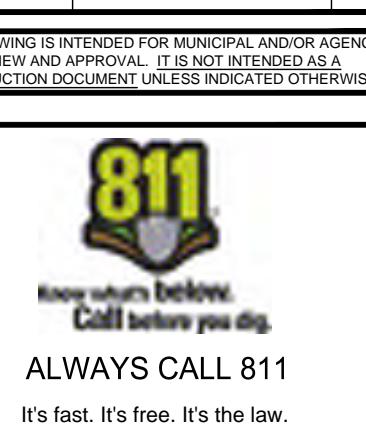

ISSUED FOR MUNICIPAL & AGENCY REVIEW & APPROVAL

PROJECT No.: FLB180120
DRAWN BY: LJL
CHECKED BY: LJL
DATE: 2019-10-25
CAD I.D.: FLB180120-GDP-1

PROJECT:
PIERRE DELRAY PHASE 1 - SPRAB SITE PLAN PACKAGE (AKA SUNTRUST BUILDING)

CLIENT
ZYSCOVICH
ARCHITECTS
PROPOSED DEVELOPMENT
302 E ATLANTIC AVE
PALM BEACH COUNTY
DELRAY BEACH, FL

BOHLER
ENGINEERING
2255 GLADES ROAD, SUITE 305E
BOCA RATON, FLORIDA 33431
Phone: (561) 571-0280
Fax: (561) 571-0281
FLORIDA BUSINESS CERT. OF AUTH. No. 30780
LANDSCAPE ARCHITECT BUSINESS LIC. No. C26000531

SHEET TITLE:
PAVING, GRADING AND DRAINAGE PLAN
SHEET NUMBER:
C-401
REVISION 2 - 2019-09-10

